



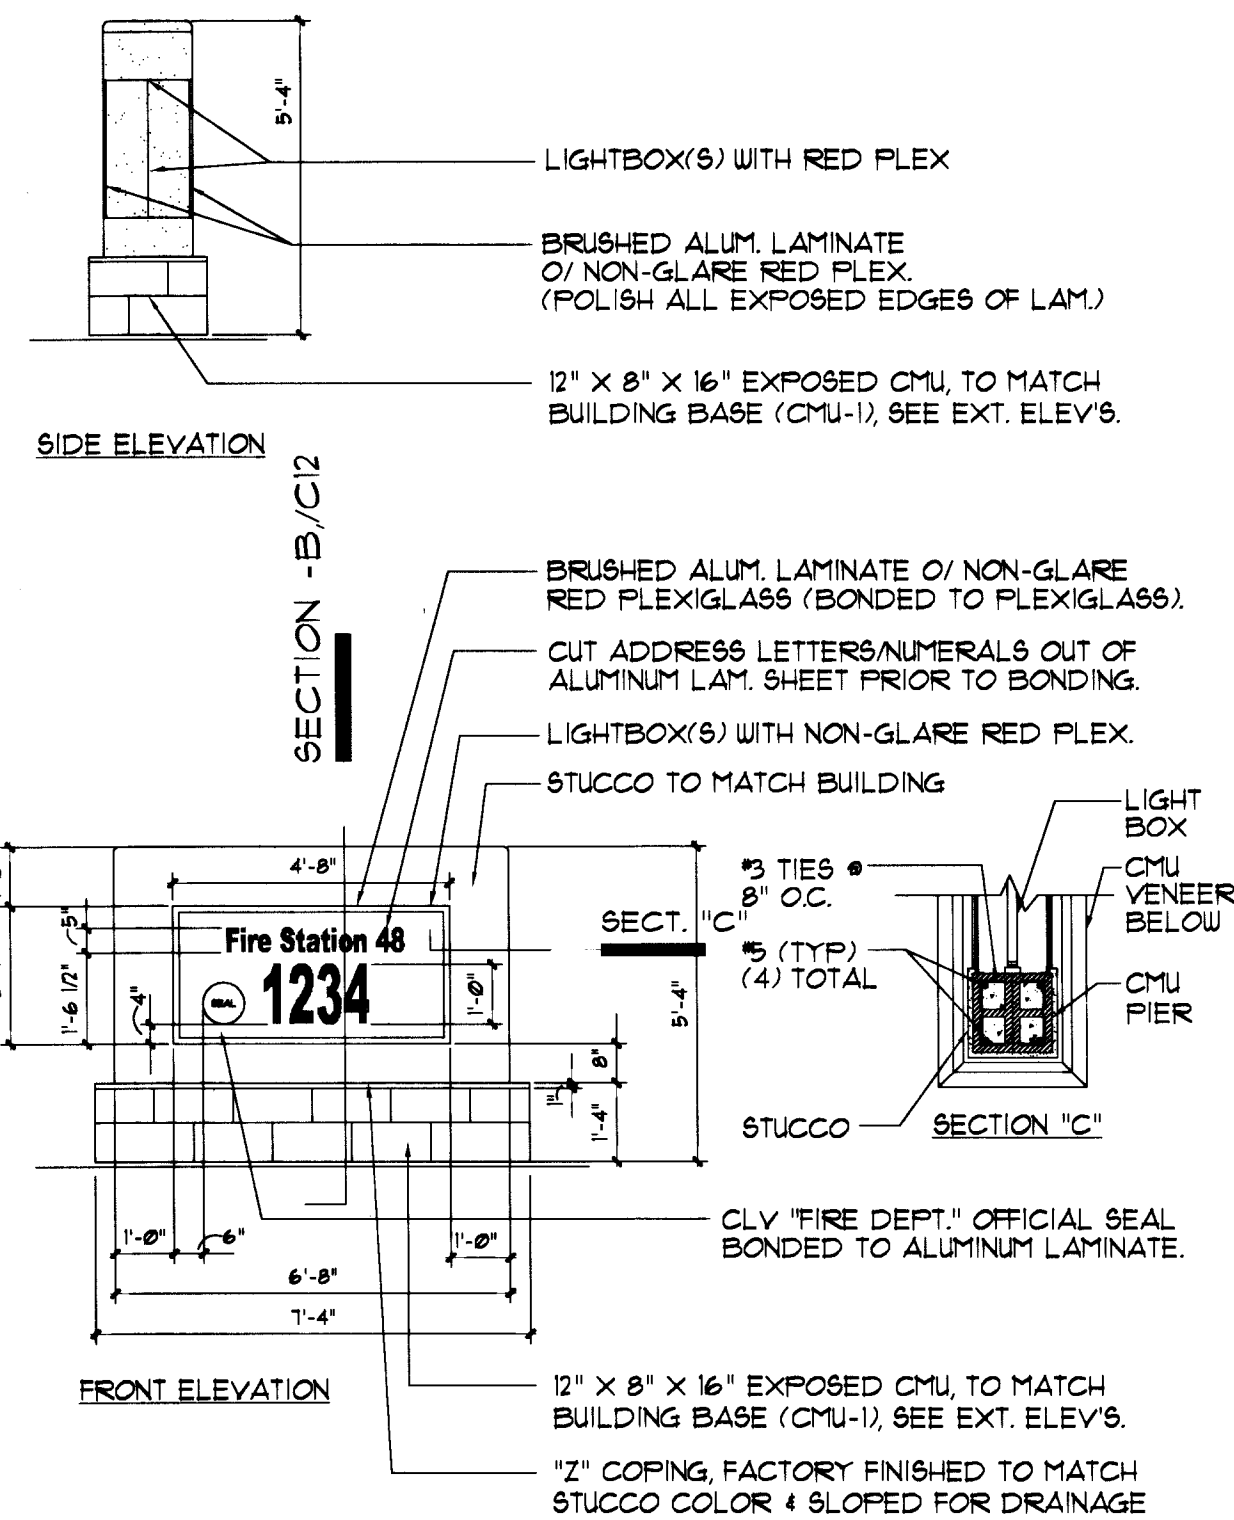


MONUMENT SIGN DETAIL
NTS

A
C12

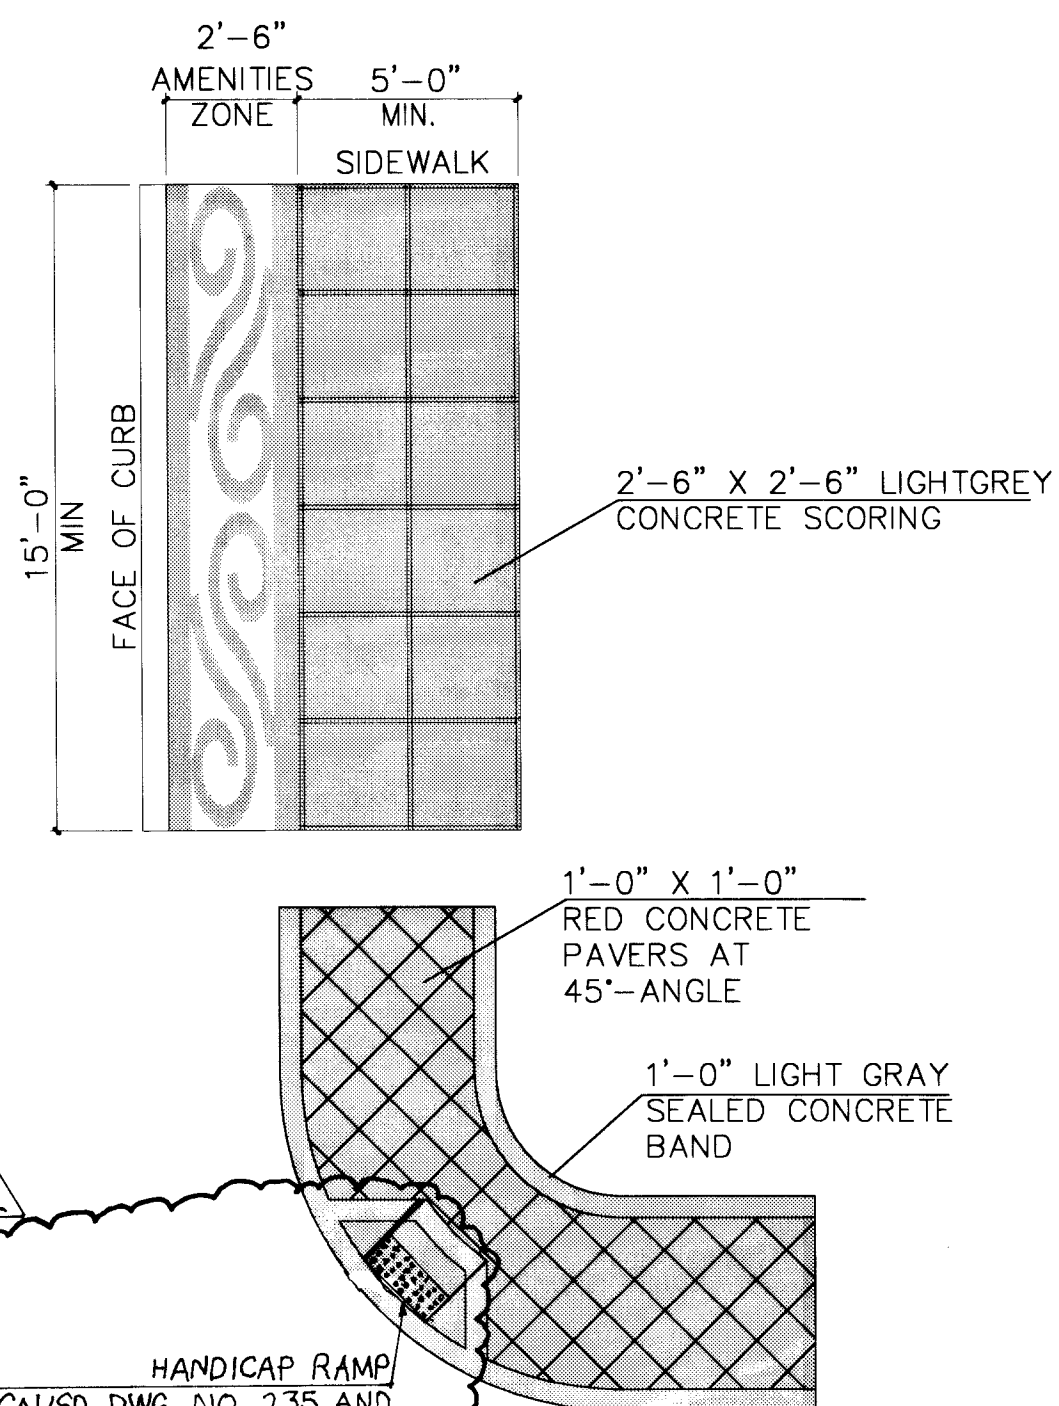

SIDEWALK TREATMENT
NTS

D
C12

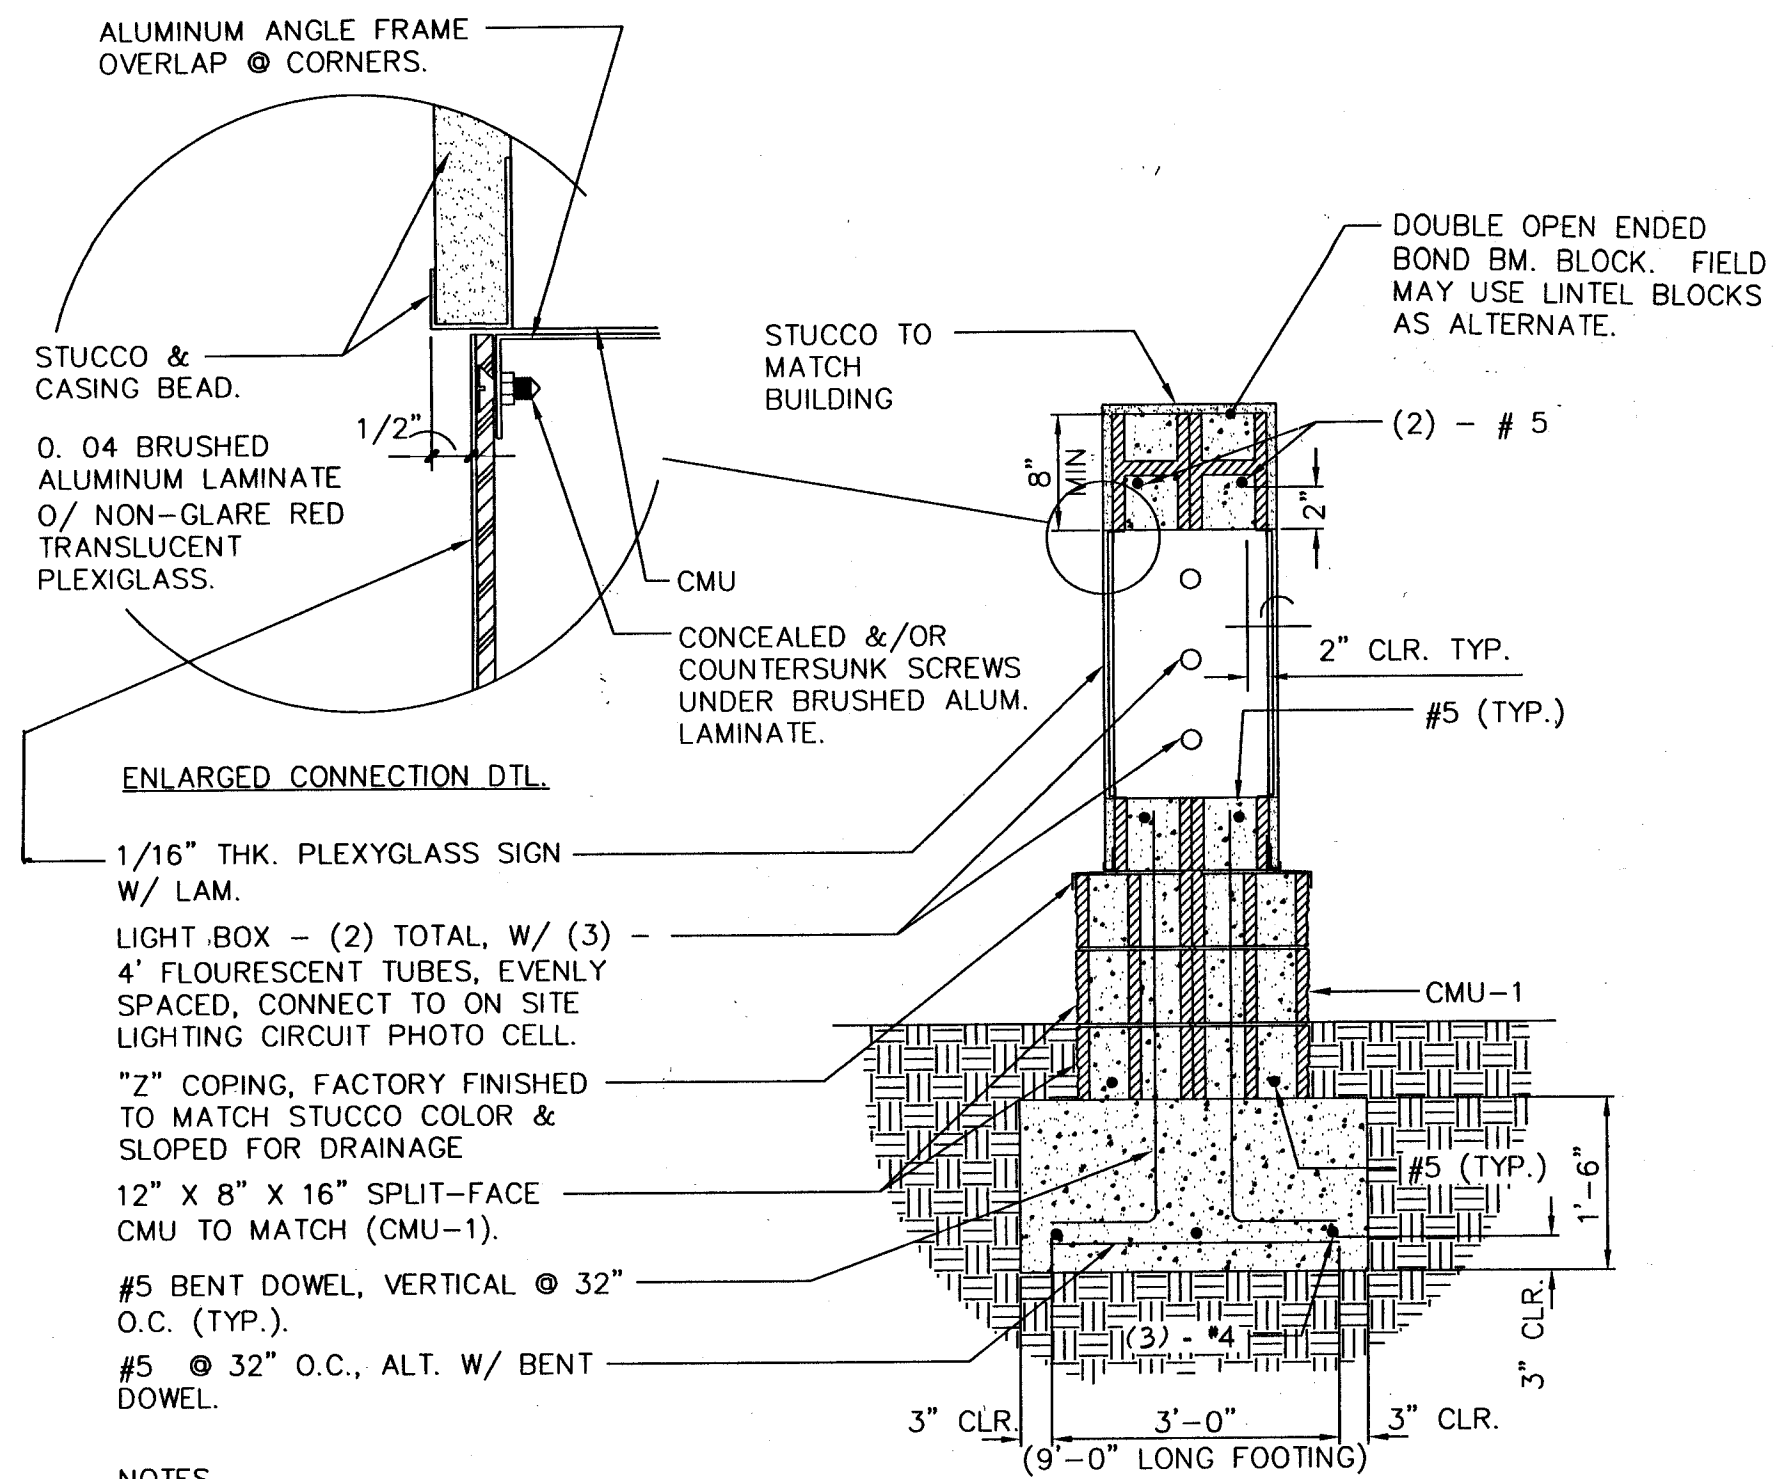


NOTES

- CORNER BLOCKS SHALL HAVE GLAZED FACE ON 3 SIDES.
- PVC CONDUIT AND J-BOX TO BE INSTALLED PER SHEET C-ES.1. ONE 3/4" & TWO 1" COMMUNICATION CONDUITS ARE TO BE INSTALLED THROUGH THE BOTTOM OF THE FOOTING AND CMU WALL INTO SIGN. CONDUITS FOR DATA LINE WILL COME UP THROUGH THE FOOTING AND INTO SIGN ASSEMBLY.
- FIELD TO KNOCK OUT CELL SIDEWALLS OF LINTEL @ CENTER & ENDS TO CONNECT BOTH WYTHS.


SECTION @ MONUMENT SIGN
NTS

B
C12

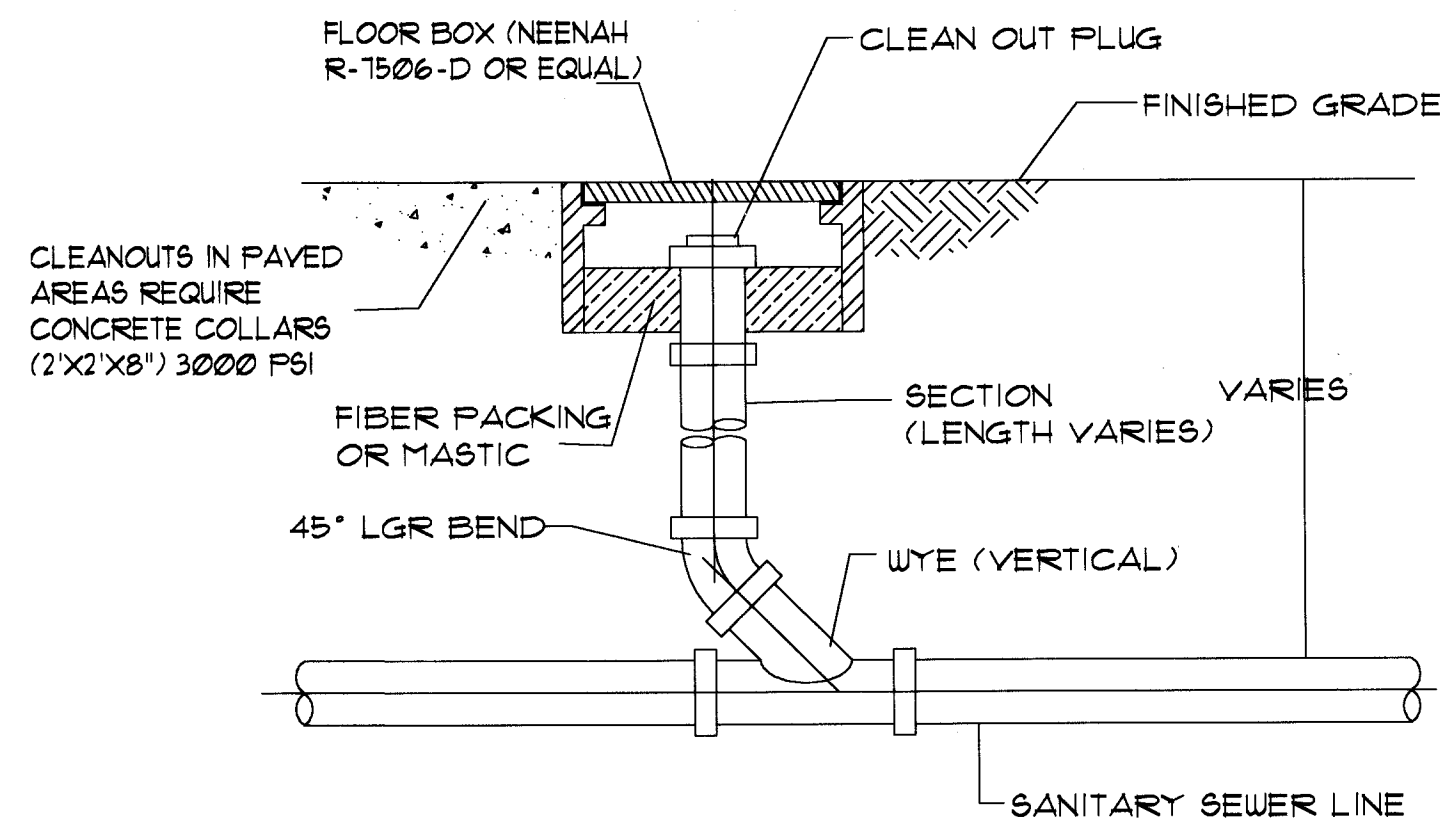


SEWER CLEANOUT
NTS

E
C12

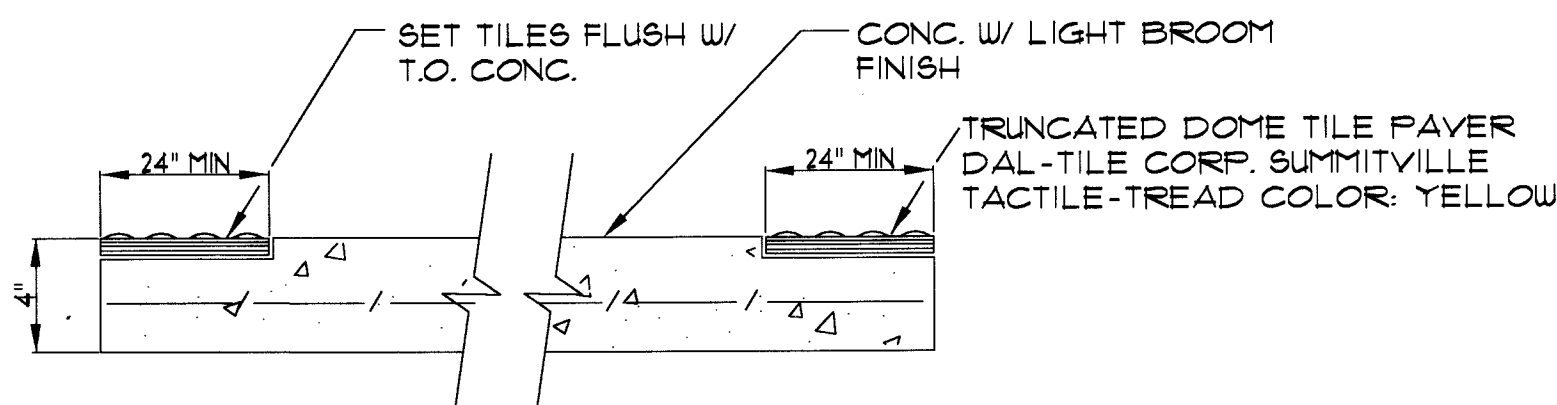

ACCESSIBLE ROUTE
NTS


F
C12

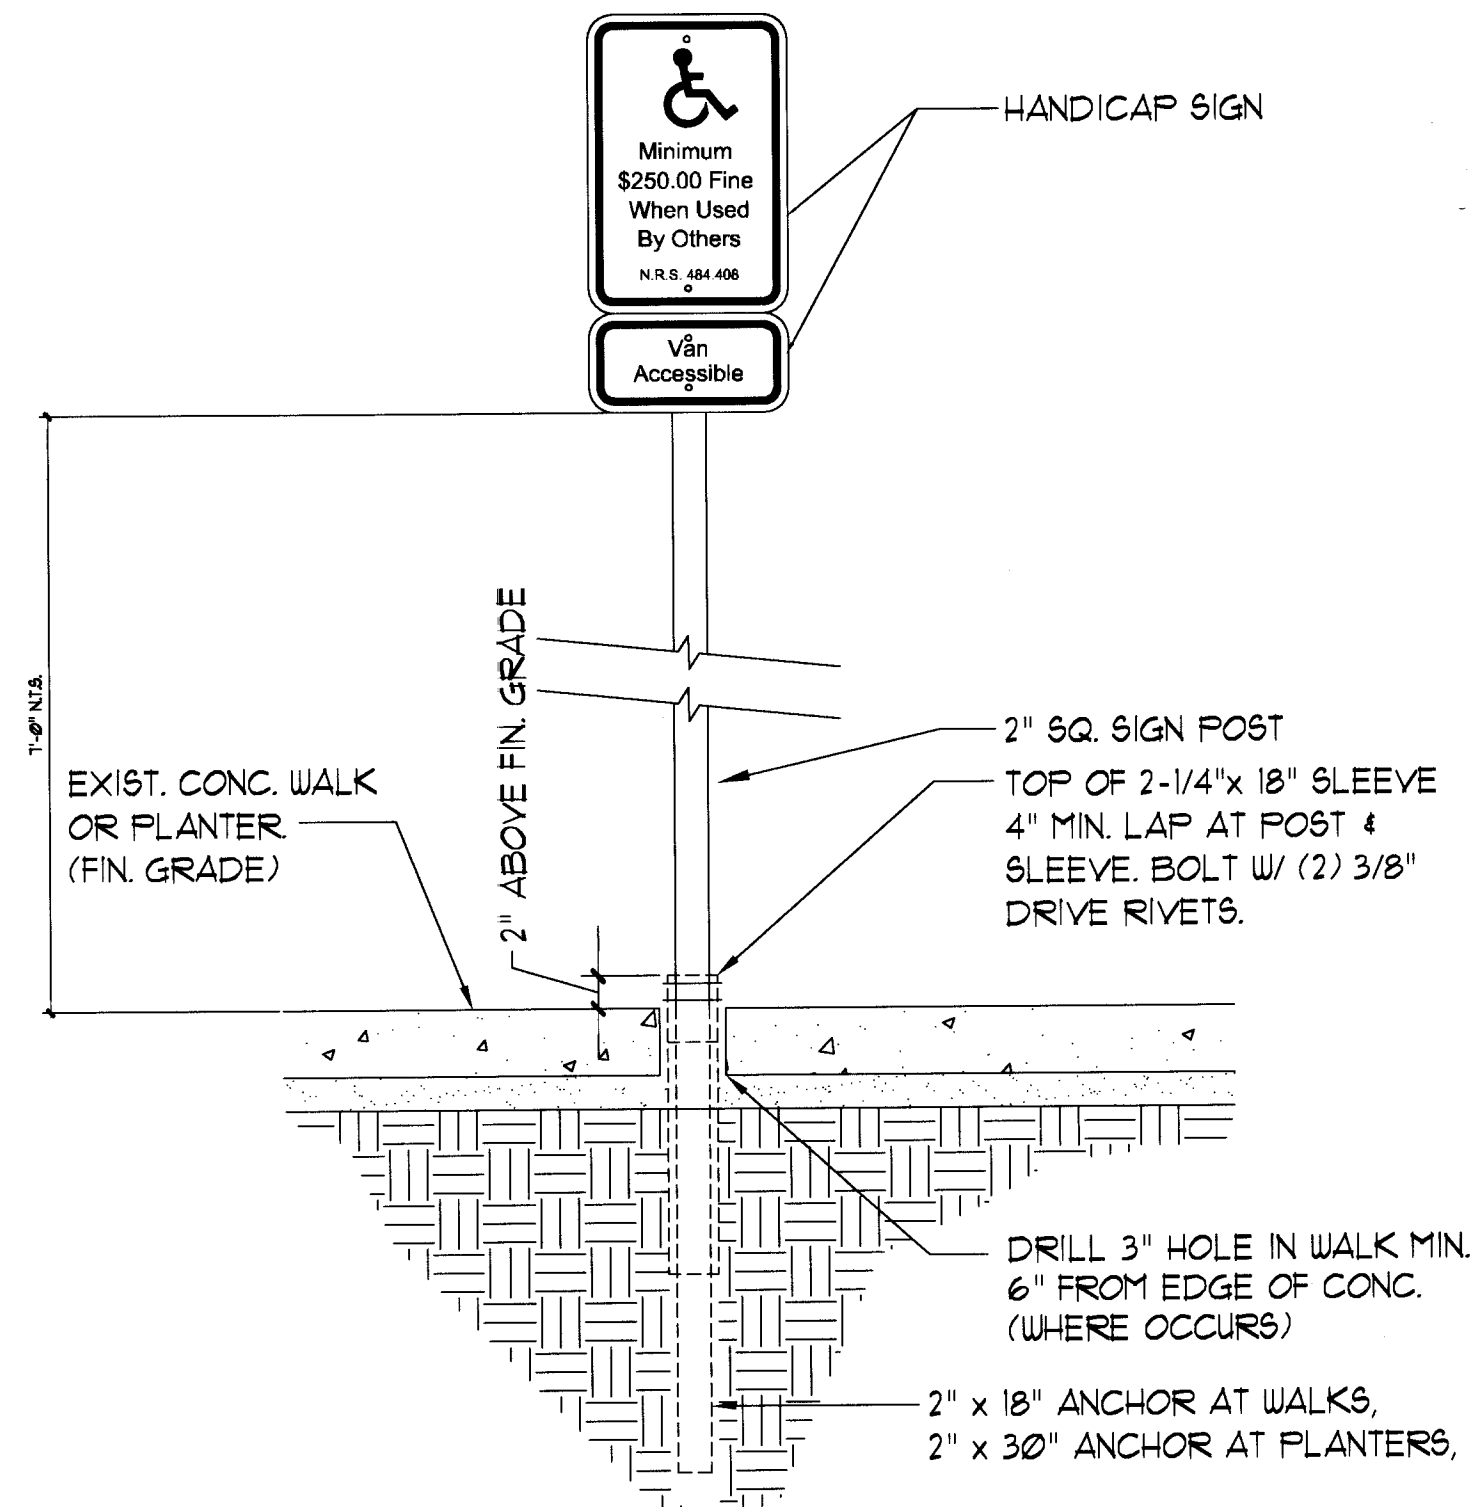




ALL COMPONENTS TO BE GALVANIZED SQUARE POST. ATTACH ANCHOR TO SLEEVE PRIOR TO DRIVING INTO GROUND.

HANDICAP PARKING SIGN DETAIL
NTS

C
C12

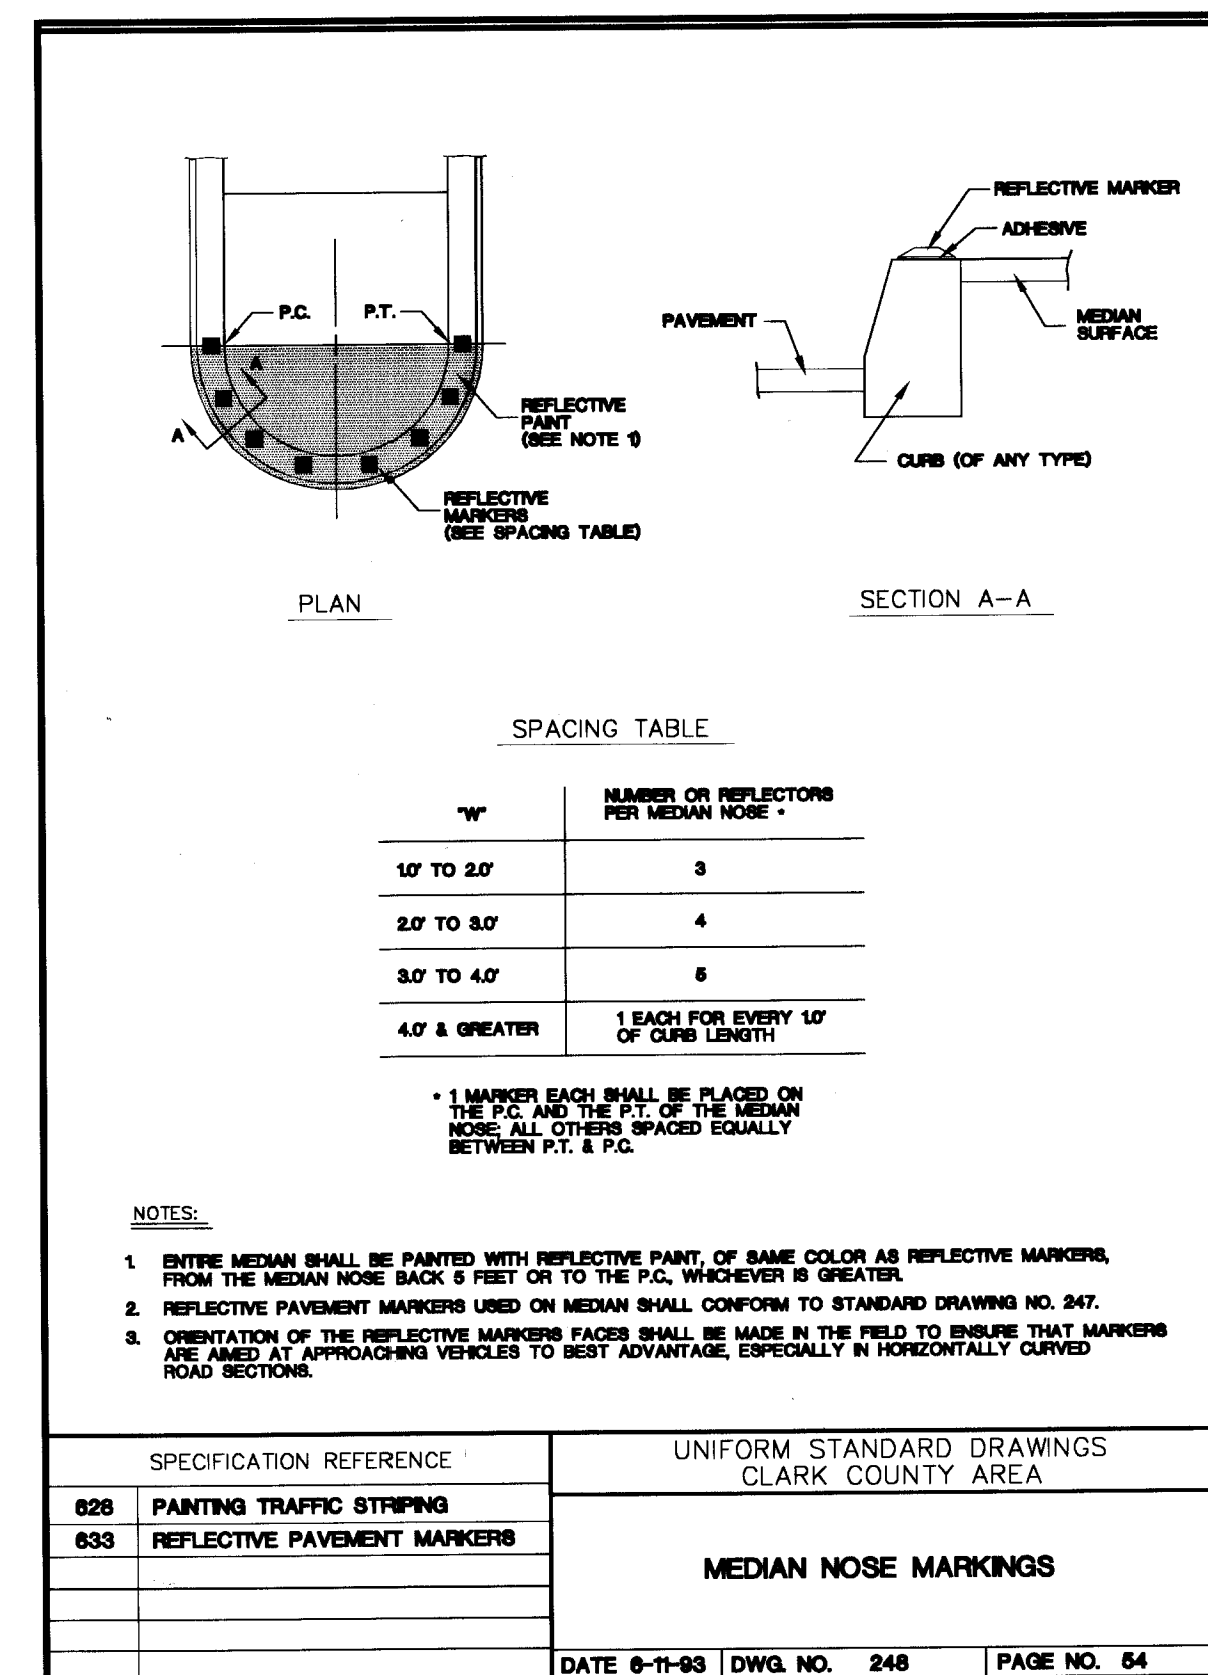

SPECIFICATION REFERENCE	UNIFORM STANDARD DRAWINGS CLARK COUNTY AREA
628 PAINTING TRAFFIC STRIPING	MEDIAN NOSE MARKINGS
633 REFLECTIVE PAVEMENT MARKERS	
	DATE 6-11-93 DWG. NO. 248 PAGE NO. 64

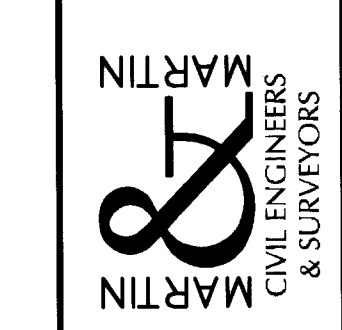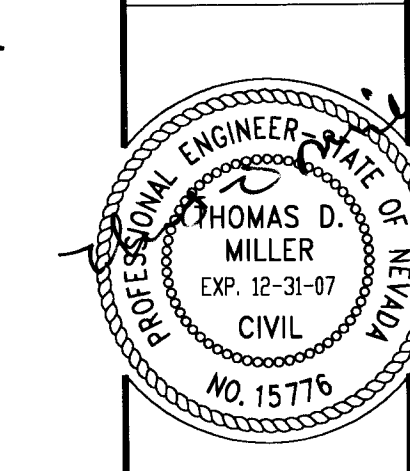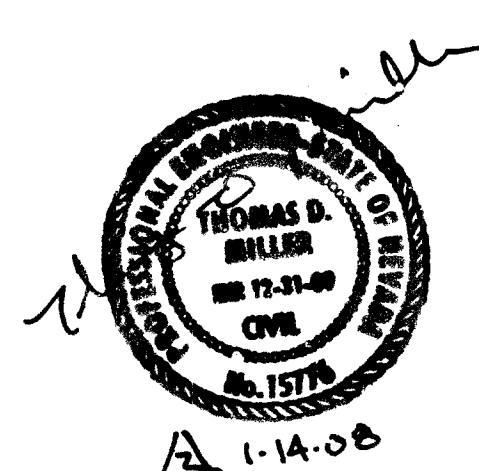

2101 S. JONES BLVD
SUITE 120
LAS VEGAS, NV 89146
PHONE (702) 248-8000
FAX (702) 248-8070

CITY OF LAS VEGAS
FIRE STATION NO. 48
CONSTRUCTION DETAILS IV

SHEET
C-12
12 OF 26 SHTS
CLV DWG. NO.
630-104

24423