
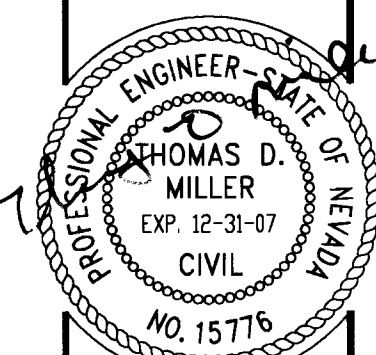
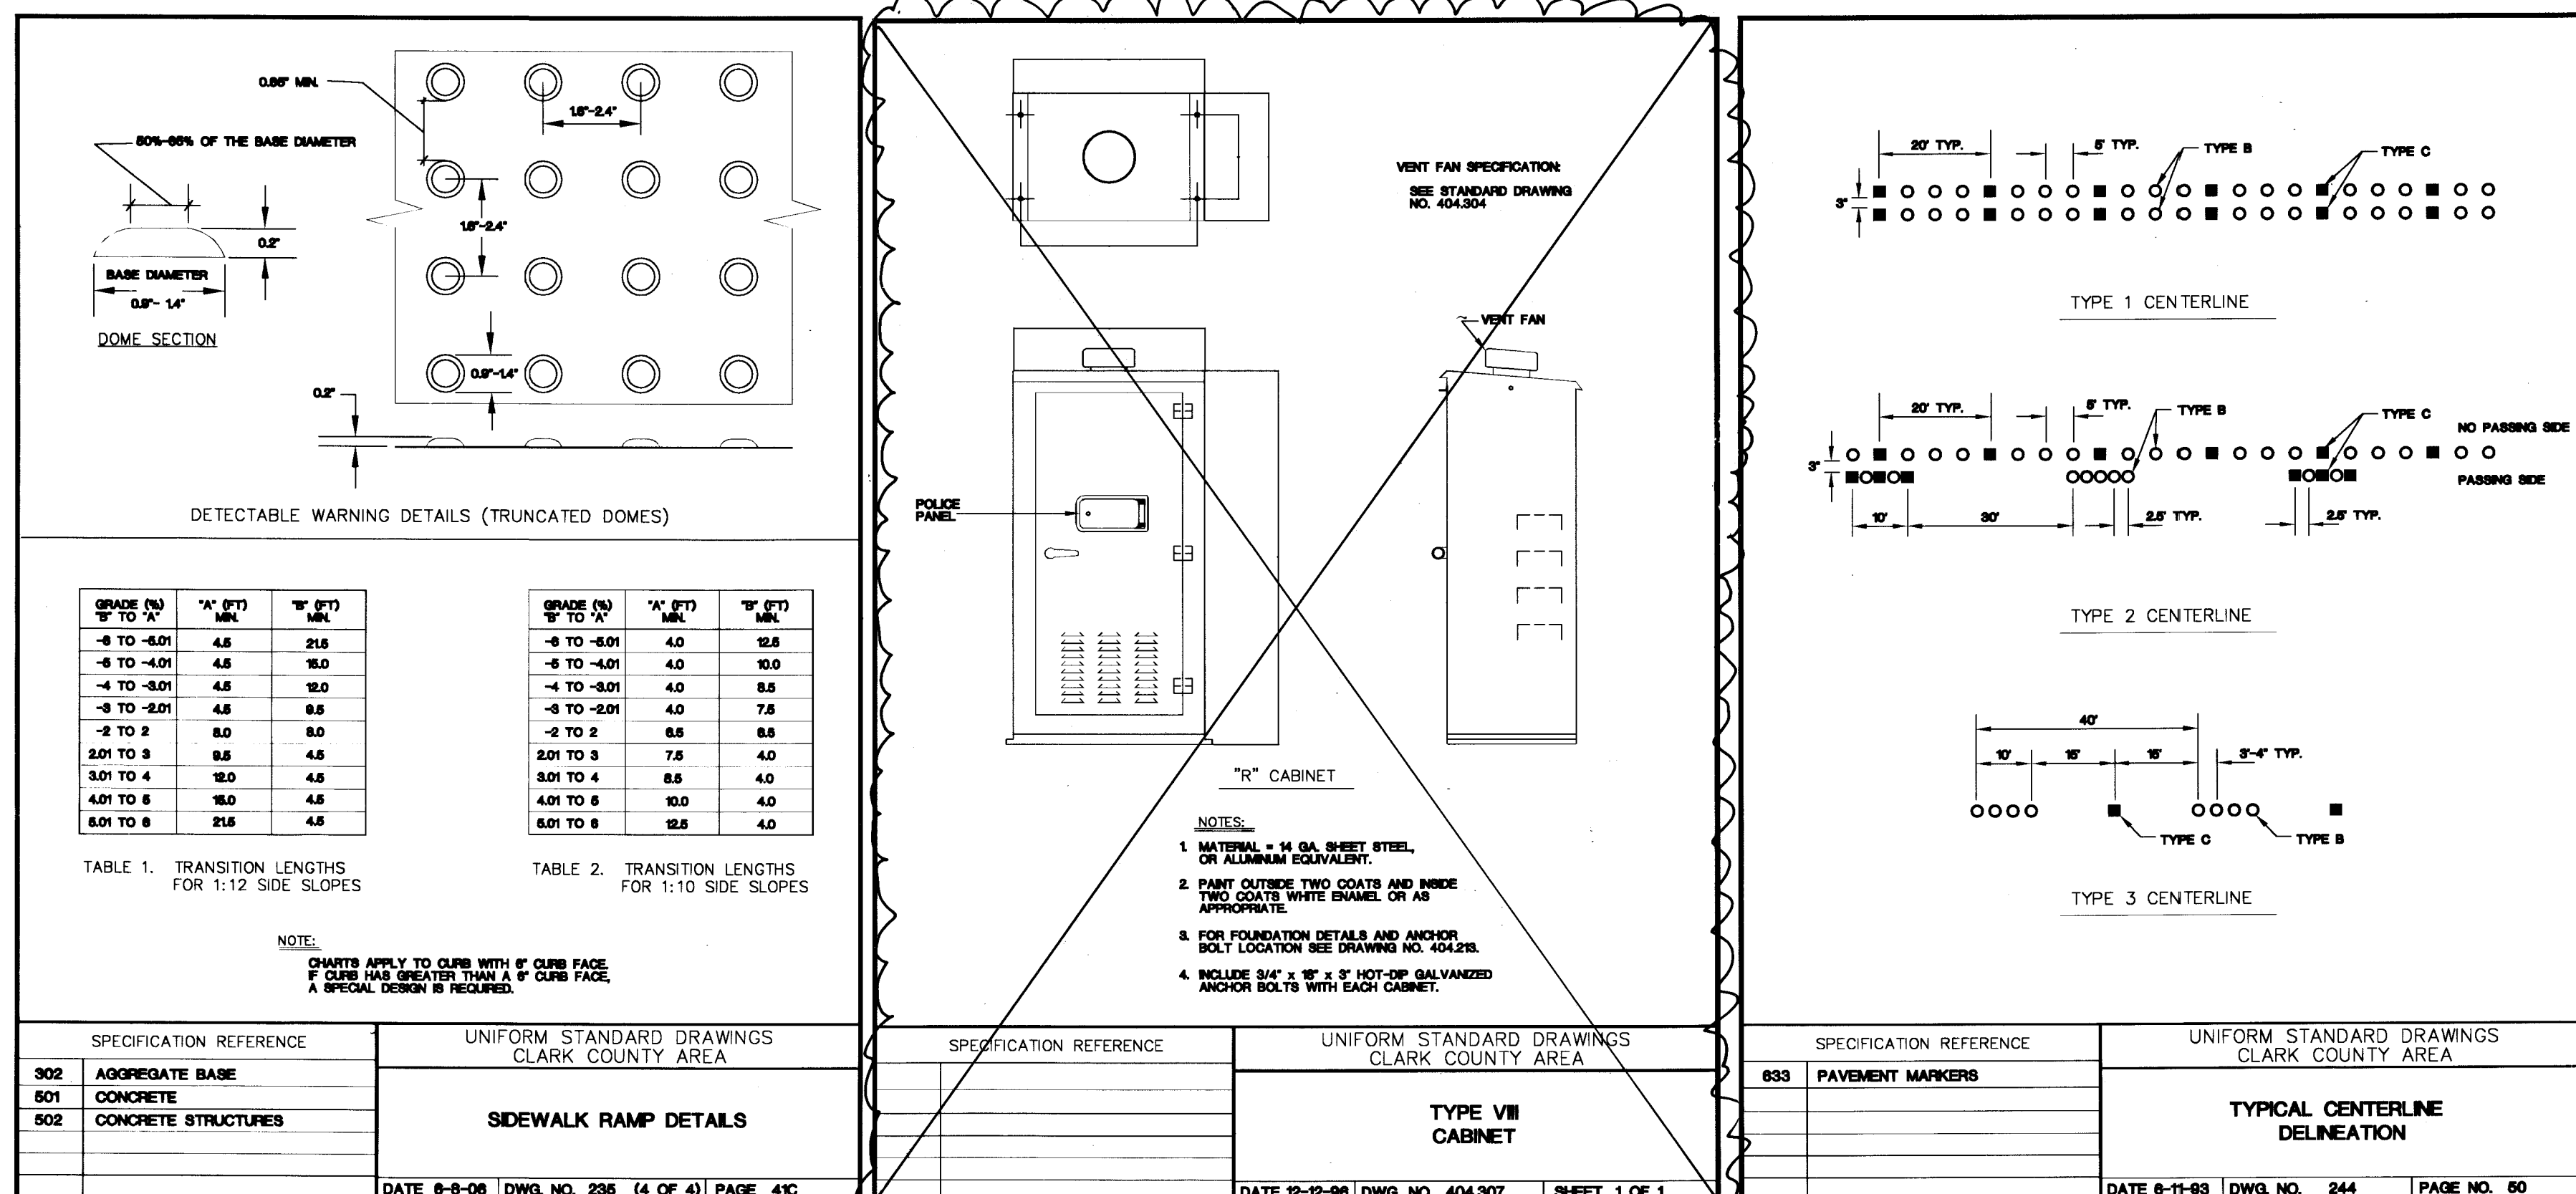
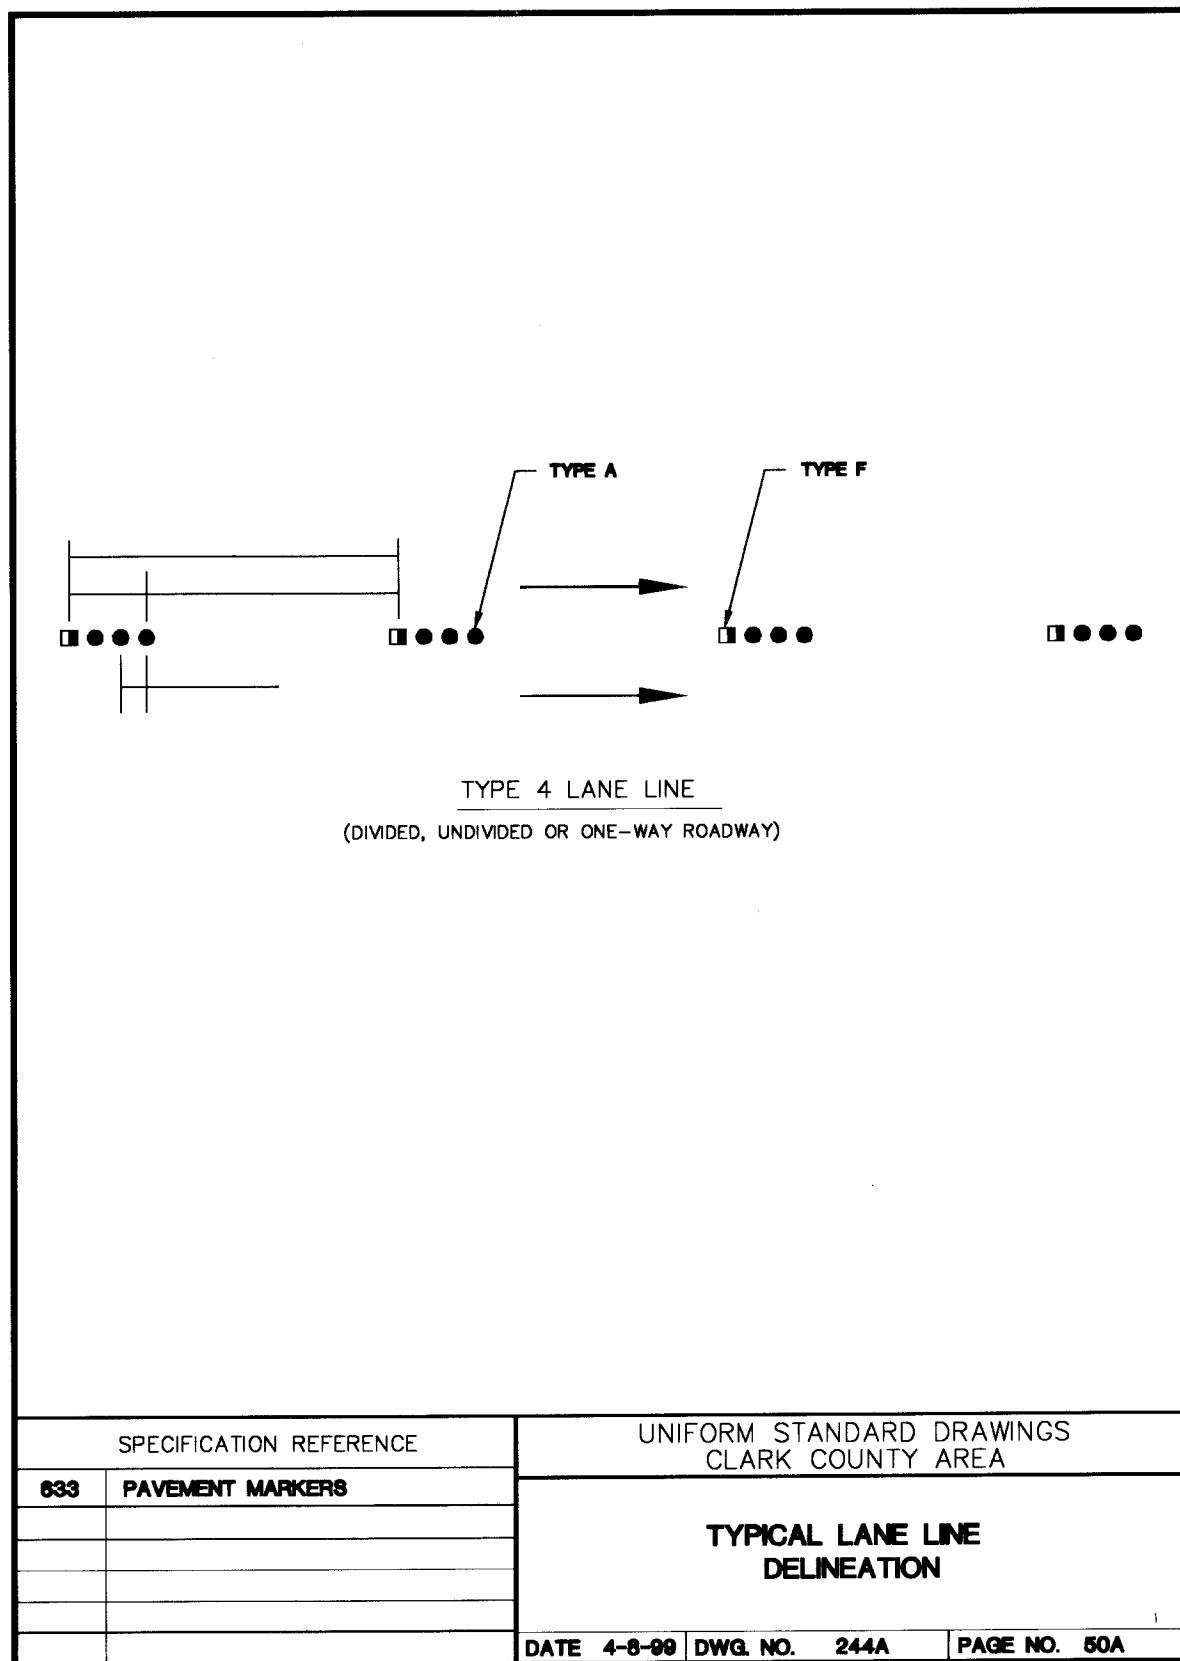
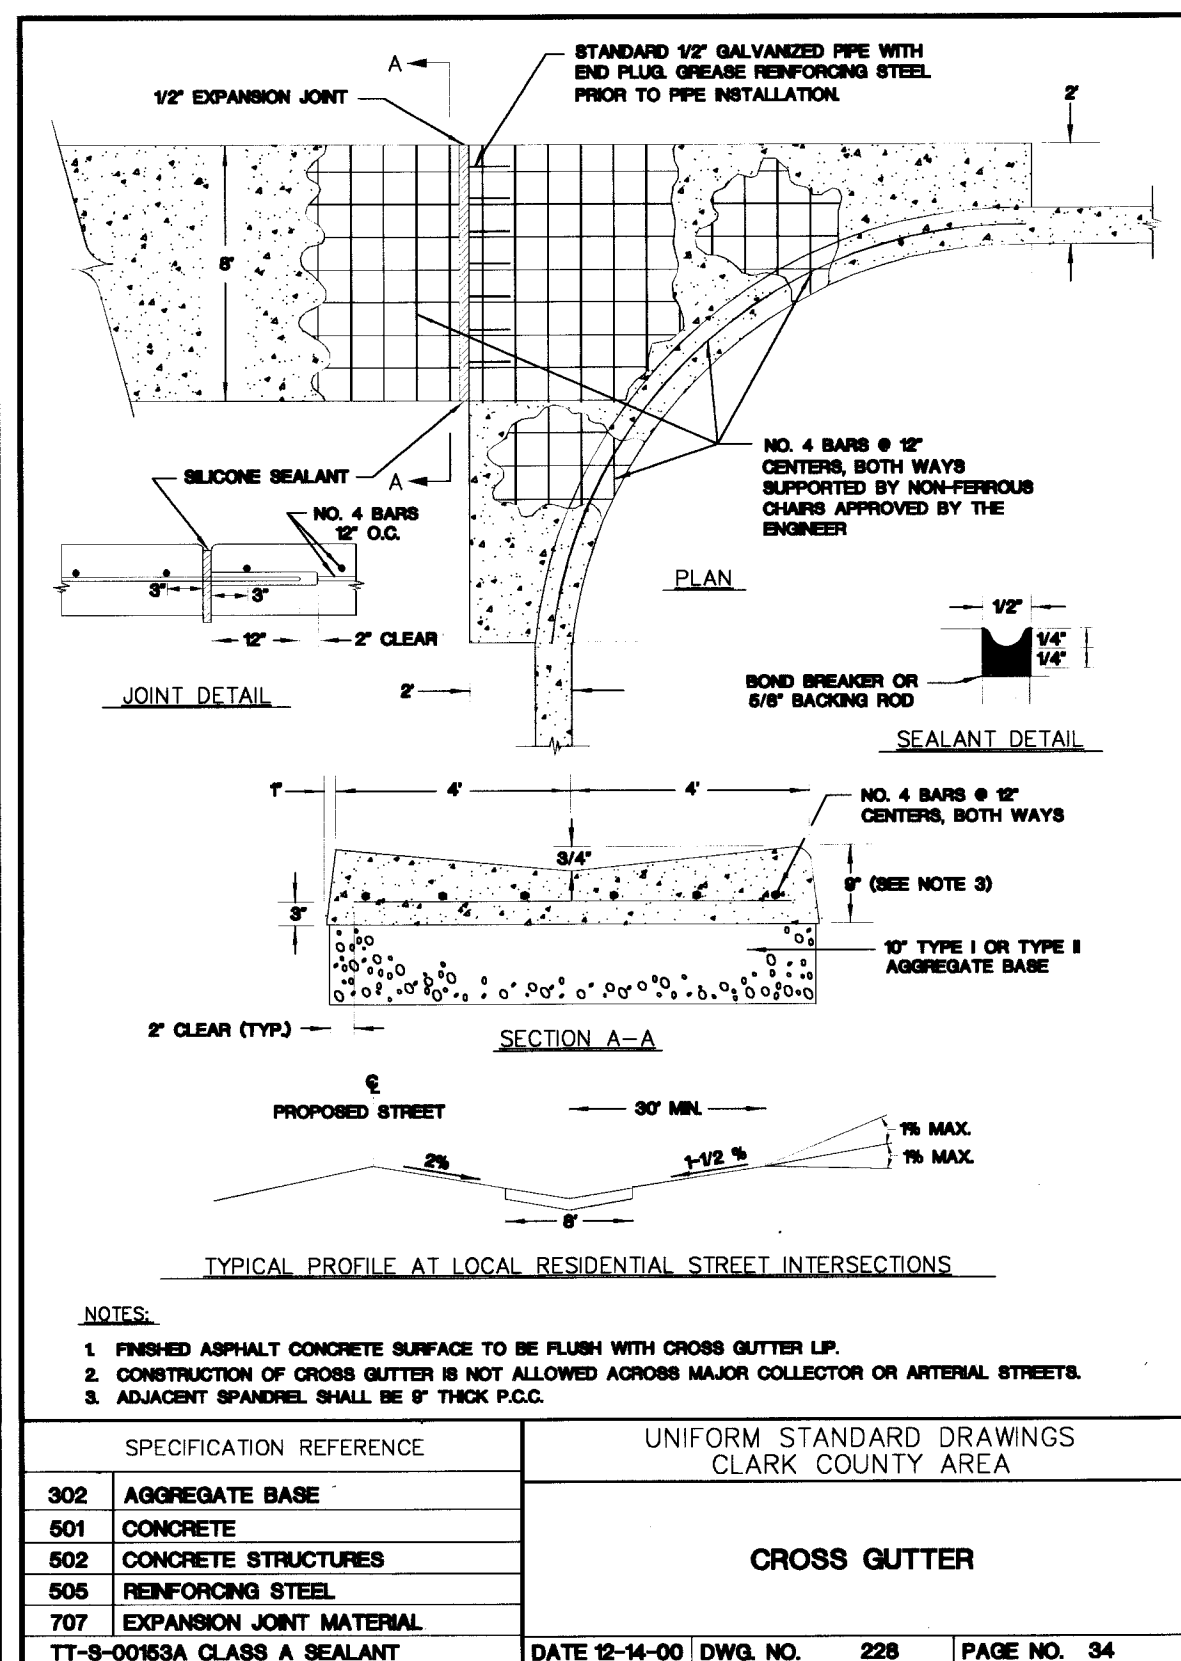
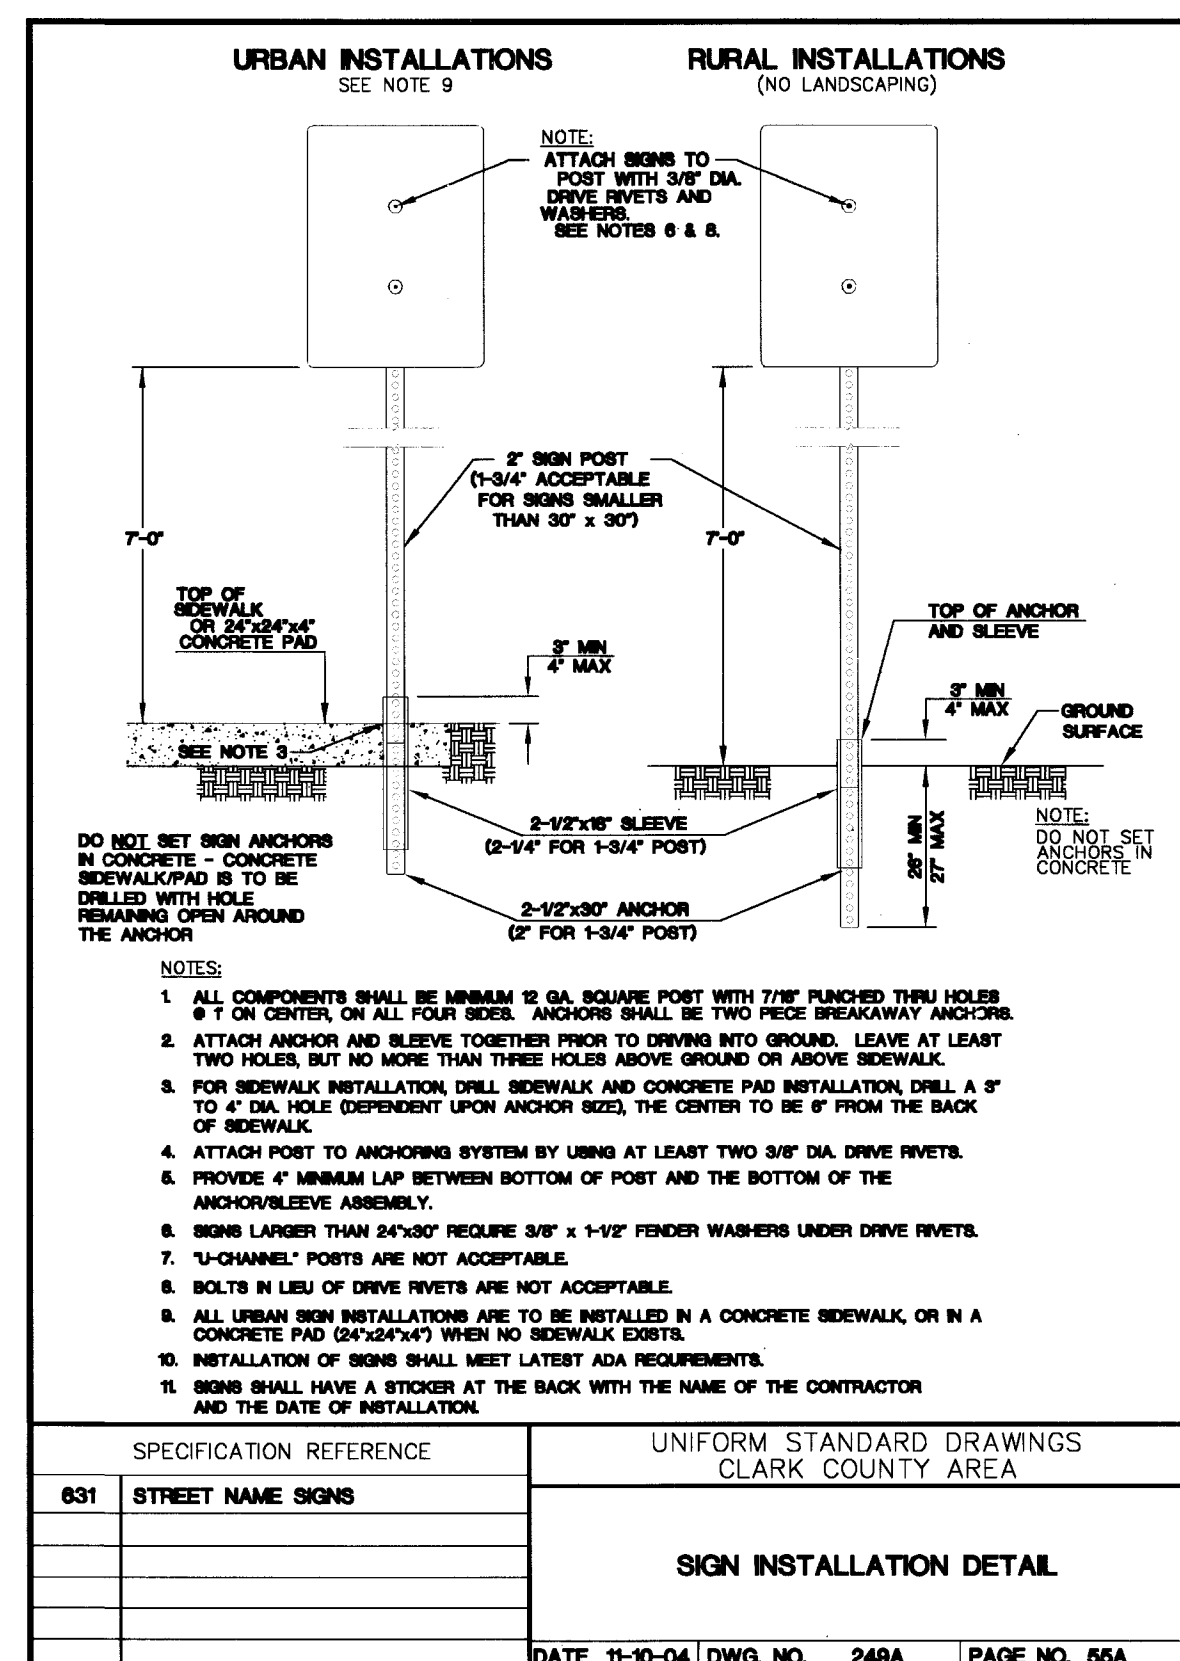


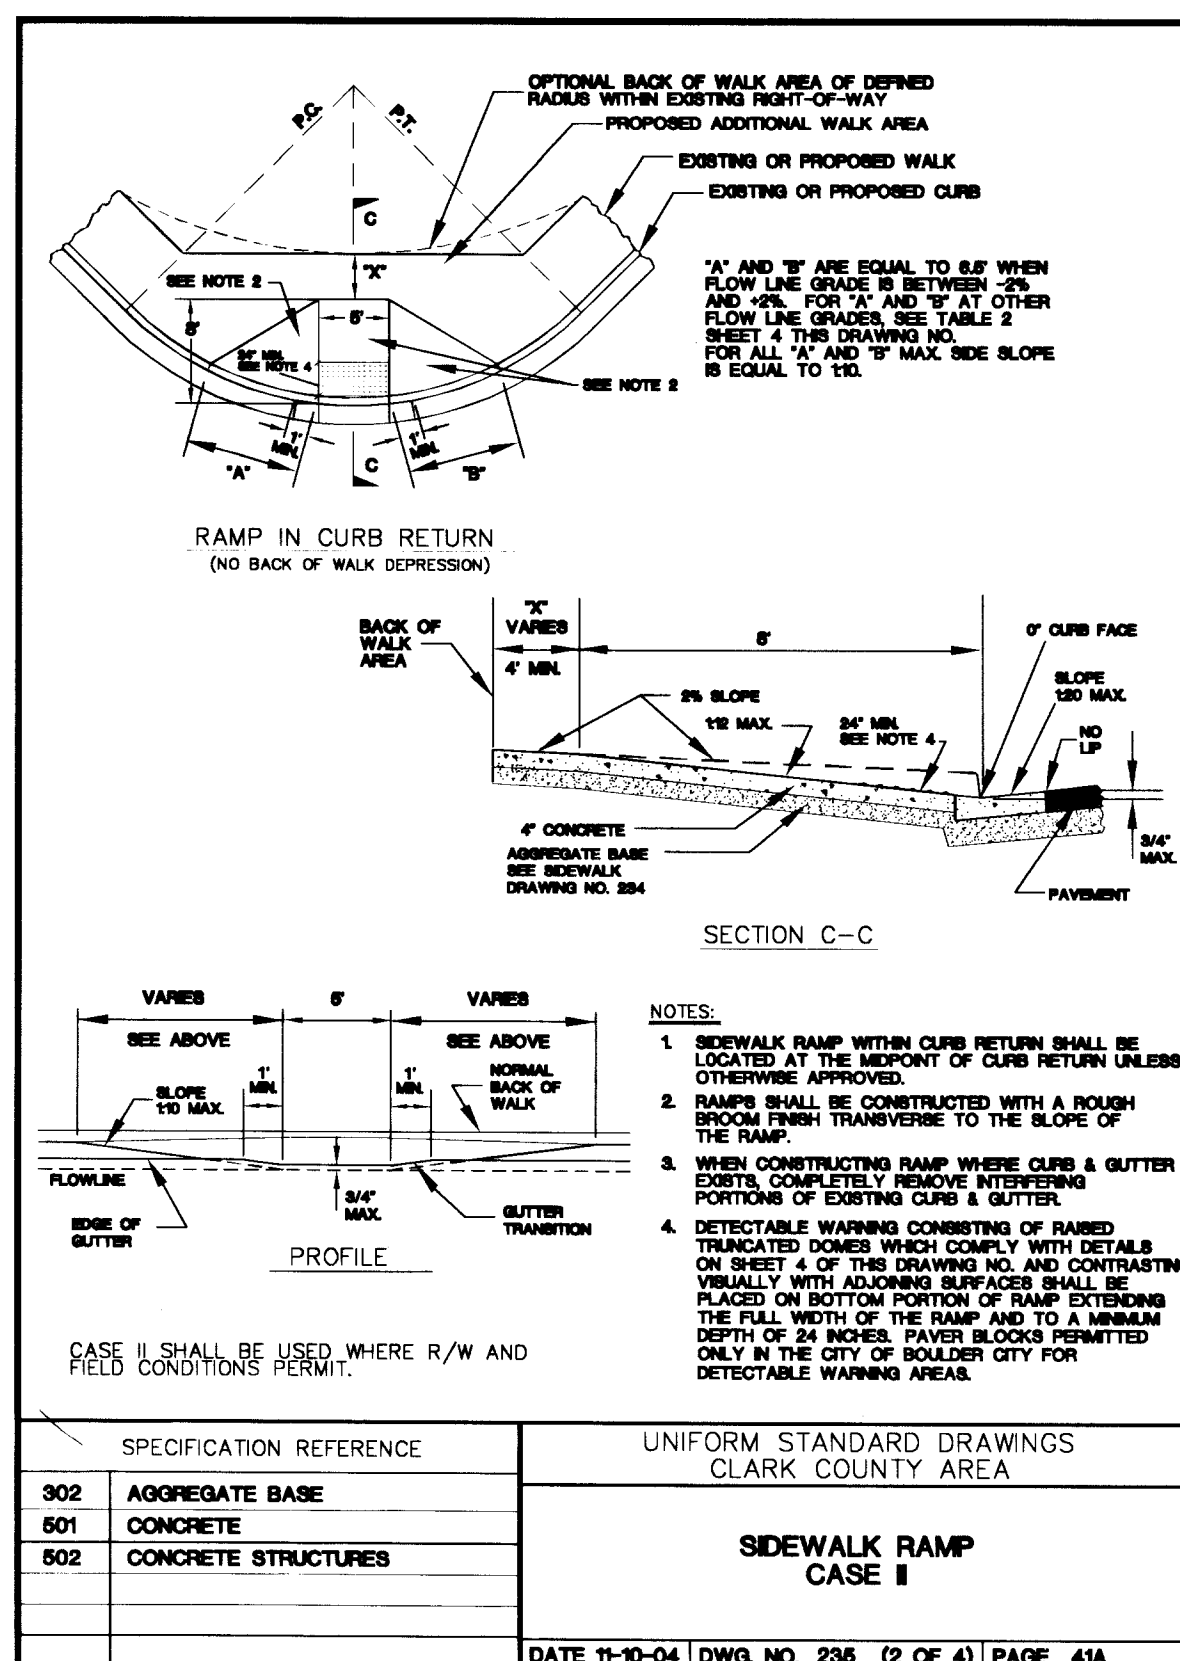

MARTIN & MARTIN
CIVIL ENGINEERS
& SURVEYORS

2101 S. JONES BLVD
SUITE 120
LAS VEGAS, NV 89146
PHONE (702) 248-8000
FAX (702) 248-8070

CITY OF LAS VEGAS
FIRE STATION NO. 48
CONSTRUCTION DETAILS IX

SHEET
C-17
17 OF 26 SHTS
CLV DWG. NO.
630-104

24423