CONSTRUCTION NOTES

1. INSTALL "STOP HERE ON RED" SIGN (R10-6 24"X36").
2. INSTALL 24" STOP BAR.
3. SIGN POST INSTALLATION PER CCAUSD NO. 249 (SEE SHEET C-19).
4. INSTALL 4" WHITE STRIPES AT 45 DEGREE ANGLE, 3' ON CENTER AS SHOWN.
5. INSTALL BLUE HANDICAP PARKING SYMBOL.
6. INSTALL 4" WHITE PARKING STRIPE.
7. INSTALL MEDIAN NOSE MARKINGS PER CCAUSD NO. 248 (SEE SHEET C-12).
8. PAINT CURB RED 10' ON EACH SIDE OF FIRE HYDRANT.
9. INSTALL BLUE RAISED PAVEMENT MARKER.
10. REHABILITATE EXISTING TYPE 2 CENTERLINES TO LIKE NEW CONDITION PER CCAUSD NO. 244 (SEE SHEET C-17).
11. REHABILITATE TYPE 4 LANE LINES TO LIKE NEW CONDITION PER CCAUSD NO. 244A AS NEEDED (SEE SHEET C-17).
12. ~~INSTALL TYPE 2 CENTERLINE TO LIKE NEW CONDITION PER CCAUSD NO. 244A (SEE SHEET C-17).~~
13. PAINT MEDIAN CURB YELLOW.
14. INSTALL RAISED YELLOW REFLECTIVE PAVEMENT MARKERS AS SHOWN @ 5' O.C.

GRAPHIC SCALE

30 0 15 30 60 120

(IN FEET)
1 INCH = 30 FT

BENCHMARK

DESC.	NAVD 88 DATUM	NAVD 88 DATUM
FOUND RIVET & PLATE, LOCATED IN THE TOP OF CURB AT THE NORTH WEST CORNER OF EL CAPITAN AND RACEL. MARKED 8LV90 8S6 WITH A PUBLISHED ELEVATION OF 2600.16 PER CITY OF LAS VEGAS BENCHMARKS 6-02.	2600.16 (FEET)	792.5309 (METERS)

BASIS OF BEARING

SOUTH 89°48'12" EAST, BEING THE BEARING OF THE CENTERLINE OF SEVERANCE LANE AS SHOWN IN THAT CERTAIN RECORD OF SURVEY IN FILE 114, PAGE 57 OF SURVEYS, OFFICIAL RECORDS, CLARK COUNTY, NEVADA.

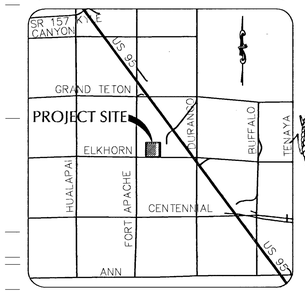

VICINITY MAP
N.T.S.

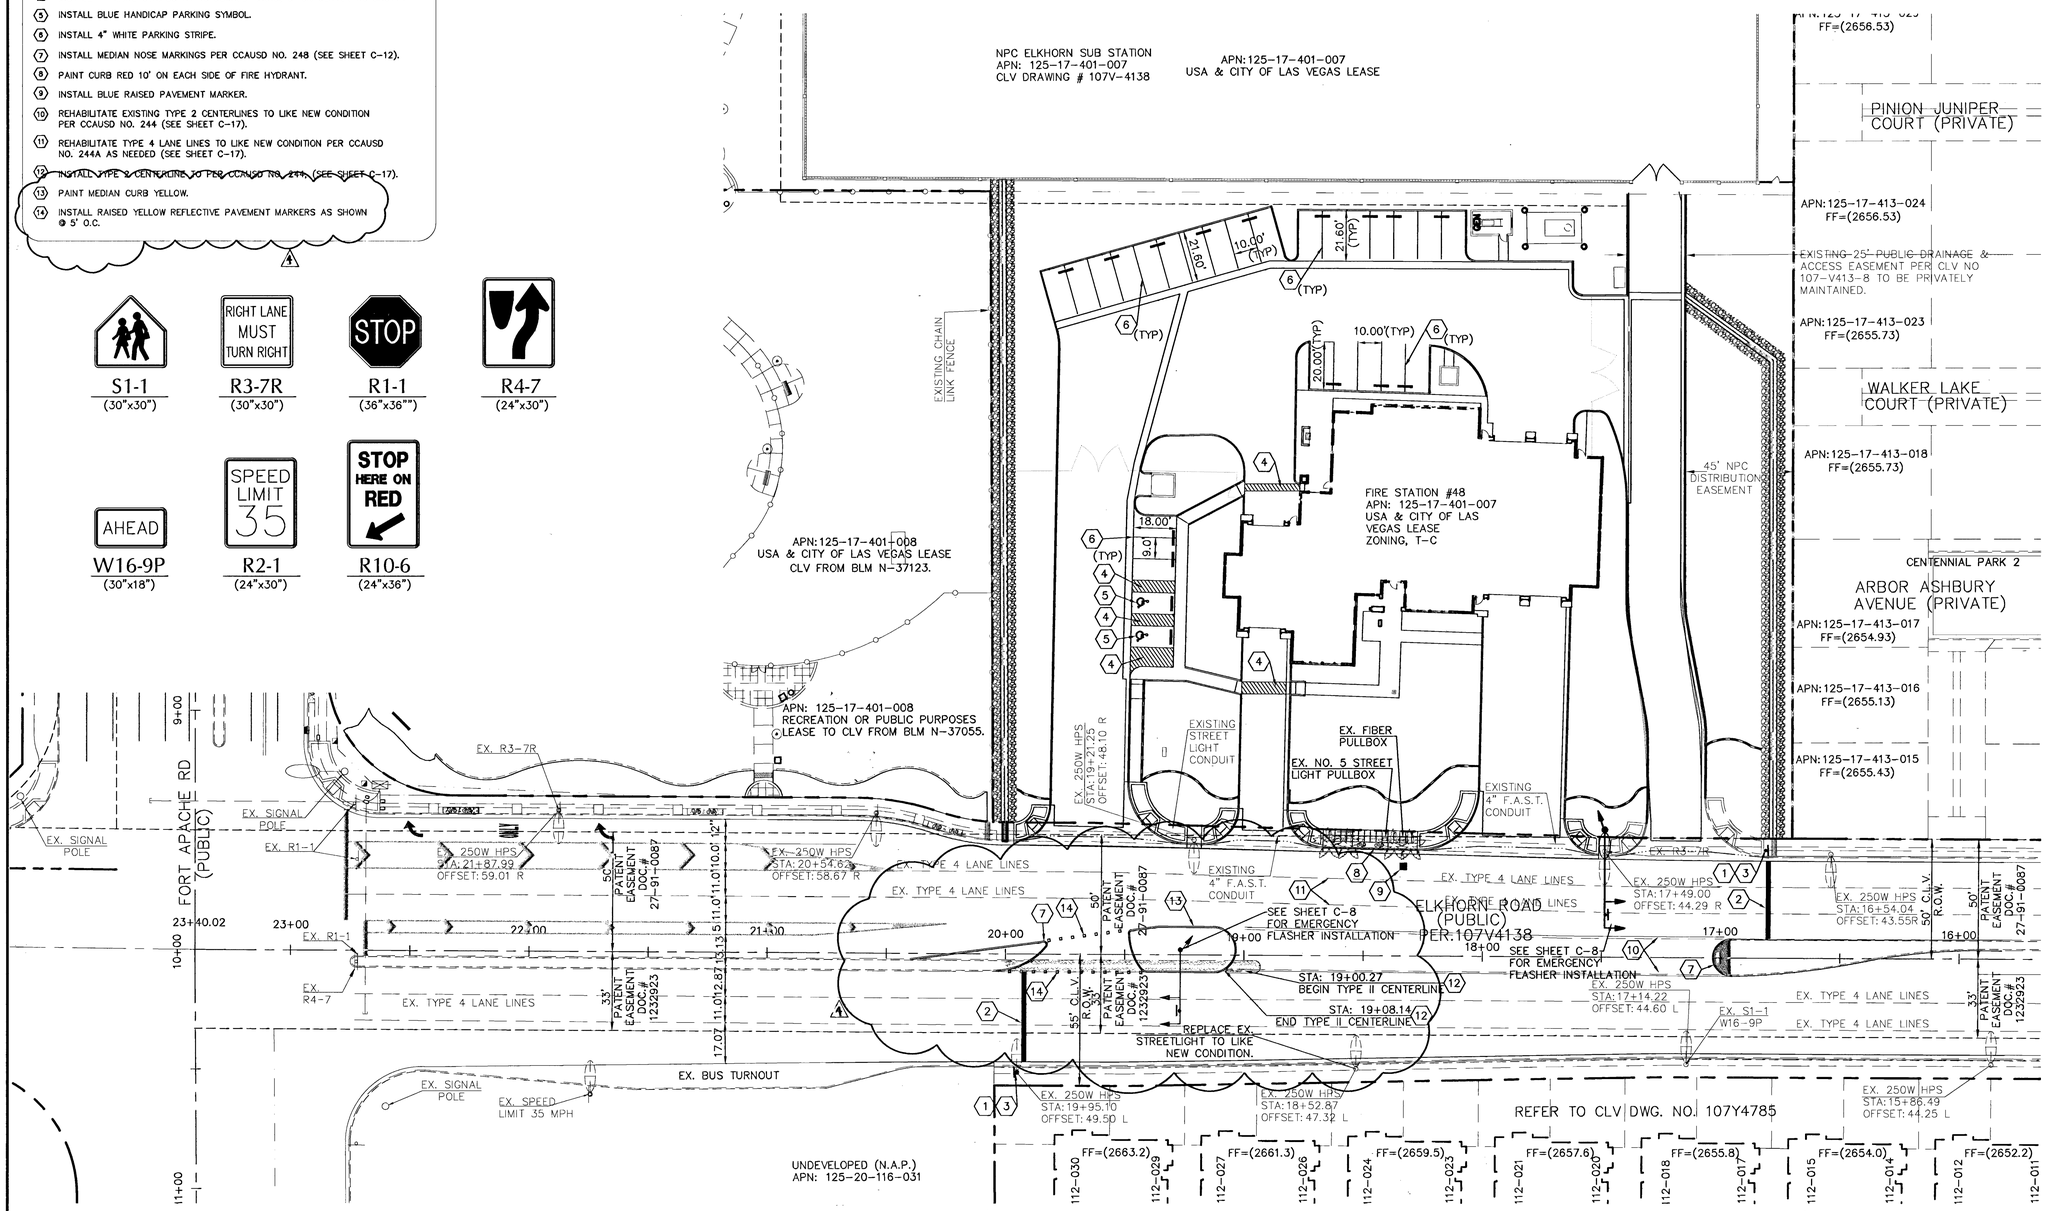

113125

AVOID HITTING UNDERGROUND TRAFFIC SIGNAL AND STREET LIGHT SYSTEMS. IT'S COSTLY.
CALL BEFORE YOU DO UNDERGROUND WORK
CALL 1-702-455-7511 CLARK COUNTY TRAFFIC OPERATIONS AND
CALL 1-702-432-5300 FREEWAY AND ARTERIAL SYSTEM OF TRANSPORTATION

AVOID HITTING OVERHEAD POWER LINES. IT'S COSTLY.
CALL BEFORE YOU DO OVERHEAD WORK
CALL 1-702-227-2929

AVOID CUTTING UNDERGROUND UTILITY LINES. IT'S COSTLY.
CALL 811
OR
1-800-227-2600
AND
CLARK COUNTY TRAFFIC OPERATIONS
CALL 1-702-455-7244

MARTIN & MARTIN ASSUMES NO RESPONSIBILITY FOR EXISTING UTILITY LOCATIONS AND ELEVATIONS. THE UTILITIES SHOWN ON THIS DRAWING HAVE BEEN PLOTTED FROM THE BEST AVAILABLE INFORMATION. IT IS, HOWEVER, THE CONTRACTOR'S RESPONSIBILITY TO FIELD VERIFY THE LOCATION AND ELEVATION OF ALL UTILITIES PRIOR TO THE COMMENCEMENT OF ANY CONSTRUCTION. CONTRACTOR TO FIELD VERIFY ALL EXISTING SITE CONDITIONS PRIOR TO CONSTRUCTION. IF A CONFLICT EXISTS BETWEEN WHAT IS SHOWN ON THESE DRAWINGS AND WHAT EXISTS IN THE FIELD, THE CONTRACTOR IS TO NOTIFY THE ARCHITECT OR ENGINEER IMMEDIATELY.

FUTURE | EXISTING | PROPOSED
0.00% | (0.00%) | 0.00% SLOPE
[0.00] | (0.00) | 0.00 GRADING/ ELEVATION TAG
XXX | XXX | XXX STORM MANHOLE
DRAIN INLET
CONTOUR
SCREEN/ RETAINING WALL

POWER LINE/POLE
TELEPHONE LINE
METERS/PULL BOXES
UTILITY POLE
REDUCER
STREET LIGHTS
100 W H.P.S.
150 W H.P.S.
200 W H.P.S.
250 W H.P.S.
AREA LIGHT

FIRE HYDRANT
FIRE DEPARTMENT CONNECTION
WATER VALVE
SEWER MANHOLE
SEWER CLEANOUT
STORM CLEANOUT
GAS VALVE

PL-RIGHT-OF-WAY
PL-ADJACENT
CENTERLINE
EASEMENT LINE
FLOW LINE
WATER LINE
GAS LINE
STORM DRAIN
SANITARY SEWER LINE

AC PAVEMENT
6" TYPE "A" CURB
24" TYPE "1" CURB & GUTTER
30" ROLL CURB
CONCRETE

SIGN POLE
CHAIN LINK FENCE
WIRE FENCE
GUARDRAIL
FF=[0.00] FF=(0.00) FF=0.00 FINISH FLOOR

MISCELLANEOUS
SAWCUT LINE
LANDSCAPING

MYLAR REPLOT 24423

REV	DESCRIPTION	BY	DATE	AGEN. APP.
4	REVISE EMERGENCY FLASHER LOCATION AND ADD MEDIAN.			

PROJ NO: 2193.00
DESIGN: JL
PLOT DATE: 09/09/08
SCALE: AS SHOWN
STAMP DATE: 09/09/08

PROFESSIONAL ENGINEER STATE OF NEVADA
THOMAS D. MILLER
EXP. 12-31-09
CIVIL
NO. 15776

MARTIN MARTIN
CIVIL ENGINEERS & SURVEYORS
2101 S. JONES BLVD
SUITE 120
LAS VEGAS, NV 89146
PHONE (702) 248-8000
FAX (702) 248-8070

CITY OF LAS VEGAS
FIRE STATION NO. 48
TRAFFIC SIGNAGE,STRIPING & STREET LIGHTING

SHEET C-7
7 OF 26 SHTS
CLV DWG. NO. 630-104

H:\Dwg\Land\2193 FIRE STN 48\dwg\sheets\DELTA 3\2193-C7-TRAFFIC, SIGNAGE & STRIPING.DWG, C7, 9/9/2008 8:32:55 AM, tpodesi