



Door Schedule

Door No.	Size	Rating	Type	Material	Finish	Hardware		Frame	Rating	Details			
						No.	Additional Notes			Material	Finish	Head	Jamb
101	3'-0" x 7'-0" x 1 3/4"		B	SCUD	① IP-1	1	SEE DOOR NOTES, THIS PAGE			HM	IP-1	4/AT	4/AT
102A	3'-0" x 7'-0" x 1 3/4"		C	SCUD	① IP-1	2	SEE DOOR NOTES, THIS PAGE			HM	IP-1	4/AT	4/AT
102B	3'-0" x 7'-0" x 1 3/4"		F	ALUM.	① IP-1	3	STOREFRONT DOOR W/ TYP. GLASS			HM	IP-1	4/AT	4/AT
103	3'-0" x 7'-0" x 1 3/4"		C	SCUD	① IP-1	4	SEE DOOR NOTES, THIS PAGE			HM	IP-1	4/AT	4/AT
105	3'-0" x 7'-0" x 1 3/4"		C	SCUD	① IP-1	2	SEE DOOR NOTES, THIS PAGE			HM	IP-1	4/AT	4/AT
106	3'-0" x 7'-0" x 1 3/4"		C	SCUD	① IP-1	4	SEE DOOR NOTES, THIS PAGE			HM	IP-1	4/AT	4/AT
106A	3'-0" x 7'-0" x 1 3/4"		C	SCUD	① IP-1	2	SEE DOOR NOTES, THIS PAGE			HM	IP-1	4/AT	4/AT
107	3'-0" x 7'-0" x 1 3/4"		D	HM	IP-1	11	NO LOUVER * THIS DOOR - RFI 2			HM	IP-1	4/AT	4/AT
108	3'-0" x 7'-0" x 1 3/4"		D	HM	IP-1	1	SEE DOOR NOTES, THIS PAGE			HM	IP-1	4/AT	4/AT
109	3'-0" x 7'-0" x 1 3/4"		G	HM	IP-1	1	SEE DOOR NOTES, THIS PAGE			HM	IP-1	4/AT	4/AT
110A	4'-0" x 7'-0" x 1 3/4"		E	HM	IP-1	1	SEE DOOR NOTES, THIS PAGE			HM	IP-1	4/AT	4/AT
110B	3'-0" x 7'-0" x 1 3/4"		A	STEEL	①	-	SECTIONAL ROLL UP GARAGE DOOR			STEEL	-	12/A101	4/A101
110C	3'-0" x 7'-0" x 1 3/4"		A	STEEL	①	-	SECTIONAL ROLL UP GARAGE DOOR			STEEL	-	12/A101	4/A101
110D	3'-0" x 7'-0" x 1 3/4"		G	HM	EP-2	6	SEE EXTERIOR FINISH SCHEDULE			HM	IP-1	2/AT	2/AT
111	3'-0" x 7'-0" x 1 3/4"		G	HM	IP-1	1	LOUVER, SEE MECH. DUGS.			HM	IP-1	4/AT	4/AT
112A	2'-6" x 7'-0" x 1 3/4"		I	SCUD	① IP-1	9	SEE DOOR NOTES, THIS PAGE			HM	IP-1	4/AT	4/AT
112B	2'-6" x 7'-0" x 1 3/4"		I	SCUD	① IP-1	9	SEE DOOR NOTES, THIS PAGE			HM	IP-1	4/AT	4/AT
112C	2'-6" x 7'-0" x 1 3/4"		I	SCUD	① IP-1	9	SEE DOOR NOTES, THIS PAGE			HM	IP-1	4/AT	4/AT
114A	3'-0" x 7'-0" x 1 3/4"		H	SCUD	① IP-1	13	SEE DOOR NOTES, THIS PAGE			HM	IP-1	4/AT	4/AT
114B	3'-0" x 7'-0" x 1 3/4"		H	SCUD	① IP-1	13	SEE DOOR NOTES, THIS PAGE			HM	IP-1	4/AT	4/AT
115A	3'-0" x 7'-0" x 1 3/4"		C	SCUD	① IP-1	2	SEE DOOR NOTES, THIS PAGE			HM	IP-1	4/AT	4/AT
115B	3'-0" x 7'-0" x 1 3/4"		C	SCUD	① IP-1	2	SEE DOOR NOTES, THIS PAGE			HM	IP-1	4/AT	4/AT
116	3'-0" x 7'-0" x 1 3/4"		C	SCUD	① IP-1	4	SEE DOOR NOTES, THIS PAGE			HM	IP-1	4/AT	4/AT
117	3'-0" x 7'-0" x 1 3/4"		C	SCUD	① IP-1	12	SEE DOOR NOTES, THIS PAGE			HM	IP-1	4/AT	4/AT
120A	3'-0" x 7'-0" x 1 3/4"		C	SCUD	① IP-1	2	SEE DOOR NOTES, THIS PAGE			HM	IP-1	4/AT	4/AT
120B	3'-0" x 7'-0" x 1 3/4"		C	SCUD	① IP-1	2	SEE DOOR NOTES, THIS PAGE			HM	IP-1	4/AT	4/AT
120C	3'-0" x 7'-0" x 1 3/4"		D	HM	EP-2	10	SEE EXTERIOR FINISH SCHEDULE			HM	IP-1	2/AT	2/AT
121	3'-0" x 7'-0" x 1 3/4"		C	SCUD	① IP-1	4	SEE DOOR NOTES, THIS PAGE			HM	IP-1	4/AT	4/AT
122	3'-0" x 7'-0" x 1 3/4"		C	SCUD	① IP-1	4	SEE DOOR NOTES, THIS PAGE			HM	IP-1	4/AT	4/AT
131	3'-0" x 7'-0" x 1 3/4"		H	SCUD	① IP-1	13	SEE DOOR NOTES, THIS PAGE			HM	IP-1	4/AT	4/AT
133A	4'-0" x 7'-0" x 1 3/4"		E	HM	IP-1	5	-			HM	IP-1	4/AT	4/AT
133B	4'-0" x 7'-0" x 1 3/4"		E	HM	IP-1	5	-			HM	IP-1	4/AT	4/AT
133C	13'-4" x 14'-0"		A	STEEL	①	-	SECTIONAL ROLL UP GARAGE DOOR			STEEL	-	12/A101	4/A101
133D	13'-4" x 14'-0"		A	STEEL	①	-	SECTIONAL ROLL UP GARAGE DOOR			STEEL	-	12/A101	4/A101
133E	13'-4" x 14'-0"		A	STEEL	①	-	SECTIONAL ROLL UP GARAGE DOOR			STEEL	-	12/A101	4/A101
133F	13'-4" x 14'-0"		A	STEEL	①	-	SECTIONAL ROLL UP GARAGE DOOR			STEEL	-	12/A101	4/A101
133G	3'-0" x 7'-0" x 1 3/4"		G	HM	EP-1	6	SEE EXTERIOR FINISH SCHEDULE			HM	IP-1	2/AT	2/AT
133H	3'-0" x 7'-0" x 1 3/4"		G	HM	EP-1	10	SEE EXTERIOR FINISH SCHEDULE			HM	IP-1	2/AT	2/AT
134	3'-0" x 7'-0" x 1 3/4"		D	HM	IP-1	11	LOUVER, SEE MECH. DUGS.			HM	IP-1	4/AT	4/AT
135	4'-0" x 7'-0" x 1 3/4"		E	HM	IP-1	11	LOUVER, SEE MECH. DUGS.			HM	IP-1	4/AT	4/AT
136A	3'-0" x 7'-0" x 1 3/4"		D	HM	IP-1	11	LOUVER, SEE MECH. DUGS.			HM	IP-1	4/AT	4/AT
136B	3'-0" x 7'-0" x 1 3/4"		D	HM	IP-1	11	LOUVER, SEE MECH. DUGS.			HM	IP-1	4/AT	4/AT
138	3'-0" x 7'-0" x 1 3/4"		C	SCUD	① IP-1	1	SEE DOOR NOTES, THIS PAGE			HM	IP-1	4/AT	4/AT
139	3'-0" x 7'-0" x 1 3/4"		C	SCUD	① IP-1	1	SEE DOOR NOTES, THIS PAGE			HM	IP-1	4/AT	4/AT
140	3'-0" x 7'-0" x 1 3/4"		G	HM	EP-2	8	SEE EXTERIOR FINISH SCHEDULE			HM	IP-1	2/AT	2/AT
141	3'-0" x 7'-0" x 1 3/4"		G	HM	EP-2	8	SEE EXTERIOR FINISH SCHEDULE			HM	IP-1	2/AT	2/AT

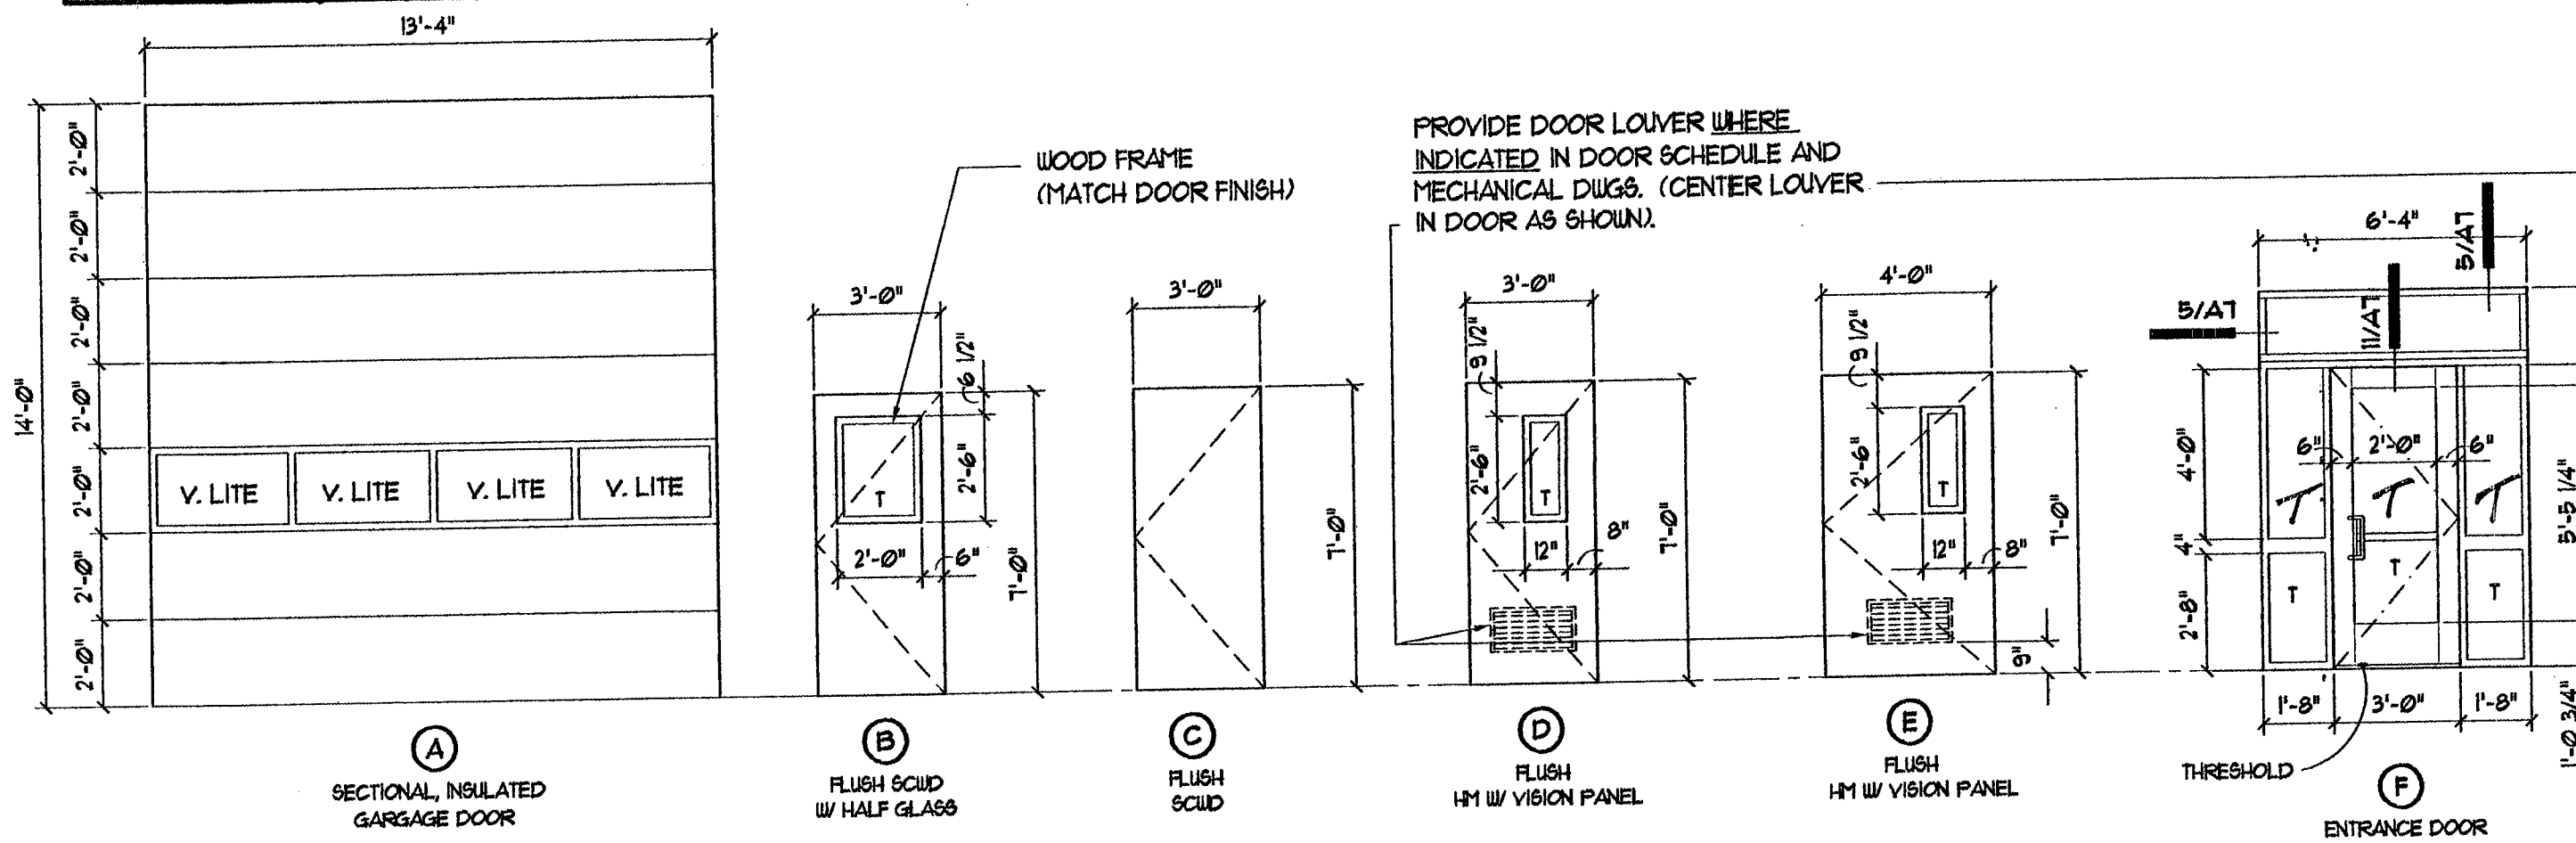

Door Types

Not to Scale

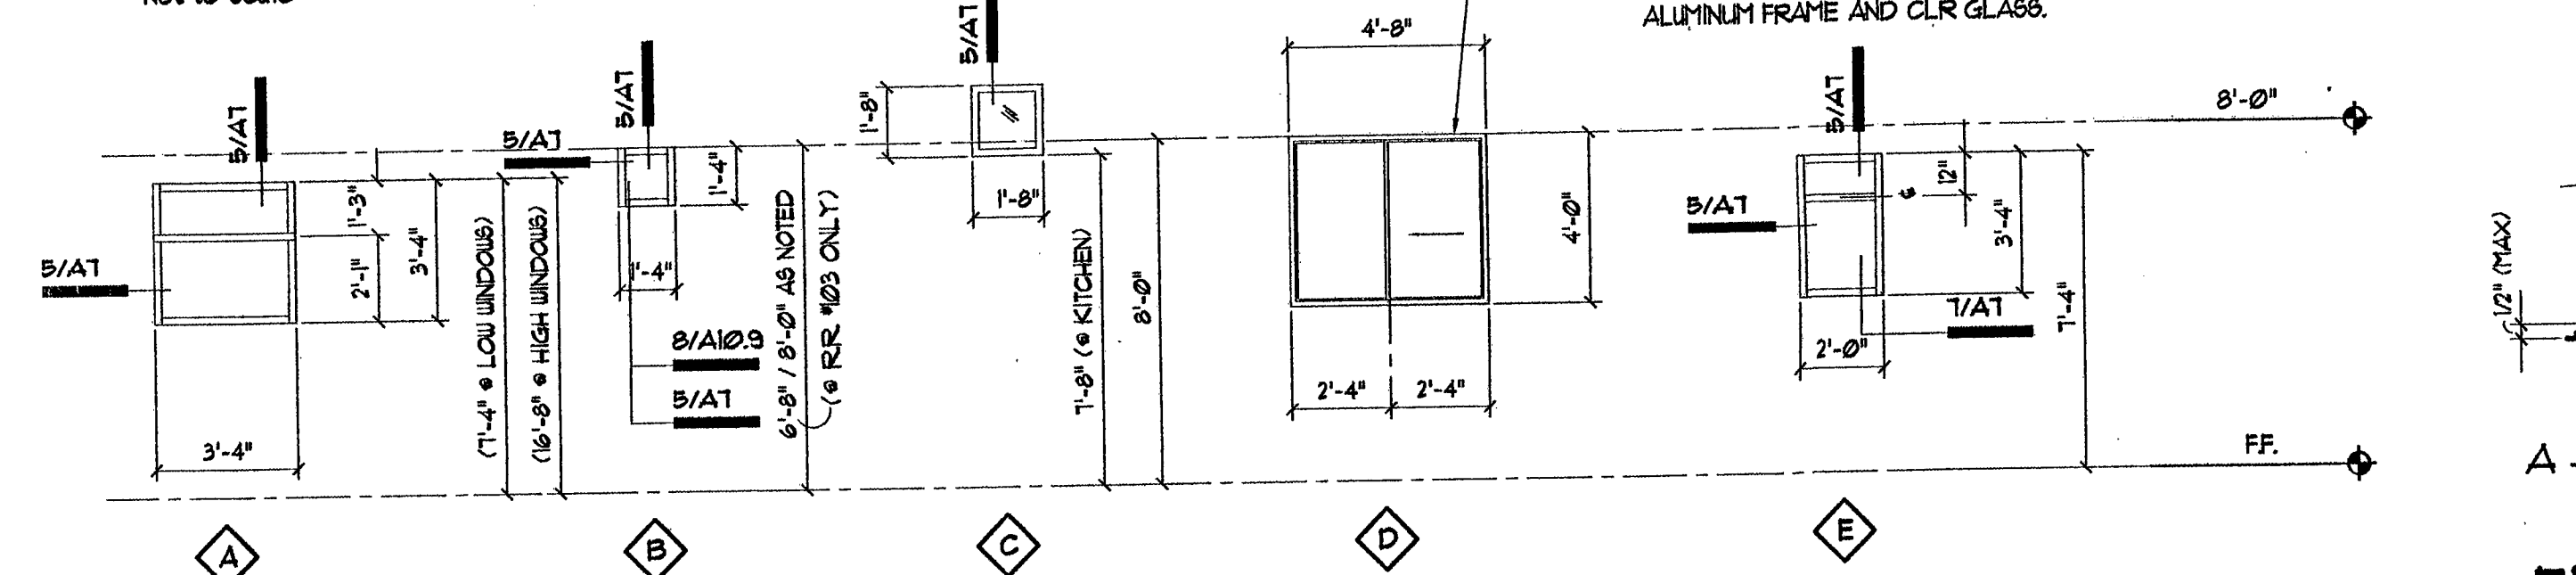

Window Types

Not to Scale

Room Finish Schedule

Room No.	Room Name	Floor	Base	Use North oriented left as shown on site. All for walls.				Ceiling
				East	South	West	North	
101	CAPTAIN'S OFFICE	CFT-1	CBT	IP-1	IP-1	IP-1	IP-1	AC-1
102	HALL	CFT-1	CBT	IP-1	IP-1	IP-1	IP-1	AC-1
102A	ENTRY	CFT-1	CBT	IP-1	IP-1	IP-1	IP-1	AC-1
103	RESTROOM	CFT-2	CUT-1	CT/G-2	CT/G-2	CT/G-2	CT/G-2	IP-VCT
104	RESCUE DORM	CPT-1	RB-1	IP-1	IP-1	IP-1	IP-1	AC-1
105	RESCUE OFFICE	CPT-1	RB-1	IP-1	IP-1	IP-1	IP-1	AC-1
106	RESTROOM	CFT-2	CUT-1	CT/G-2	CT/G-2	CT/G-2	CT/G-2	IP-VCT
106A	HALL	CPT-1	RB-1	IP-1	IP-1	IP-1	IP-1	AC-1
107	CLEAN ROOM	SC	RB-1	IP-1	IP-1	IP-1	IP-1	IP-1
108	TURNOUT LOCKERS	SC	RB-1	IP-1	IP-1	IP-1	IP-1	IP-1
109	MED. STORAGE	SC	RB-1	IP-1	IP-1	IP-1	IP-1	IP-1
110	RESCUE APPARATUS BAY	SC	CBT	EPY/IP-1	EPY/IP-1	EPY/IP-1	EPY/IP-1	IP-1
111	STORAGE	SC	RB-1	IP-1	IP-1	IP-1	IP-1	IP-1
112	PANTRY	-	-	IP-1	IP-1	IP-1	IP-1	IP-1
113	KITCHEN	-	-	IP-1	IP-1	IP-1	IP-1	IP-1
114	DINING ROOM	-	-	IP-1	IP-1	IP-1	IP-1	AC-1
115	DAYROOM	CPT-1	RB-1	IP-1	IP-1	IP-1	IP-1	AC-1
116	CAPTAIN'S DORM	CPT-1	RB-1	IP-1	IP-1	IP-1	IP-1	AC-1
117	CAPTAIN'S DORM	CPT-1	RB-1	IP-1	IP-1	IP-1	IP-1	AC-1
118	CAPTAIN'S BATH	CPT-2	CUT-1	CT/G-2	CT/G-2	CT/G-2	CT/G-2	IP-VCT
118A	VEST.	CPT-1	RB-1	IP-1	IP-1	IP-1	IP-1	AC-1
119	STORAGE	-	-	IP-1	IP-1	IP-1	IP-1	AC-1
120	HALL	-	-	IP-1	IP-1	IP-1	IP-1	AC-1
121	BATH	CFT-2	CUT-1	CT/G-2	CT/G-2	CT/G-2	CT/G-2	IP-VCT
121A	VEST.	CPT-1	RB-1	IP-1	IP-1	IP-1	IP-1	AC-1
122	BATH	CFT-2	CUT-1	CT/G-2	CT/G-2	CT/G-2	CT/G-2	IP-VCT
122A	VEST.	CPT-1	RB-1	IP-1	IP-1	IP-1	IP-1	AC-1
123	DORM	CPT-1	RB-1	IP-1	IP-1	IP-1	IP-1	AC-1
124	DORM	CPT-1	RB-1	IP-1	IP-1	IP-1	IP-1	AC-1
125	DORM	CPT-1	RB-1	IP-1	IP-1	IP-1	IP-1	AC-1
126	DORM	CPT-1	RB-1	IP-1	IP-1	IP-1	IP-1	AC-1
127	DORM	CPT-1	RB-1	IP-1	IP-1	IP-1	IP-1	AC-1
128	DORM	CPT-1	RB-1	IP-1	IP-1	IP-1	IP-1	AC-1
129	DORM	CPT-1	RB-1	IP-1	IP-1	IP-1	IP-1	AC-1
130	DORM	CPT-1	RB-1	IP-1	IP-1	IP-1	IP-1	AC-1
131	EXERCISE ROOM	RUB-1	RB-1	IP-2	IP-1	IP-1	IP-1	AC-1
132	NOT USED	-	-	-	-	-	-	-
133	ENGINE APPARATUS BAY	SC	CBT	EPY/IP-1	EPY/IP-1	EPY/IP-1	EPY/IP-1	IP-1
134	UTILITY CON	SC	RB-1	IP-1	IP-1	IP-1	IP-1	IP-1
135	CLEAN ROOM	SC	RB-1	IP-1	IP-1	IP-1	IP-1	IP-1
136	TURNOUT LOCKERS	SC	RB-1	IP-1	IP-1	IP-1	IP-1	IP-1
137	SWITCHGEAR/COMPRESSOR	SC	-	EP-1	EP-1	EP-1	EP-1	EP-1
138	TELE/ELECT.	SC	RB-1	IP-1	IP-1	IP-1	IP-1	AC-1
139	JAN/STOR	SC	RB-1	IP-1	IP-1	IP-1	IP-1	IP-1
140	RESCUE DORM	CPT-1	RB-1	IP-1	IP-1	IP-1	IP-1	AC-1
141	RESCUE DORM	CPT-1	RB-1	IP-1	IP-1	IP-1	IP-1	AC-1

Finish & Materials (Manufacturer's for reference only - see specs)	
INTERIOR FINISHES:	
SC	SEALED CONCRETE W/ SMOOTH FINISH. SEE SPEC'S. USE "ASHFORD FORMULA" FOR CONCRETE SEALER.
AC-1	ACOUSTICAL CEILING - SEE SPECIFICATIONS FOR COLOR & MFR.
IP-1	INTERIOR PAINT "ICI" (MFR 40 YY 15/084), COLOR "SEED FLARE".
IP-2	INTERIOR PAINT "ICI" (MFR XXXXXXXX), COLOR "XXXXXXXXXX".
EPY	EPOXY PAINT, SEE SPEC'S, COLOR "SEED PEARL".
CPT-1	CARPET BY "COLLINS & AIKMAN" FLOOR COVERINGS. STYLE: "MARTINIQUE", COLOR: "38408 KINGSTON".
CT	CERAMIC TILE, SEE INTERIOR ELEVATIONS 8HT. A81 & A82 FOR TILE PATTERN & COLORS.
CFT-1	1/2" x 1/2" CERAMIC FLOOR TILE TO MATCH "DALTILE" - CONTINENTAL SLATE - COLOR "ASIAN BLACK" C553
CFT-2	2" x 2" CERAMIC FLOOR TILE TO MATCH "DALTILE" - KEYSTONE - COLOR "EBONY" #D31
CBT	1/2" x 1/2" CERAMIC BASE TILE W/ BULLNOSED EDGE TO MATCH MFR "DALTILE" CONTINENTAL SLATE - COLOR "ASIAN BLACK" C553. NOTE: BASE TILE SHALL BE FACTORY FABRICATED.
CUT-1	4-1/4" x 4-1/4" CERAMIC WALL TILE TO MATCH "DALTILE" - #295 CT - "ALMOND"
CUT-2	1" x 6" "LINER" CERAMIC WALL TILE TO MATCH "DALTILE" - #K-III - "BLACK"
CUT-3	2" x 2" CERAMIC WALL TILE TO MATCH "DALTILE" - PER "ABRITES GLOSS ALMOND 6465"
CUT-4	2" x 2" CERAMIC WALL TILE TO MATCH "DALTILE" - PER "ABRITES GLOSS SABLE 6421"
RUB-1	3/8" RUBBER FLOORING - SEE SPECIFICATIONS.
G-1	GROUT BY "LATICRETE INTERNATIONAL", SPECTRALOCK COLOR 22 "MIDNIGHT" (FLOOR GROUT COLOR)
G-2	GROUT BY "MAPEI", COLOR "BONE". (WALL GROUT COLOR)
RUB-1	RUBBER BASE (4" H) BY "ROPPE", COLOR F193 "BLACK-BROWN" (OR APPROVED EQ.)
CR	CHAIR RAIL, SEE DETAIL 9/A104 FOR MORE INFORMATION.
LAH-1	BASE & OVERHEAD CABINETRY: LAMINATE BY "FORMICA" COLOR: "160-58 IVORY BRUSHING".
LAH-2	COUNTERTOP LAMINATE BY "WILSONART", COLOR: "4623-60 GRAPHITE NEBULA".
LAH-3	ACCENT LAMINATE BY "CHEMETAL" (METAL MICA), COLOR: "221 VENETIAN HORIZONTAL".
GL-1	3/4" GLESTONE STONE SERIES, COLOR ROSA GREY #201, GROUP B
NOTE: ALL INTERIOR SIDES OF ALL CASEWORK INCLUDING SHELVING SHALL RECEIVE WHITE MELAMINE FINISH ON ALL EXPOSED EDGES. (UNLESS NOTED OTHERWISE).	
EXTERIOR FINISHES:	
NOTE: SEE EXTERIOR FINISH LEGEND ON SHEET A41 FOR ALL EXTERIOR FINISH COLORS & MANUFACTURERS.	
Finish Schedule Notes:	
① SEE REFLECTED CEILING PLAN FOR SPECIALITY CEILING	
② EPY IP-1 TO 8'-0" AFF. (EPY COLOR TO MATCH IP-1/ IP-1 8'-0" TO CEILING)	
③ SEE DTL 9/A104 FOR CHAIRRAIL DETAIL.	
④ DO NOT INSTALL BASE BEHIND LOCKERS.	
⑤ 8"x4"x1/8" EXPOSED CHU, SEE WALL LEGEND.	
⑥ USE SEMI GLOSS PAINT @ ALL RR CEILING.	
⑦ PROVIDE BATT. INSUL. DIRECTLY ABOVE ACOUSTICAL CEILING. PROVIDE OPENING @ RETURN AIR GRILLE OPENINGS.	

Door Schedule Notes:

- CH. SECTIONAL DOORS SHALL HAVE FACTORY WHITE FINISH.
- SEE SPEC'S FOR INFO. ON FINISH OF ALL INTERIOR SCUD DOORS. (USE PAINT GRADE DOORS W/ IP-2 PAINT ON DOOR ONLY, NOT FRAMES)
- SEE SHOP DUGS. & SPEC'S FOR ALL INFO.