



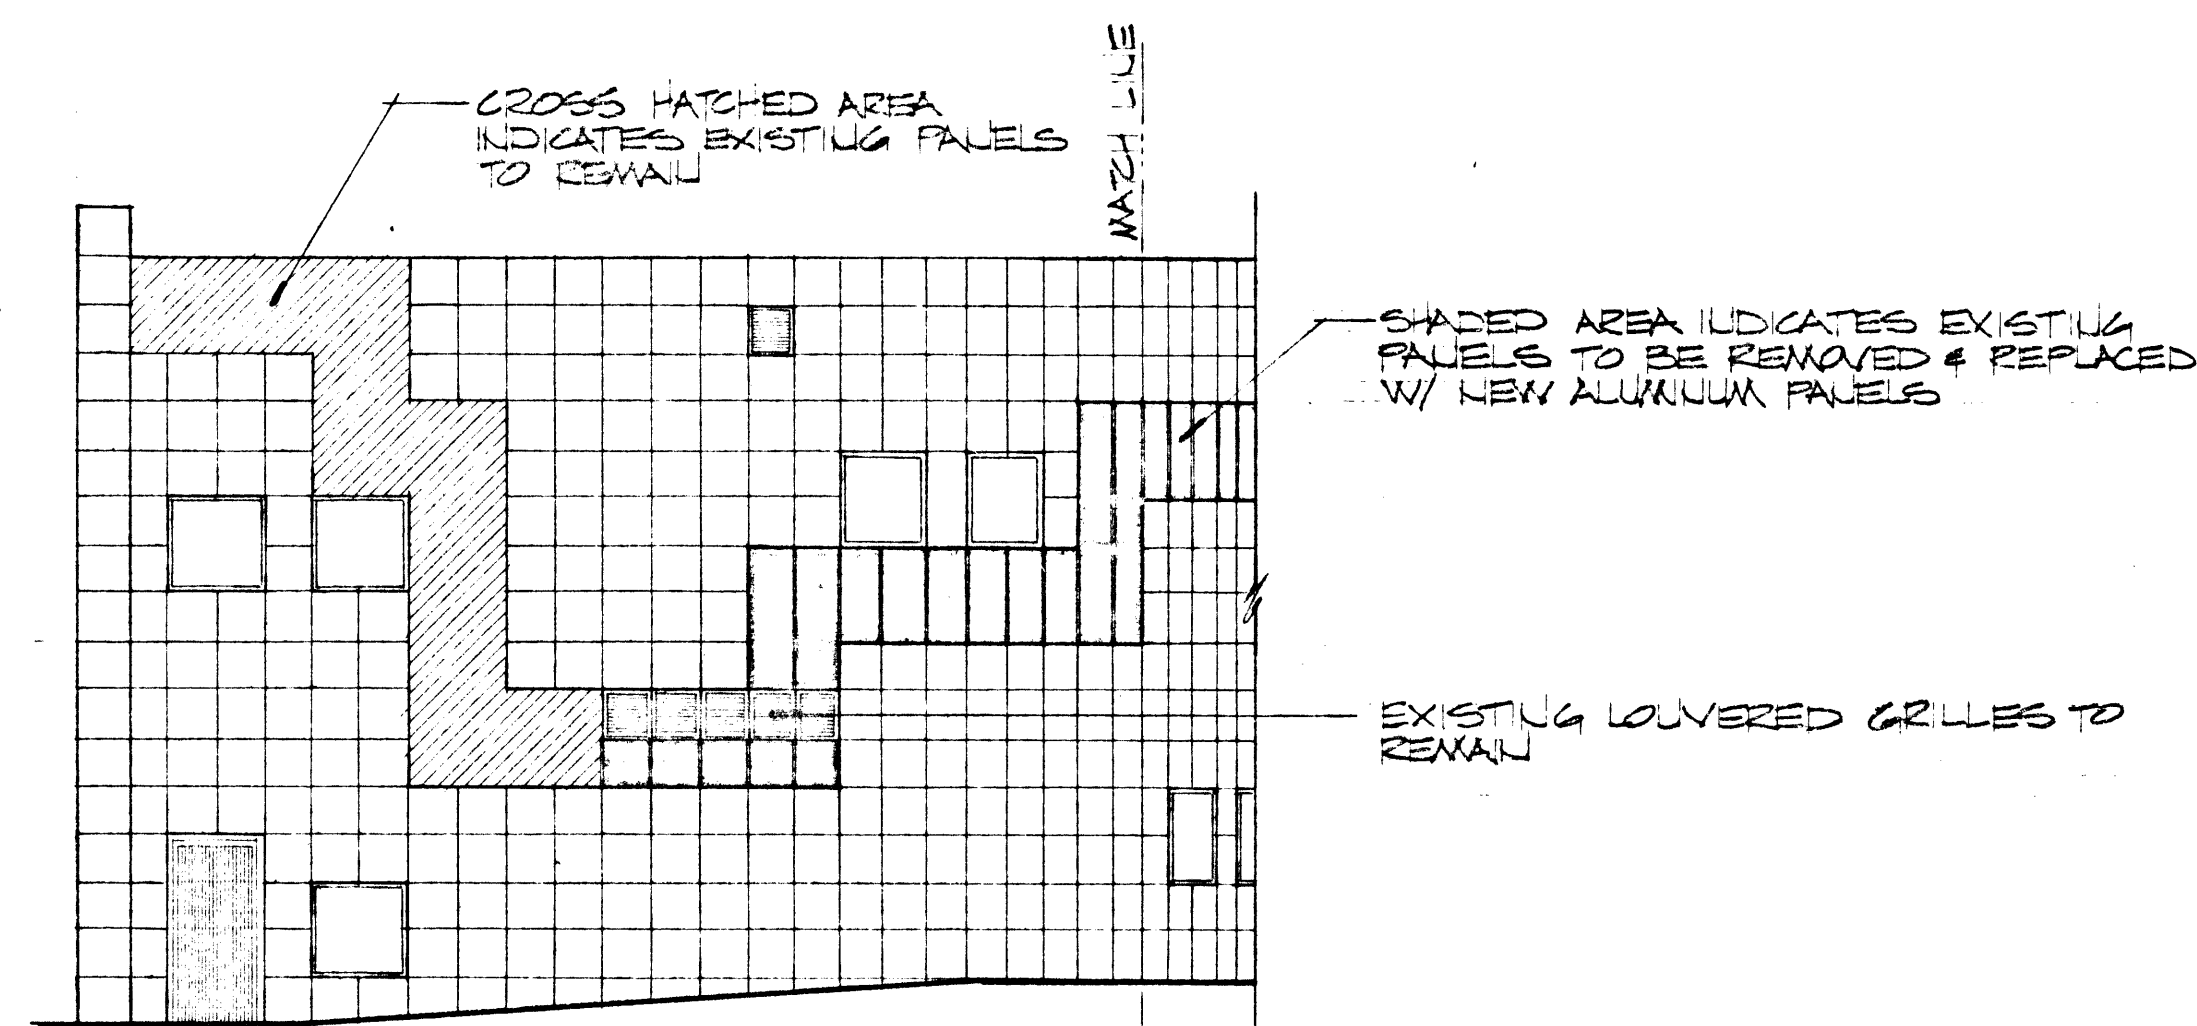

WEST ELEVATION

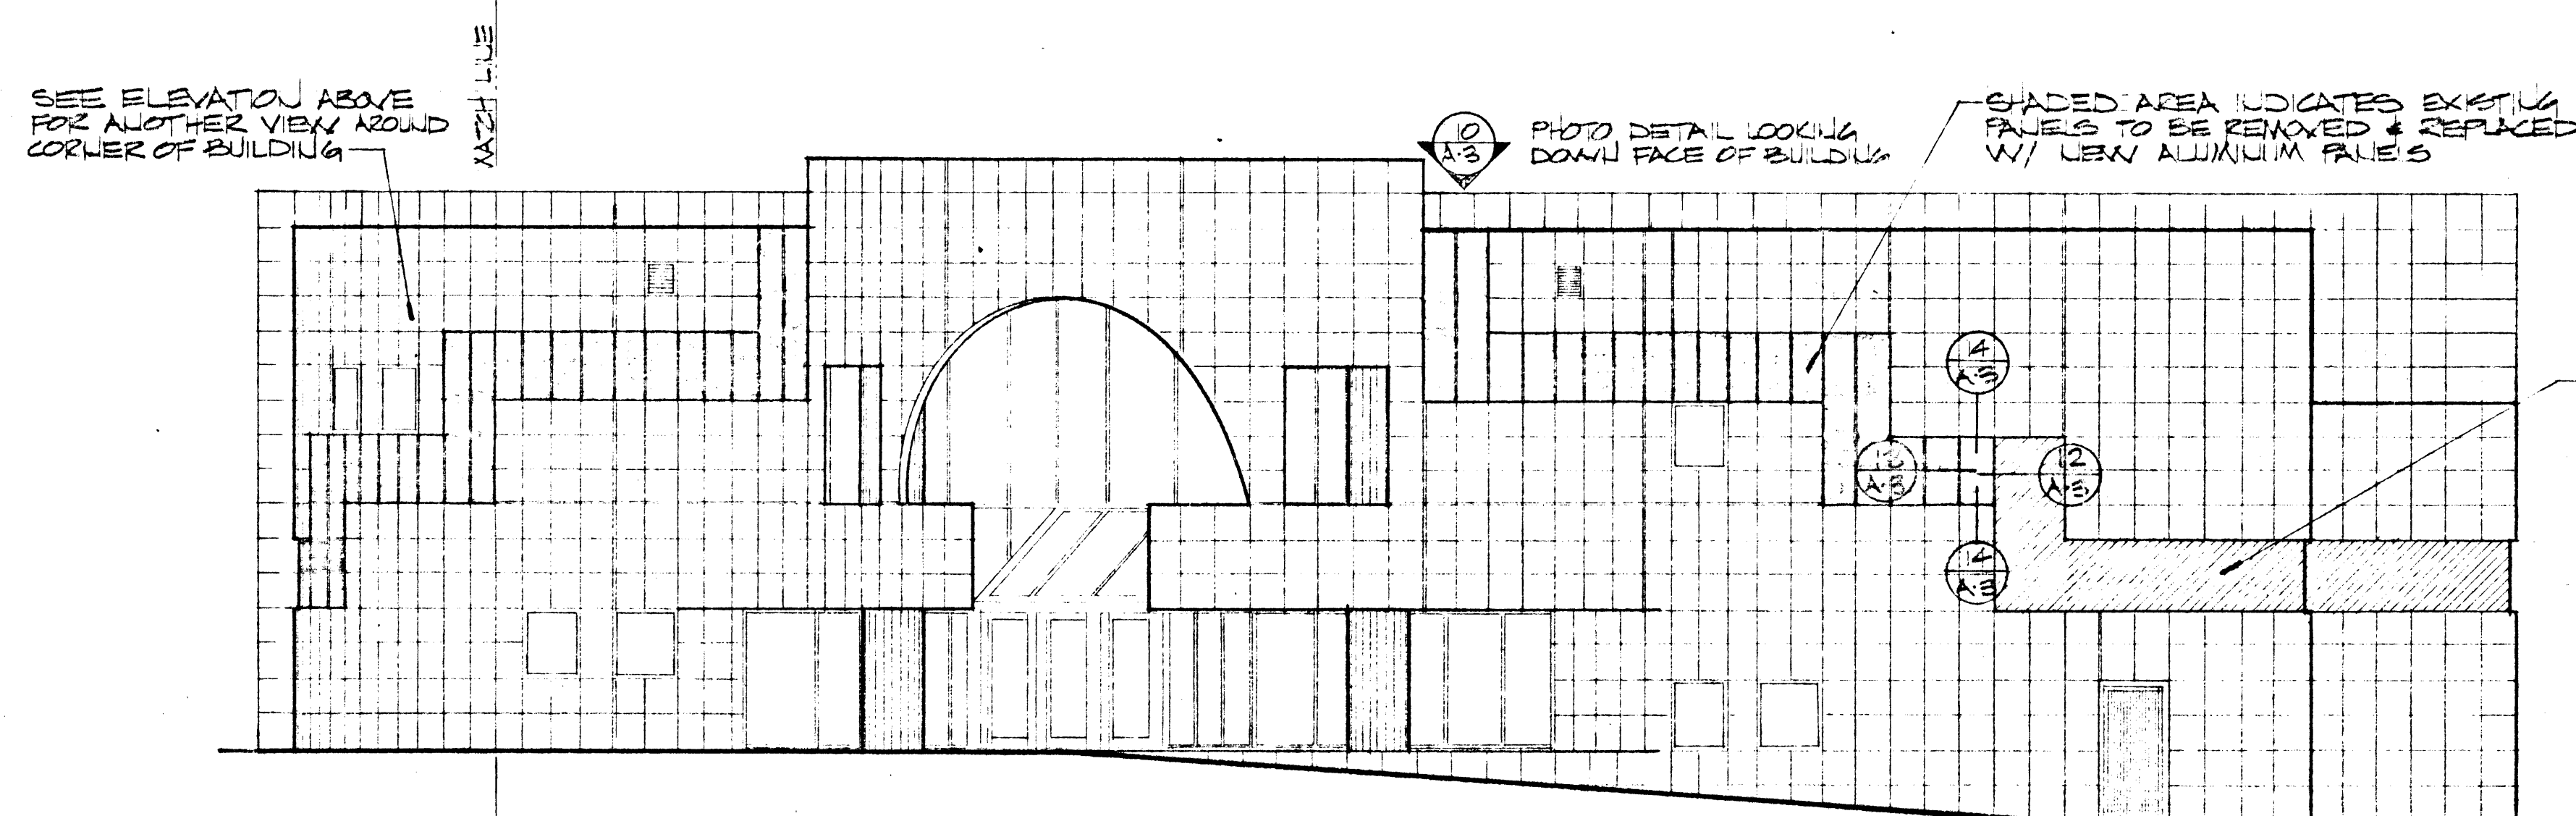

SOUTHWEST ELEVATION

**HARDWARE GROUP #1**

- 1/2" PR. BUTTS
- 1/4" PUSH PLATE
- 1/4" PULL PLATE
- 1/4" CLOSER
- 1/4" KICK PLATE
- 1/4" STOP
- 1/4" SADDLE
- 1/4" D.B. INDICATOR

FB3179 4-1/2 x 4-1/2  
1510 4x16  
7500  
20x2 LBS  
W802T  
272A  
L9486P

**NOTE**  
CONTRACTOR SHALL  
SUBMIT SK (W) COPIES  
OF MANUFACTURER'S PRODUCT  
DATA ON ALL HARDWARE  
SHOWERS & TOILET ACCESSORIES  
FOR ARCHITECT'S REVIEW &  
APPROVAL PRIOR TO  
ORDERING

EXISTING DOOR & HARDWARE TO REMAIN & ADD DEAD  
BOLT W/ INDICATOR SAME AS HARDWARE GROUP #1

NEW TOILET ROOM PLAN

NEW 8'-0" x 7'-0" x 8'-4"  
HOLLOW METAL  
INSULATED DOOR W/ T.M.E.L.  
IN SERIES HOLLOW METAL  
FRAME. SEE HARDWARE  
GROUP #1

COLLECT NEW R-TRAP TO EXIST.  
WASTE LINE FOR NEW 'GLOVER'  
SHOWER CABINET MODEL L936  
OR AN APPROVED EQ.

REINSTALL HANDICAPPED TOILET  
IN NEW HANDICAPPED STALL

NEW BOROICK 1042 SERIES  
OVERHEAD EDGED TOILET  
PARTITION (COLOR SELECTED  
BY SUBMITTAL) OR APPROVED EQ.


NEW BOROICK B3574 RECESSED  
SEAT COVER/LAPON/TOILET PAPER  
DISPENSER, MOUNT 46" FROM  
F.F. TO TOP & 47" FROM BACK  
WALL TO FACE EDGE OR APPROVED EQ.

REINSTALL GRAB BARS 33"  
FROM F.F. TO C. OF EAR


**NOTE:** PART & REPAIR TILE  
FLOOR & WALL WHERE EXIST.  
PARTITIONS WERE MOUNTED

**NOTE:** ALL PAINTED  
SURFACES SHALL BE TOUCHED  
UP TO MATCH EXISTING

TOILET ROOM DEMO PLAN

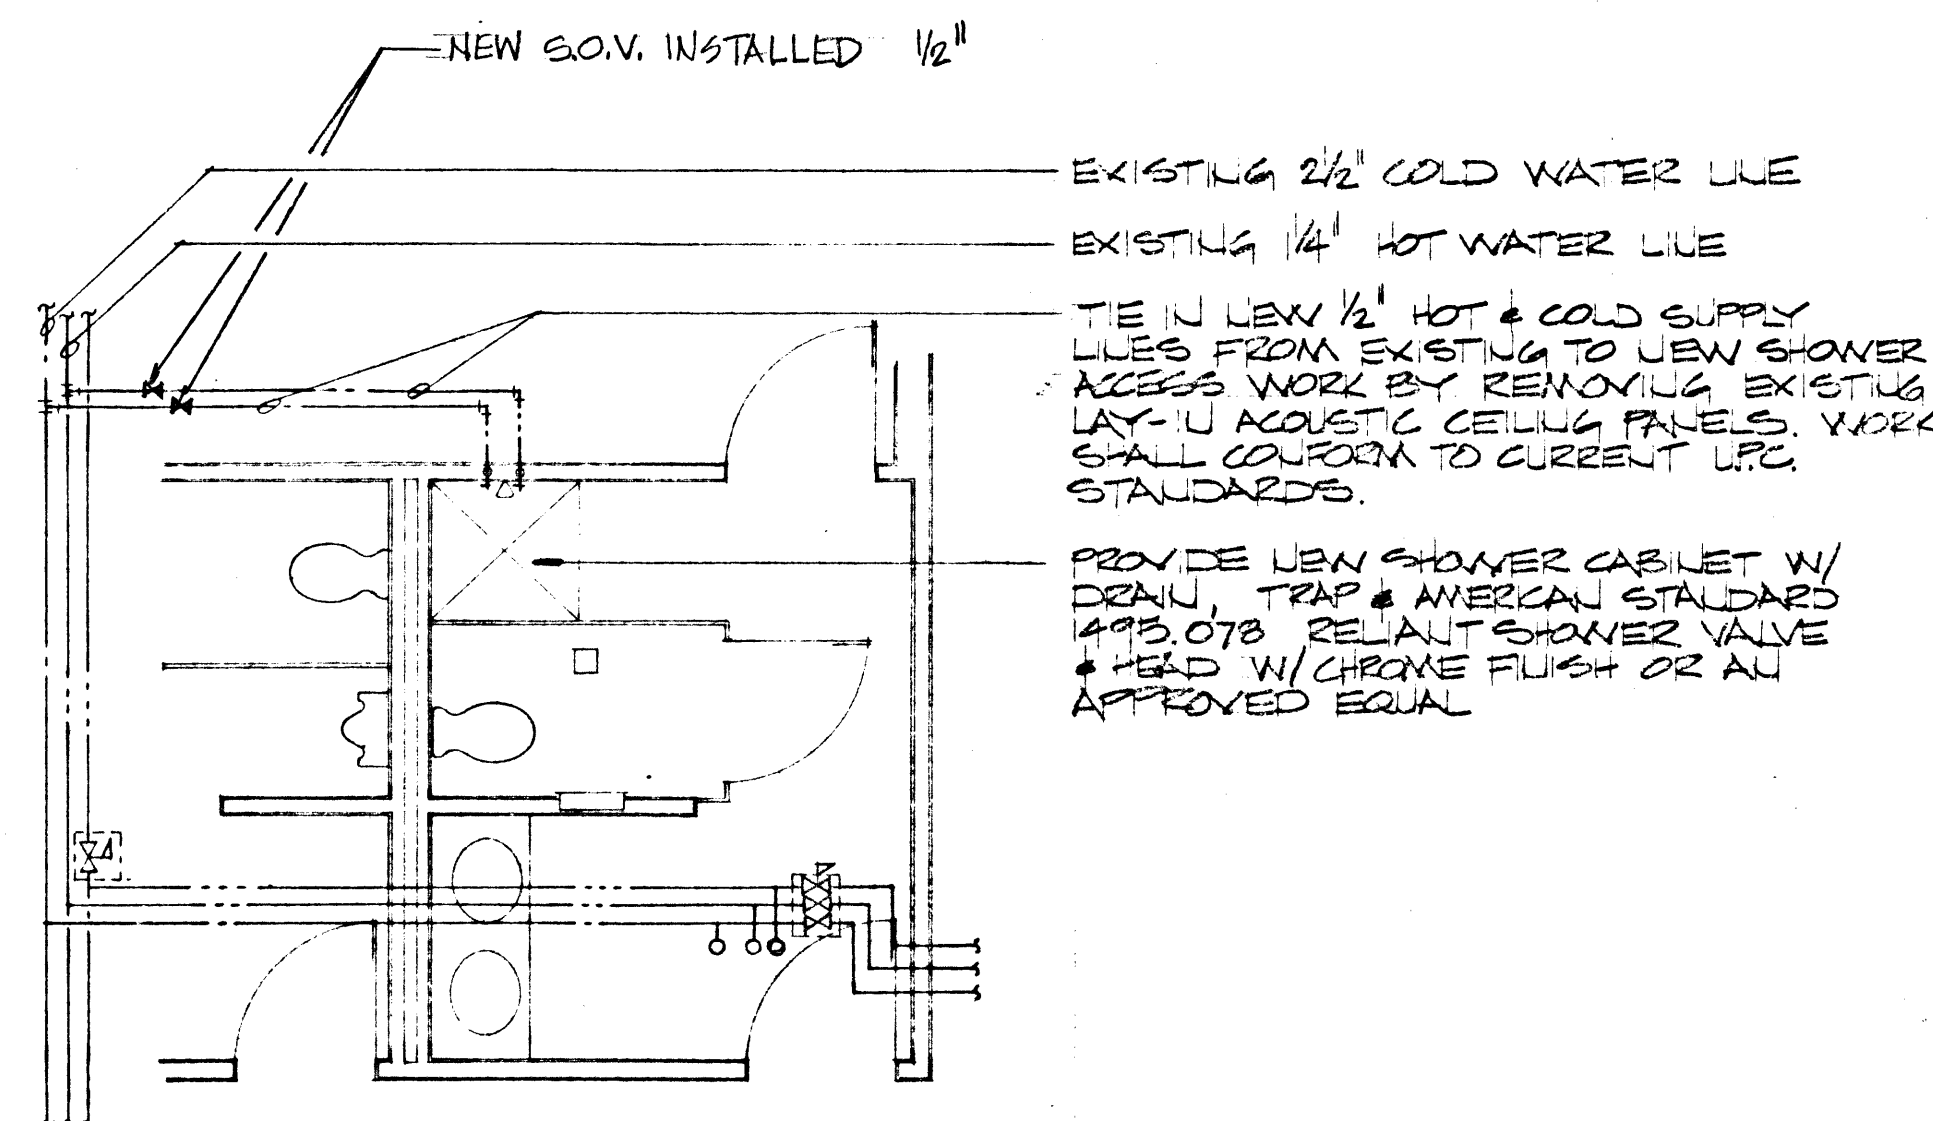

NEW PLUMBING PLAN

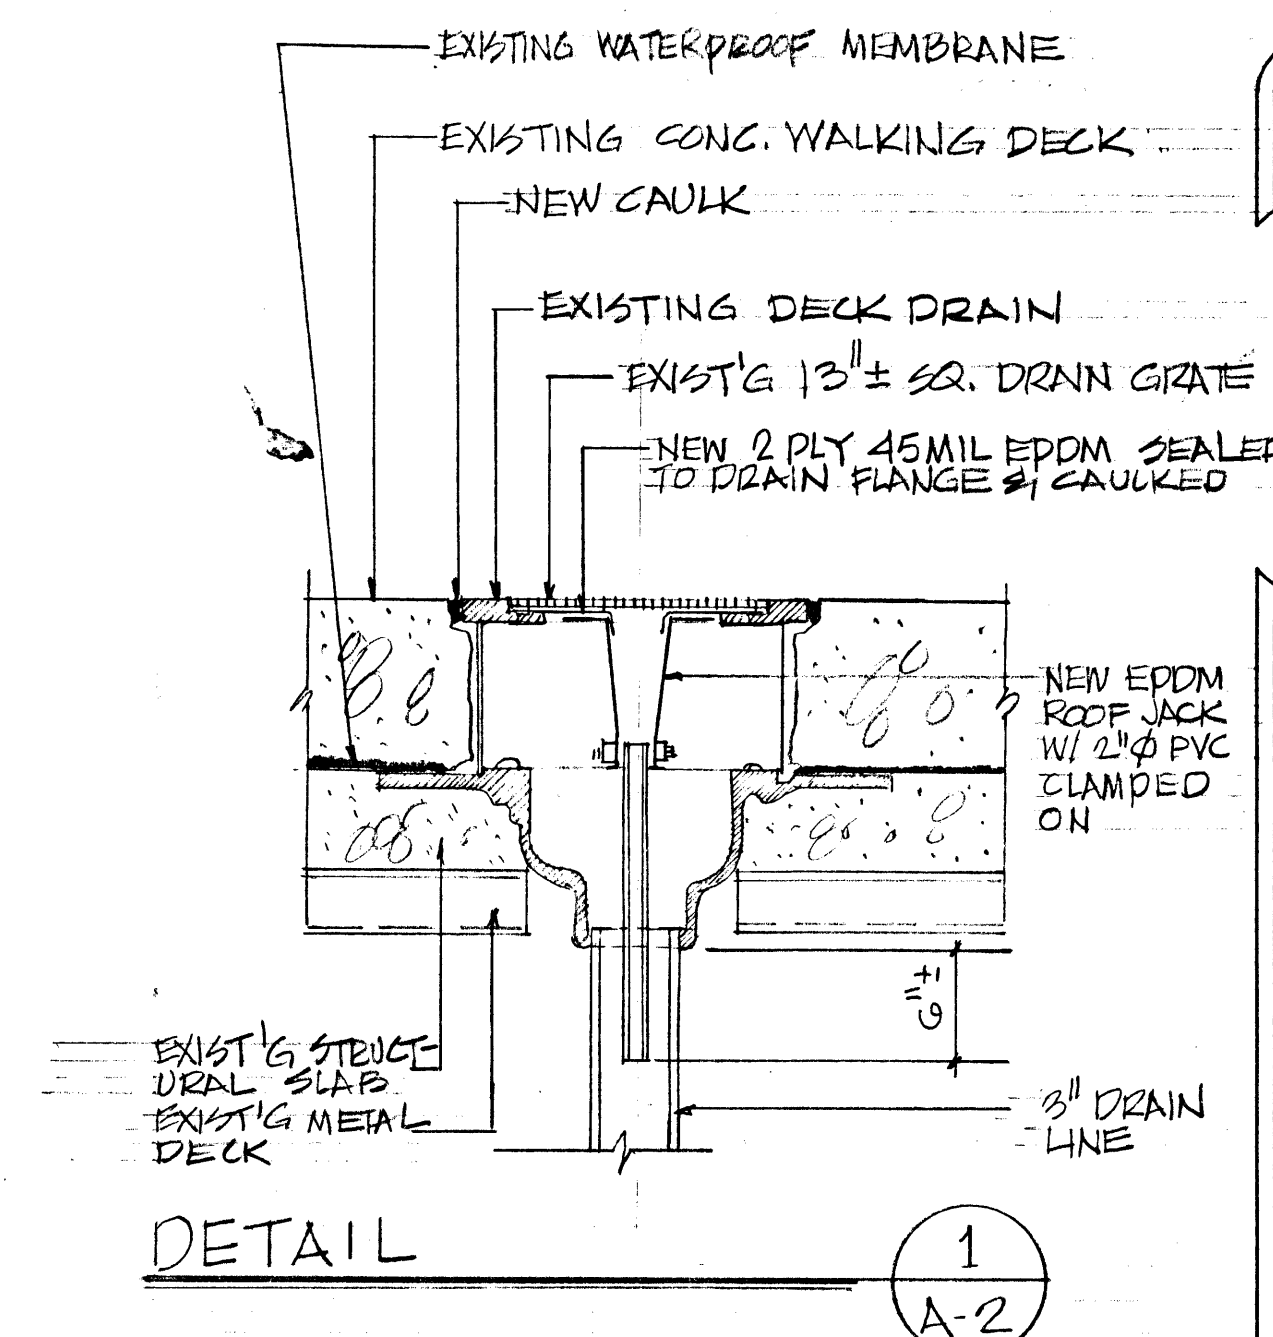

GENERAL NOTES

- (PLAZA LEVEL PLAN ONLY)
1. REMOVE ALL EXISTING SEALANT & EXIST.  
SEALED JOINTS. CLEAN & RESEAL  
SEE SPECIFICATIONS & DETAILS BELOW
  2. EXISTING CRACKS TO BE REPAIRED.  
SEE SPECIFICATION

ORIGINAL CAULKING AND BACKER  
ROD HAD FAILED. NEW BACKER  
ROD AND CAULKING INSTALLED  
IN THESE AREAS.

LIGHT LINES SHOW PLAN  
BELOW PLAZA

DASHED LINES INDICATE  
EXISTING SEALED JOINTS

DOTTED LINES INDICATE A  
CRACK TO BE REPAIRED

EXISTING TILE SHORT WALL

REMOVE ALL EXISTING  
CAULKING

REPAIR EXIST. BACKER  
ROD AS REQ'D

EXIST. PLAZA DECK

EXISTING JOINT (TYP.)


NEW HORIZONTAL TRAFFIC  
SURFACE CAULKING

EXISTING BACKER

EXISTING PLAZA DECK

NEW JOINT (TYP.)

PARTIAL PLAZA LEVEL FLOOR PLAN

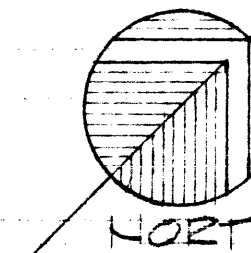

Harris Sharp Associates Incorporated  
Architecture, Planning, Interiors  
4800 West Charleston Boulevard Las Vegas, Nevada 89102 (702) 877-0025

EXISTING PLAZA & TOILET PLAZA PLANS, NEW TOILET PLAN  
REPAIRS TO FIRE CRACKS  
IN PLAZA

**DRAWING**  
RECORD

230207.6  
JAN. 30, 1990  
BF  
TMS  
Sheet  
A-2  
4  
630-748