


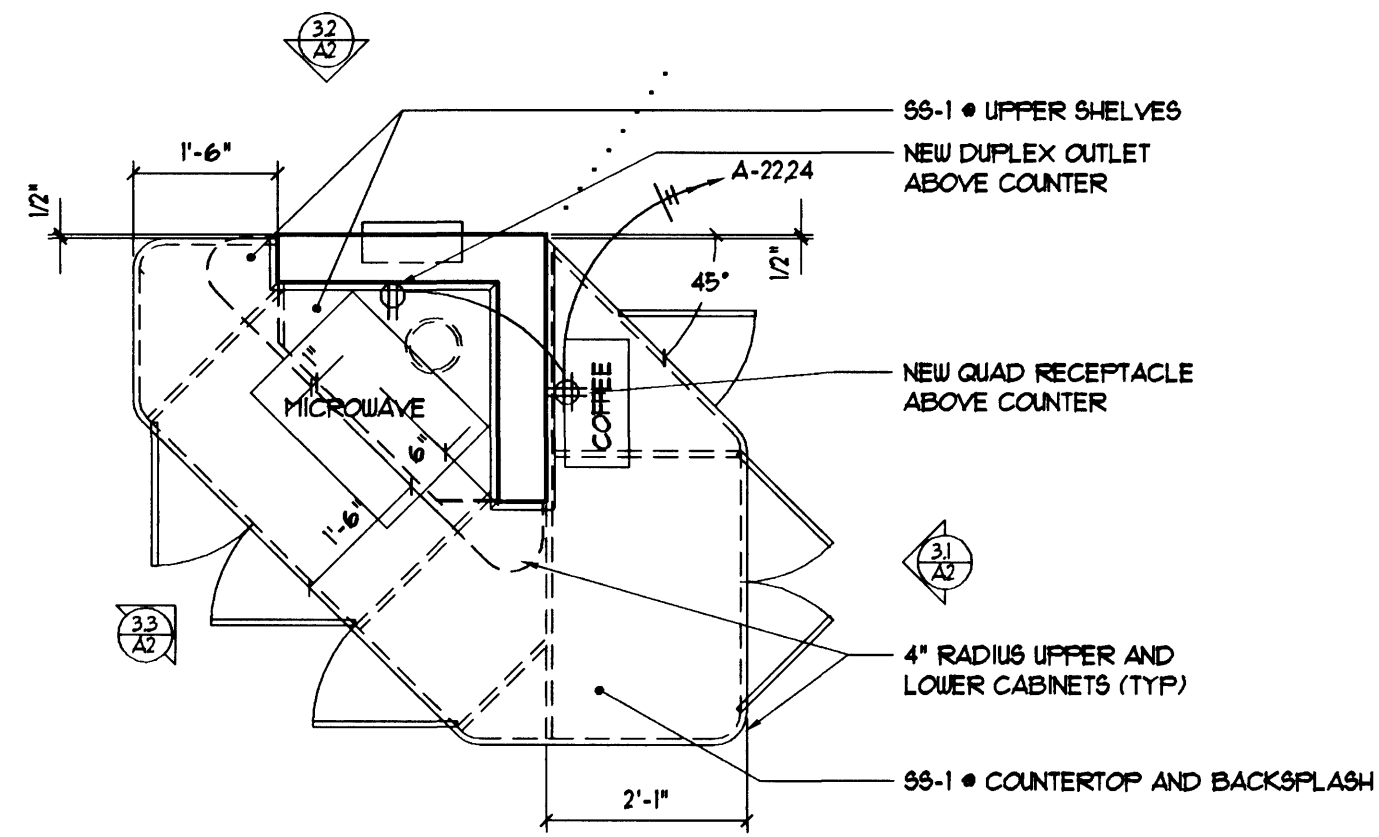


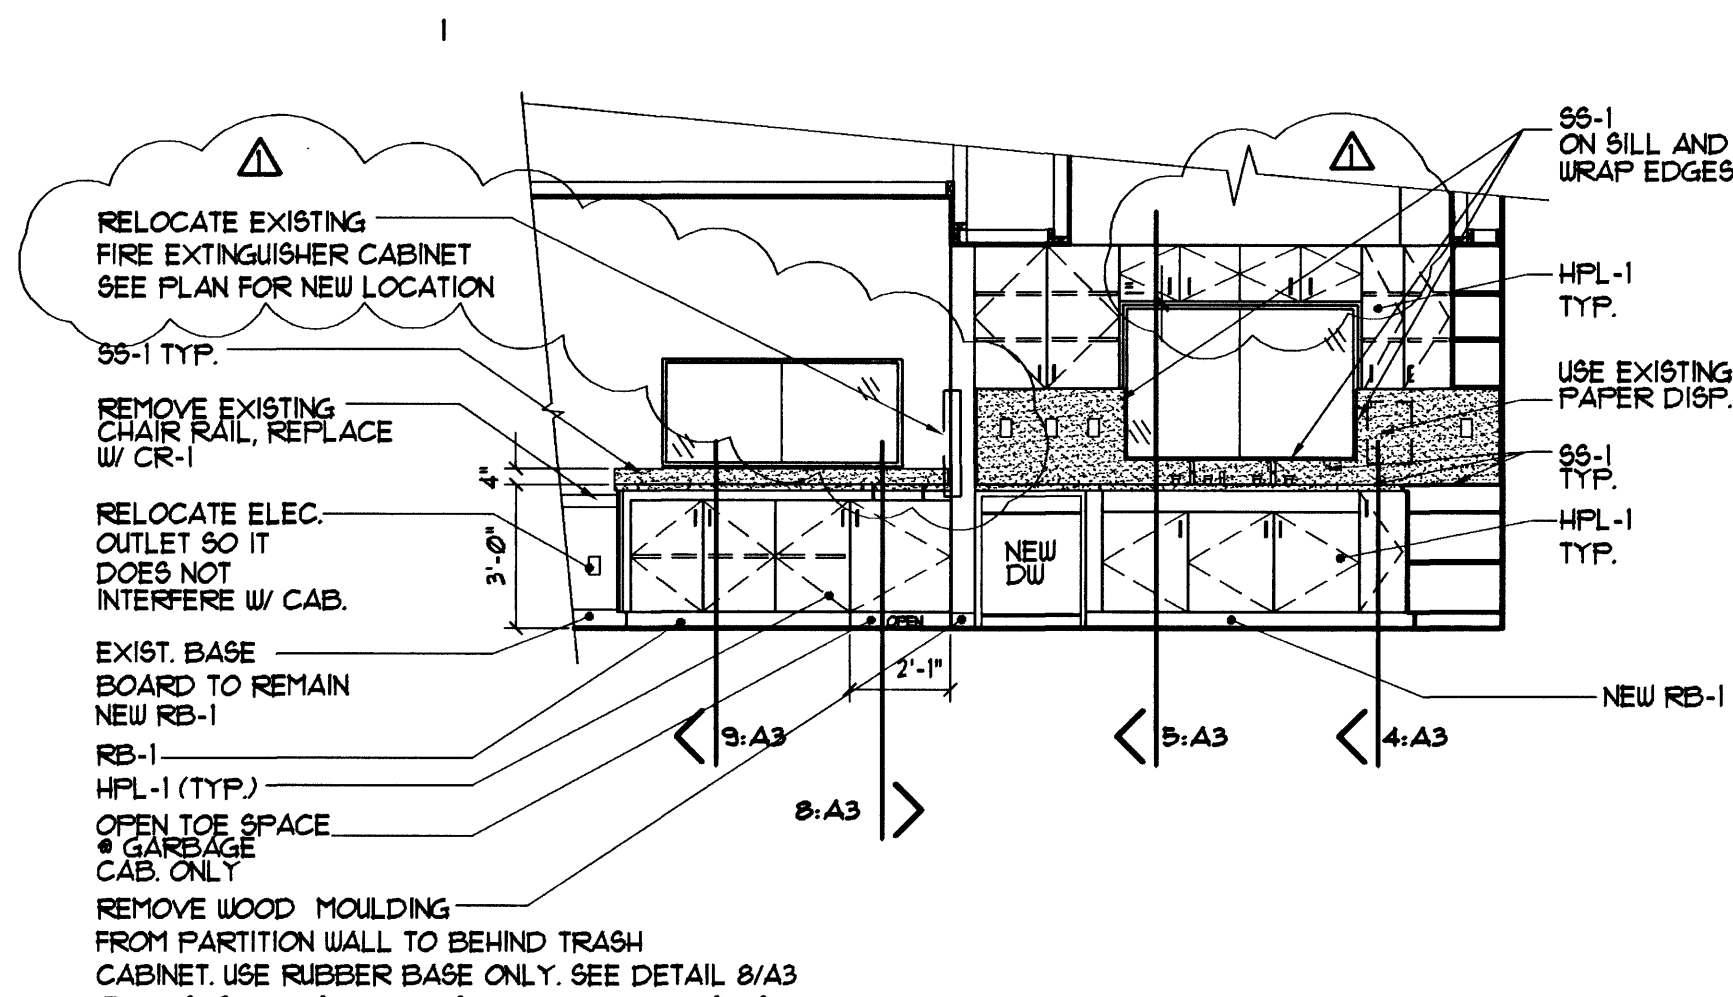

1 Enlarged Floor Plan of Kitchen Island
Scale: 1/2"=1'-0"

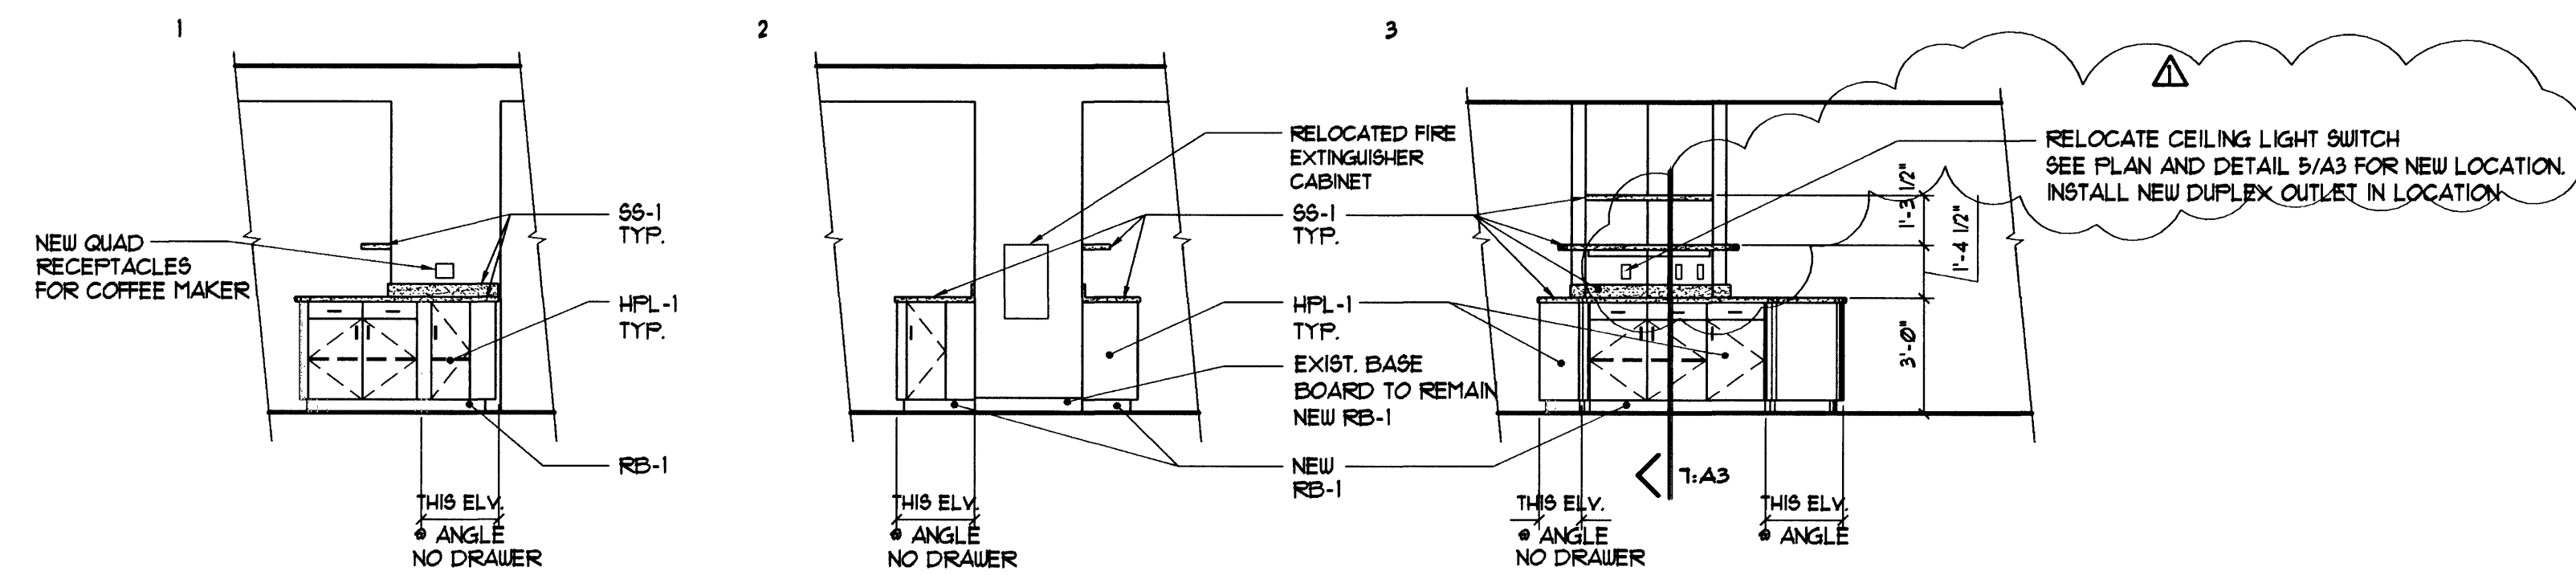

2 Kitchen Interior Elevation
Scale: 1/4"=1'-0"

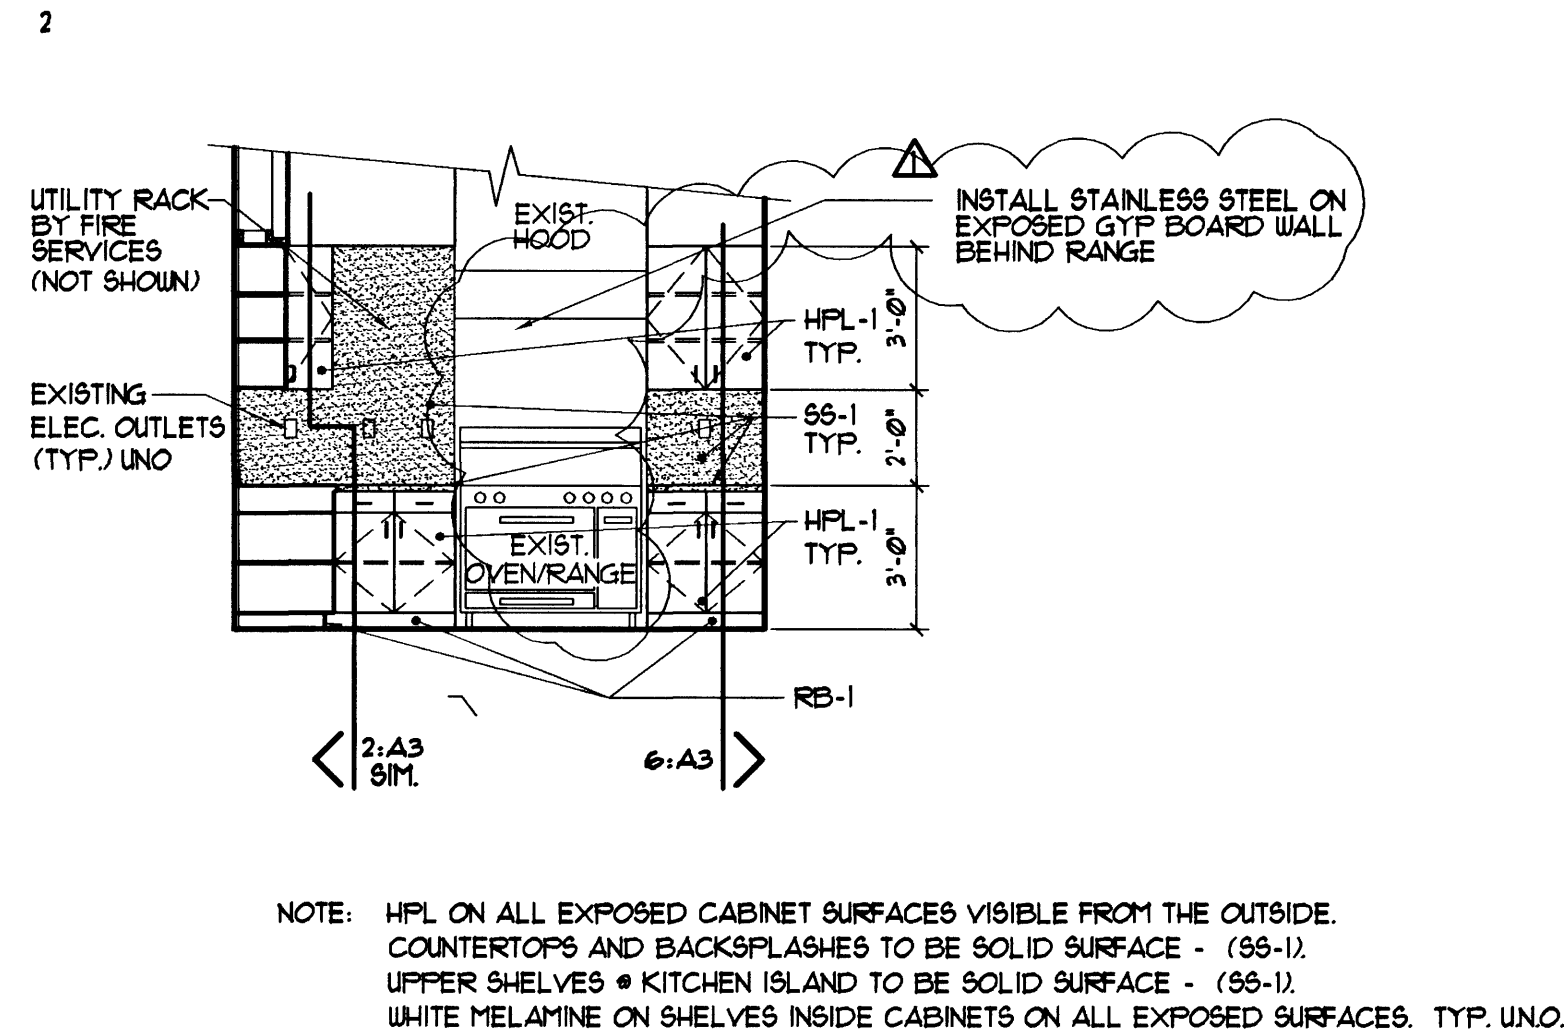

3 Kitchen Island Elevations
Scale: 1/4"=1'-0"

Casework Notes:

- DRAWER AND PULLS: EXTRUDED ALUMINUM FULL, "U" SHAPED WITH STAINLESS STEEL FINISH 4 INCH CENTERS.
- DRAWER SLIDES: BOX DRAWERS: ACCURIDE FULL EXTENSION, 100 LB. CLEAR ZINC FINISH.
- HINGES: BLUM MODUL FULLY CONCEALED, SELF CLOSING, NICKEL PLATED, 110 DEGREE OPENING ANGLE, OVERLAY DOOR.

Finish Schedule

- HPL-1 LAMINATE NO. 1 - WILSONART, D48-60, THISTLE
- SS-1 COUNTERTOP SURFACE AND BACKSPLASH - WILSONART, GIBRALTAR SOLID SURFACING - 13mm 9012-ML ADIRONDACK MELANGE
- RB-1 RUBBER BASE - BURKE, 543, CEDAR
- CR-1 WOOD MOULDING CHAIR RAIL - AUSTIN HARDWOODS CHAIR RAIL, A401 - POPULAR (4" x 3/4") PAINT TO MATCH RB-1

SOLID SURFACE NOTES:

- FABRICATION AND INSTALLATION IN ACCORDANCE WITH MANUFACTURERS INSTRUCTIONS.
- FABRICATORS MUST BE SOLID SURFACE CERTIFIED.
- EASE ALL EXPOSED EDGES.



REVISIONS
 1. INSTALL STAINLESS STEEL BEHIND RANGE
 2. RELOCATE FIRE EXT. CAB.
 3. RELOCATE LIGHT SWITCHES.

CONSULTANT

Fire Station # 9
 - Kitchen Remodel -
 Interior Elevations
 Casework Specifications

DEPARTMENT OF PUBLIC WORKS
 ARCHITECTURAL SERVICES

400 EAST STEWART AVENUE
 LAS VEGAS, NEVADA 89101
 PHONE: (702) 229-6535
 FAX: (702) 386-3232
 TDD: (702) 386-9108

INTERIOR DESIGNER
 Frank Trupiano

DRAWN: MTH/uka
 FILE: f09/KC/ra903a2

DATE: 9/14/2001

SCALE: 1/4"=1'-0"

PROJECT: F99 Kitchen Remodel

SHEET NO.

A2
 3 of 4