



Call
before you
Dig.
1-800-227-2600
UNDERGROUND SERVICE (USA)

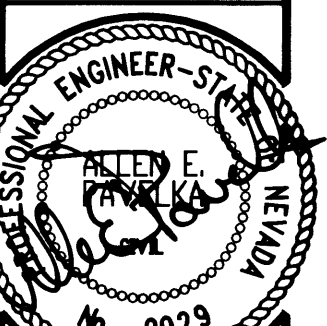


APN: 162-04-210
(SCOTCH SIGHTY ADDITION RECORD)
CURRENT ZONING: R-E

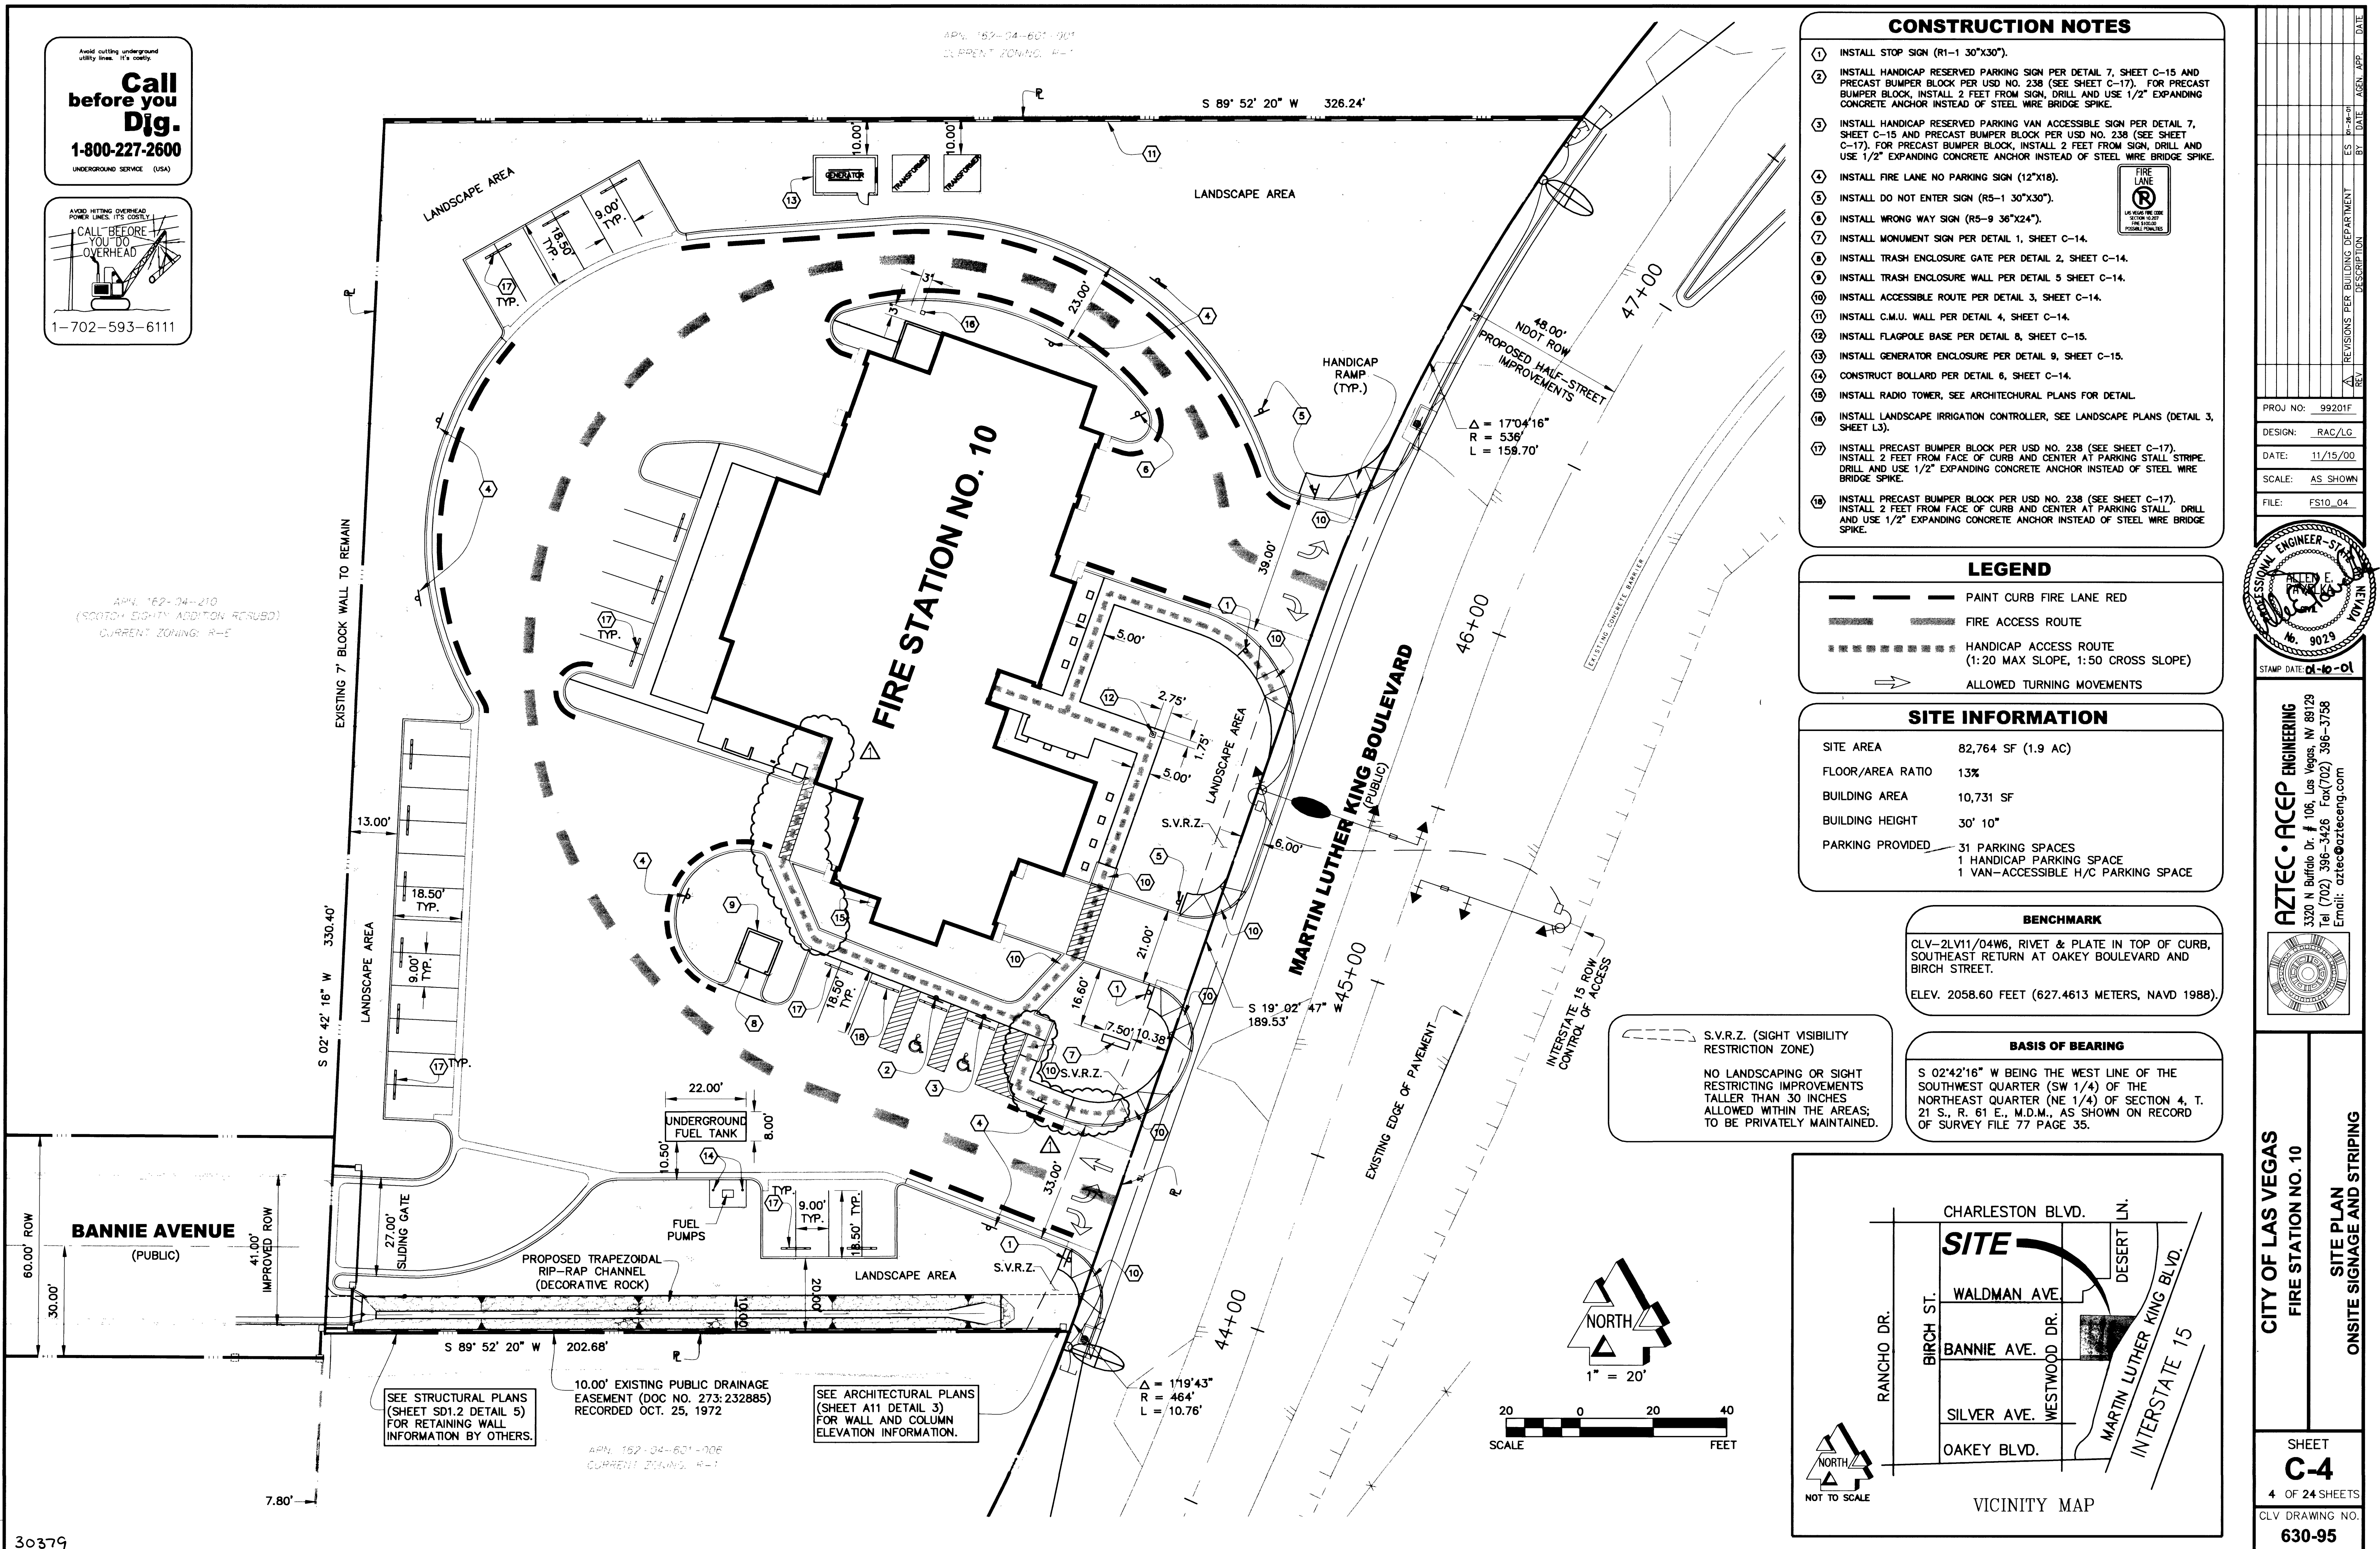


STAMP DATE: 01-16-01

AZTEC-ACEP ENGINEERING
3320 N. Buffalo Dr. # 106, Las Vegas, NV 89129
Tel (702) 396-3426 Fax(702) 396-3758
Email: aztec@azteceng.com

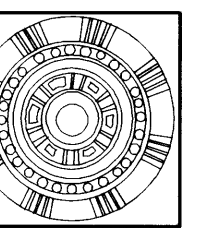

CITY OF LAS VEGAS
FIRE STATION NO. 10
SITE PLAN
ONSITE SIGNAGE AND STRIPING

SHEET
C-4
4 OF 24 SHEETS
CLV DRAWING NO.
630-95

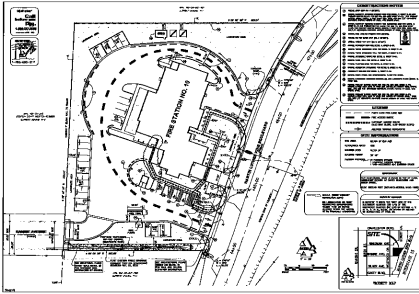




 219

100

[illegible]

1998

1000

[illegible]


