
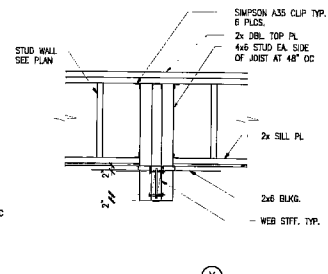
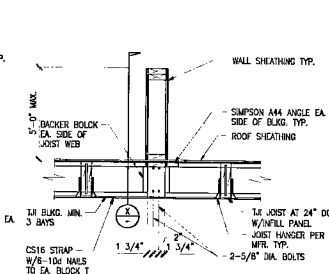
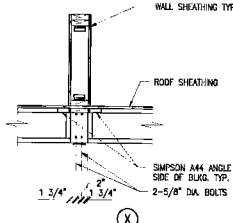


NOTE:
See plan or schedule for footing size and reinforcing.





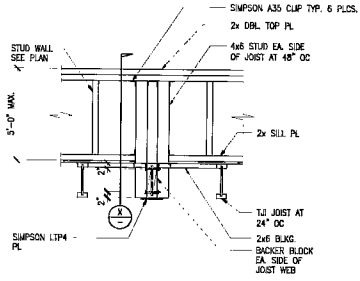


SECTION
NO SCALE

1 SCREEN WALL PERPENDICULAR TO JOIST
3/4" = 1'-0"

2 SCREEN WALL PARALLEL TO JOIST
3/4" = 1'-0"

3

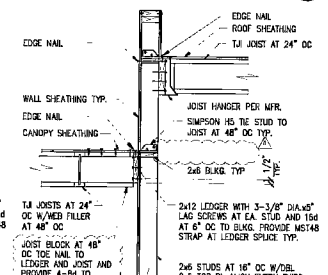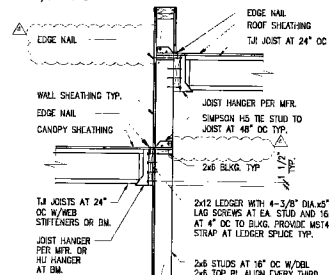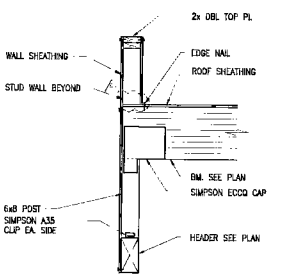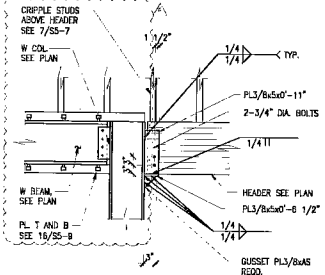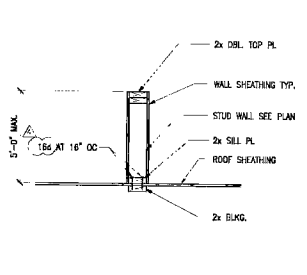

4 SCREEN WALL TO ROOF
3/4" = 1'-0"


5 HEADER AT W COLUMN
3/4" = 1'-0"

6 SECTION
3/4" = 1'-0"

7 SECTION
3/4" = 1'-0"

8 SECTION
3/4" = 1'-0"

9

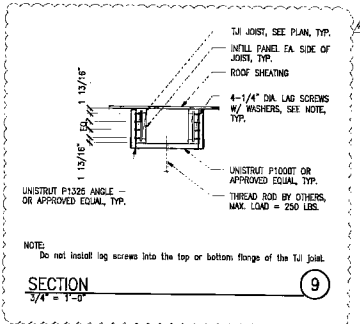

NOTE:
Do not install lag screws into the top or bottom flange of the Tji joist.

SECTION
3/4" = 1'-0"

9


LOCTSA ENGINEERING
6810 South Jones Blvd. Suite 200
Las Vegas, NV 89130
Phone: (702) 386-9318
Fax: (702) 386-9317
www.loctsa.com
LE JOB# 082071

CITY OF LAS VEGAS
FREEDOM PARK RENOVATION
880 NORTH INDOAVEL, LAS VEGAS, NEVADA 89101
SECTIONS AND DETAILS

100% OWNER REVIEW

OWNER: CITY OF LAS VEGAS
ENGINEER OF RECORD: ARCHITECTURAL SERVICES

NO. DATE	DESCRIPTION
1	ISSUED FOR PERMIT
2	ISSUED FOR PERMIT
