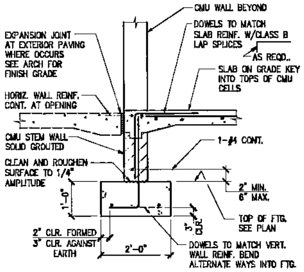

FOOTING AT WALL OPENING (1)
3/4"=1'-0"

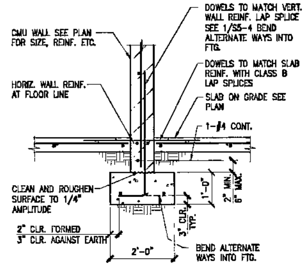

INTERIOR WALL FOOTING (2)
NO SCALE

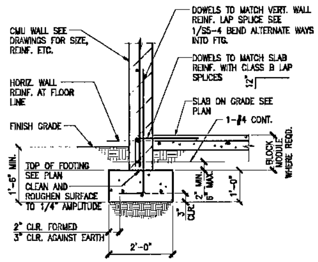

EXTERIOR WALL FOOTING (3)
NO SCALE

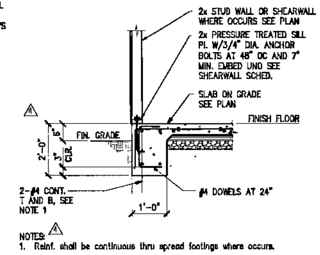

FOOTING AT EXTERIOR WALL (4)
NO SCALE

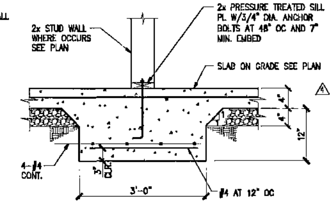

INTERIOR THICKENED SLAB (5)
NO SCALE

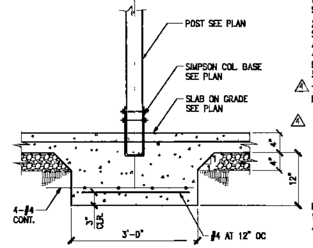

INTERIOR THICKENED SLAB (6)
3/4" = 1'-0"

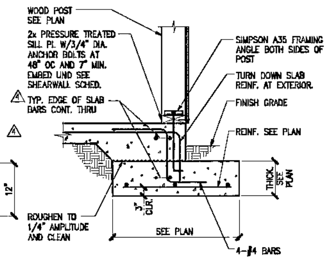

FOOTING AT WOOD POSTS (7)
NO SCALE

not used (8)

not used (9)

not used (10)

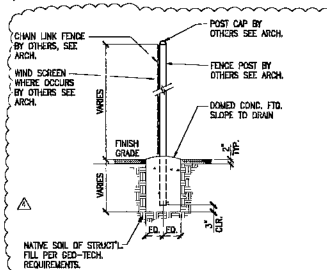

FENCE FOOTINGS			
HEIGHT	POST DIA.	FOOTING DIA.	FOOTING DEPTH
3'-6"	2 7/8"	1'-0"	2'-6"
6'-0"	2 7/8"	1'-0"	3'-6"
6'-0"	4"	1'-4"	3'-6"
8'-0"	2 7/8"	1'-0"	3'-6"
8'-0"	4"	1'-4"	3'-6"
8'-6" to 9'-6"	2 7/8"	1'-0"	3'-6"
8'-6" to 9'-6"	4"	1'-4"	3'-6"
10'-0"	2 7/8"	1'-0"	3'-6"
10'-0"	4"	1'-4"	3'-6"
25'-0"	6 5/8"	C1*	C1*

* See 4/S4-1 for Footing

CHAIN LINK FENCE FOOTING (11)
NO SCALE

not used (12)

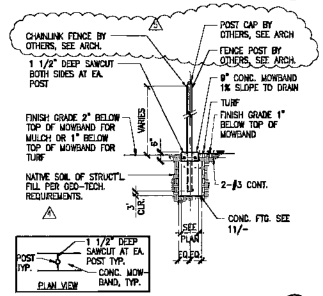

CLF POST WITH MOWBAND (13)
NO SCALE

not used (14)

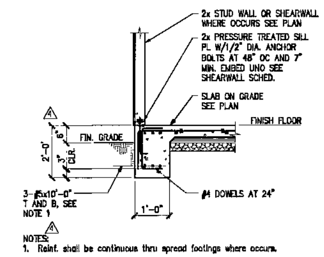

FOOTING AT EXTERIOR WALL (15)
NO SCALE

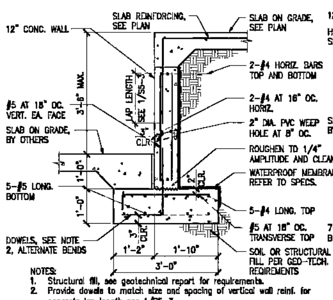

RETAINING WALL SECTION (16)
NO SCALE

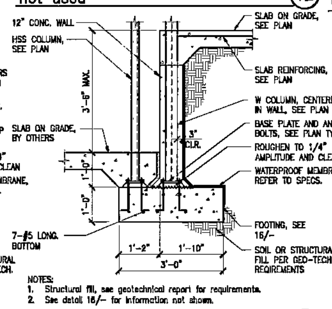

RETAINING WALL SECTION (17)
NO SCALE

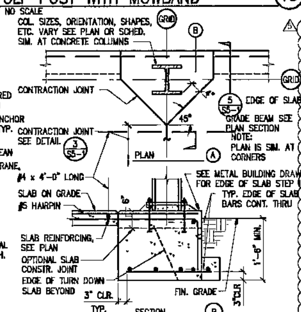

COLUMN ISOLATION JOINT (18)
NO SCALE

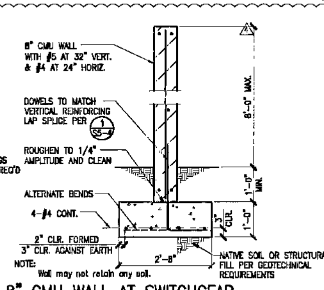

8" CMU WALL AT SWITCHGEAR AND MAINTENANCE WALLS (19)
3/4" = 1'-0"

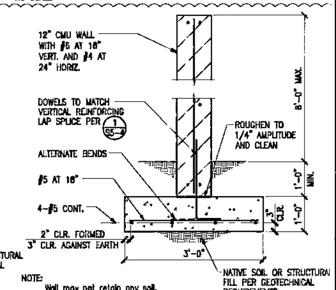

12" CMU WALL AT SCREEN WALLS (20)
3/4" = 1'-0"

REVISIONS
4 12.15.2008 BLDG. DEPT REVIEW #3
5 01.26.2009 BLDG. DEPT REVIEW #4

architecture interiors planning engineering
Dekker Perich Sabatini
6880 Bermuda Road, Ste. 100
Las Vegas, Nevada 89119
702.436.1000
fax 436.1080
info@dpsdesign.org

LOCHSA ENGINEERING
6345 South Jones Blvd, Suite 100
Las Vegas, NV 89118
Phone (702) 365-9312
Fax (702) 365-9317
email structural@lochsa.com
LE JOB# 082071

CITY OF LAS VEGAS
FREEDOM PARK RENOVATION
850 NORTH MOJAVE, LAS VEGAS, NEVADA 89101
FOUNDATION TYPICAL DETAILS

100%
OWNER REVIEW

OWNER: CITY OF LAS VEGAS
DEPARTMENT OF PUBLIC WORKS
ARCHITECTURAL SERVICES
400 EAST STEWART AVENUE
LAS VEGAS, NEVADA 89101
PHONE: (702) 229-6535
FAX: (702) 384-4840
TDD: (702) 386-9108

DATE: OCT 24, 2008
SCALE: AS NOTED
070354
650.22-16

S5-2

21402