


121352

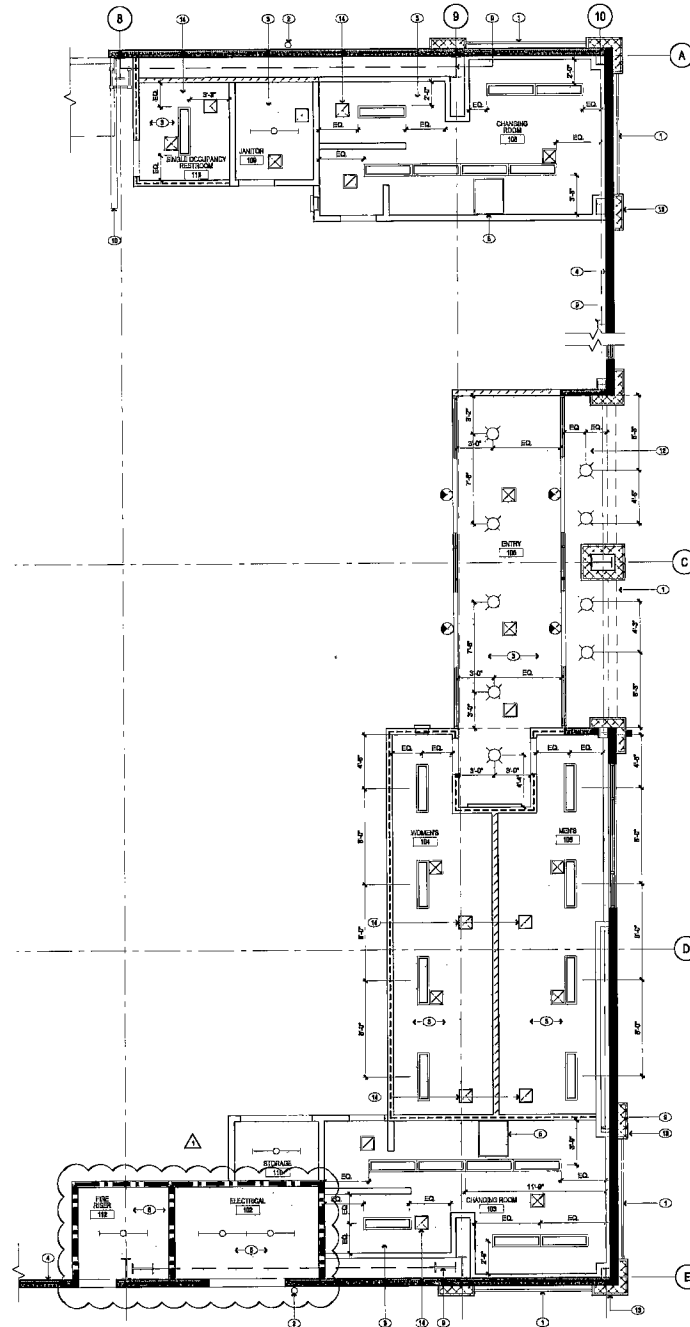

1 LOWER REFLECTED CEILING PLAN
1/8" = 1'-0"

KEY NOTES

1. STRENGTH AND DETAIL DATA.
2. EXISTING SHALL BE CONSIDERED TO UNDERGOING DISMANTLING SYSTEM FOR CON. PLAN.
3. CEMENT BOARD CEILING - FANTOM FOR RCP PLAN.
4. 1/2" X 1/2" X 1/2" FANTOM FOR RCP PLAN.
5. 1/2" X 1/2" X 1/2" FANTOM FOR RCP PLAN.
RCP GENERAL NOTES

1. REFER TO ELECTRICAL LEGEND FOR ADDITIONAL INFORMATION.
2. REFER TO MECHANICAL PLAN FOR ADDITIONAL INFORMATION.
3. VERIFY LOCATION OF SECURITY CAMERA WITH OPERATOR. THE DESIGN BUILD TEAM TO PROVIDE ALL REQUIRED SCHEDULE, CASE, JUNCTION BOXES, ETC. FOR A COMPLETE OPTIMIZED SYSTEM. REFER TO THE FIVE APPENDIX SECTION IN THE PROJECT SPECIFICATIONS FOR ADDITIONAL INFORMATION.
4. PROVIDE A MINIMUM 1 FOOT CIRCULAR ILLUMINATION AT ALL EXITS.
5. LOCATE ALL HANGING DETECTOR AND OTHER CEILING MOUNTED MECHANICAL ELECTRICAL, PLUMBING, AND FIRE EQUIPMENT IN THE CENTER OF ADDITIONAL CEILING TILES.
6. DIMENSIONS PER SEC 717A, SEE DETAIL.
7. FURNISH SCHEDULE IN ADDITION. ALL IN CEILING ARE TO BE CENTERED ON PANEL UNLESS OTHERWISE NOTED.

RCP LEGEND

- EXIT SIGN
- DIRECTIONAL EXIT SIGN
- 2X FLUORESCENT LIGHT FIXTURE
- 2X SURFACE MOUNTED FLUORESCENT LIGHT FIXTURE
- 2X WIDE 4-8" LONG SURFACE MOUNTED FLUORESCENT LIGHT FIXTURE
- OPEN STRIP FLUORESCENT LIGHT FIXTURE
- LIGHT FIXTURE
- CEILING FAN
- SUPPLY AIR GRILL
- RETURN AIR GRILL
- EXHAUST FAN
- OUTLETS SPLIT AIR CONDITIONING UNIT
- SECURITY CAMERA LOCATION, AS NOTED IN GENERAL NOTES
- 4" CONCRETE MOUNT WATER PROOF LAMP
- 1/2" X 1/2" PERFORATED METAL TRANSFER GRILL (PAINT TO MATCH CEILING)
- SECURITY EXTERIOR LIGHT FIXTURE
- EXTERIOR LIGHT FIXTURE
- LAY IN CEILING, SEE 18402, 18402, 20402
- GYPHUM BOARD CEILING
- 30" X 30" ROOF HATCH
- STAND ALONE HARDWARE BATTERY BACK-UP SMOKE DETECTOR





































OWNER REVIEW

100%

OWNER: CITY OF LAS VEGAS
CONTRACTOR: FREEDOM PARK RENOVATION
880 NORTH MOJAVE LAS VEGAS, NEVADA 89101
MULTI-PURPOSE BUILDING
ENLARGED REFLECTED CEILING PLAN

DATE: FEBRUARY 13, 2009
BY: [Signature]
CHECKED: [Signature]
APPROVED: [Signature]

MPA-6A