GENERAL NOTES:

1. ALL WATER PIPING SHALL BE INSTALLED ON THE INTERIOR SIDE OF THE BUILDING.
2. THE CUTTING, NOTCHING AND BORING OF HOLES IN FLOOR JOIST AND WALL STUDS SHALL BE IN ACCORDANCE WITH THE LATEST APPROVED EDITION OF THE INTERNATIONAL BUILDING CODE.
3. CONTRACTOR SHALL BE RESPONSIBLE FOR THE COORDINATION OF ALL PLUMBING ROUGH-IN LOCATIONS. REFER TO ARCHITECTURAL DRAWINGS FOR FIXTURES AND EQUIPMENT LOCATIONS.
4. CONTRACTOR SHALL BE RESPONSIBLE FOR ALL CUTTING AND PATCHING AS REQUIRED TO ACCOMMODATE HIS WORK.
5. ALL SANITARY DRAINAGE PIPING SHALL BE SLOPED AT 1/4" PER FOOT.
6. PLUMBING CONTRACTOR SHALL COORDINATE ROUTING OF PIPING WITH ALL OTHER TRADES PRIOR TO COMMENCING WORK.
7. REFER TO THE PLUMBING DETAILS THAT APPLY TO THE WORK ON THIS DRAWING. THESE DETAILS PROVIDE GUIDANCE AS TO INSTALLATION INTENT AND DO NOT NECESSARILY SHOW ALL COMPONENTS REQUIRED.

SHEET NOTES:

1. 3" ROOF DRAIN AND OVERFLOW DRAIN DOWN THROUGH ROOF.
2. 3/4" CONDENSATE DRAIN DOWN THROUGH ROOF.
3. 4" VENT THROUGH ROOF.
4. 3/4" COLD WATER DOWN THROUGH ROOF.
5. ROOF HOSE BIBB, REFER TO DETAIL H/P-03.

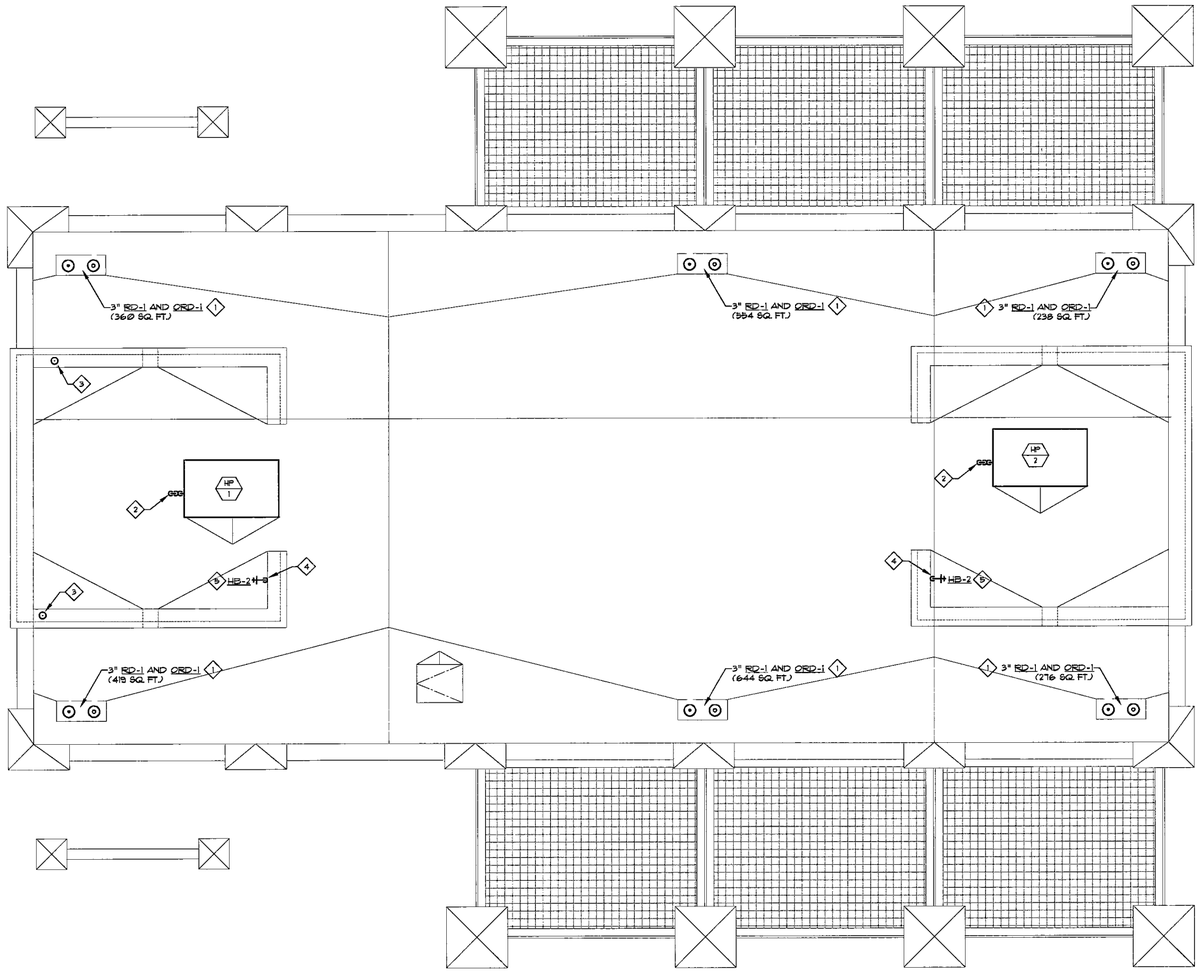

A / AP-4 ADMINISTRATION BUILDING PLUMBING ROOF PLAN
1/4" = 1'-0"

NORTH

123212

RECORD DRAWING

THESE MODIFIED OR RECORD DRAWINGS HAVE BEEN PREPARED, IN WHOLE OR IN PART, ON THE BASIS OF INFORMATION COMPILED AND FURNISHED BY THE CONTRACTOR OR OTHERS INVOLVED WITH THE PROJECT. MSA ENGINEERING CONSULTANTS IS NOT RESPONSIBLE FOR ANY ERRORS OR OMISSIONS WHICH HAVE BEEN INCORPORATED INTO THIS DOCUMENT AS A RESULT. CAREFUL EXAMINATION OF ACTUAL EXISTING CONDITIONS SHOULD BE UNDERTAKEN PRIOR TO EXCAVATION, CUTTING, MODIFICATION, OR CONNECTION OF SUBSEQUENT CONSTRUCTION.

01-31-2010

REVISIONS

architecture
interiors
planning
engineering

Dekker
Perich
Sabatini

6860 Bermuda Road, Ste. 100
Las Vegas, Nevada 89119

702.436.1006
fax 436.1050
info@dpsdesign.org

MSA #L081615

MSA ENGINEERING CONSULTANTS
320 E. Wisconsin Lane
Suite 100
Las Vegas, NV. 89123
T: (702) 896-1100
F: (702) 896-1123
email: msa@msa-lv.com

CITY OF LAS VEGAS
FREEDOM PARK RENOVATION
850 NORTH MOJAVE, LAS VEGAS, NEVADA 89101
ADMINISTRATION BUILDING
PLUMBING ROOF PLAN

Russ Mauger
Russ Mauger
Roche Constructors, Inc.

REGISTERED PROFESSIONAL ENGINEER STATE OF NEVADA
RUSSELL MAUGER
Exp. 12-31-10
MECHANICAL
No. 015976

JAN 31 2010

STAMP

RECORD DRAWINGS
01-31-2010

OWNER: CITY OF LAS VEGAS
DEPARTMENT OF PUBLIC WORKS
ARCHITECTURAL SERVICES

400 EAST STEWART AVENUE
LAS VEGAS, NEVADA 89101
PHONE: (702) 229-6535
FAX: (702) 384-4845
TDD: (702) 386-9108

DRAWN	
TITLE	
DATE	JANUARY 31, 2010
SCALE	AS NOTED
BID NO	070354
CLV DWG NO	650.22-18
SHEET NO	AP-4

RECORD DRAWING

RECORD DOCUMENTS ARE PREPARED FROM DATA AND INFORMATION SUPPLIED BY OTHERS. DEKKERPERICHSABATINI, LTD. DOES NOT CERTIFY, OR WARRANT IN ANY MANNER, THE ACCURACY OR COMPLETENESS OF RECORD DOCUMENTS. DO NOT USE FOR ANY PURPOSE FOR WHICH THEY INTEND TO USE THE INFORMATION. DEKKERPERICHSABATINI, LTD. IS NOT RESPONSIBLE FOR ANY PROBLEMS OR RELATED COSTS THAT MAY ARISE OUT OF THE USE OF RECORD DOCUMENTS.

DRAWINGS AS INSTRUMENTS OF SERVICE ARE THE PROPERTY OF THE DESIGN PROFESSIONAL, WHOSE STAMP OF CERTIFICATION APPEARS ON THE DRAWINGS AND SPECIFICATIONS. ANY USE OR REPRODUCTION IN WHOLE OR IN PART, WITHOUT WRITTEN CONSENT IS STRICTLY PROHIBITED. COPIES OF THE DRAWINGS AND SPECIFICATIONS RETAINED BY THE CLIENT MAY BE UTILIZED ONLY FOR OCCUPYING THE PROJECT FOR WHICH THEY WERE PREPARED AND NOT FOR THE CONSTRUCTION OF ANY OTHER PROJECT. © 650.22-18