




Stantec Consulting Inc.
950 Industrial Way
Sparks, Nevada 89431 USA
Tel: (775) 358-6931
Fax: (775) 358-6954
www.stantec.com

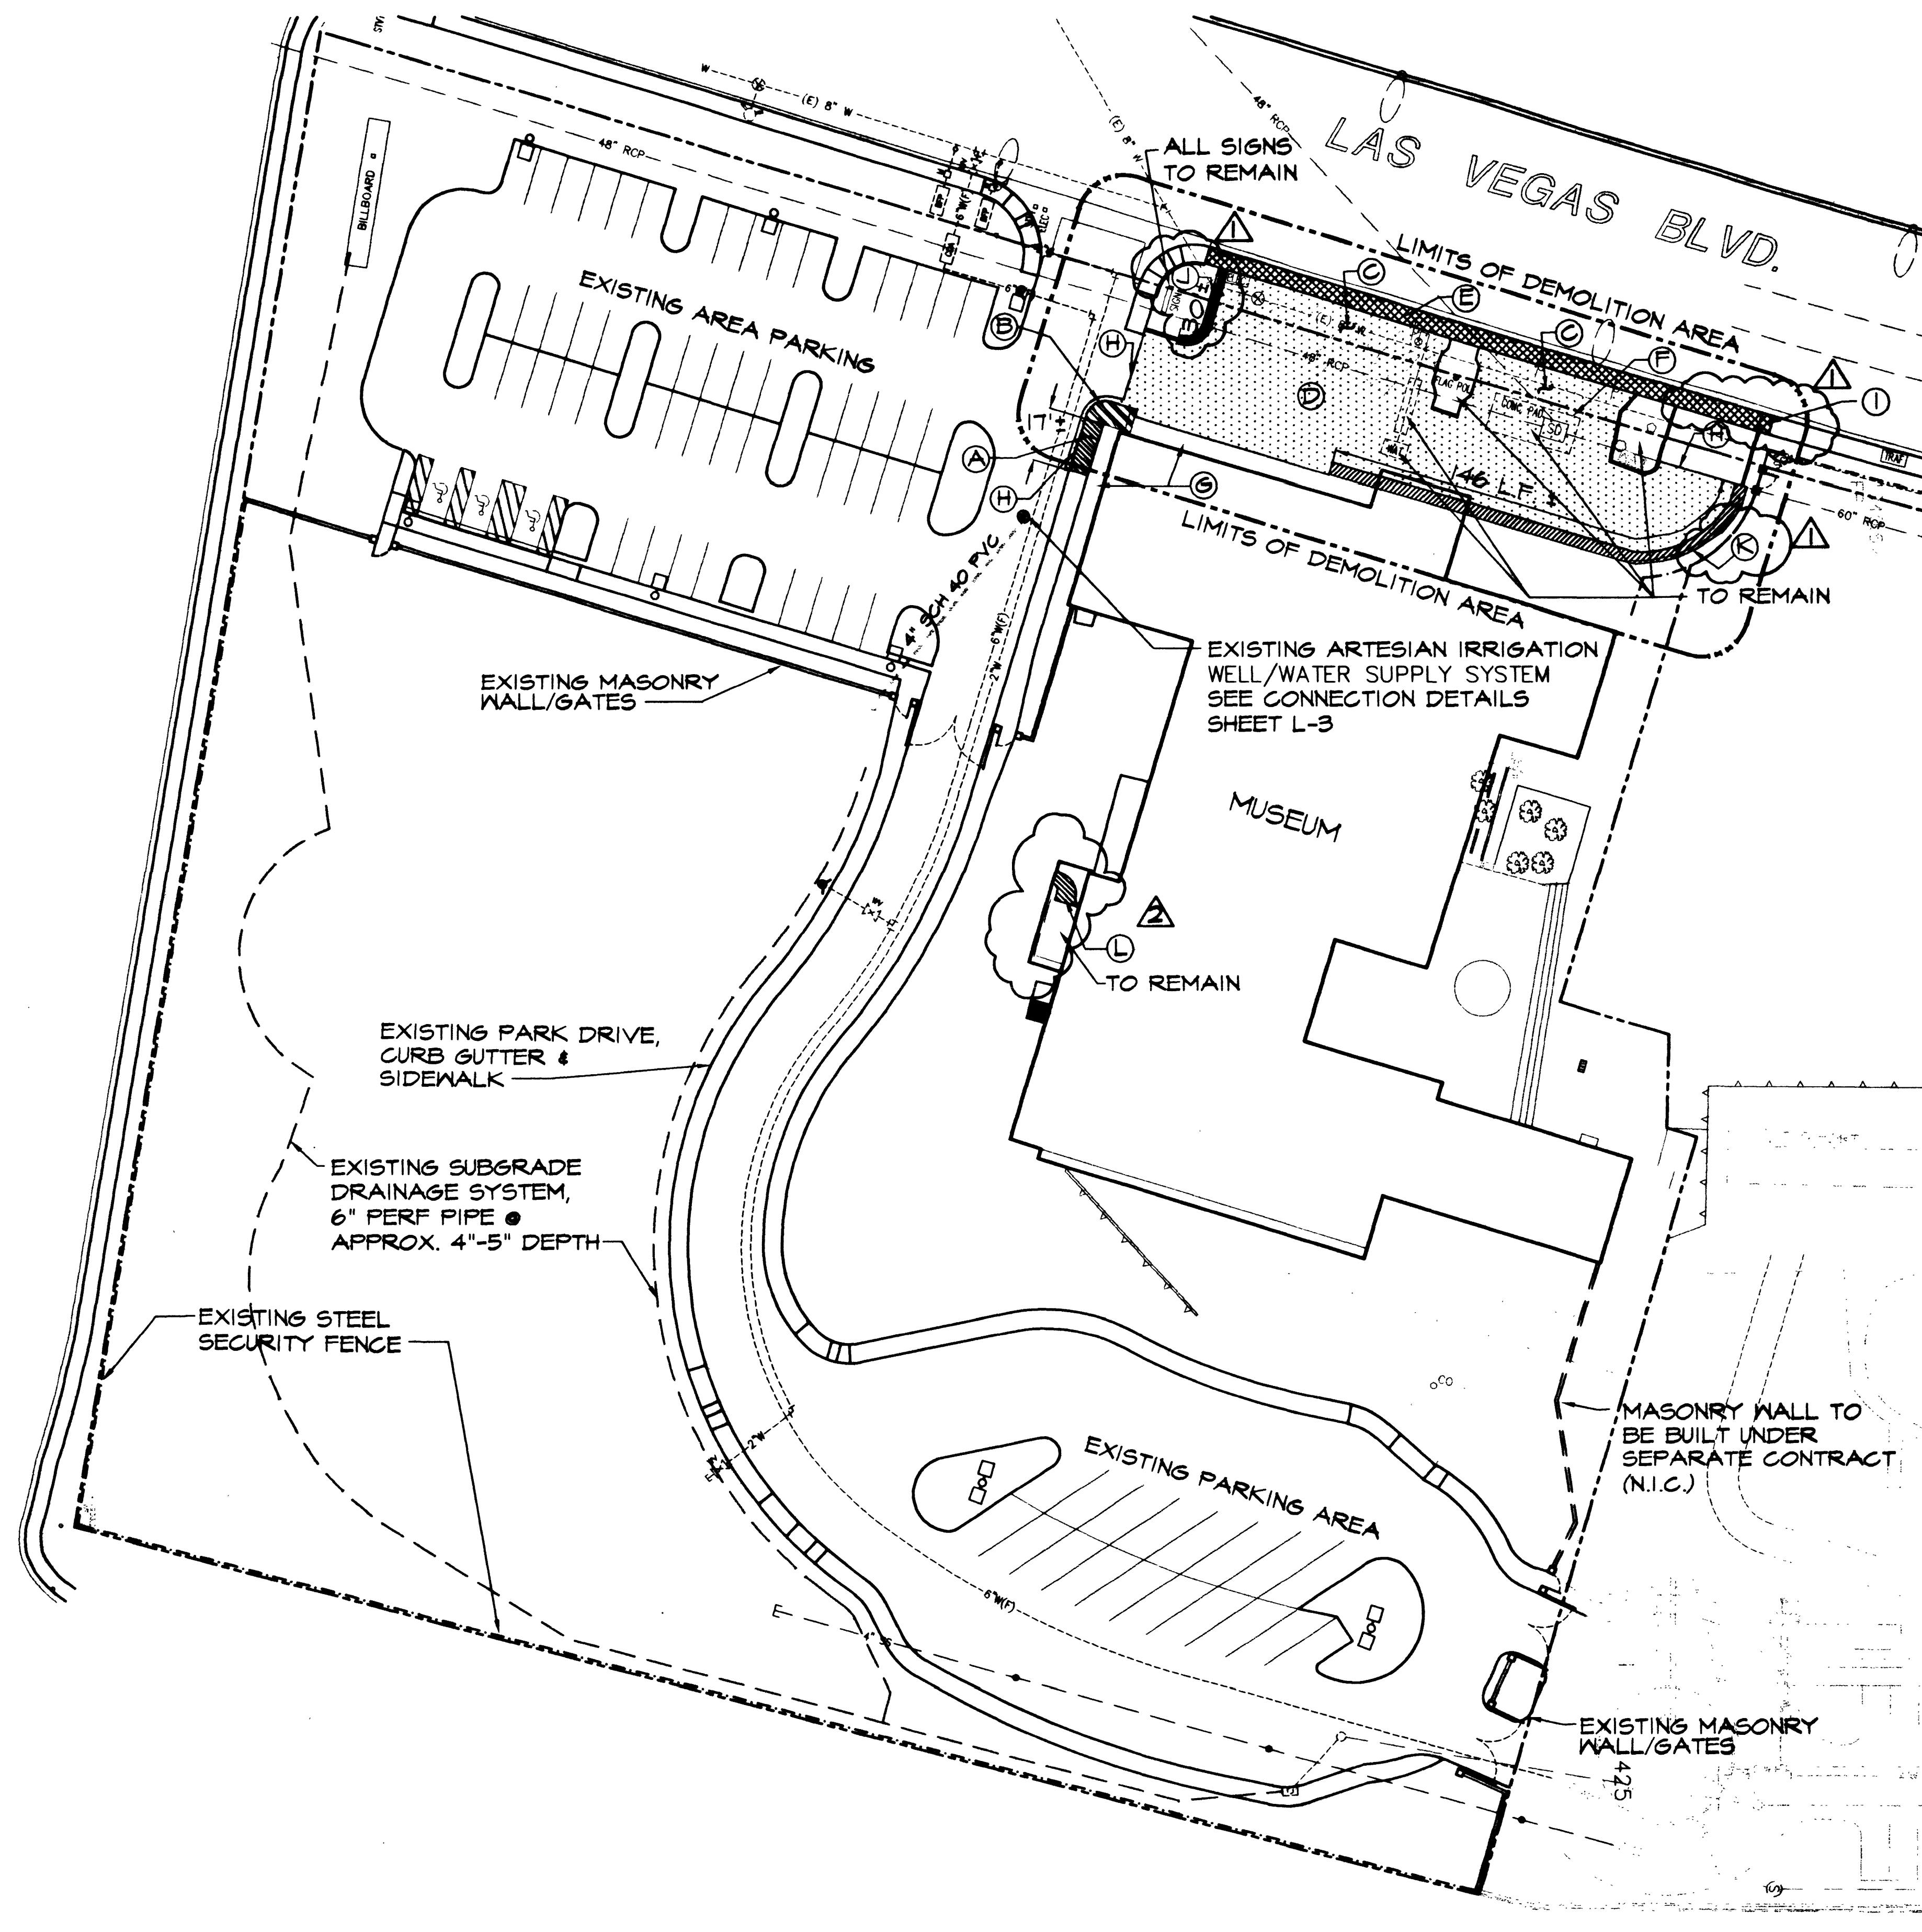


SCALE: 1" = 30'-0"



DEMOLITION NOTES:


- (A) REMOVE EXISTING TWO SECTIONS, 17 LF +/- OF CONCRETE SIDEWALK, CURB AND GUTTER, TO FULL CURB HEIGHT.
- (B) REMOVE EXISTING CONCRETE SIDEWALK END SECTION, CURB RETURN, AND SIDEWALK RAMP. SEE SHEET C8 LAYOUT PLAN FOR LOCATION OF REPLACEMENT SIDEWALK END SECTION AND "L" TYPE CURB.
- (C) REMOVE EXISTING PARKING BUMPERS AND STORE FOR REUSE ON THIS PROJECT.
- (D) REMOVE EXISTING AC PAVEMENT, 7444 SQ' +/-
- (E) REMOVE EXISTING CONCRETE SIDEWALK, 140 LF +/- . EXISTING CURB AND GUTTER TO REMAIN.
- (F) ALL UTILITY BOXES TO REMAIN. CONTRACTOR SHALL PROTECT AND PRESERVE ALL UTILITIES AND UTILITY APPURTANANCES (BOXES) FROM DAMAGE DURING DEMOLITION AND CONSTRUCTION.
- (G) PRESERVE AND PROTECT EXISTING PLANT MATERIAL.
- (H) SAWCUT FULL DEPTH IN NEAT STRAIGHT LINE.
- (I) REMOVE EXISTING CONCRETE SIDEWALK TO ELECTRIC FULL BOX. COORDINATE WITH ELECTRIC SHEET E4.
- (J) REMOVE EXISTING CONCRETE CURB 30 LF +/-
- (K) REMOVE EXISTING CONCRETE CURB 140 LF +/-
- (L) REMOVE EXISTING CONCRETE RAMP 50 SQ' +/- FROM JOINT AT TOP OF RAMP TO GROUND LEVEL.

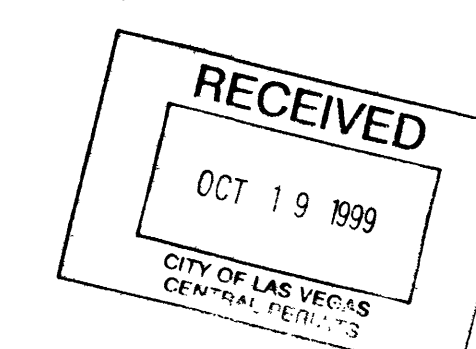

PLANS APPROVED
ARCHITECTURAL
Building & Safety Dept.
City of Las Vegas, Nevada

RAC NOV 04 1999

Does Not Include: Grading, Geotechnical, Planting, and the 100' Site Inspection. No Change Without Approval From the Not a Permit to Violate Any Ordinance

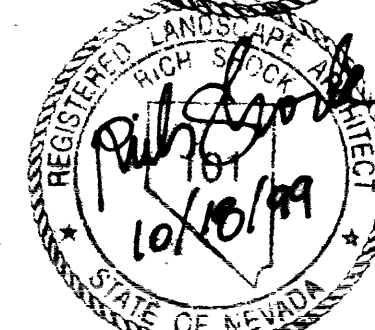

EXISTING CONDITIONS/DEMOLITION PLAN

City of Las Vegas
DEPARTMENT OF PUBLIC WORKS

HERITAGE PARK
PHASE 1B
PARK IMPROVEMENT PLANS
CLARK COUNTY CITY OF LAS VEGAS NEVADA

3 OF 43

C2

650.44A

26663