





LINE TABLE		
LINE	BEARING	LENGTH
L1	S73°06'37"E	10.47'
L2	N44°20'51"E	5.13'
L3	S34°17'20"W	2.90'
L4	N57°36'34"E	9.48'
L5	N57°27'26"E	17.43'
L6	N17°54'54"W	3.17'
L7	S08°14'31"W	22.76'
L8	S55°14'31"W	5.66'
L9	N81°45'24"W	20.85'
L10	S30°38'14"W	20.58'
L11	N54°21'46"W	22.00'
L12	S75°38'14"W	5.66'
L13	N08°14'31"E	22.46'
L14	S25°48'44"E	19.01'
L15	S75°38'14"W	18.43'
L16	N54°21'46"W	22.23'
L17	S08°14'31"W	12.00'
L18	N81°45'24"W	24.00'
L19	S08°14'31"W	12.00'
L20	N29°43'42"W	5.12'
L21	S18°48'18"E	5.26'
L22	N30°38'14"E	1.65'
L23	N57°44'01"E	9.11'

CURVE TABLE			
CURVE	DELTA	RADIUS	LENGTH
CC1	74°09'44"	65.00'	24.64'
CC2	23°01'28"	104.81'	44.13'
CC3	68°33'18"	58.00'	64.40'
CC4	04°26'43"	61.03'	10.06'
CC5	22°57'36"	58.00'	23.24'
CC6	56°16'12"	45.00'	44.14'
CC7	41°57'55"	60.00'	46.31'
CC8	23°04'26"	110.00'	44.30'
CC9	74°12'48"	54.98'	77.64'
CC10	50°13'16"	40.04'	35.14'
CC11	53°13'05"	23.80'	22.23'
CC12	107°55'04"	17.40'	33.72'
CC13	07°42'40"	163.64'	22.02'
CC14	40°18'41"	44.60'	34.90'
CC15	21°38'44"	43.14'	16.32'
CC16	52°34'48"	45.52'	41.84'
CC17	77°12'04"	7.66'	10.33'
CC18	111°22'11"	13.04'	25.33'
CC19	38°16'23"	42.33'	28.24'
CC20	25°48'34"	37.14'	16.73'
CC21	53°43'33"	23.10'	21.66'
CC22	43°46'17"	41.94'	32.08'
CC23	76°01'27"	25.47'	33.74'
CC24	85°00'44"	26.57'	34.43'
CC25	129°24'06"	25.17'	56.88'
CC26	41°26'53"	26.50'	14.17'
CC27	122°56'15"	24.66'	52.92'

NOTE: ALL DIMENSIONS ARE TO FRONT FACE OF CURB.

PICNIC RAMADA
SEE SHEET A2.1

SITE FURNITURE:
PER PAD TYP.

PICNIC TABLE
DETAIL 4/C4

BBQ GRILL
DETAIL 1/L4

TRASH RECEPT
DETAIL 2/C4

4.00' TYP.

PICNIC RAMADA
SEE SHEET A2.1

SITE FURNITURE:
PER PAD TYP.

PICNIC TABLE
DETAIL 4/C4

BBQ GRILL
DETAIL 1/L4

TRASH RECEPT
DETAIL 2/C4

4.00' TYP.

PLANS APPROVED
ARCHITECTURAL
Bulfinch & Associates
City of Las Vegas

OCT 20 1999

OCT 19 1999

CITY OF LAS VEGAS
CENTRAL PERMITS

REGISTERED LANDSCAPE
ARCHITECT
RICH SODOK
10/18/99

REGISTERED LANDSCAPE
ARCHITECT
PIHOSHINE
10/18/99

REGISTERED LANDSCAPE
ARCHITECT
PIHOSHINE
10/18/99



SCALE: 1"=10'-0"



NORTH



DIMENSION/LAYOUT PLAN

City of Las Vegas
DEPARTMENT OF PUBLIC WORKS

HERITAGE PARK
PHASE II
PARK IMPROVEMENT PLANS
CLARK COUNTY CITY OF LAS VEGAS NEVADA

OF 43
C3

650.44A

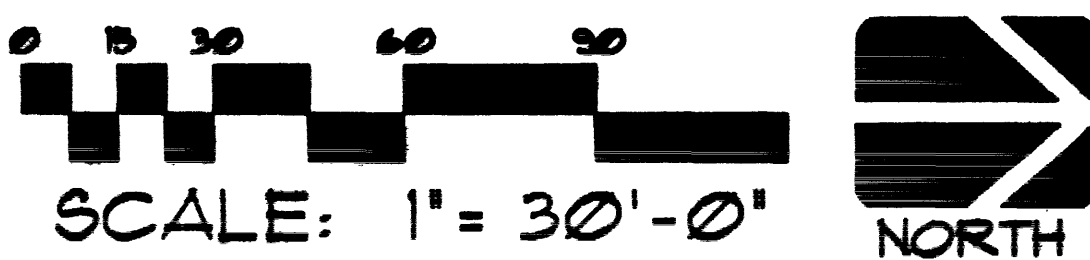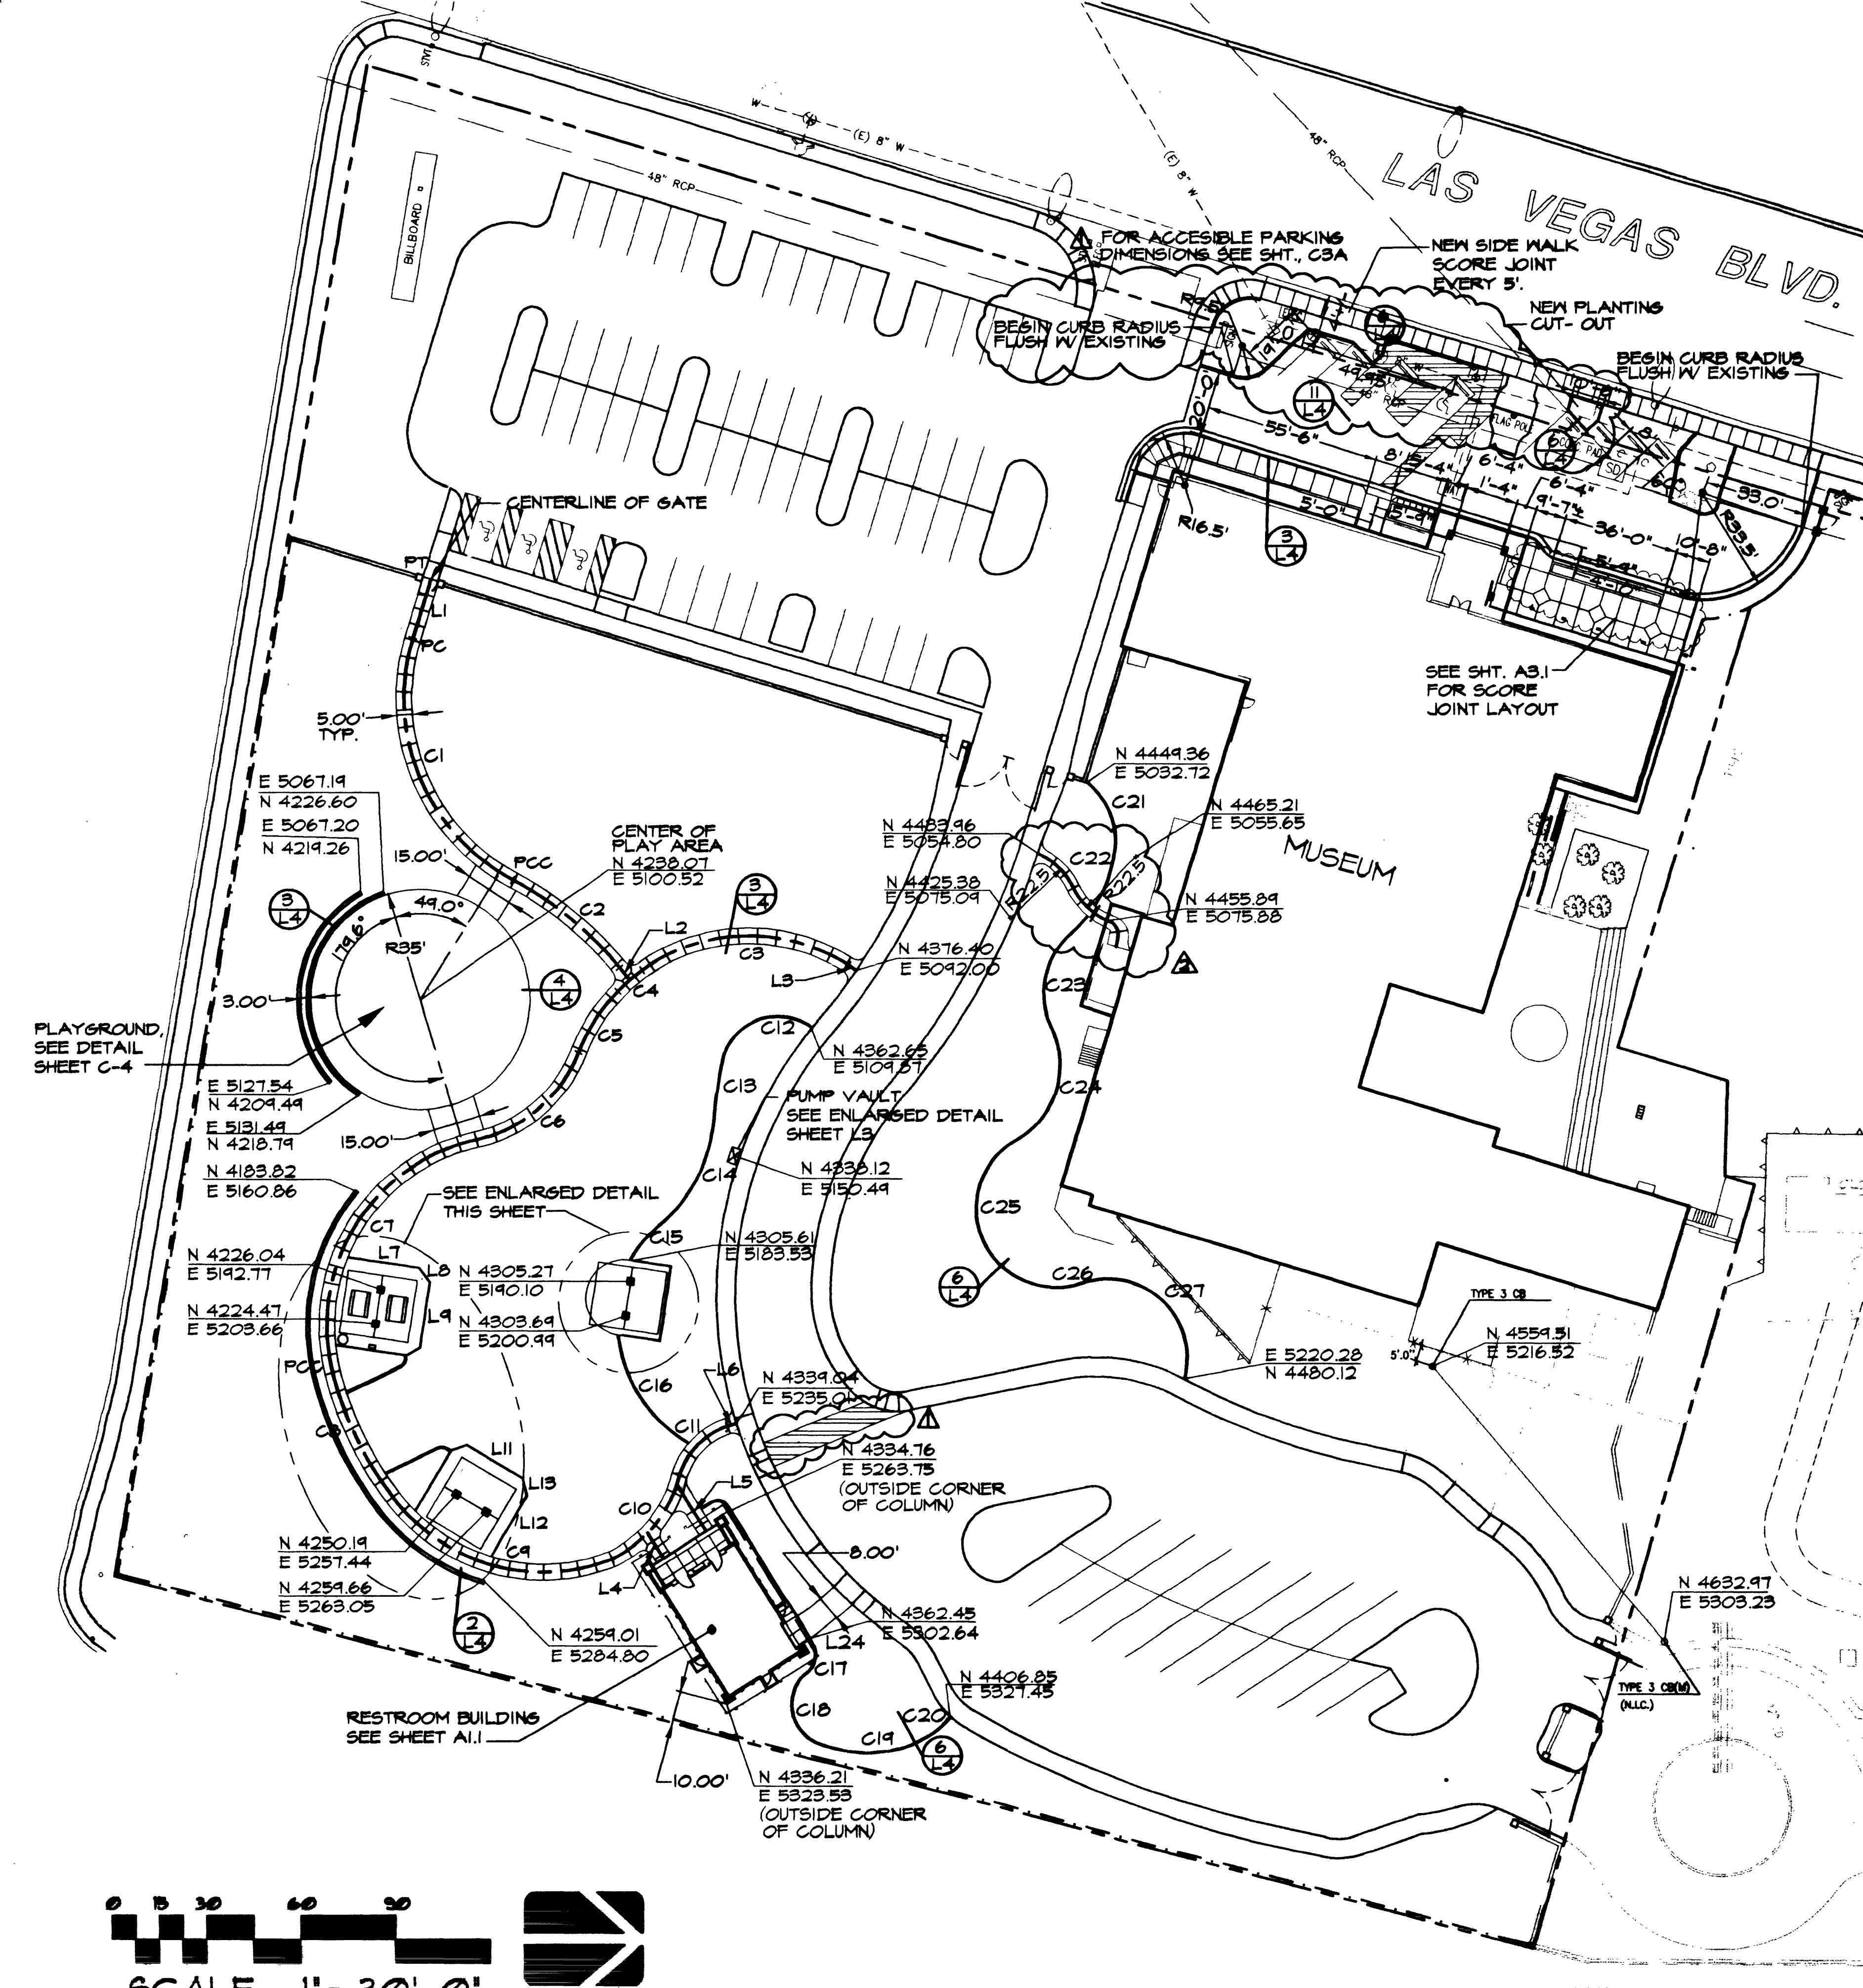

SCALE: 1"=30'-0"



NORTH

26664