




Stantec Consulting Inc.
950 Industrial Way
Sparks, Nevada 89431 USA
Tel: (775) 358-6931
Fax: (775) 358-6954
www.stantec.com


Stantec

RECREATION EQUIPMENT SCHEDULE:

SYMBOL	DESCRIPTION/MODEL	MANUFACTURER/DISTRIBUTOR
	OUTDOOR CREATIONS, INC. MODEL NO. 1009, 8' CONCRETE PICNIC TABLE MOUNTING, ON GRADE (ARRANGE AS SHOWN ON LAYOUT PLAN, SHEET) COLOR - SAND TEXTURE - SMOOTH SEE DETAIL, 4/C4 (OR APPROVED EQUAL)	OUTDOOR CREATIONS, INC. P.O. BOX 50 ROUND MOUNTAIN, CA 96084 PAUL D'AMICO (416) 551-6714
	MAUSAU TILE BENCH MODEL #TF5070, ALIERS BENCH COLOR - SAND TEXTURE - SMOOTH MOUNTING SEE DETAIL, 5/C4 (OR APPROVED EQUAL)	MAUSAU TILE 1150 E. LINCOLN, P.O. BOX 457 BANNING, CA 92220 (904) 844-5645
	MAUSAU TILE TRASH CONTAINER MODEL #TF1200-MCA-11FTL MODEL "A" WASTE CONTAINER WITH PLASTIC TOP, CABLE LEVELERS AND LINER CITY OF LAS VEGAS LOGO (ONE SIDE) (IN CITY OF LAS VEGAS) COLOR - SAND TEXTURE - WEATHERSTONE PLASTIC TOP - BROWN MOUNTING SEE DETAIL, 2/C4 (OR APPROVED EQUAL)	MAUSAU TILE 1150 E. LINCOLN, P.O. BOX 457 BANNING, CA 92220 (904) 844-5645
	KAY PARK RECREATION CORPORATION MODEL #SB1635, PEDESTAL GRILL MOUNTING - SEE DETAIL, 1/C4 (OR APPROVED EQUAL)	RICH BOYCE RECREATION, INC. 2500 N. 5700 SOUTH MILLSVILLE, UTAH 84554 (800) 455-2755

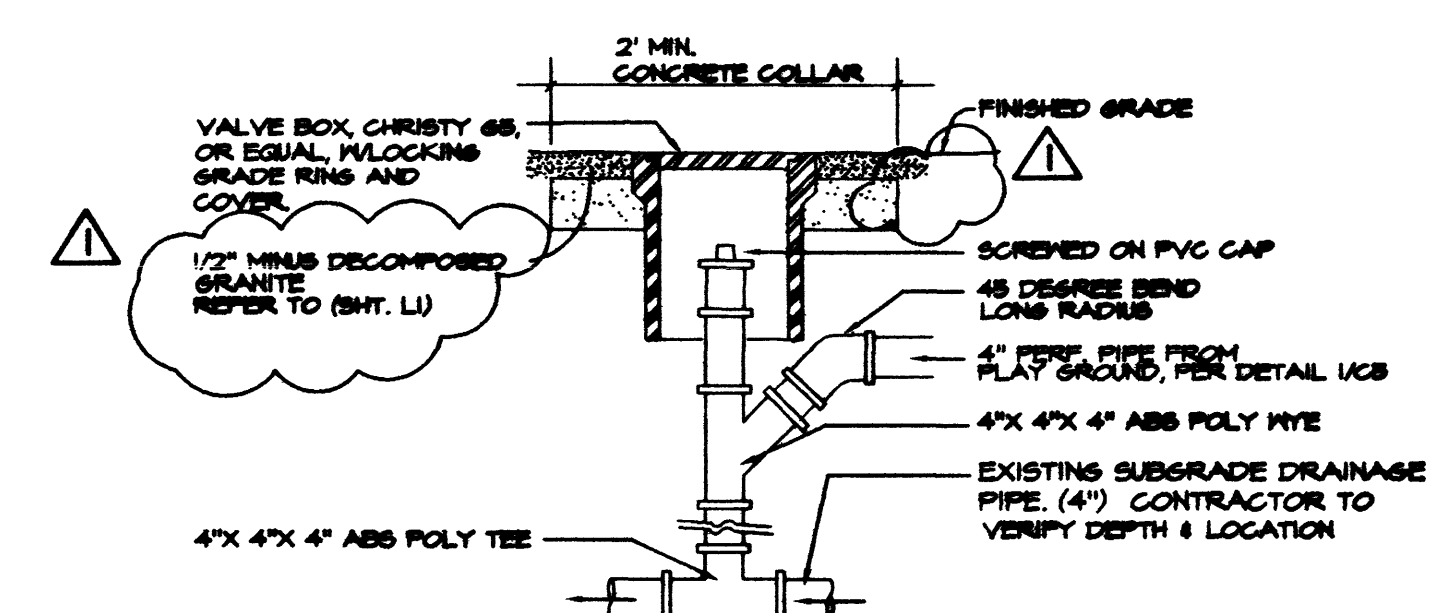

5
C4 PLAYGROUND DRAIN INLET & CLEAN-OUT DETAIL
NOT TO SCALE

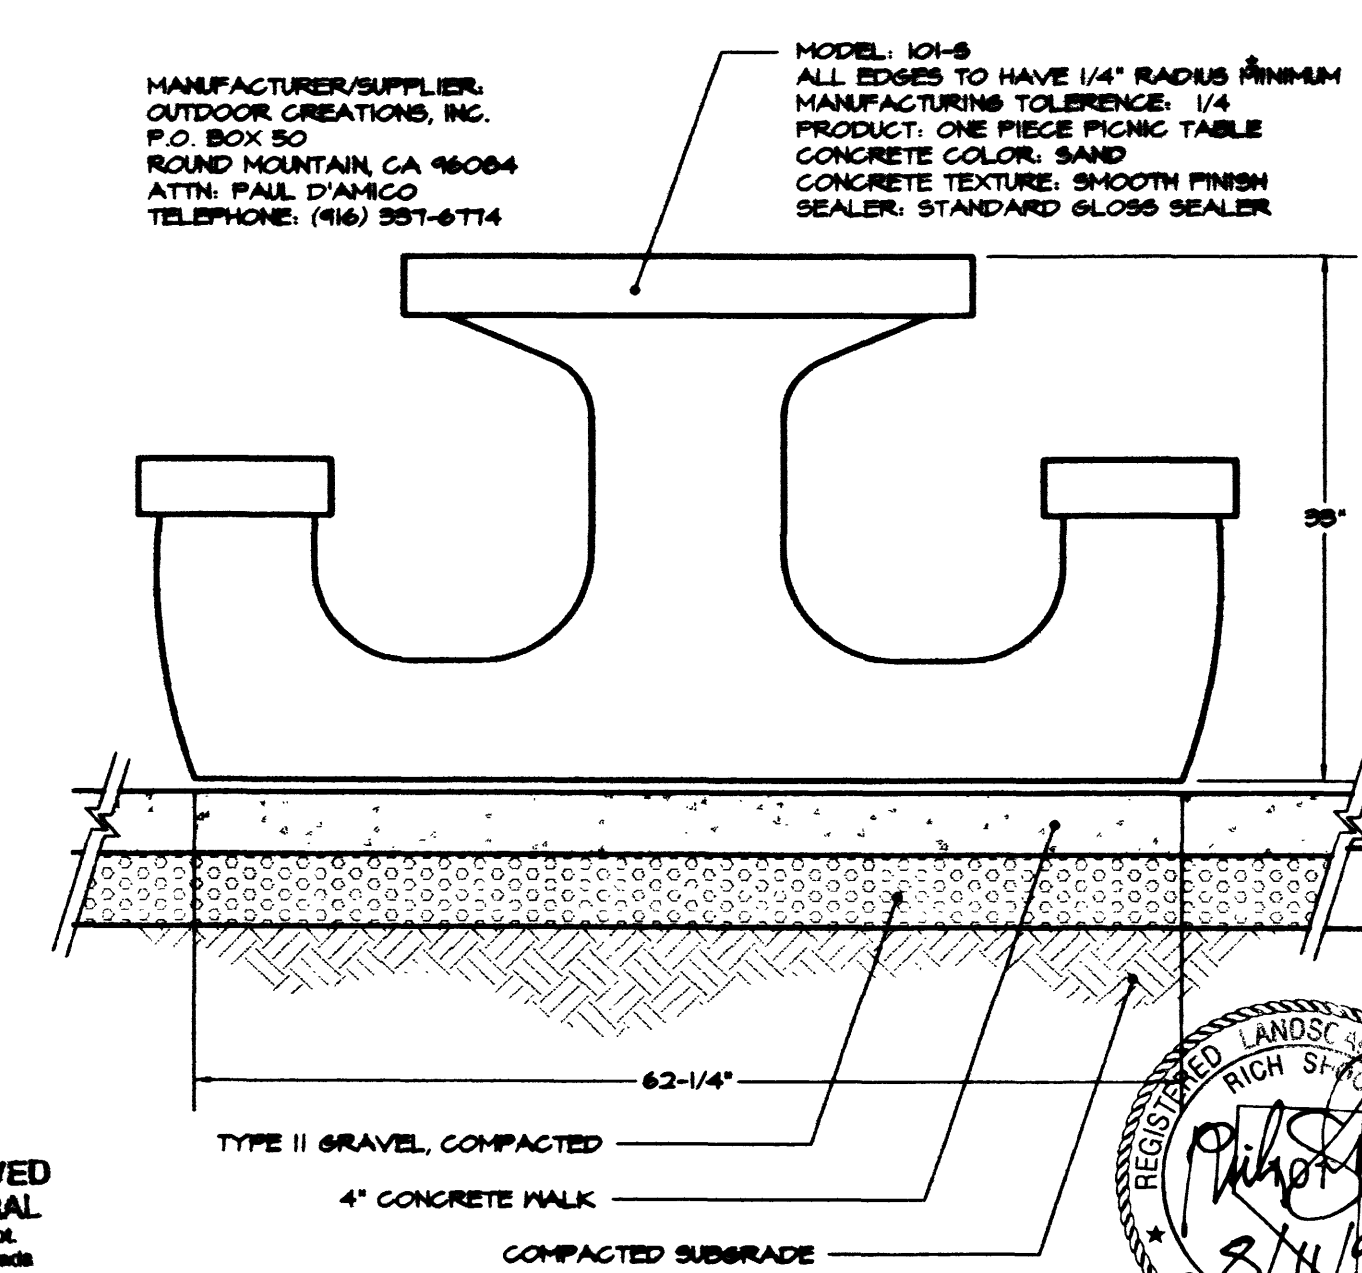

4
C4 PICNIC TABLE
NOT TO SCALE

PLAYGROUND EQUIPMENT SCHEDULE:


SYMBOL	DESCRIPTION/MODEL	MANUFACTURER/DISTRIBUTOR
	DECK TRIANGLE IV HARDWARE (5 POSTS) DECK 1/2 HEX FULL IV HARDWARE (4 POSTS) DECK 1/2 HEX OPEN IV HARDWARE (5 POSTS) POSTS 5" O.D. X 156" SIDE-BY-SIDE SLIDE IV CANOPY (5DK) HORIZONTAL TRY-RINGS IV END CLIMBER PANEL STORE FRONT BELOW DECK MOSUL SLIDE ONE PIECE (5' DECK) TYPHOON SLIDE (5' DECK) BRIDGE HANDRINGS BETWEEN DECKS PANEL IVO BUBBLE BELOW DECK CLIMBER SPIDER (5' OR 6' DK) STAIR BTWN DECKS ADA 2' RISE TRANSFER POINT W/SSL STEP (5' DECK) CLIMBER CURVED LOOP (5' DECK) PANEL MARBLE RACE KIDS' PERCH IV WHEEL CARGO LADDER (5' DECK)	

PLAY EQUIPMENT COLORS:
DECKS, RAMPS, BRIDGES & STEPS - SAND
PLASTIC ROOFS - SAND
PLASTIC SLIDES - SAND
POSTS & ARCHES - FOREST GREEN
ACCENTS, RAILINGS & CLIMBERS - BURGUNDY


	MAUSAU TILE, TERRA FORM DIV MODEL #TF1066, DINOSAUR COLOR - E1, LIGHT CHARCOAL (OR APPROVED EQUAL)	MAUSAU TILE 1150 E. LINCOLN, P.O. BOX 457 BANNING, CA 92220 (904) 844-5645
	MAUSAU TILE, TERRA FORM DIV MODEL #TF1020, CAMEL COLOR - E2, SAND (OR APPROVED EQUAL)	MAUSAU TILE 1150 E. LINCOLN, P.O. BOX 457 BANNING, CA 92220 (904) 844-5645
	MAUSAU TILE TERRA FORM DIV. MODEL #TF1006, SCORILLA COLOR - E1, LIGHT CHARCOAL (OR APPROVED EQUAL)	MAUSAU TILE 1150 E. LINCOLN, P.O. BOX 457 BANNING, CA 92220 (904) 844-5645
	GAME TIME BACKHOE DIGGER MODEL #6144 COLOR - YELLOW (OR APPROVED EQUAL)	RICH BOYCE RECREATION, INC. 2500 N. 5700 SOUTH MILLSVILLE, UTAH 84554 (800) 455-2755
	GAME TIME ACCESSIBLE BACKHOE DIGGER MODEL #6144 COLOR - YELLOW (OR APPROVED EQUAL)	RICH BOYCE RECREATION, INC. 2500 N. 5700 SOUTH MILLSVILLE, UTAH 84554 (800) 455-2755

PLAYGROUND SAFETY SURFACE
VITRITURF
COLORS - 1/3 RED, 1/3 ORANGE, 1/3 GOLD
(OR APPROVED EQUAL)
(OR)
TOT TURF
COLORS - 1/3 RED, 1/3 ORANGE, 1/3 GOLD
(OR APPROVED EQUAL)

VITRITURF, INC.
3151 SAN GABRIEL AVE
GLENDALE, CA 91206
MARK HOLLOMELL
(618) 951-4105
ROBERTSON INDUSTRIES
2146 WEST SHERMAN ST.
PHOENIX, AZ 85004
RICHARD HANLEY
(800) 555-0574

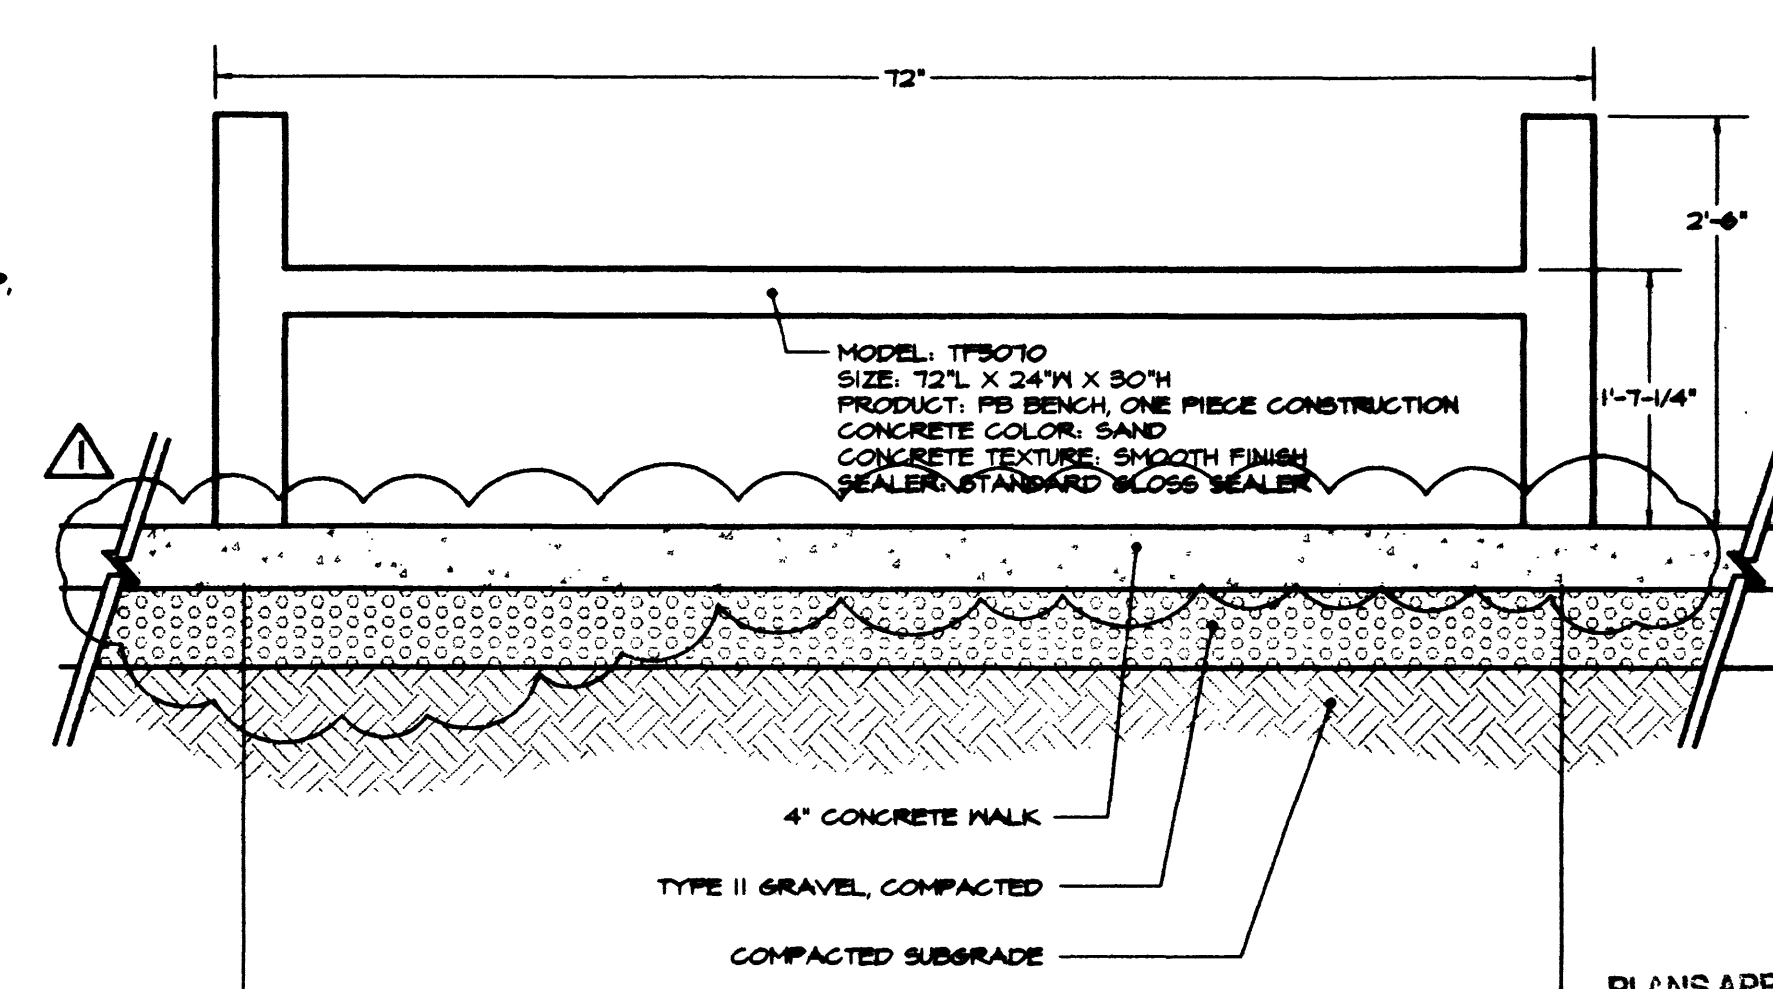


3
C4 BENCH DETAILS
NOT TO SCALE

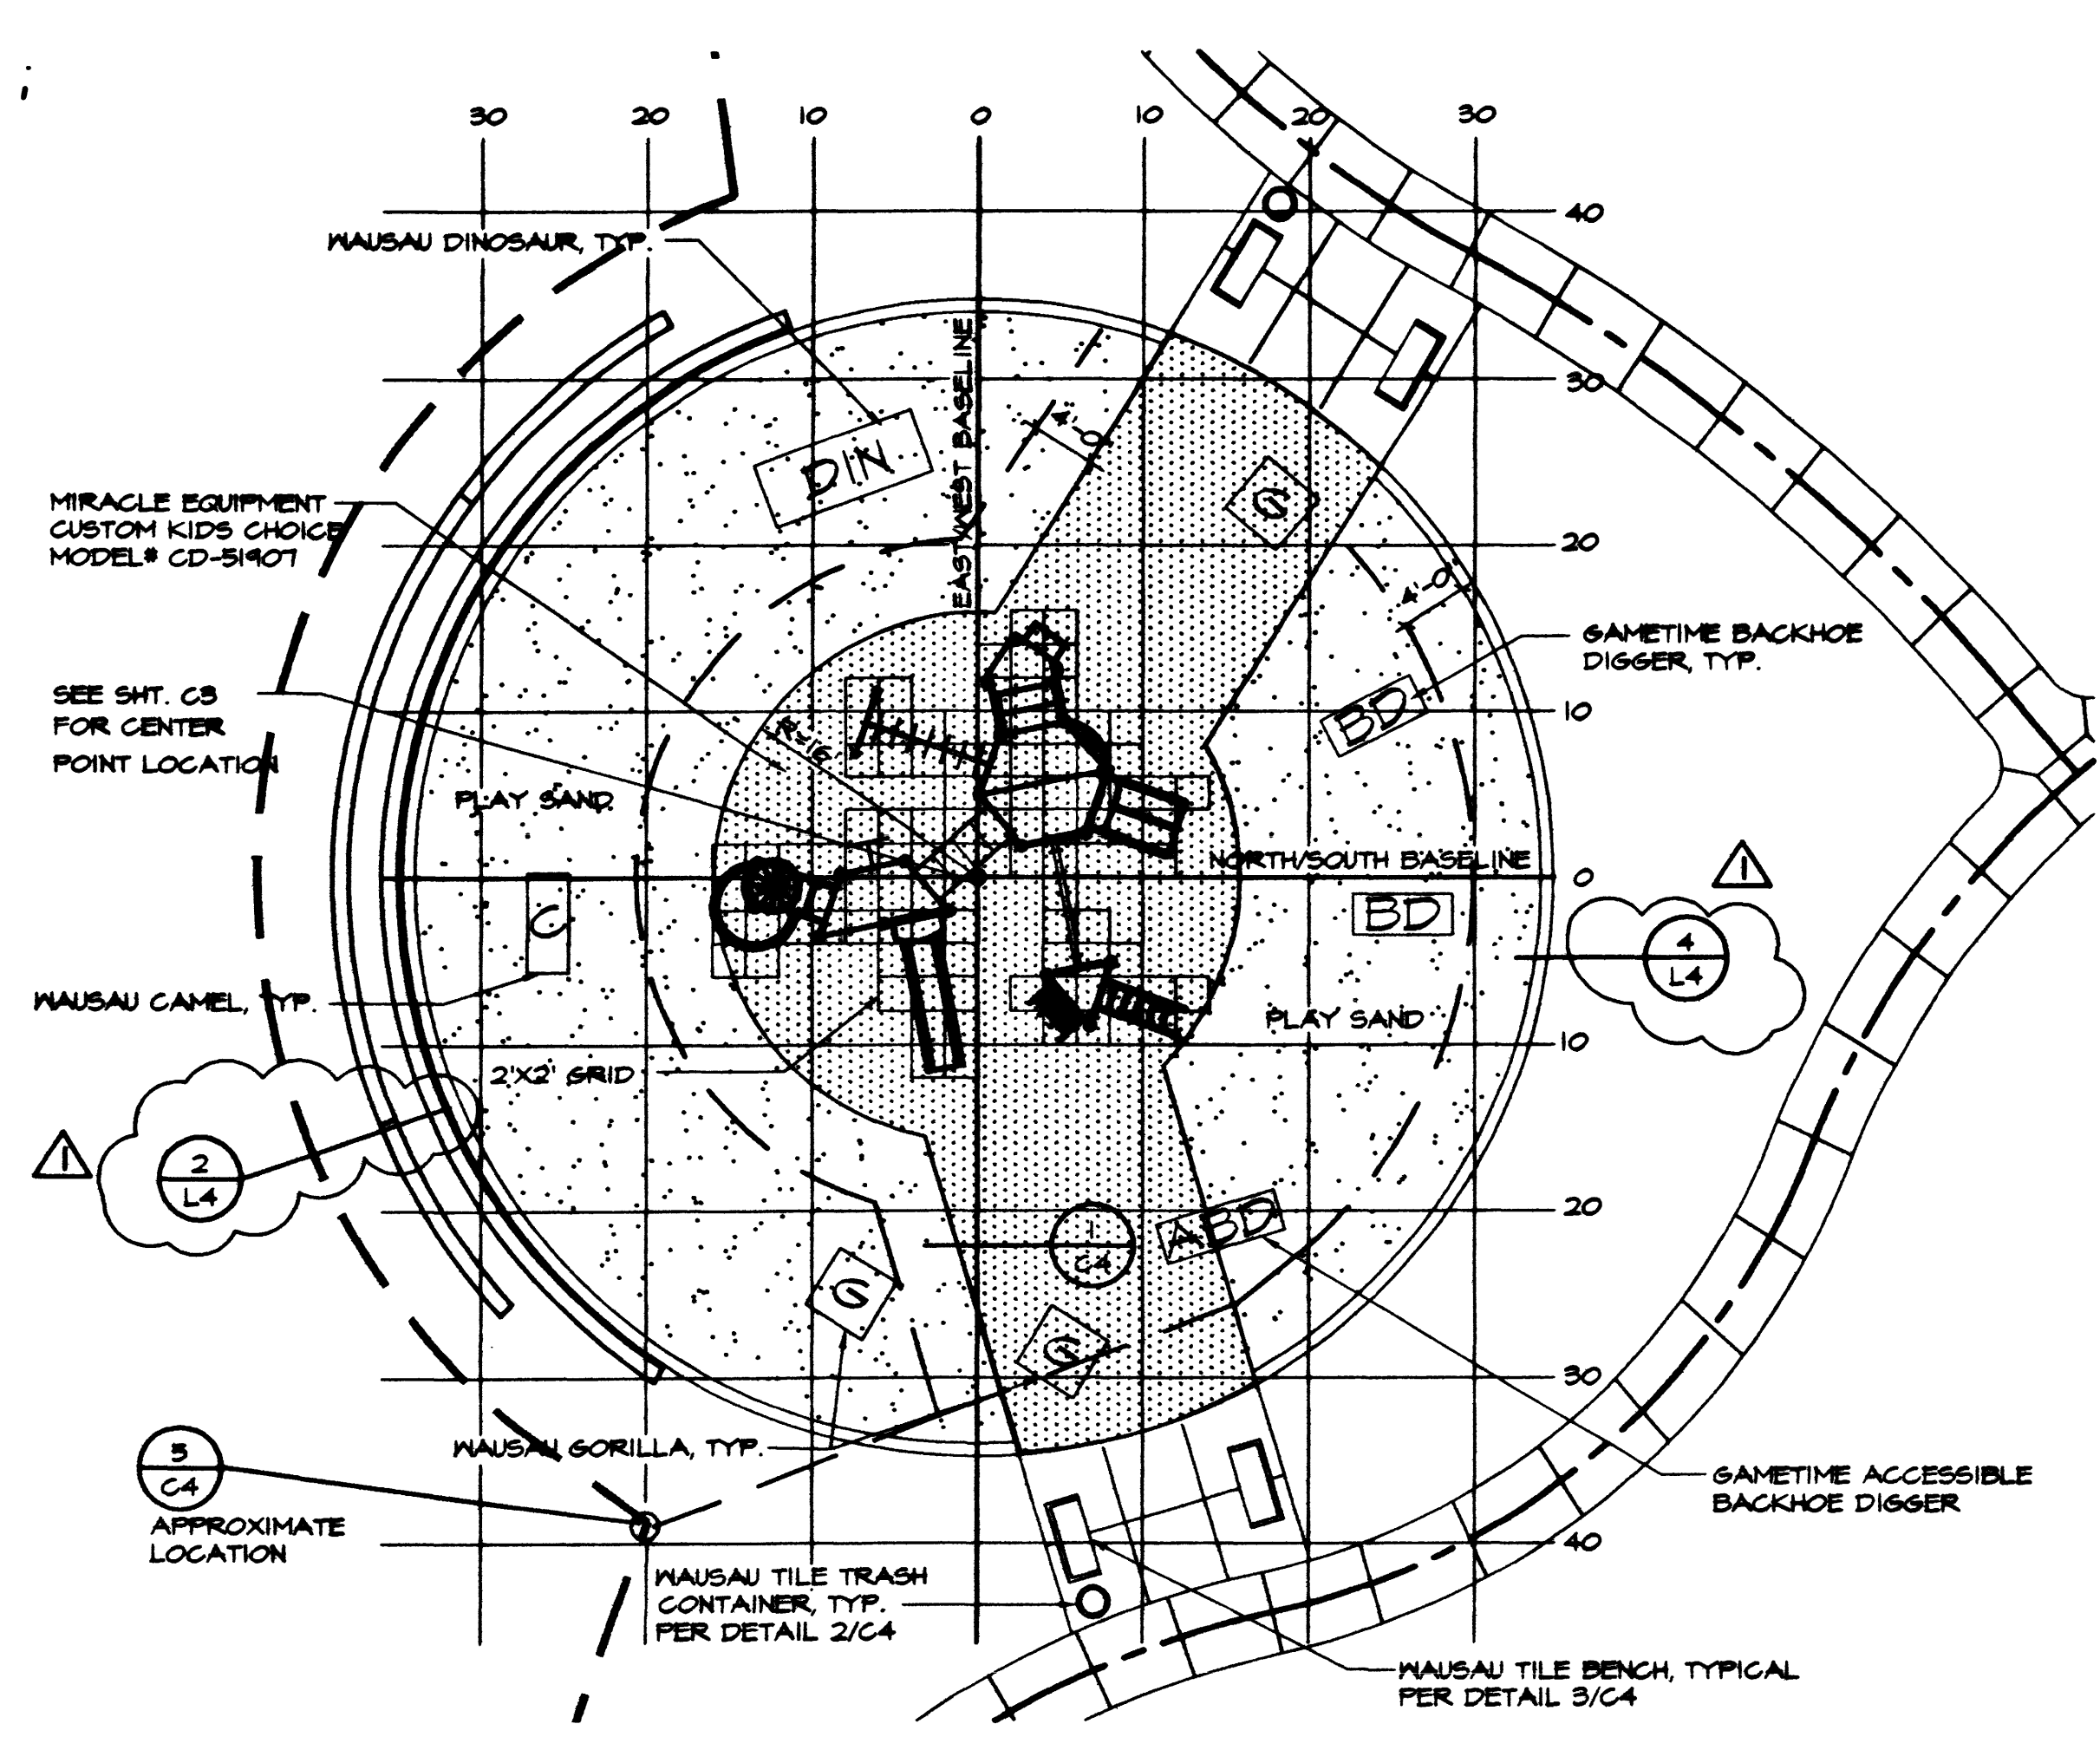


PLAYGROUND AREA

SCALE: 1"=10'-0"

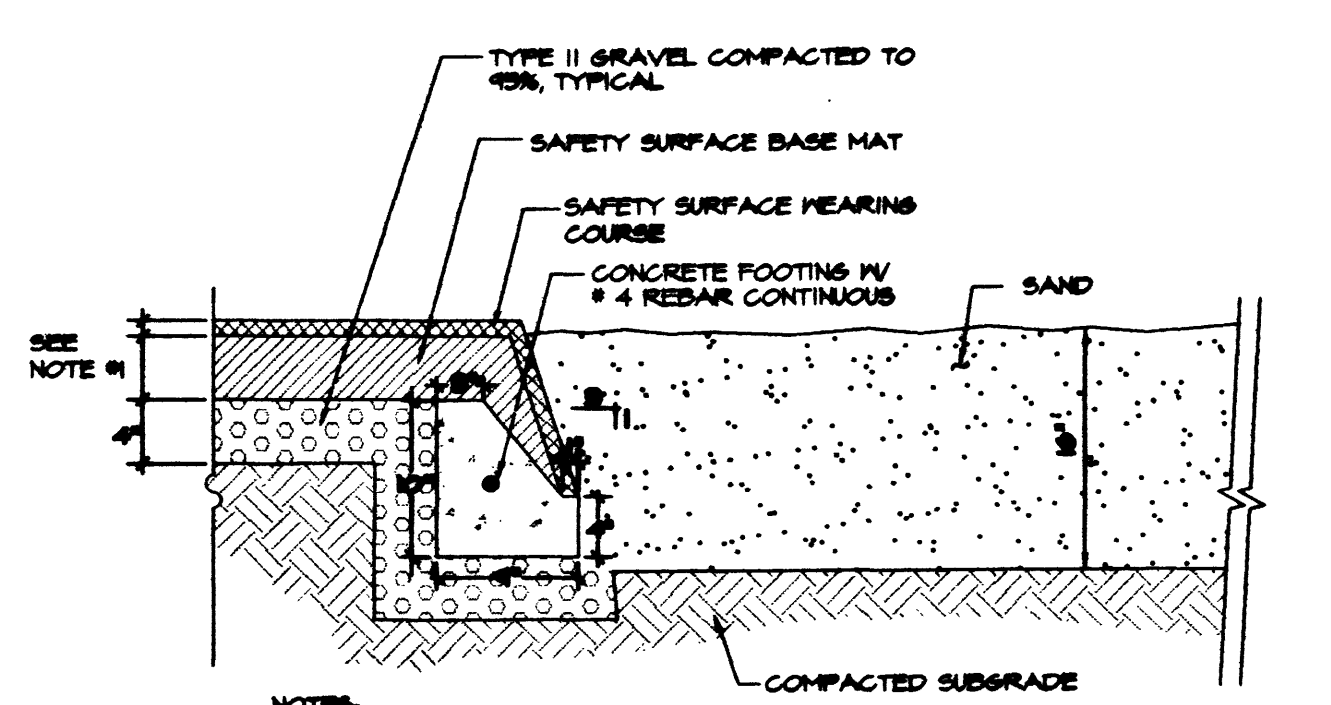

1
C4 PLAYGROUND SECTION
NOT TO SCALE

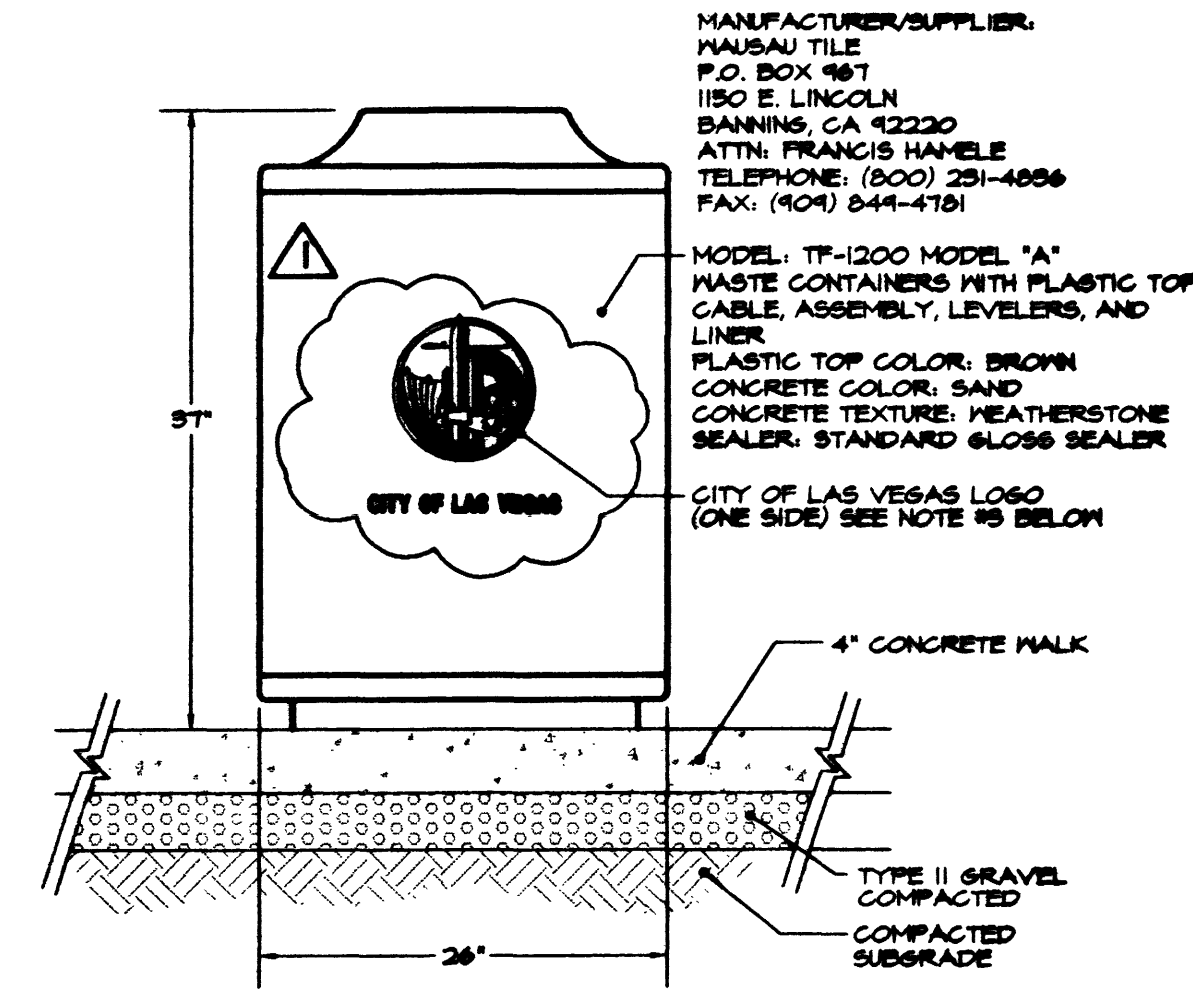

2
C4 TRASH RECEPTACLE
NOT TO SCALE


PLANS APPROVED
ARCHITECTURAL
Building & Safety Dept.
City of Las Vegas, Nevada

NOV 04 1999
City of Las Vegas, Nevada

PLAYGROUND/RECREATION AREA LAYOUT

date JUNE 1999

CHIEF, FIELD OP.

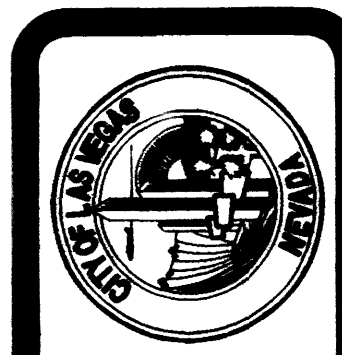

City of Las Vegas
DEPARTMENT OF PUBLIC WORKS

HERITAGE PARK
PHASE II
PARK IMPROVEMENT PLANS
CITY OF LAS VEGAS
CLARK COUNTY NEVADA

6 OF 43
C4
650.44A

PLANING\26151512\Phase II\PH2_playarea.dwg Wed Aug 11 10:31:27 1999

26666