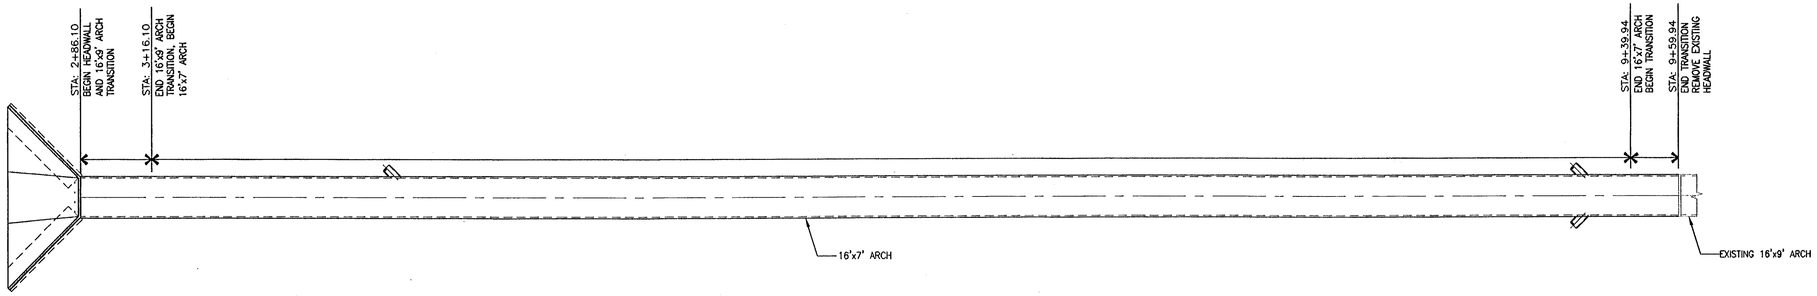

OVERALL PLAN SCALE: NO SCALE

RECORD COPY

116856

THESE PLANS, DRAWINGS AND DESIGNS ARE THE EXCLUSIVE PROPERTY OF ENGINEERING STRUCTURAL SOLUTIONS, AND SHALL NOT BE REPRODUCED IN ANY FORM WITHOUT WRITTEN CONSENT. ALL RIGHTS ARE RESERVED. COPYRIGHT 2006 ENGINEERING STRUCTURAL SOLUTIONS

SEAL: NEVADA STATE OF NEVADA PROFESSIONAL ENGINEER DOUGLAS H. WEBER No. 15117 STRUCTURAL DEC 21 2007

DESIGNED: J.W.
DRAWN: S.P.
CHECKED: J.W.
APPROVED:

ENGINEERING SYSTEM SOLUTIONS
4940 NORTH 29TH EAST, STE A
IDAHO FALLS, IDAHO 83401
Phone: (208) 552-9874
Fax: (208) 552-9302

HYDRO-ARCH
980 MARY CREST ROAD, UNIT B
HENDERSON, NV 89014

PROJECT: LA MADRE
LAS VEGAS, NV
FOR
HYDRO-ARCH

SHEET TITLE: OVERALL

REV.	DESCRIPTION	DATE
	SUBMITTED FOR APPROVAL	12/21/07

DATE: December 13, 2007
PROJECT NUMBER: 26 07455
SHEET NUMBER:
S0.2