


NOTE: SEE CIVIL DRAWINGS FOR LEACH FIELD AND UTILITIES

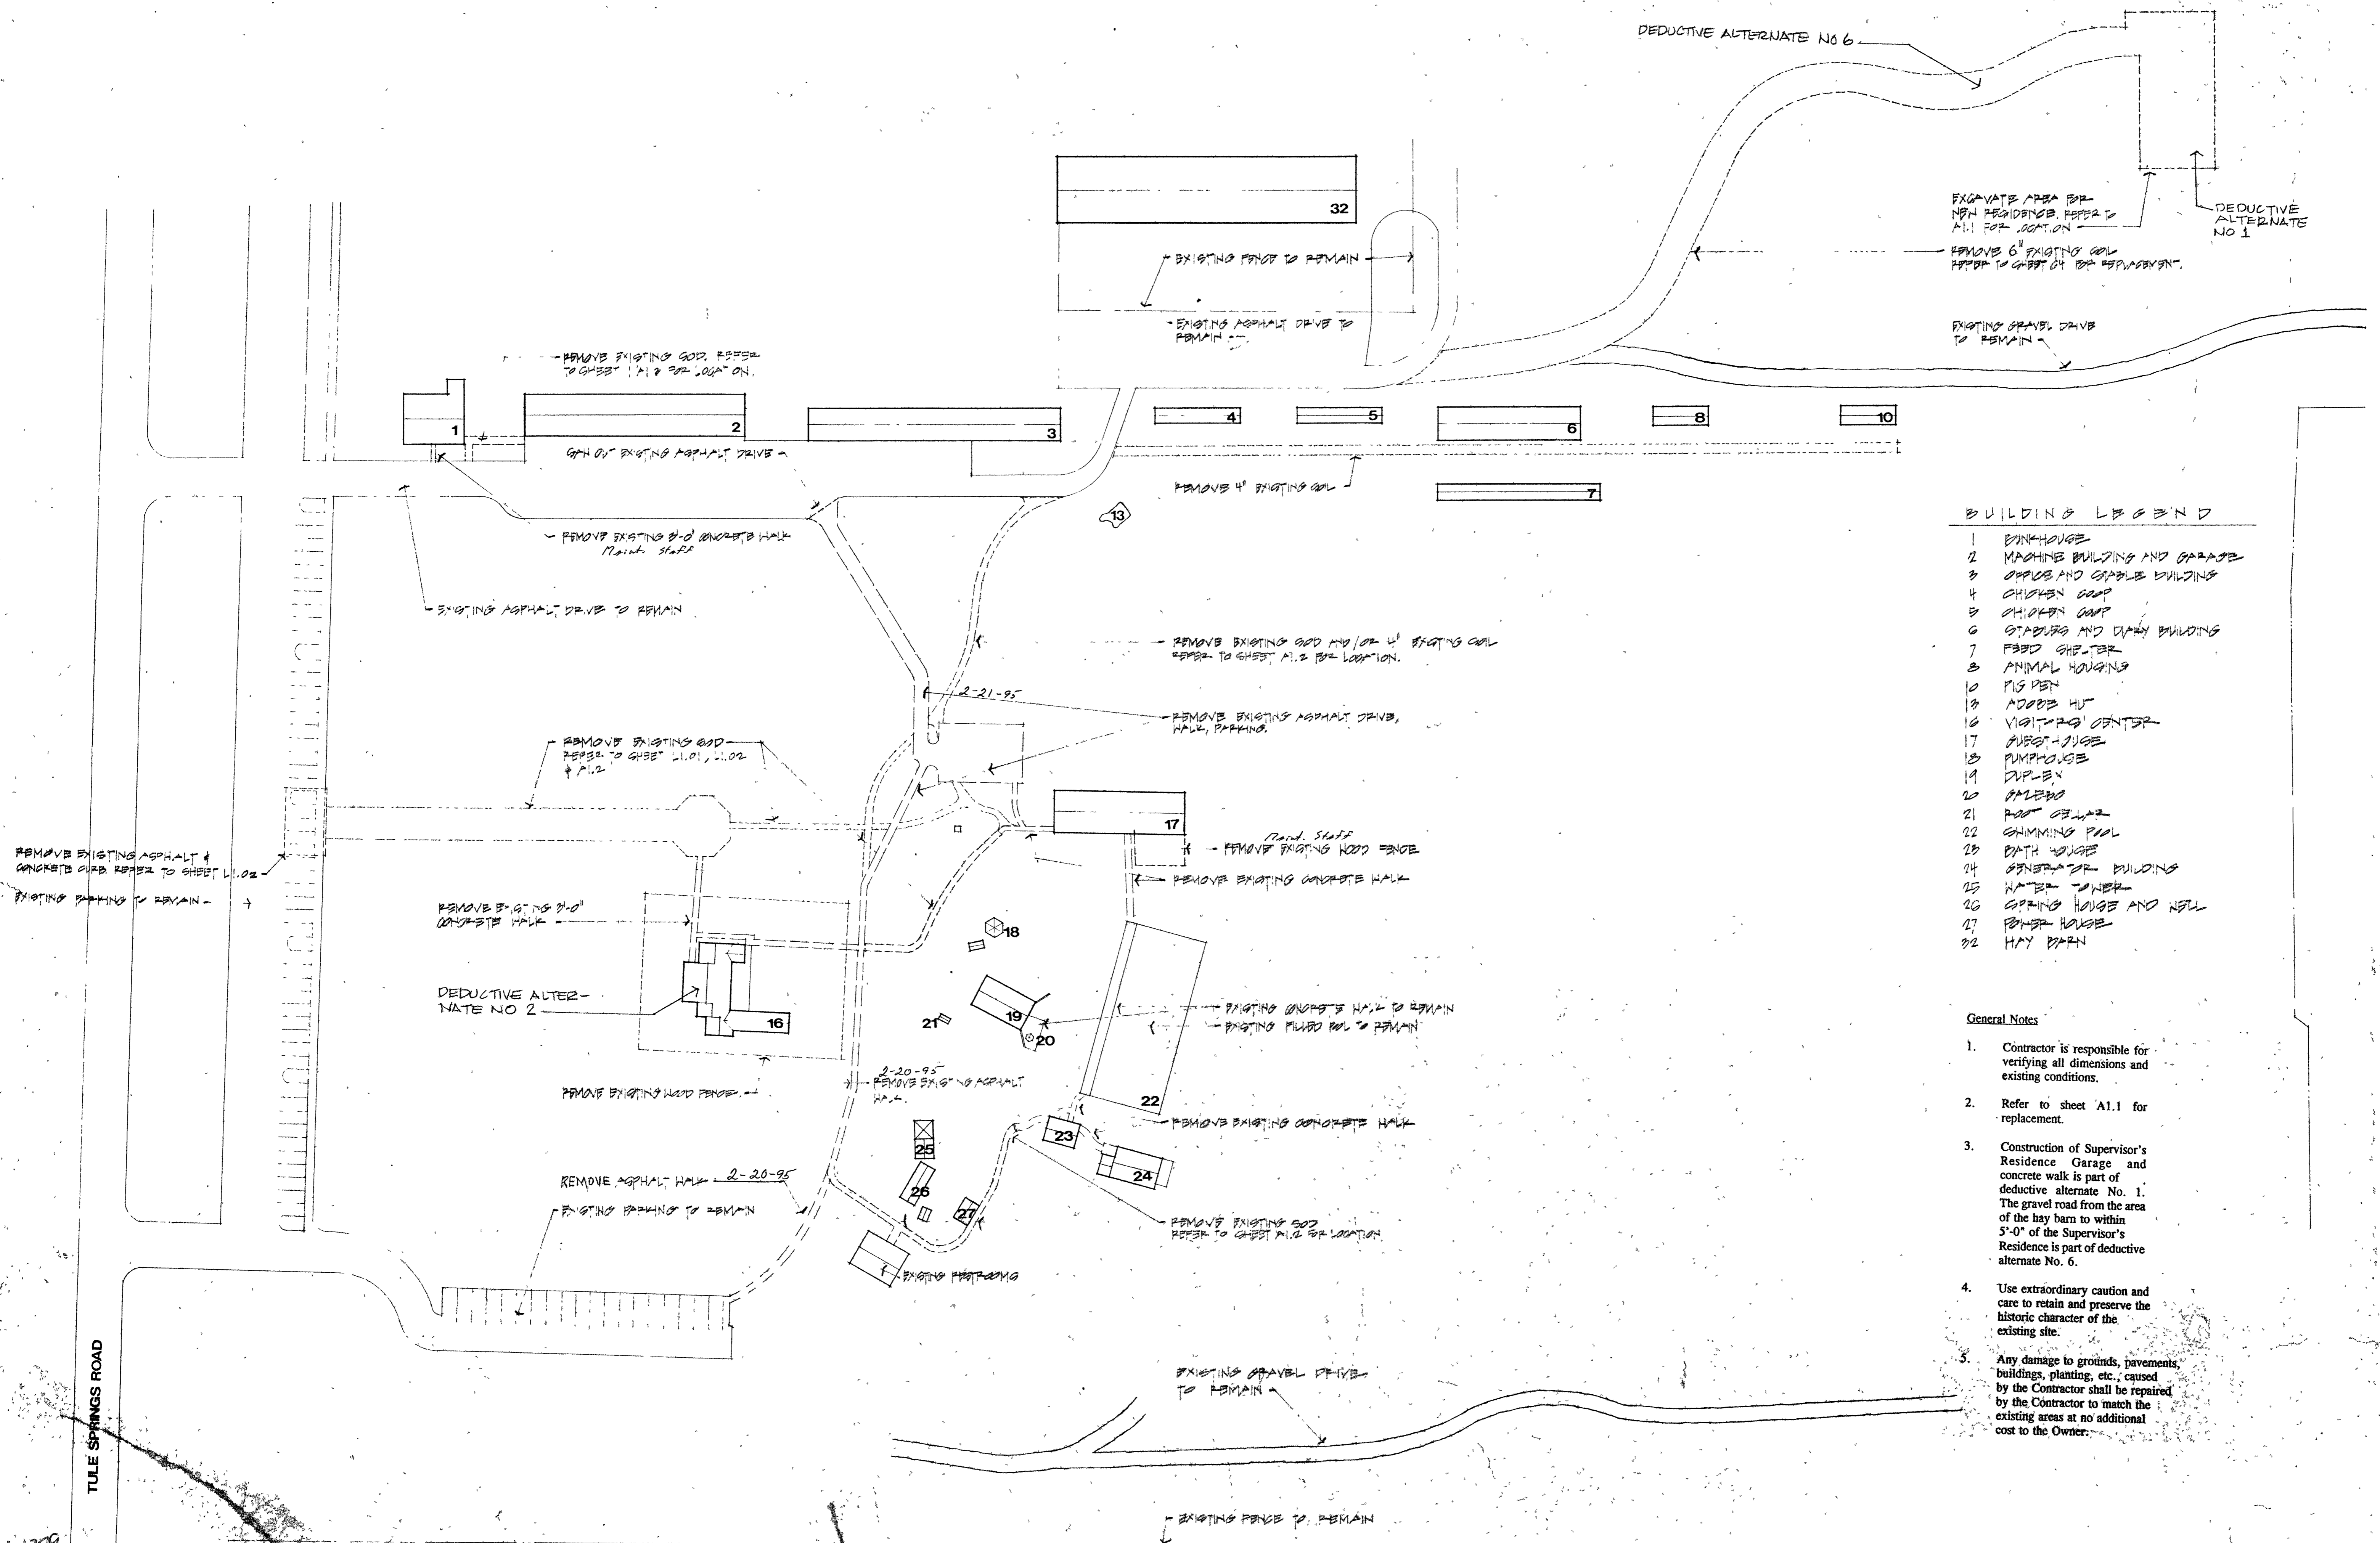

**BUILDING LEGEND**

1	BUNKHOUSE
2	MACHINE BUILDING AND GARAGE
3	OFFICE AND STORAGE BUILDING
4	CHICKEN COOP
5	CHICKEN COOP
6	STABLES AND DAIRY BUILDING
7	FEED SHELTER
8	ANIMAL HOUSING
10	FIS PEN
13	ADDER HUT
16	VISITORS CENTER
17	GUEST HOUSE
18	PUMPHOUSE
19	DUPLEX
20	SLEEPO
21	ROOM CELLAR
22	SHIMMING POOL
23	BATH HOUSE
24	GENERATOR BUILDING
25	WATER TOWER
26	SPRING HOUSE AND WELL
27	PORCH HOUSE
32	HAY BARN

**General Notes**

- Contractor is responsible for verifying all dimensions and existing conditions.
- Refer to sheet A1.1 for replacement.
- Construction of Supervisor's Residence Garage and concrete walk is part of deductive alternate No. 1. The gravel road from the area of the hay barn from the area of the Supervisor's Residence is part of deductive alternate No. 6.
- Use extraordinary caution and care to retain and preserve the historic character of the existing site.
- Any damage to grounds, pavements, buildings, planting, etc., caused by the Contractor shall be repaired by the Contractor to match the existing areas at no additional cost to the Owner.

Patrick J. Kern, AIA  
Wayne P. Schreier, AIA  
Thomas M. Siva, AIA

**HSA ARCHITECTS, INC.**  
Architecture Planning Interiors  
5531 West Oakey Boulevard, Las Vegas, Nevada 89102  
(702) 383-0077

**DEMOLITION SITE PLAN**  
FLOYD LAMB STATE PARK

Job No. 910902.0  
Date 7/1/94  
Drawn By SMH  
Check TS

Sheet A1.0  
24

DEMOLITION SITE PLAN

TULE SPRINGS ROAD

10279