
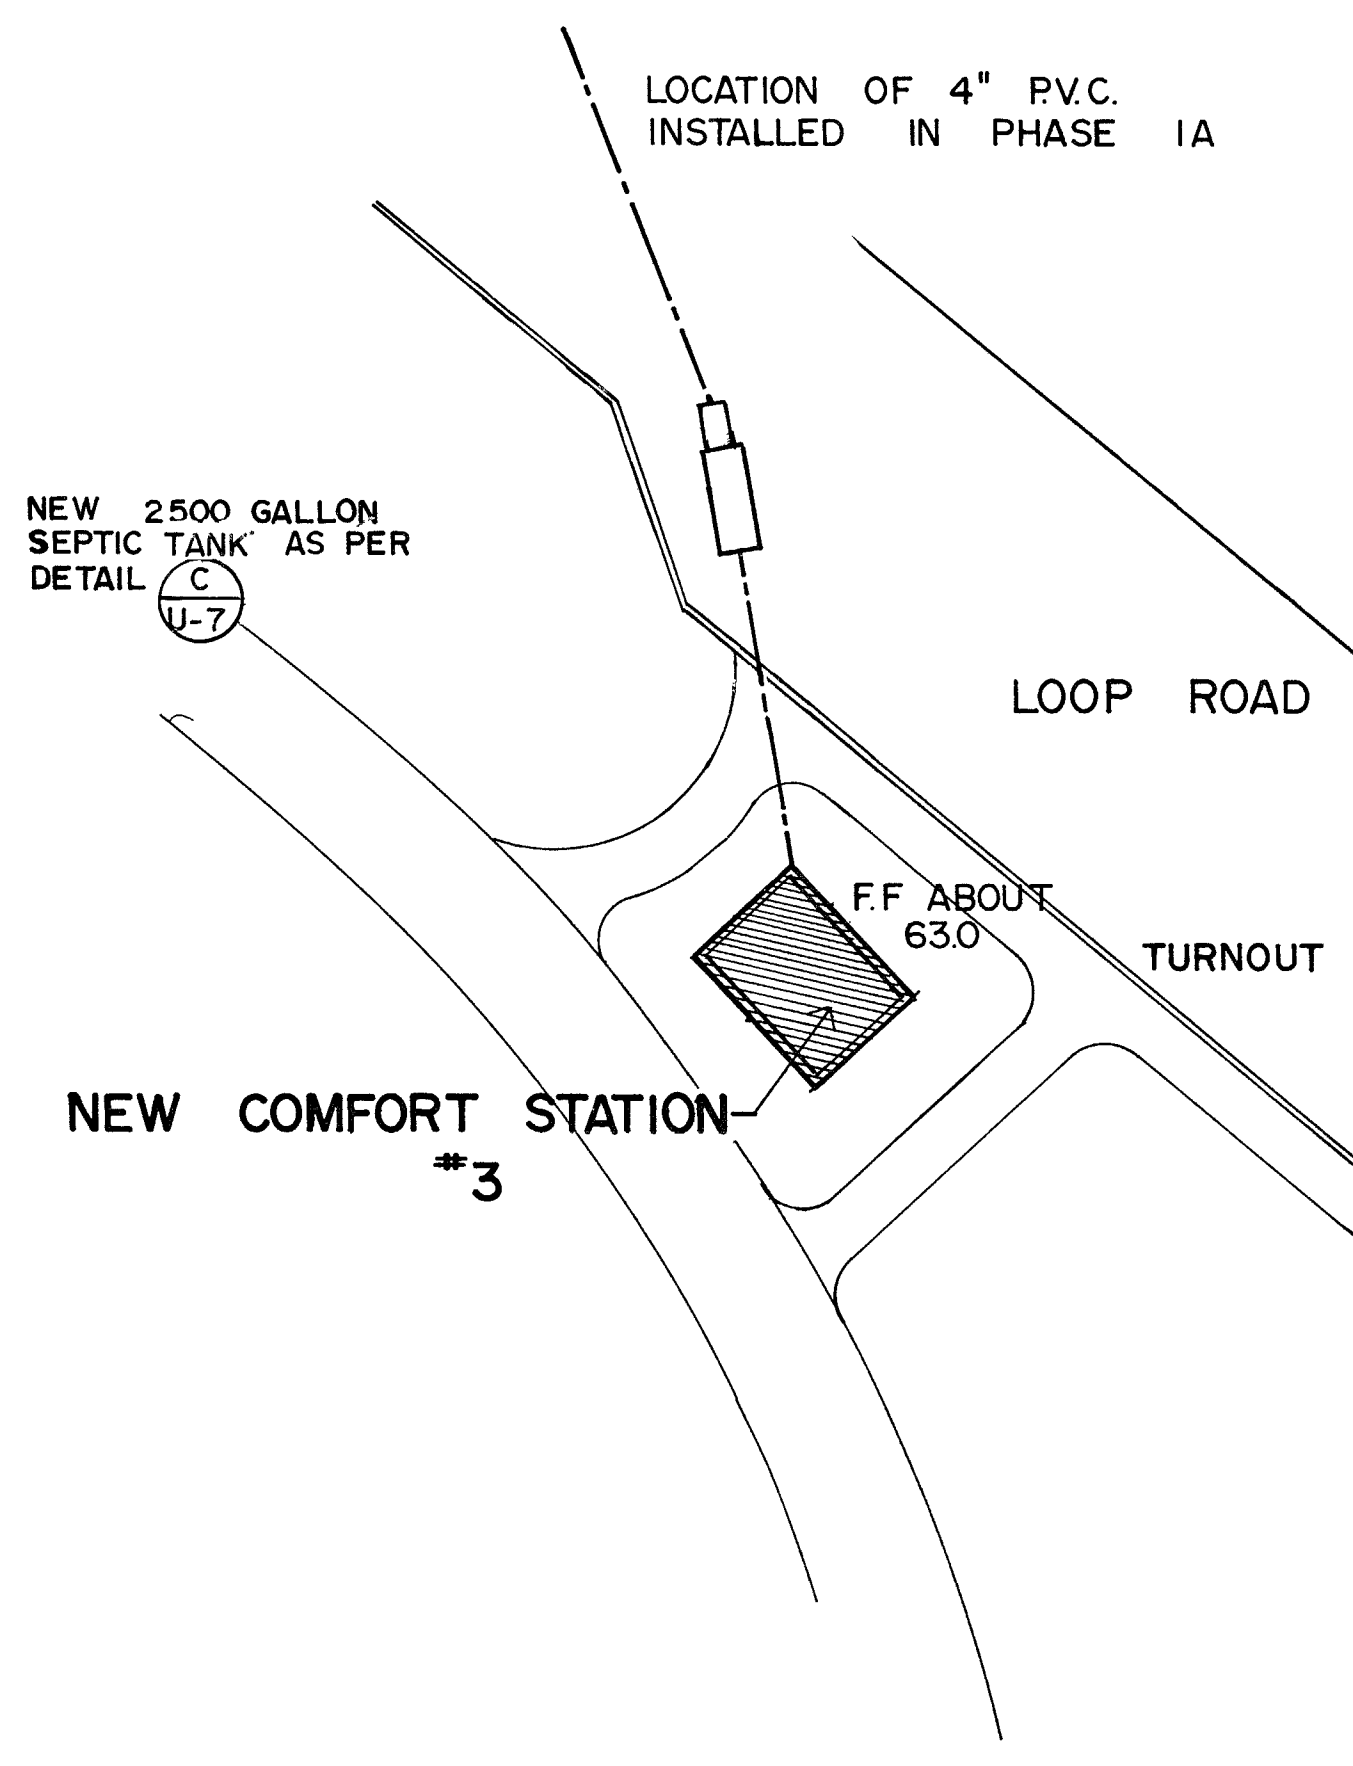
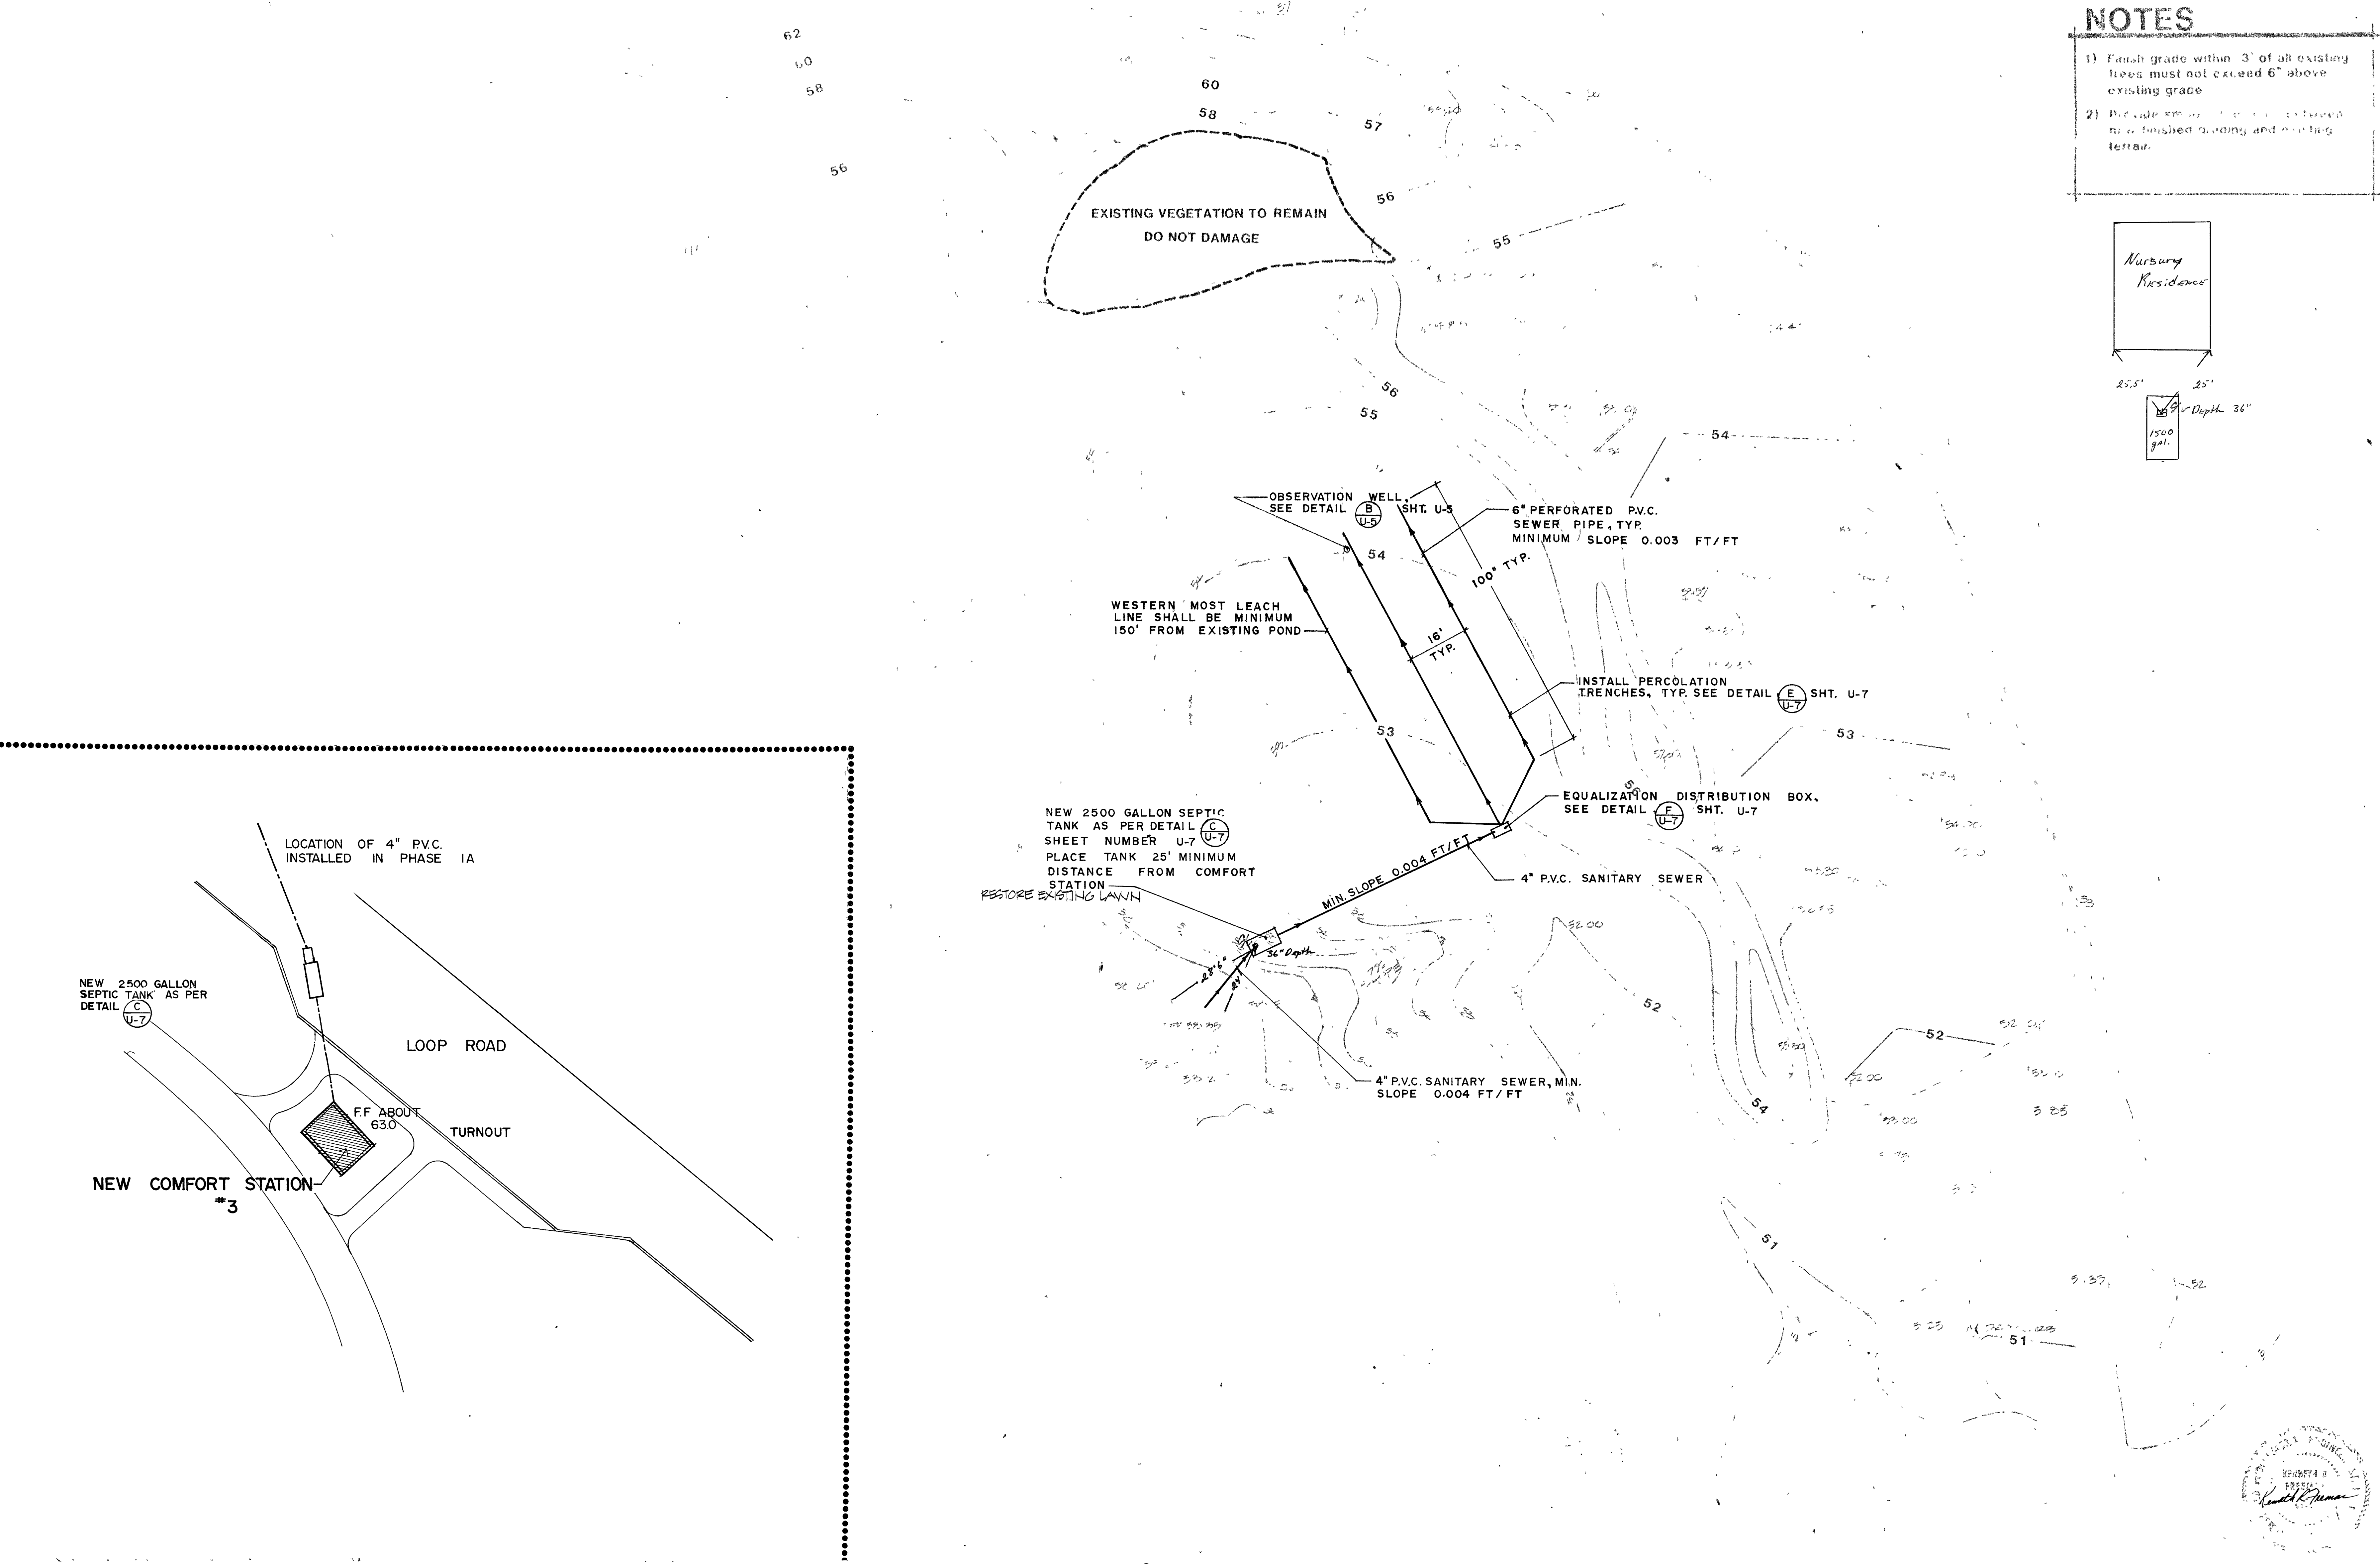





NOTES

- 1) Finish grade within 3' of all existing trees must not exceed 6" above existing grade
- 2) Provide smooth transition between finished grading and existing terrain.

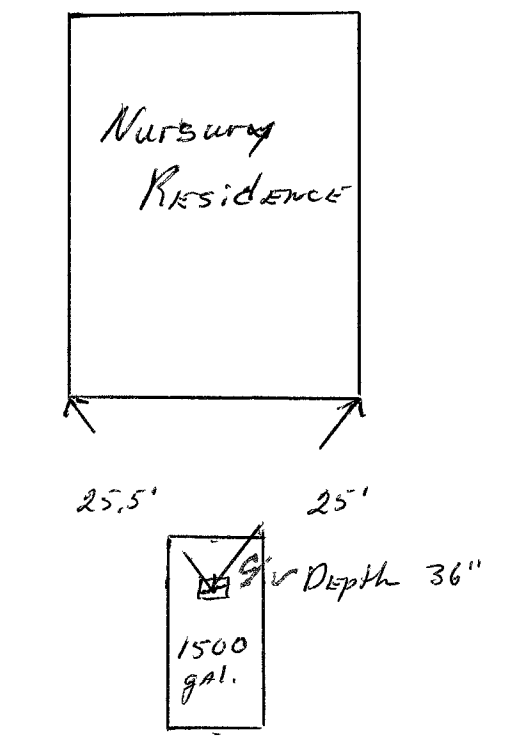

COMFORT STATION #3 & #4 SEWAGE SYSTEM

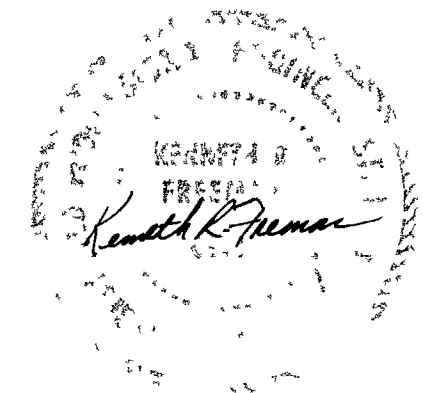

101357