3-24-87 LANDSCAPE NOTES

200 LAWN BOXES
IN BACK SECTION

Completed
10-87

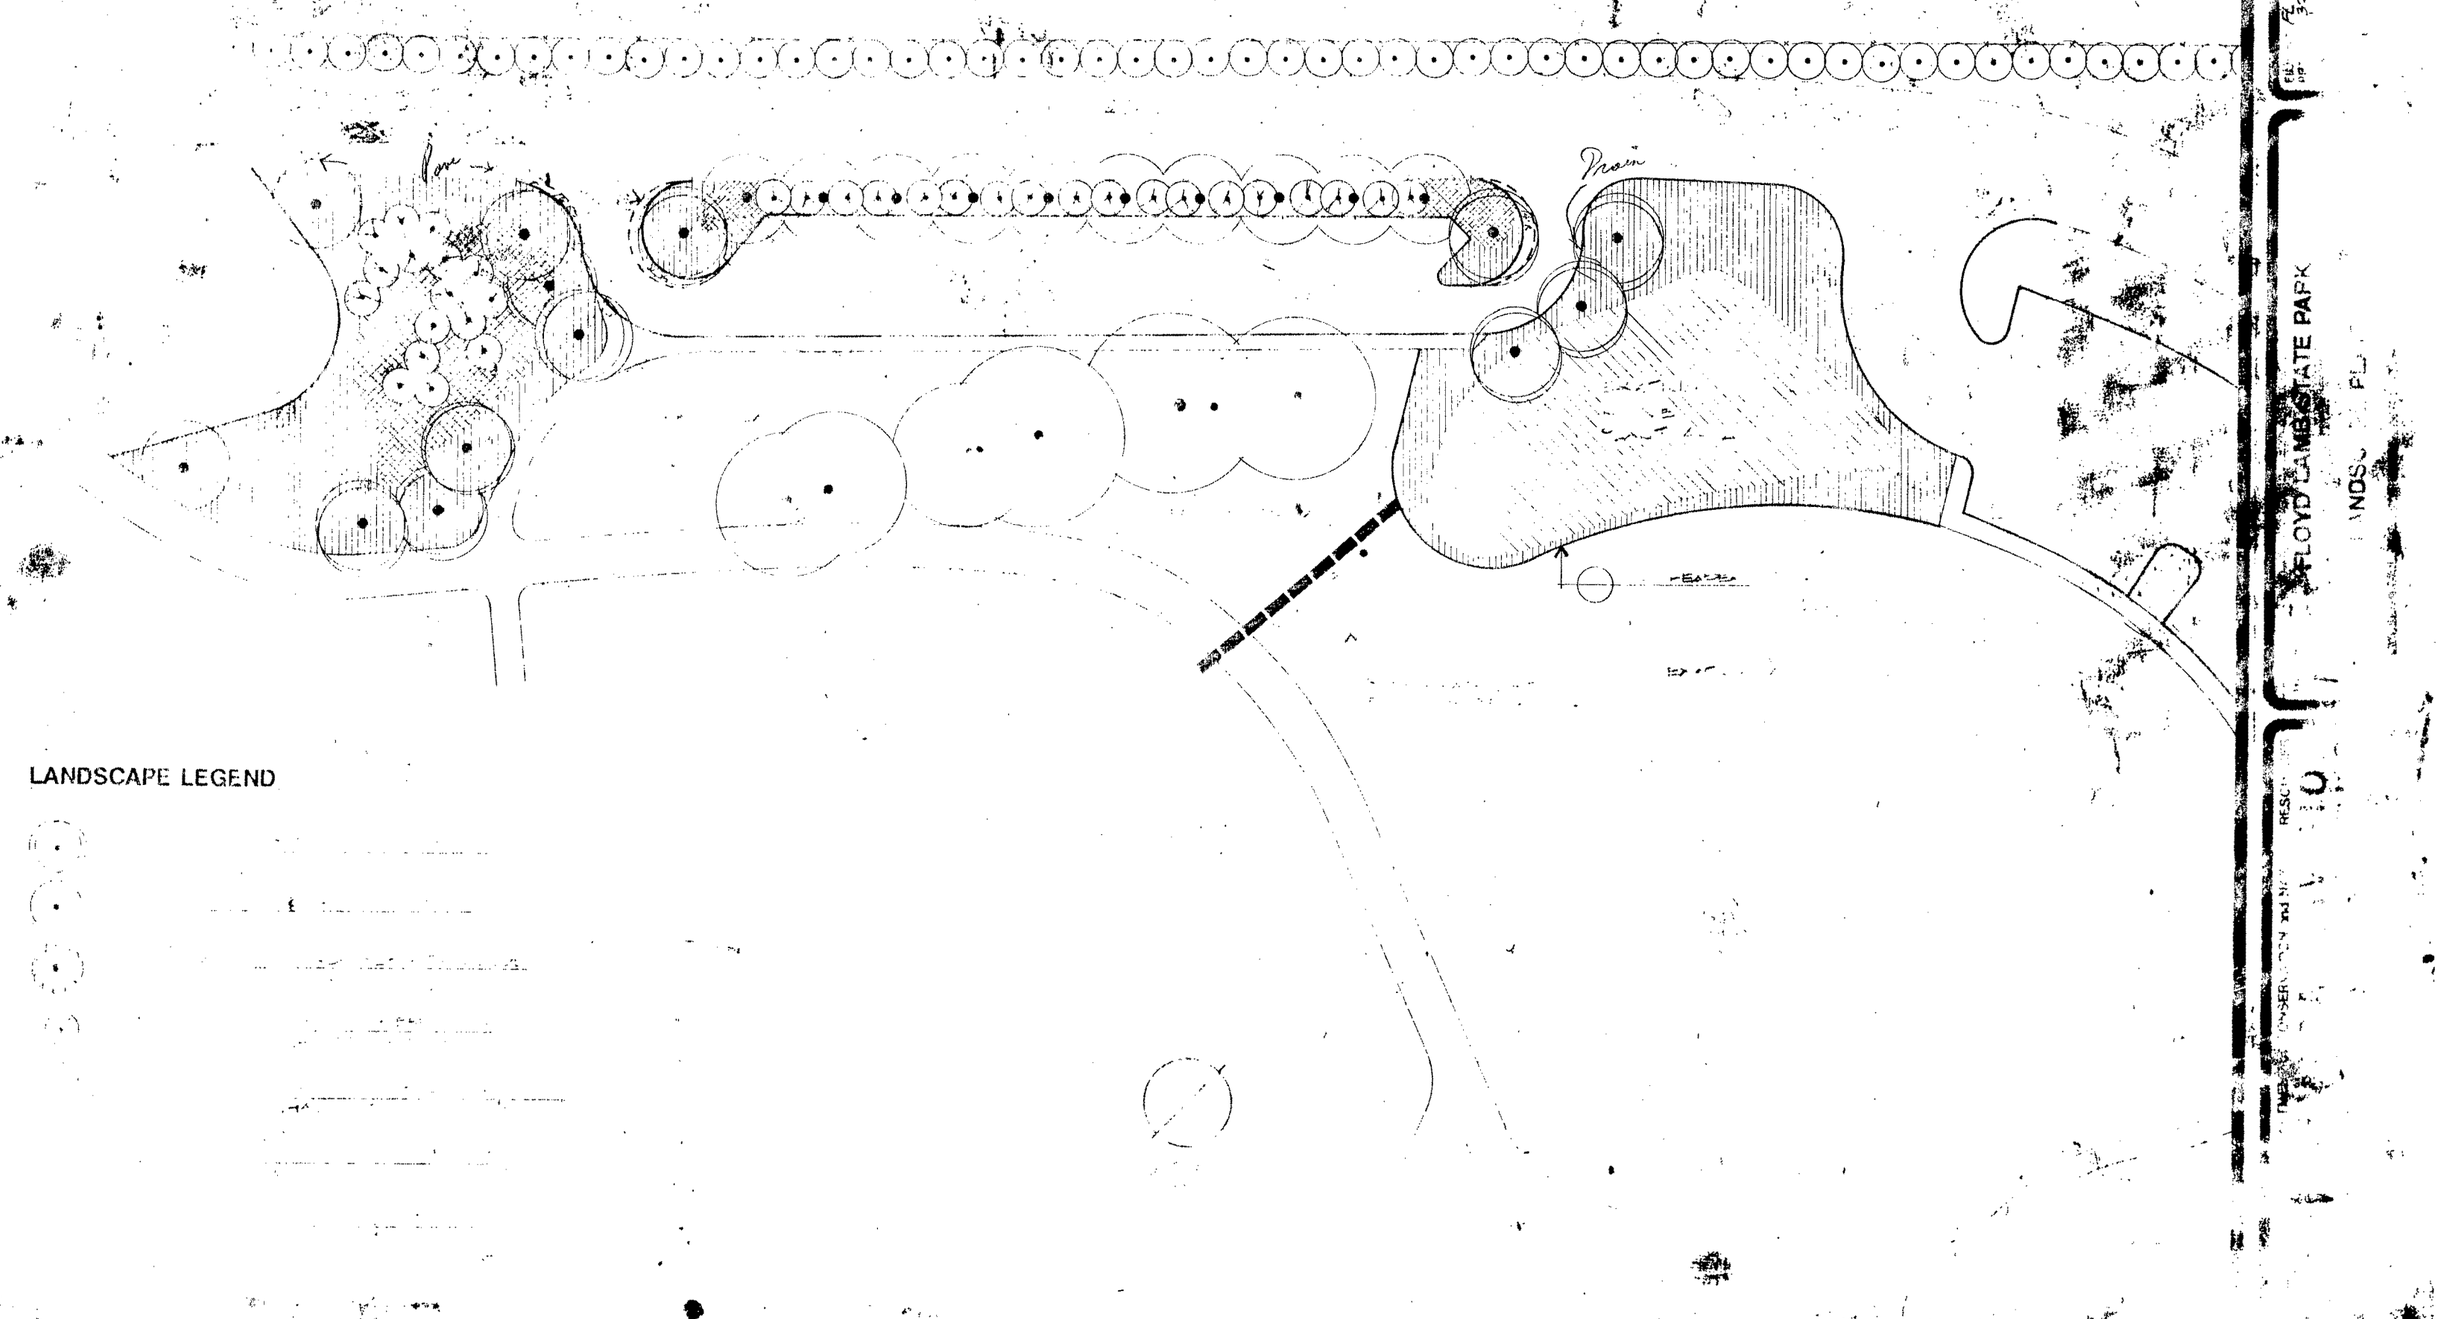

LANDSCAPE LEGEND