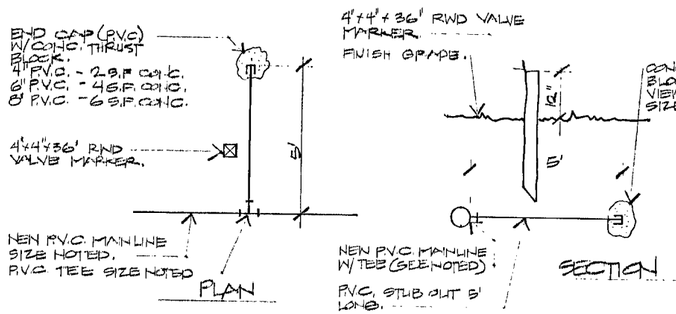

DETAIL NO. 4
NO SCALE

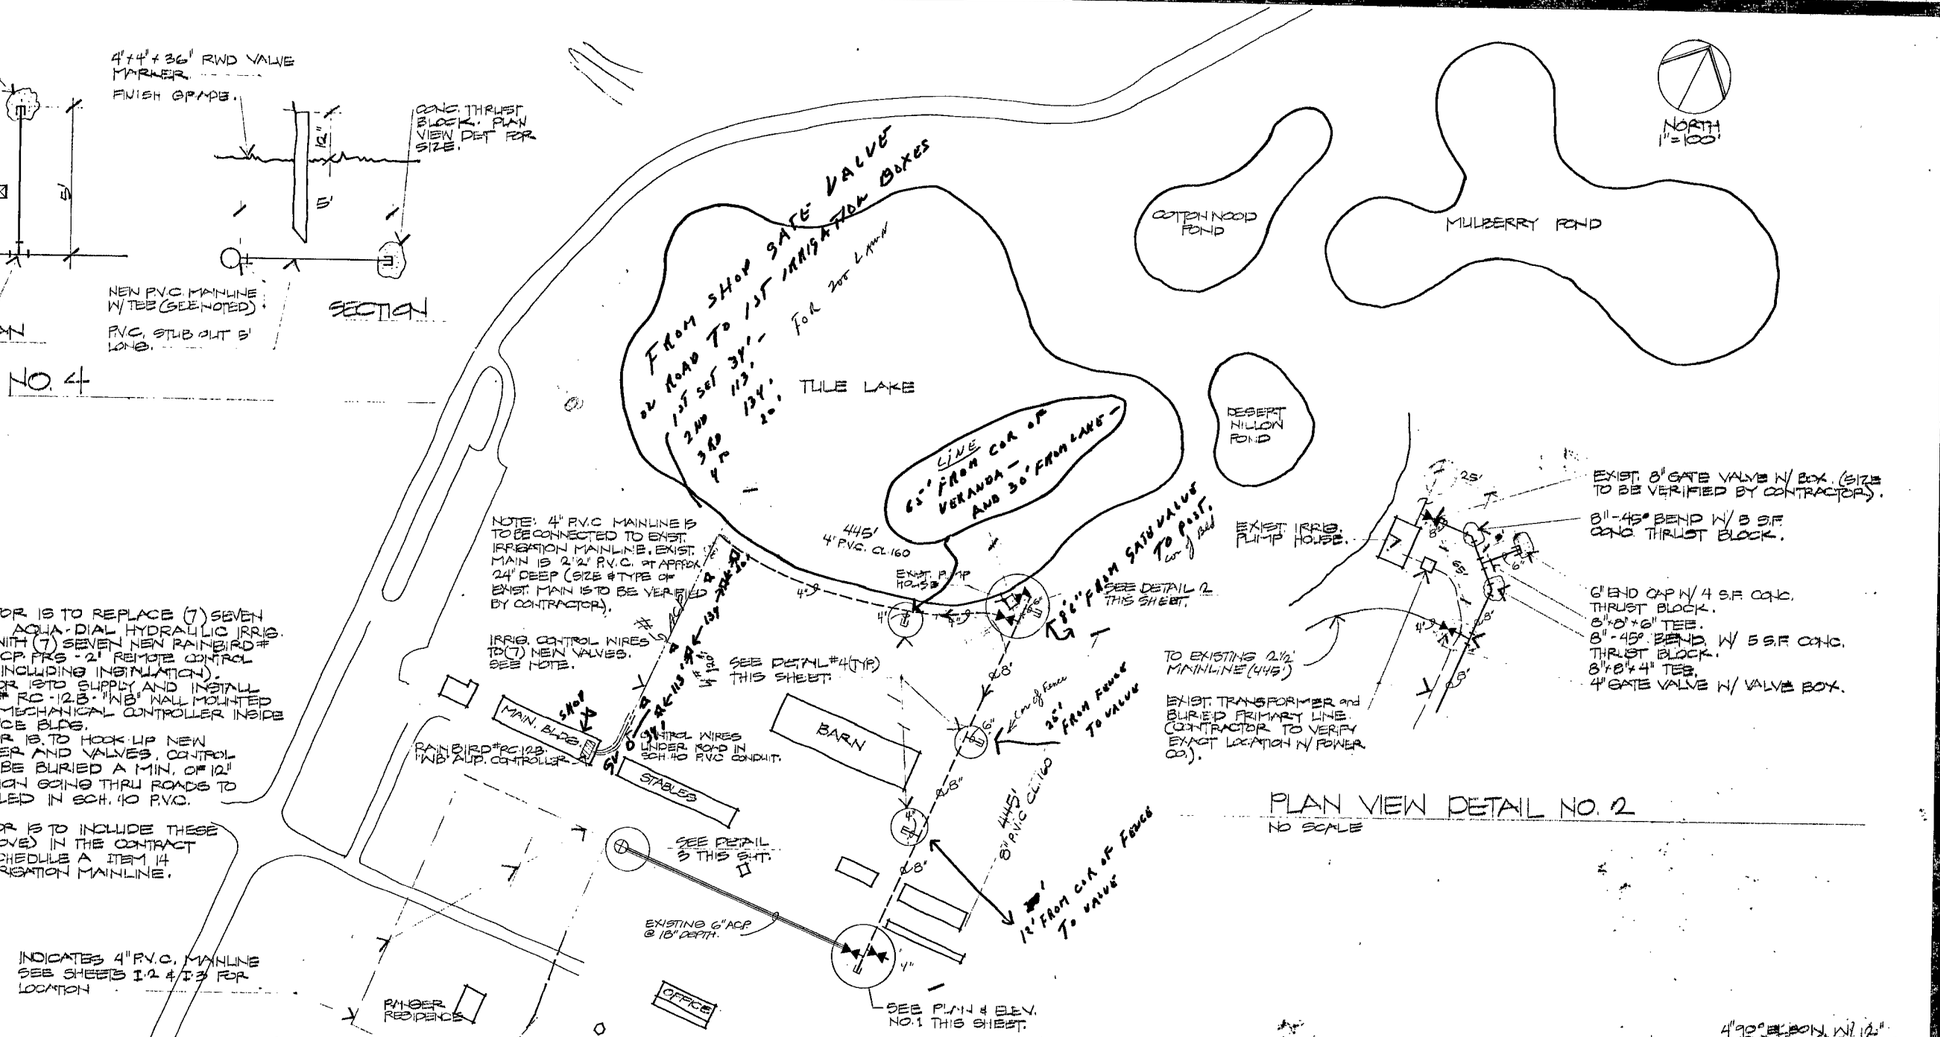

PLAN VIEW DETAIL NO. 2
NO SCALE

NOTE:
- CONTRACTOR IS TO REPLACE (7) SEVEN EXISTING AQUA-DIAL HYDRAULIC IRRIG. VALVES WITH (7) SEVEN NEW RAINBIRD # 200-EPA-CP. FRS-2' REMOTE CONTROL VALVES. (INCLUDING INSTALLATION).
- CONTRACTOR IS TO SUPPLY AND INSTALL RAINBIRD # RC-12B-NB' WALL MOUNTED ELECTRO-MECHANICAL CONTROLLER INSIDE MAINTENENCE BLDG.
- CONTRACTOR IS TO HOOK UP NEW CONTROLLER AND VALVES. CONTROL WIRES TO BE BURIED A MIN. OF 12" WITH SECTION GOING THRU ROADS TO BE INSTALLED IN SCH. 40 P.V.C. CONDUIT.
- CONTRACTOR IS TO INCLUDE THESE ITEMS (ABOVE) IN THE CONTRACT BIDDING SCHEDULE A ITEM 14 4" & P.V.C. IRRIGATION MAINLINE.

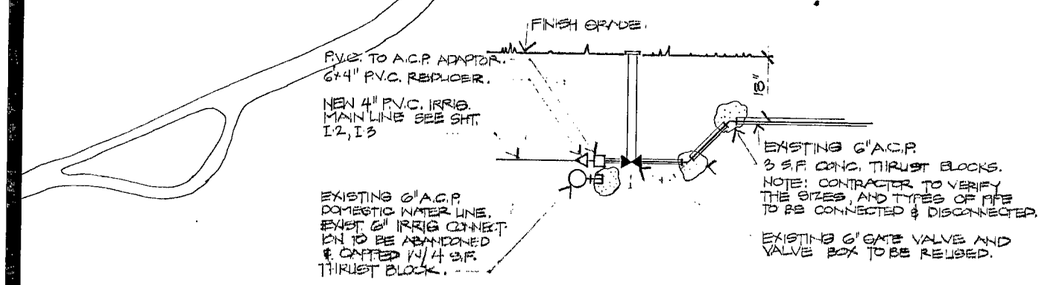

DETAIL NO. 3
NO SCALE

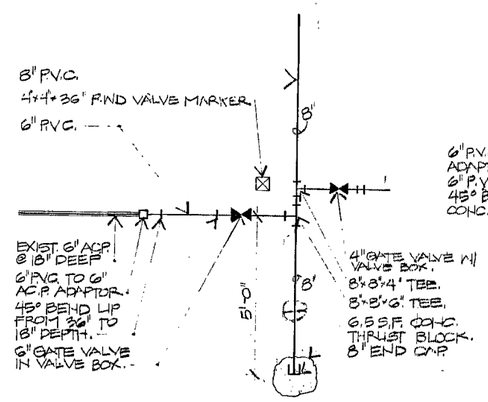

PLAN VIEW NO. 1
NO SCALE DETAIL

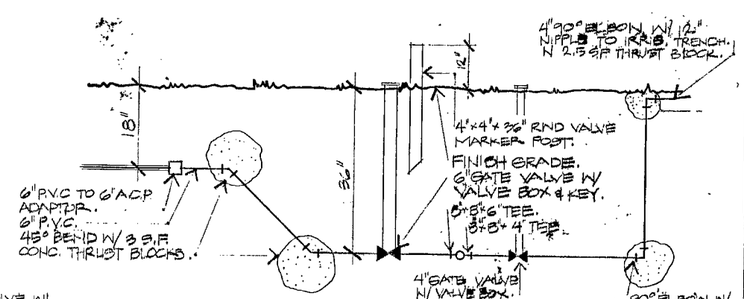

ELEVATION NO. 1
NO SCALE DETAIL

NOTE:
- SEE IRRIGATION LEGEND, NOTES, and DETAILS SHEETS I-5, 6, 7, 8.
- SEE IRRIGATION SPEC'S. SECTION 02150.

date MAY 82
revisions

FILE NO. F-8.83 HWD
PROJ. NO. 2.00.02.02
PROJ. COORD. Initial date
UNIT. SUPV.
ASST. ADM. P&D
ASST. ADM. O&M
DIV. ADMIN.

IRRIGATION MAINLINE PLAN

DEPARTMENT of CONSERVATION and NATURAL RESOURCES
NEVADA DIVISION OF STATE PARKS
CAPITOL COMPLEX CARSON CITY NEVADA 89710

I-1 OF 17