



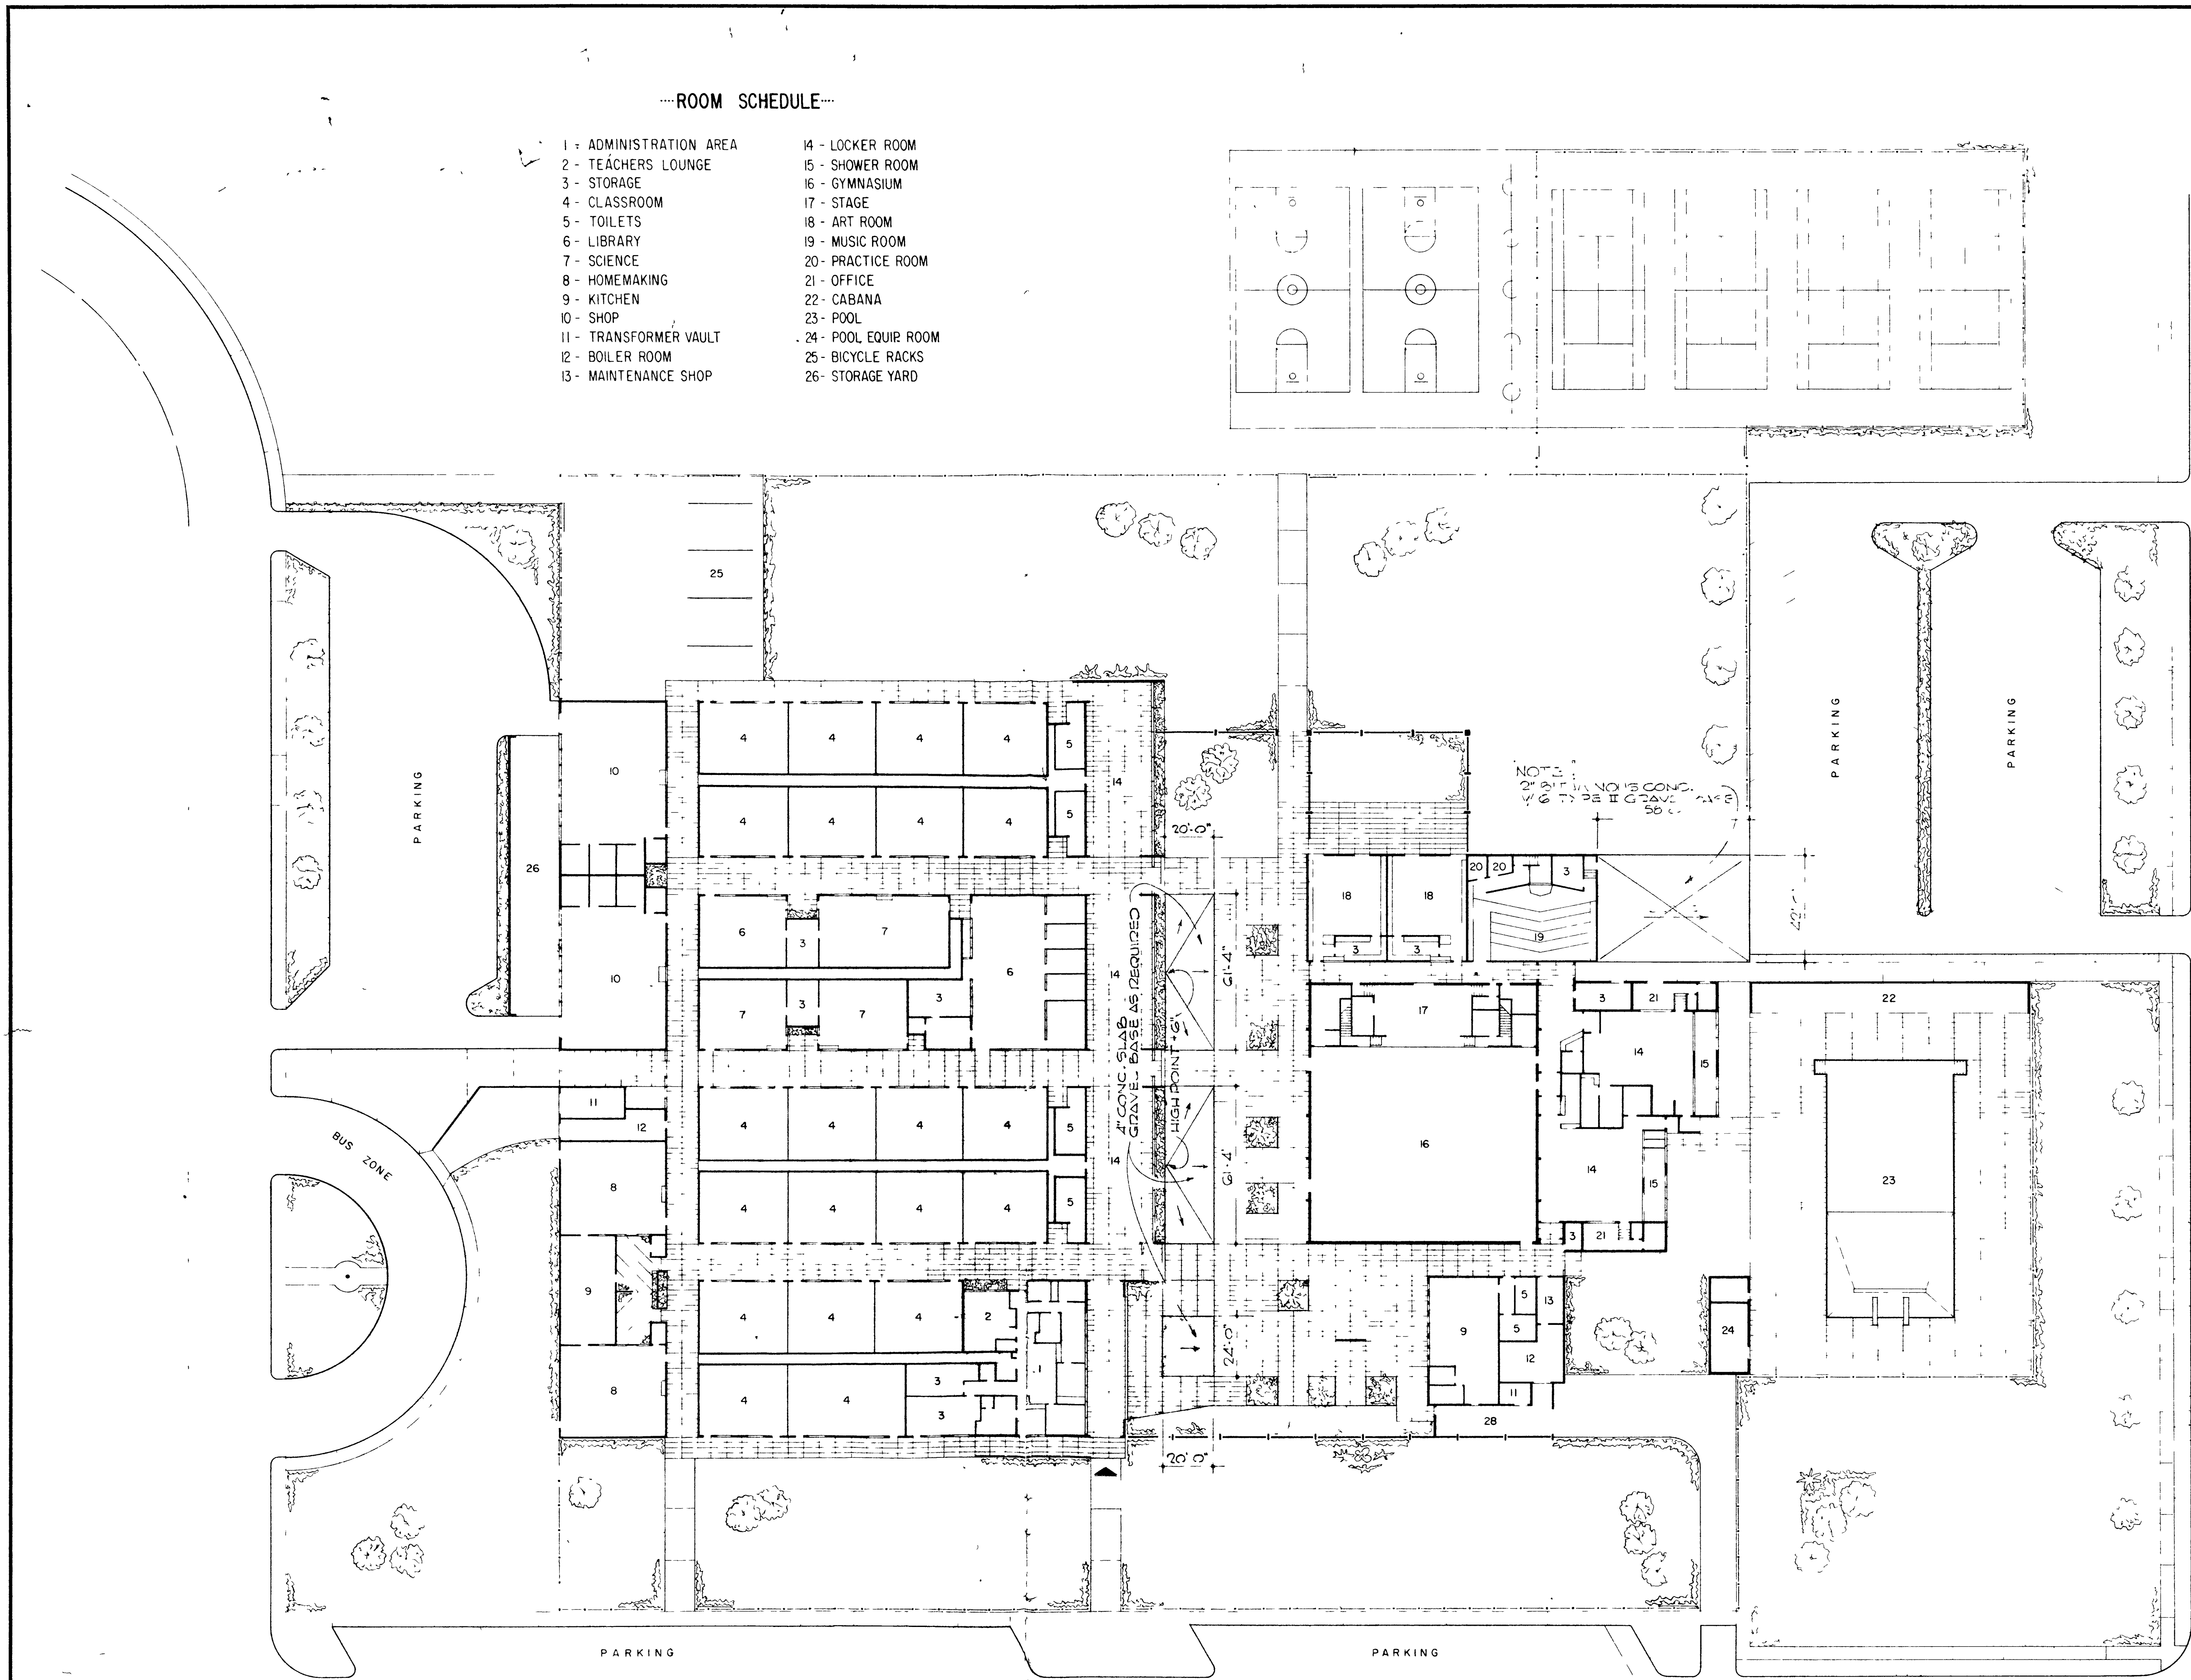

HYDE PARK JUNIOR HIGH SCHOOL
LAS VEGAS NEVADA
A R C H I T E C T S
WALTER ZICK & HARRIS SHARP
LAS VEGAS NEVADA

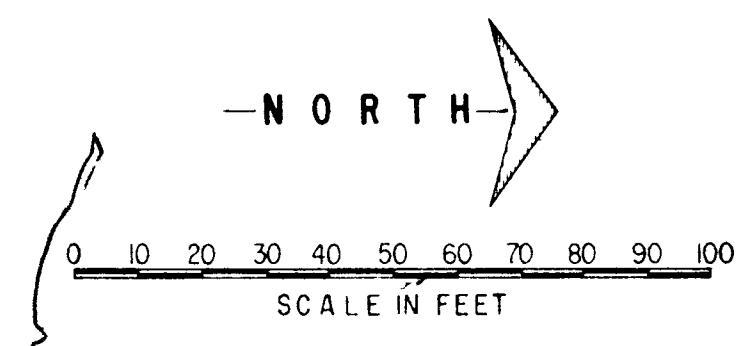

MEMBERS OF THE A. I. A.	
FROM THE OFFICE OF: A R C H I T E C T S ZICK & SHARP 1806 S. MAIN ST. LAS VEGAS, NEVADA	
NO. DATE	R E V I S I O N S
SHEET TITLE: HYDE PARK JUNIOR HIGH SCHOOL JOB: HYDE PARK JUNIOR HIGH SCHOOL LAS VEGAS, NEVADA	
JOB NUMBER 159-1	DATE 7/15/57
DRAWN BY H. S.	CHECKED H. S.
SHEET NUMBER 32	
OF 8	

