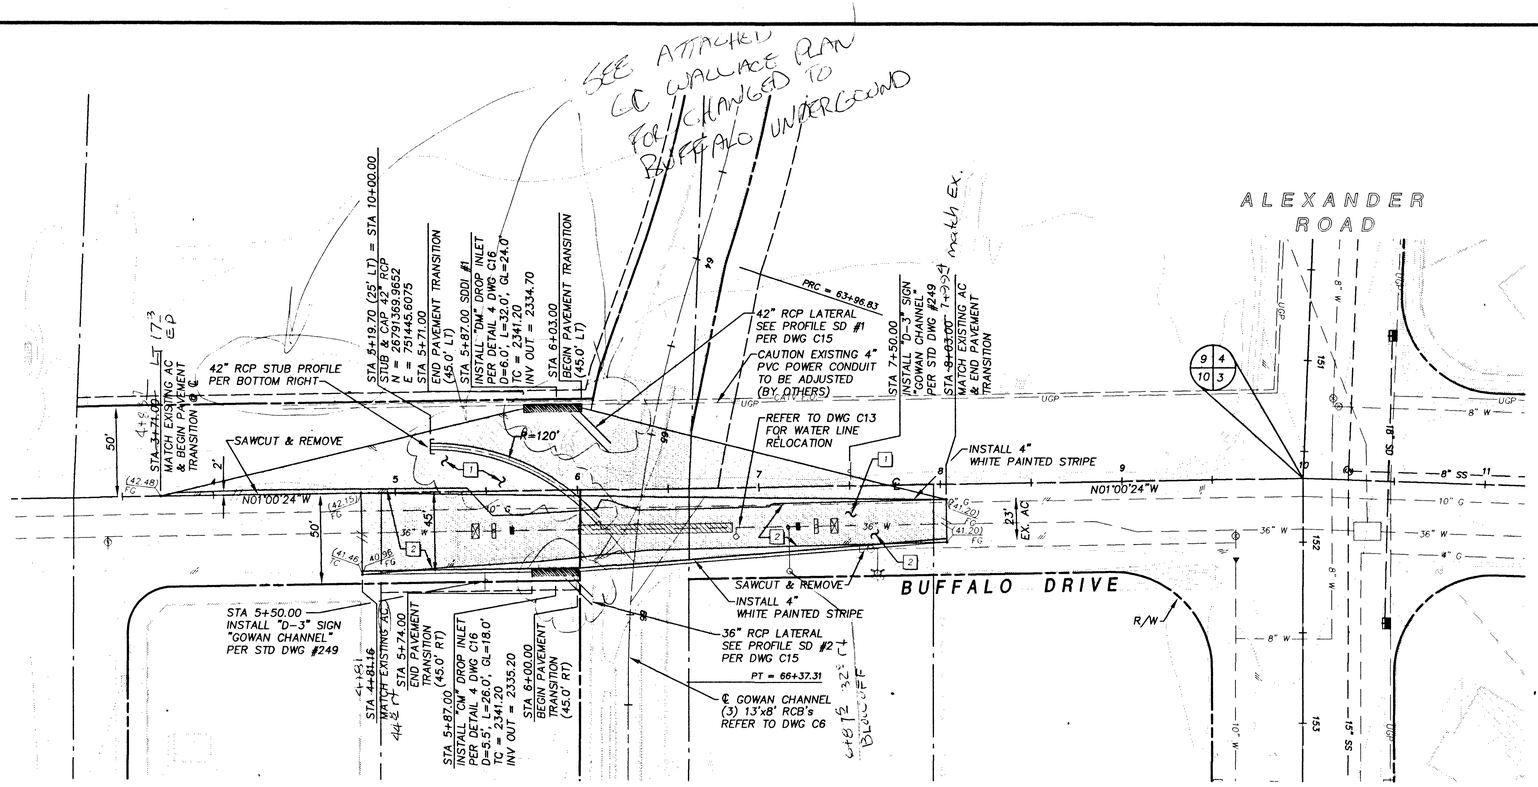


Avoid cutting underground utility lines in a mess

**Call before you Dig**

1-800-227-2600

GRAPHIC SCALE

(IN FEET)

HORIZ = 1 inch = 40 ft.
VERT = 1 inch = 4 ft.

KEY NOTES (THIS SHEET ONLY)

1. INSTALL 2" AC PAVEMENT ON 4" OF TYPE II AGGREGATE BASE
2. REMOVE EXISTING AC PAVEMENT

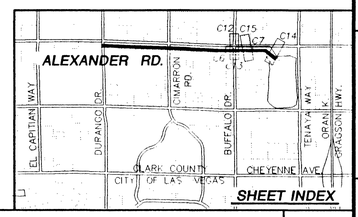


SHEET INDEX

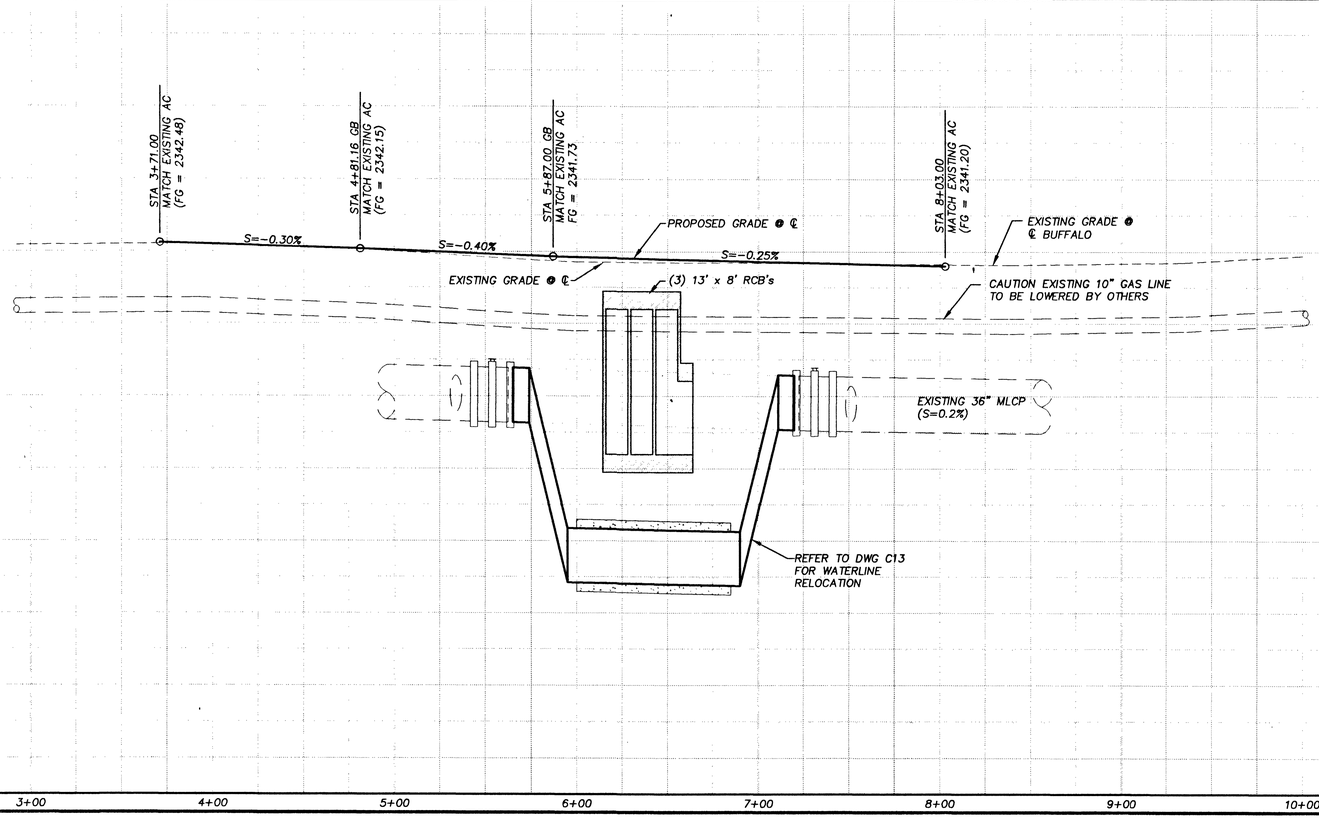


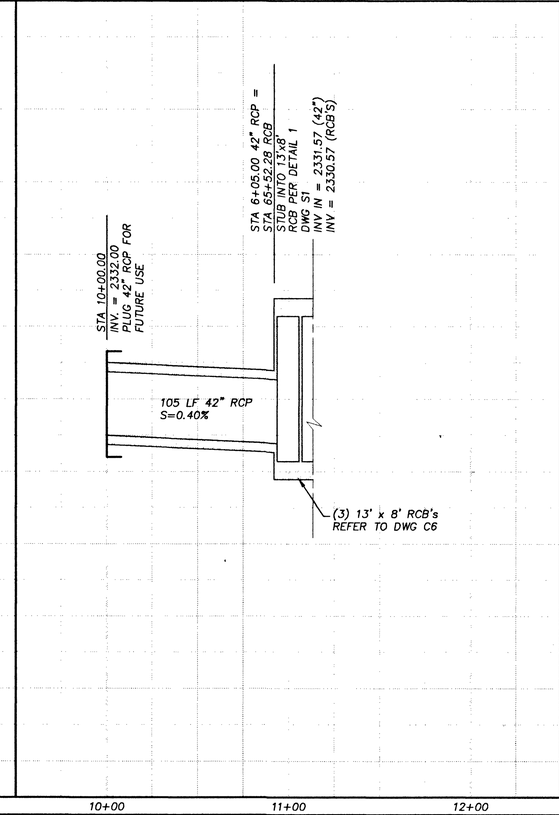


REVISIONS

| NO. | DATE | DESCRIPTION | APPROVED |
|---|---|---|---|
| | | | |

GOWAN NORTH CHANNEL

DRAWN BY: LSB | DESIGNED BY: AAS | CHECKED BY: W.HORLACHER

JOB NO.: 51979 | DATE: JANUARY 17, 1998

POST, BUCKLEY, SCHUH & JERNIGAN
901 North Green Valley Pkwy.
Suite 160
Henderson, Nevada 89014
Phone: 702/263-1100
Fax: 702/263-7200
ENGINEERING · PLANNING · SURVEYING · CONSTRUCTION SERVICES

PROFESSIONAL ENGINEER - STATE OF NEVADA
WAYNE HORLACHER
CIVIL
No. 10,739
1/17/98

Department of Public Works

# GOWAN NORTH CHANNEL – PHASE 1
# BUFFALO DRIVE PLAN AND PROFILE

CITY OF LAS VEGAS NEVADA

DRAWING No. C12 | 12 / 29

PLAN # 731-65

44329

AS-BUILT