

IMPROVEMENT PLANS FOR GILMORE CHANNEL FLOOD CONTROL IMPROVEMENTS

CITY OF LAS VEGAS
STATE OF NEVADA

PERMA-BILT HOMES

7150 POLLOCK DRIVE , SUITE 104
Las Vegas, Nevada 89119
(702) 896-9100

FUNDED BY:

CLARK COUNTY REGIONAL FLOOD CONTROL DISTRICT
AND
CLARK COUNTY REGIONAL TRANSPORTATION COMMISSION

APPROVALS

CHARLES KAJKOWSKI, JR. PE#4784 DATE _____
CITY ENGINEER

APPROVAL OF THESE PLANS IS LIMITED TO THOSE IMPROVEMENTS
CONSTRUCTED IN THE DEDICATED RIGHT-OF-WAY AND/OR DEDICATED
EASEMENTS. THIS APPROVAL DOES NOT AUTHORIZE THE CONSTRUCTION ON
ANY IMPROVEMENTS THAT DEVIATE FROM ADOPTED STANDARDS AND/OR
SPECIFICATIONS EXCEPT THOSE SPECIFICALLY LISTED UNDER DEVIATIONS
FROM STANDARD. THE ENGINEER SHALL RESOLVE ANY DEVIATION OTHER
THAN THOSE LISTED IN DEVIATIONS FROM STANDARDS IN FAVOR OF THE
UNIFORM STANDARD DRAWINGS AND SPECIFICATIONS CLARK COUNTY AREA
NEVADA.

C.C.R.F.C.D. DATE

C.C.R.T.C. DATE

KERN RIVER GAS CO. (WILLIAMS) DATE

CITY FIRE MARSHALL DATE

LAS VEGAS VALLEY WATER DISTRICT DATE

NEVADA POWER COMPANY DATE

SOUTHWEST GAS COMPANY DATE

KERN RIVER GAS CO. DATE

REV	DATE	BY


PERMA-BILT HOMES
7150 POLLOCK DRIVE , SUITE 104
LAS VEGAS, NEVADA 89119
(702) 896-9100

2727 SOUTH RAINBOW BOULEVARD LAS VEGAS, NEVADA 89102-5148
PH. (702) 873-7550 FAX (702) 882-2597
VTM nevada CONSULTING ENGINEERS • PLANNERS • LAND SURVEYORS

COVER SHEET

**GILMORE CHANNEL
FLOOD CONTROL IMPROVEMENTS**

SHEET 7/31/00
DRAWN BY: BKP
DESIGNED BY: DMB
CHECKED BY:
PROJECT NO: 5883

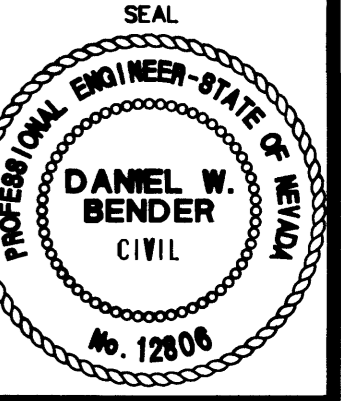

SHEET
G1 Z3
1 OF 22 SHEETS
DRAWING NO.
731-74

RECORD DRAWINGS INFORMATION SUPPLIED BY CONTRACTOR - MAY 2002