


NOTES:  
 1. REFER TO SHEET D1 FOR CHANNEL ACCESS LADDER LOCATIONS.  
 2. REFER TO SHEETS S1 THROUGH S9 FOR STRUCTURAL DETAILS.

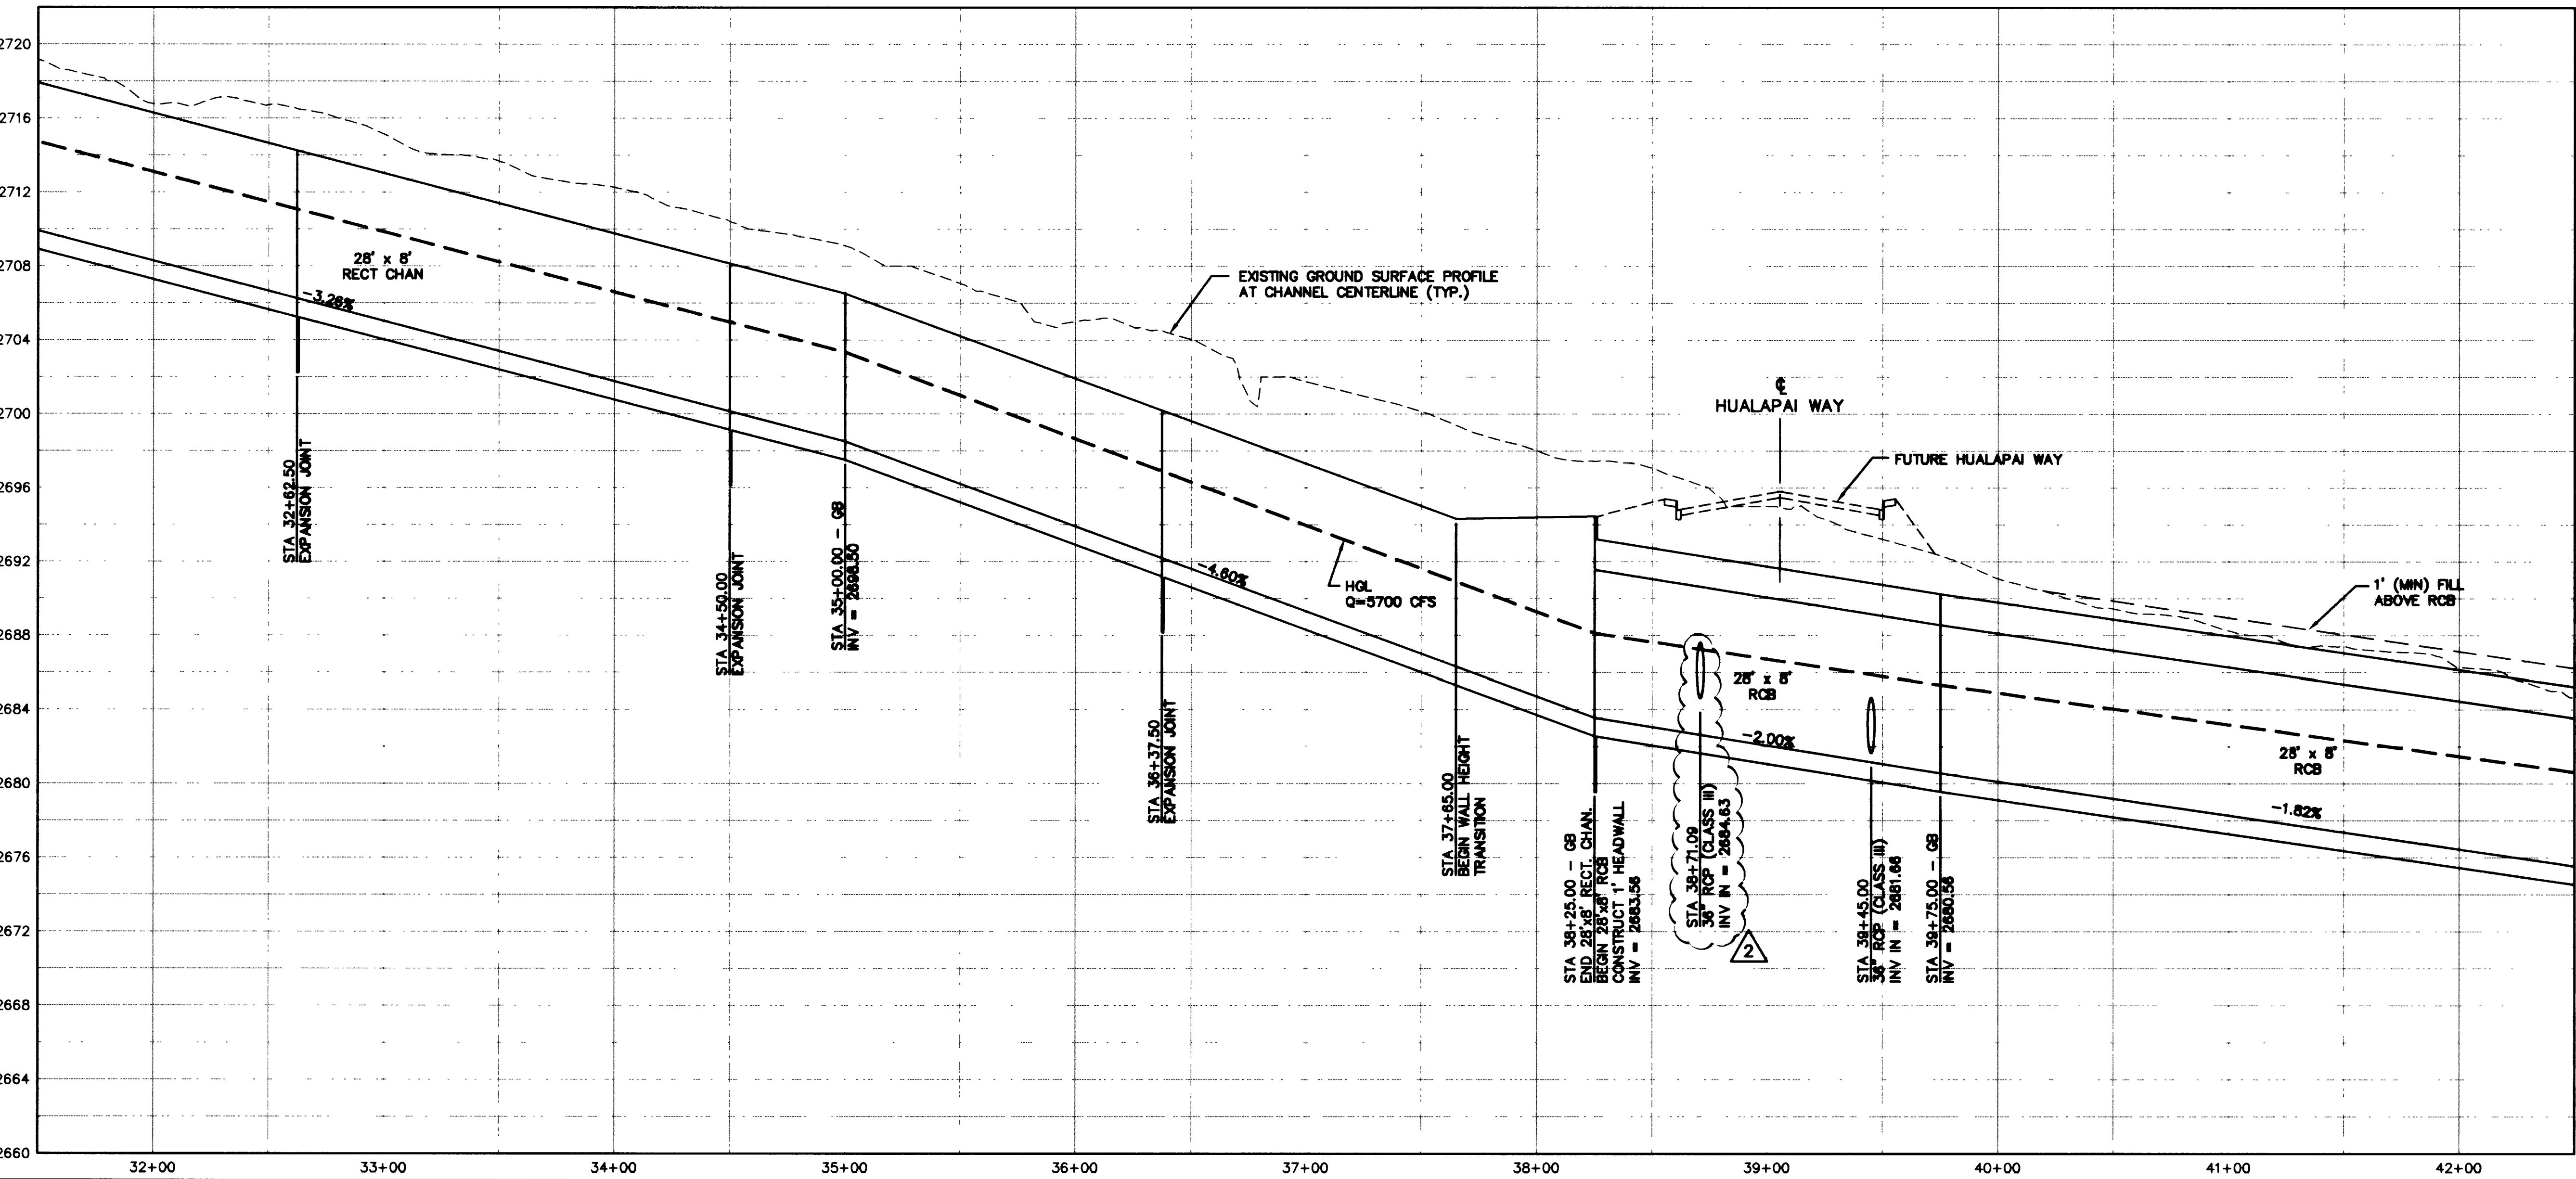

Avoid cutting underground utility lines. It's costly.  
 2 working days  
**Call before you Dig**  
 1-800-227-2600  
 Underground Service Alert (U.S.A.)  
 3-2-44e

<b>PERMA-BILT HOMES</b> 7150 POLLOCK DRIVE, SUITE 104 LAS VEGAS, NEVADA 89119 (702) 886-9100		2727 SOUTH RAINBOW BOULEVARD LAS VEGAS, NEVADA 89102-5148 PH. (702) 873-7550 FAX (702) 882-2597 <b>nevada</b> CONSULTING ENGINEERS • PLANNERS • LAND SURVEYORS (702) 886-9100	
<b>FLOOD CONTROL CHANNEL PLAN AND PROFILE</b> STA. 31+50 TO STA. 42+50		<b>GILMORE CHANNEL FLOOD CONTROL IMPROVEMENTS</b>	
DRAWN BY: DAB/BKP	DESIGNED BY: 12/10/99	CHECKED BY: 5/30/01	PROJECT NO: 5693
SCALE: 1"=40' HORIZ. 1"=5' VERT.		SHEET <b>C4</b> OF 22 SHEETS DRAWING NO. <b>131-74</b>	