



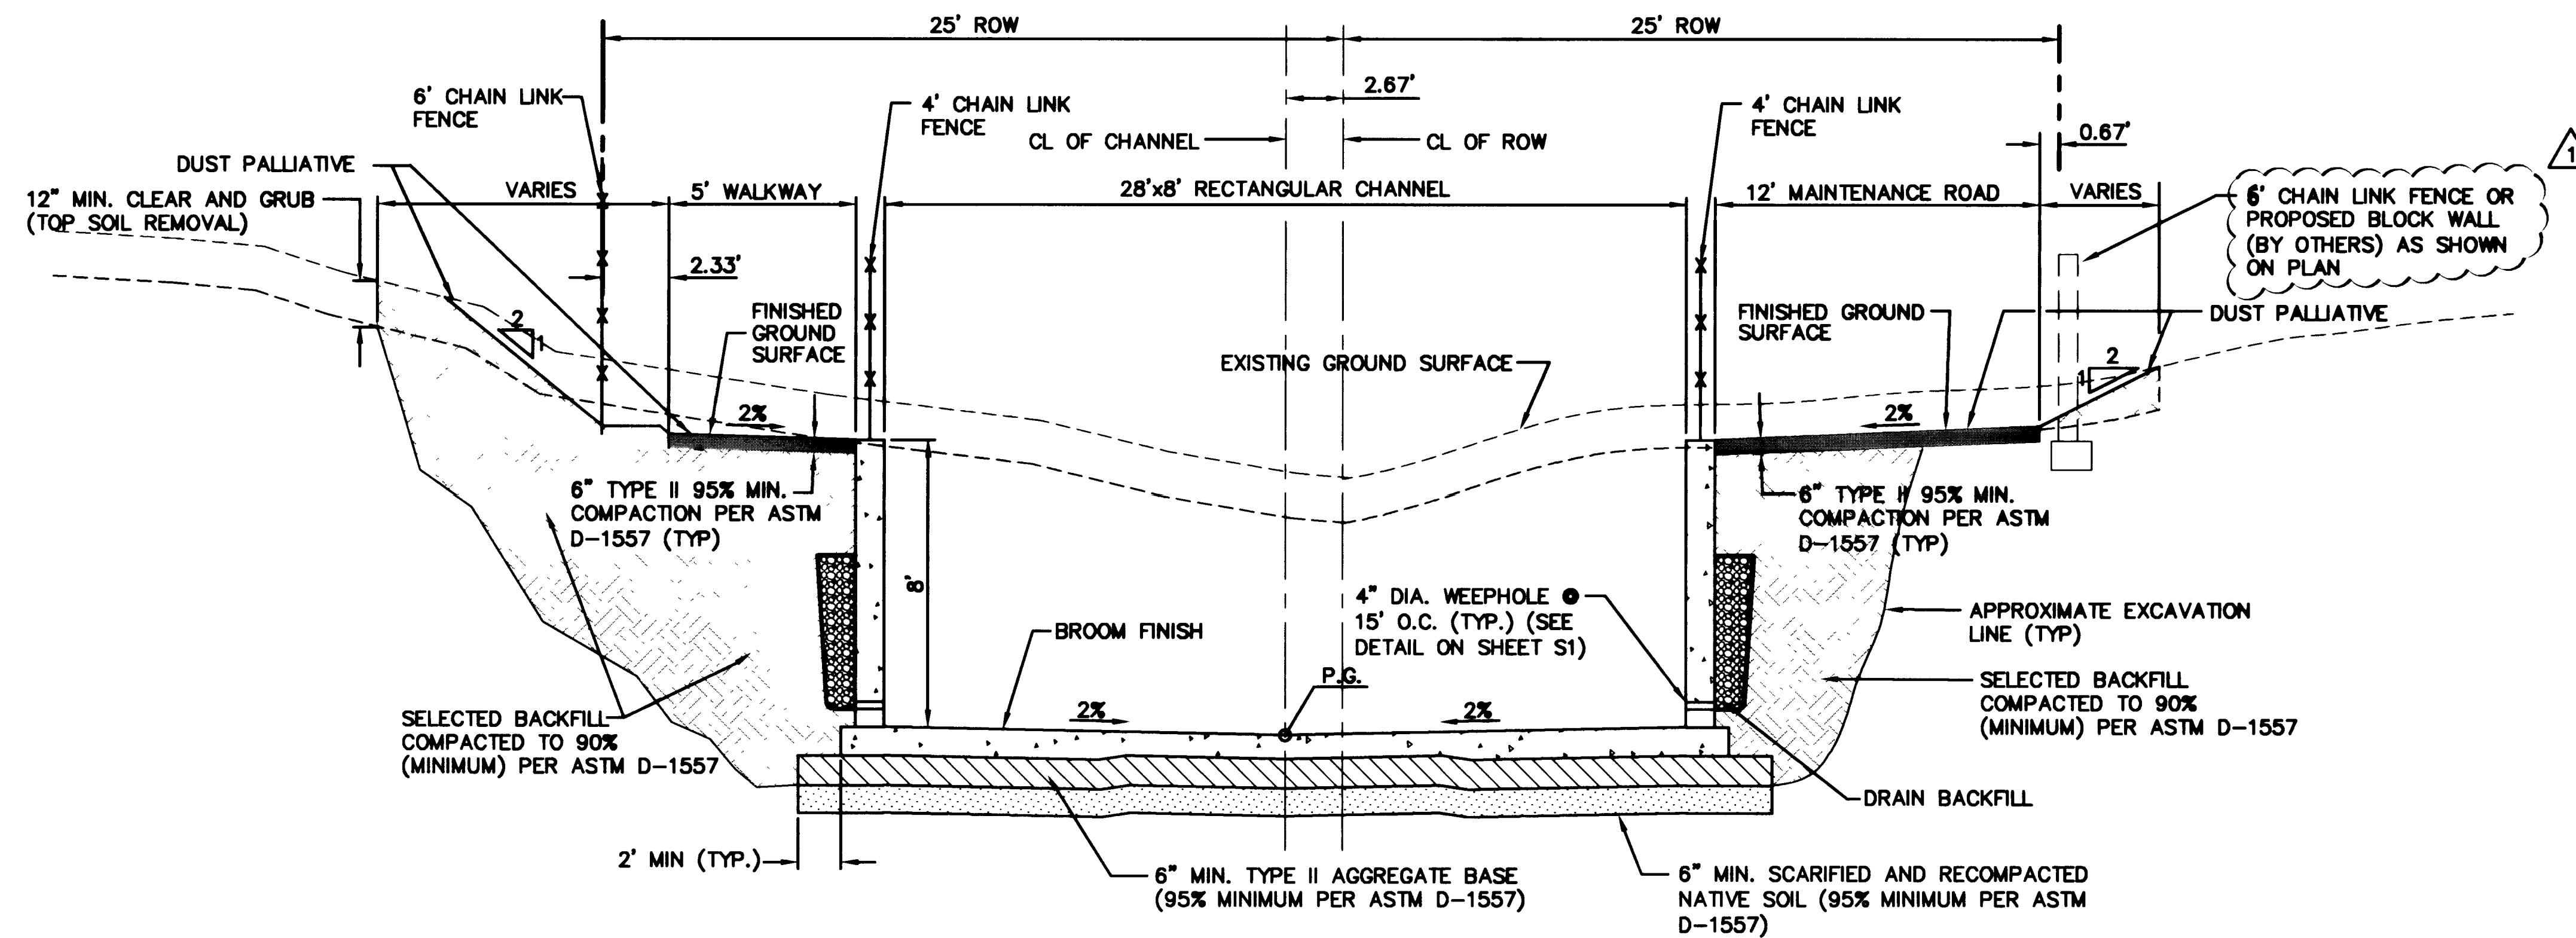

A RECTANGULAR CHANNEL EXCAVATION
N.T.S.

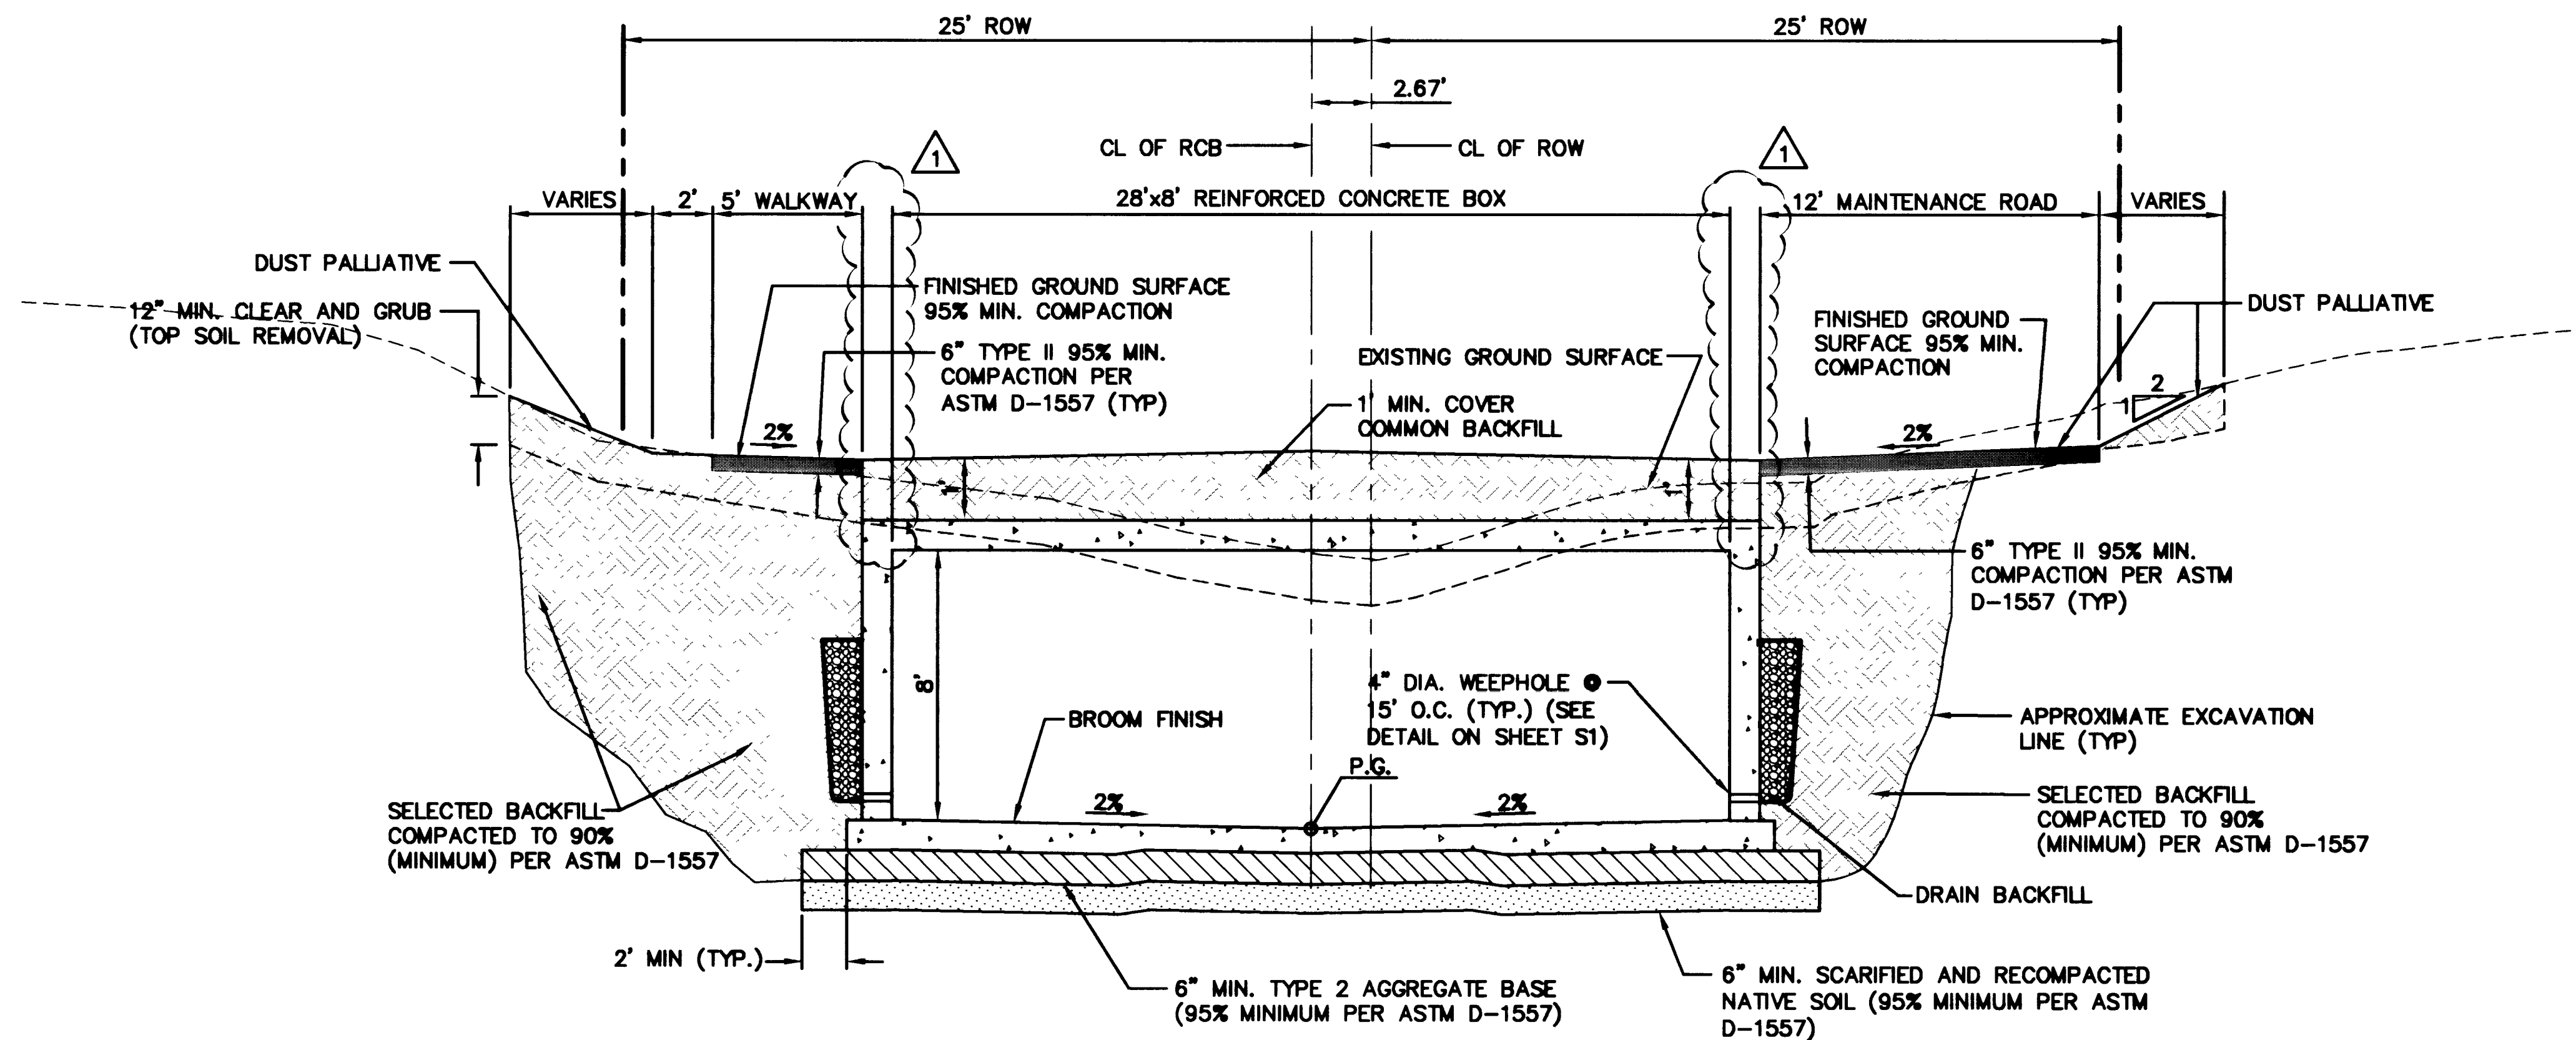

B CONCRETE BOX EXCAVATION
N.T.S.

FOR STRUCTURAL DETAILS, REFER TO SHEETS
S1 THROUGH S9

PERMA BILT HOMES 7150 POLLOCK DRIVE, SUITE 104 LAS VEGAS, NEVADA 89119 (702) 896-9100		2727 SOUTH RAINBOW BOULEVARD, LAS VEGAS, NEVADA 89102-5148 PH. (702) 873-7550 FAX (702) 362-2597 CONSULTING ENGINEERS • PLANNERS • LAND SURVEYORS vtm nevada	
SHEET D2 OF 22 SHEETS		TITLE GILMORE CHANNEL FLOOD CONTROL IMPROVEMENTS	
DRAWN BY: BKP	DESIGNED BY: BKP	CHECKED BY: BKP	PROJECT NO: 5693
DATE 4/20/01		SCALE: NONE HORIZ. NONE VERT.	
SEAL PROFESSIONAL ENGINEER-STATE OF NEVADA DANIEL W. BENDER CIVIL No. 12806 5/9/01		PER ADDENDUM NUMBER 2 REV 1 DATE 5/9/01 BY BKP	