


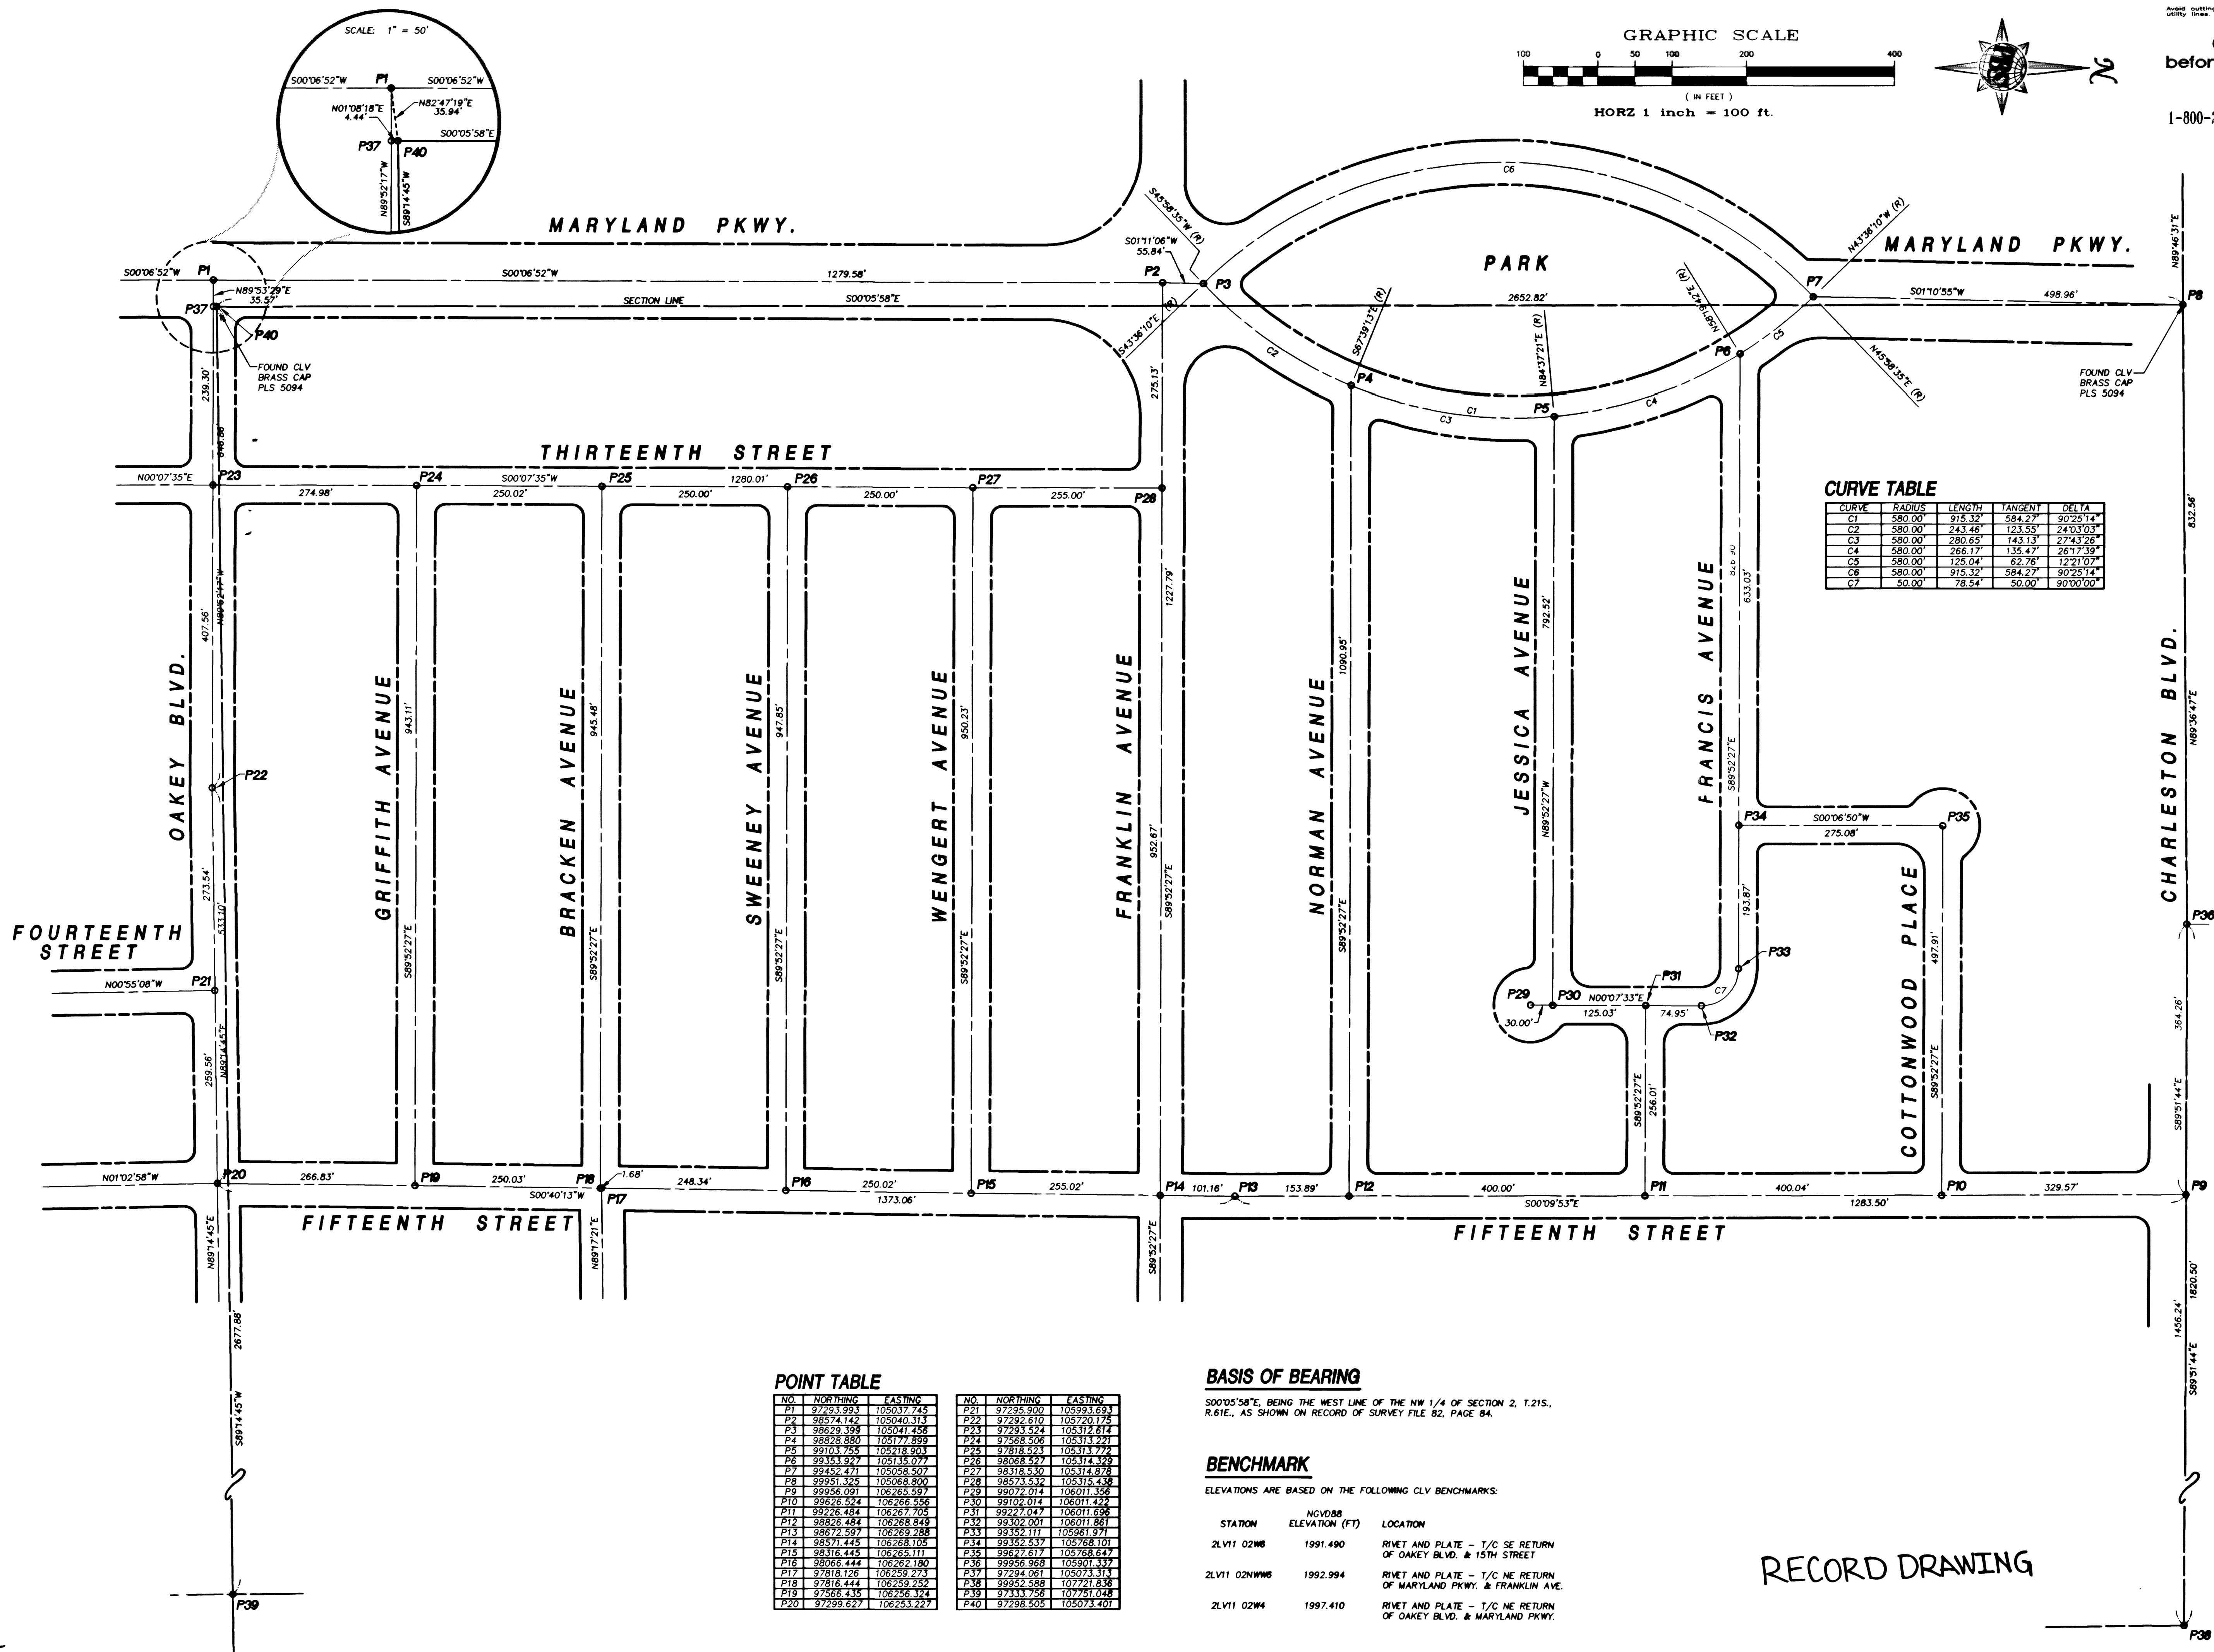

REVISIONS

NO.	DATE	DESCRIPTION

STREET REHABILITATION DESIGN

DESIGNED BY	WHORLACHER
CHECKED BY	
DATE	AUG 28, 1998
PROJECT NO.	51451

POST BLACKLEY, SCHULTZ & JENCKEN

INCORPORATING PLANNING, SURVEYING, CONSTRUCTION SERVICES

PROFESSIONAL ENGINEER - STATE OF NEVADA

10,739

Department of Public Works

HUNTRIDGE NEIGHBORHOOD - PHASE 3

SURVEY CONTROL PLAN

CITY OF LAS VEGAS

NEVADA

DRAWING No.

C4

PLAN# 107-V2813

4

27