

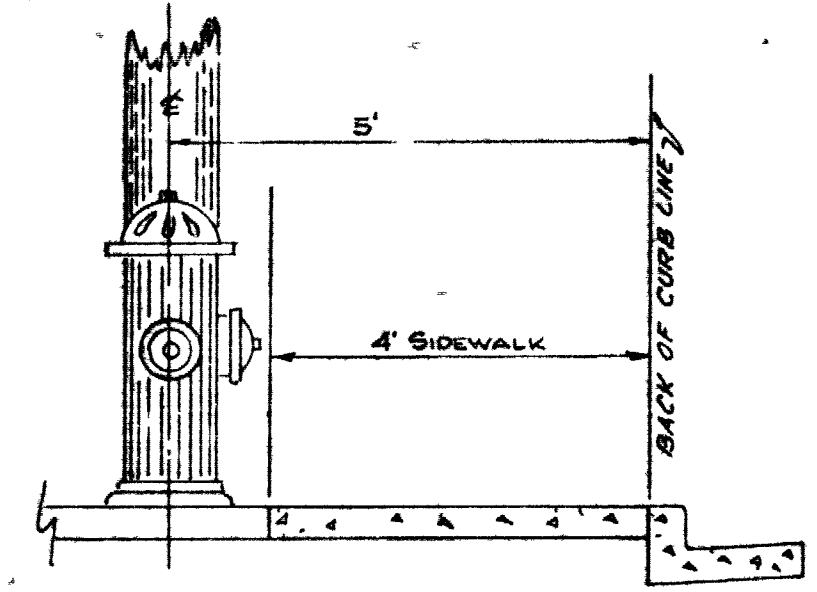
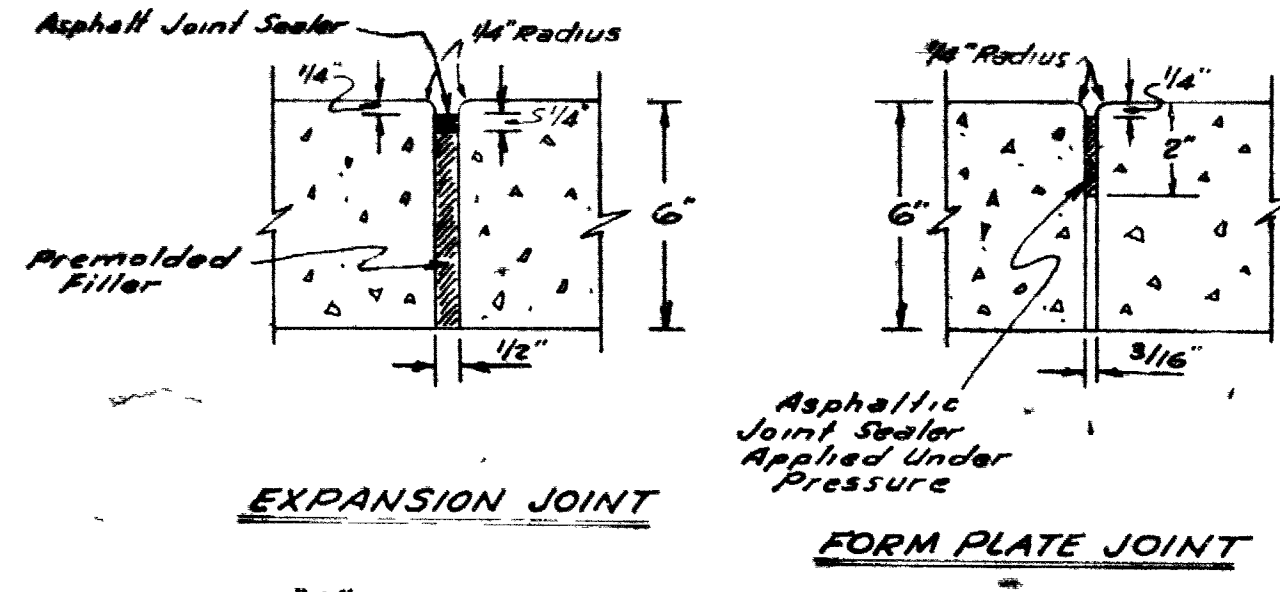
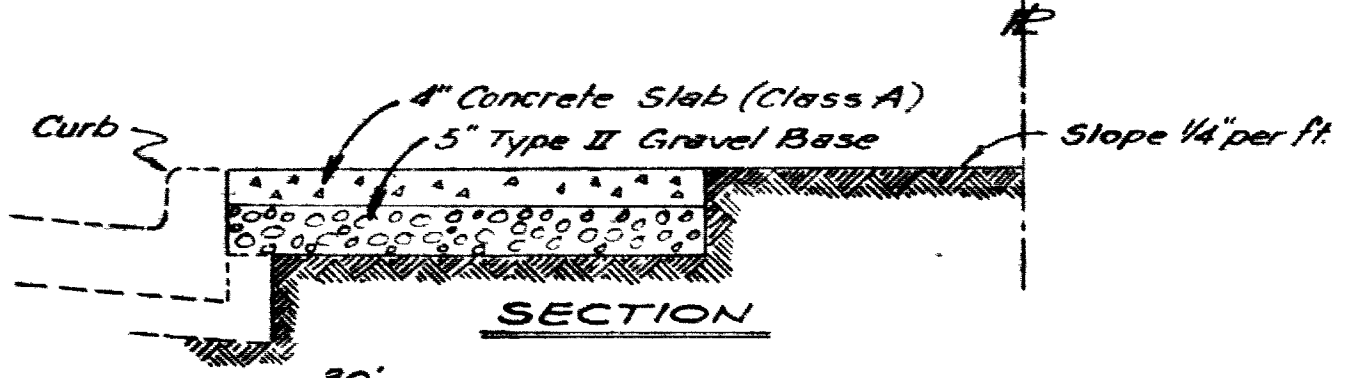
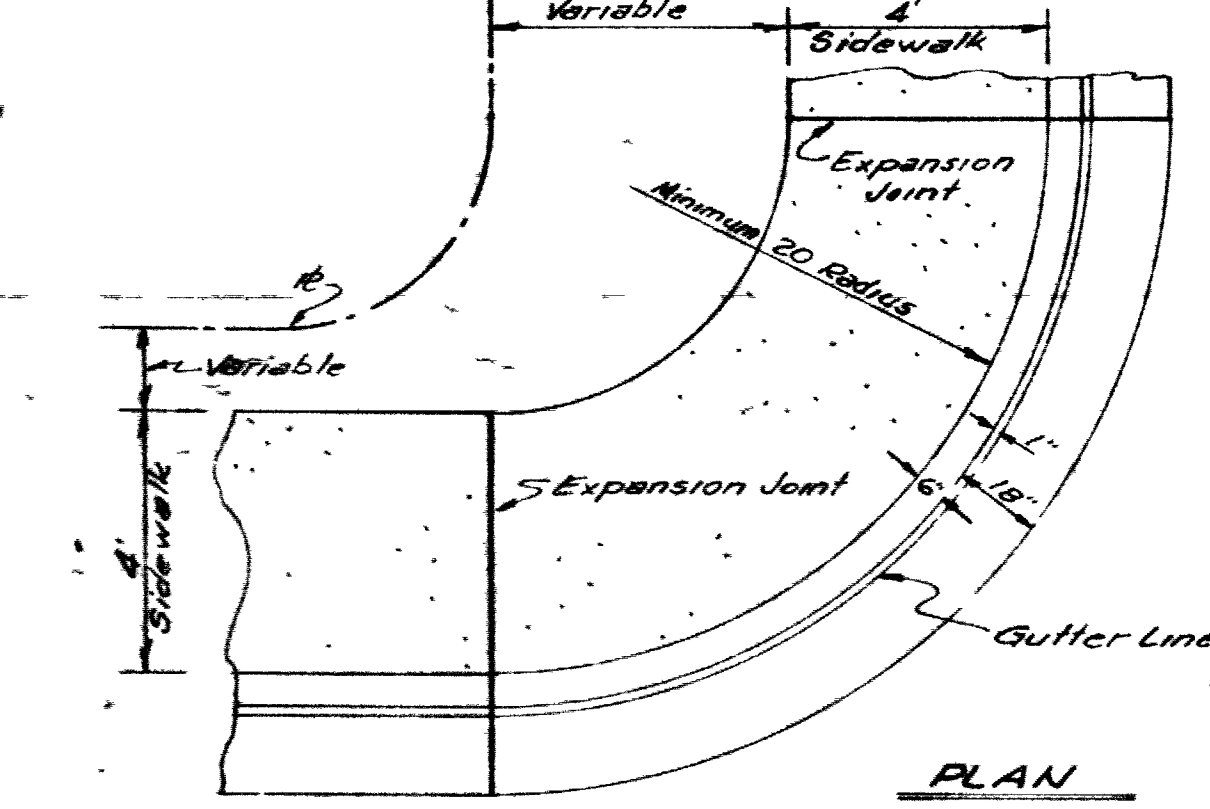
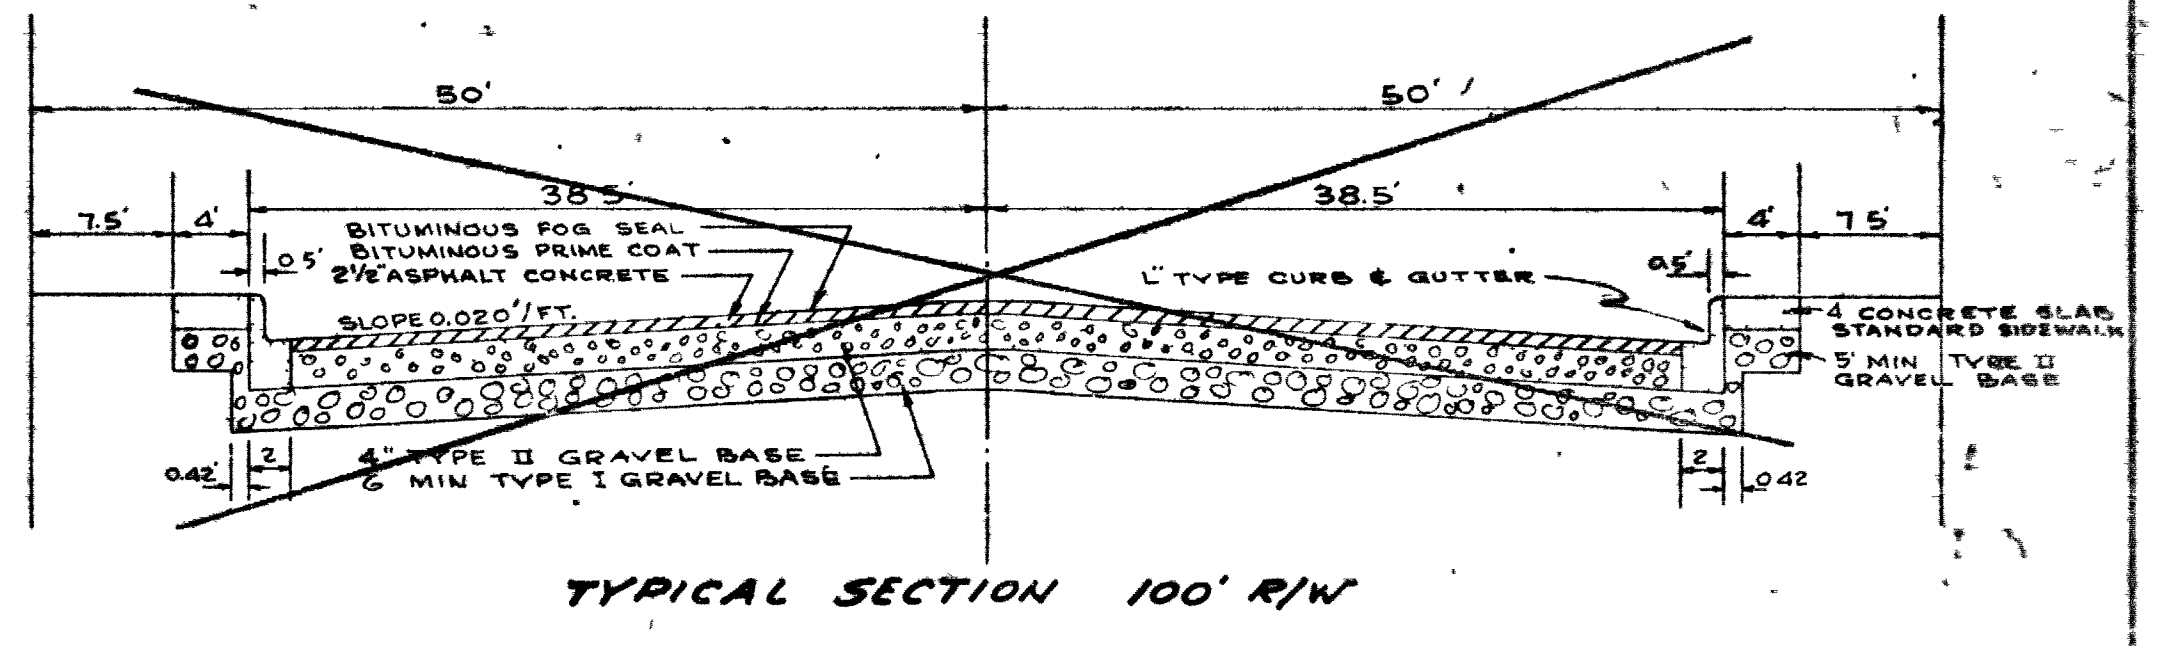
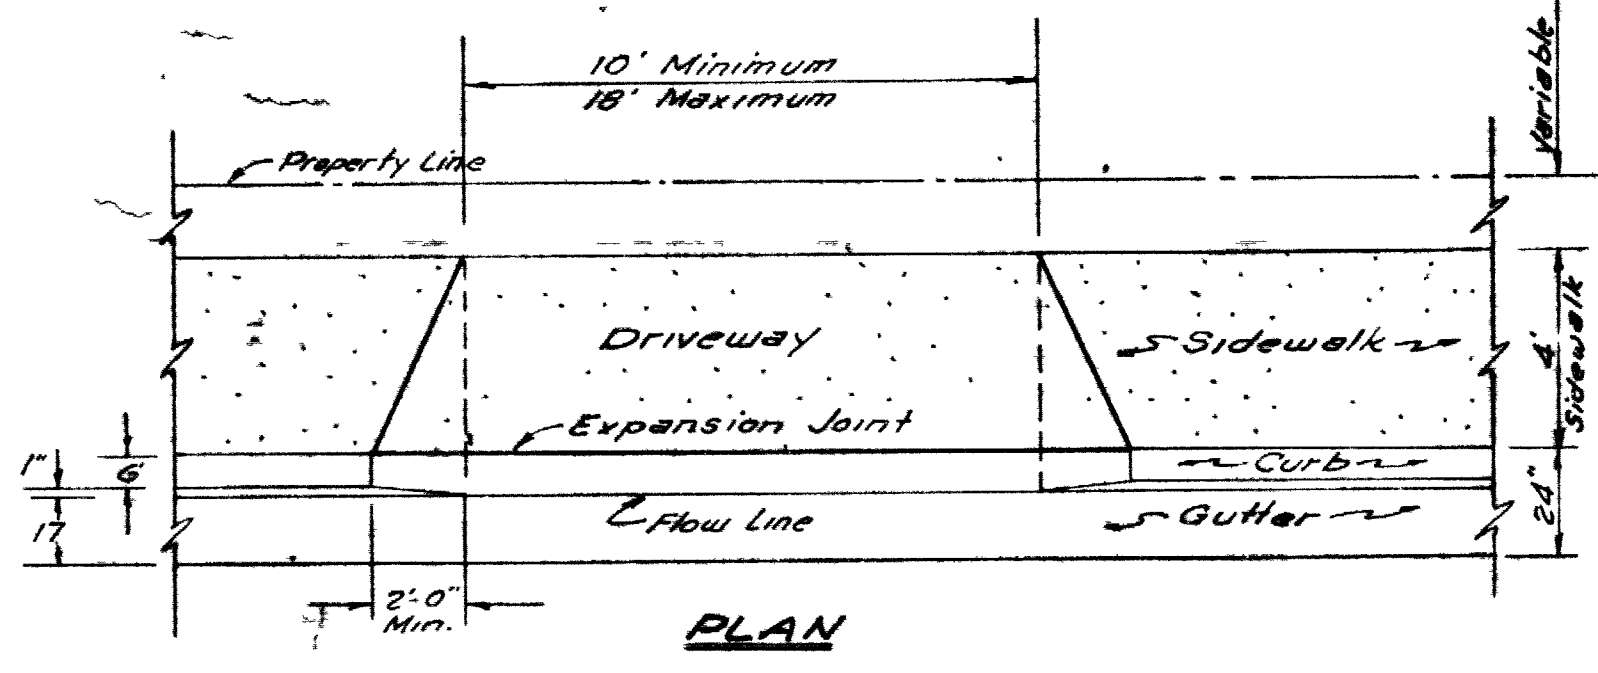
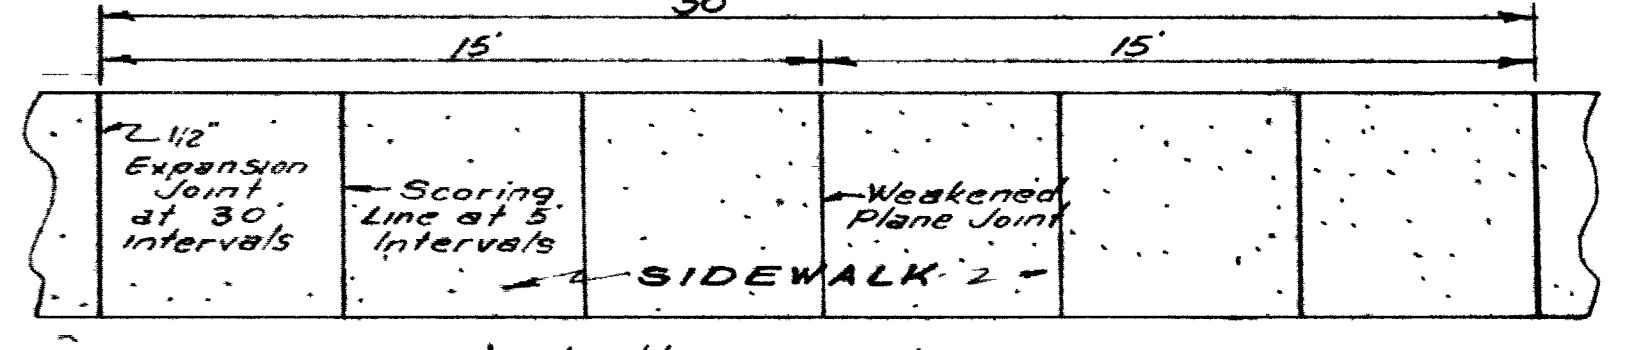




VALLEY GUTTER AND CURB RETURN

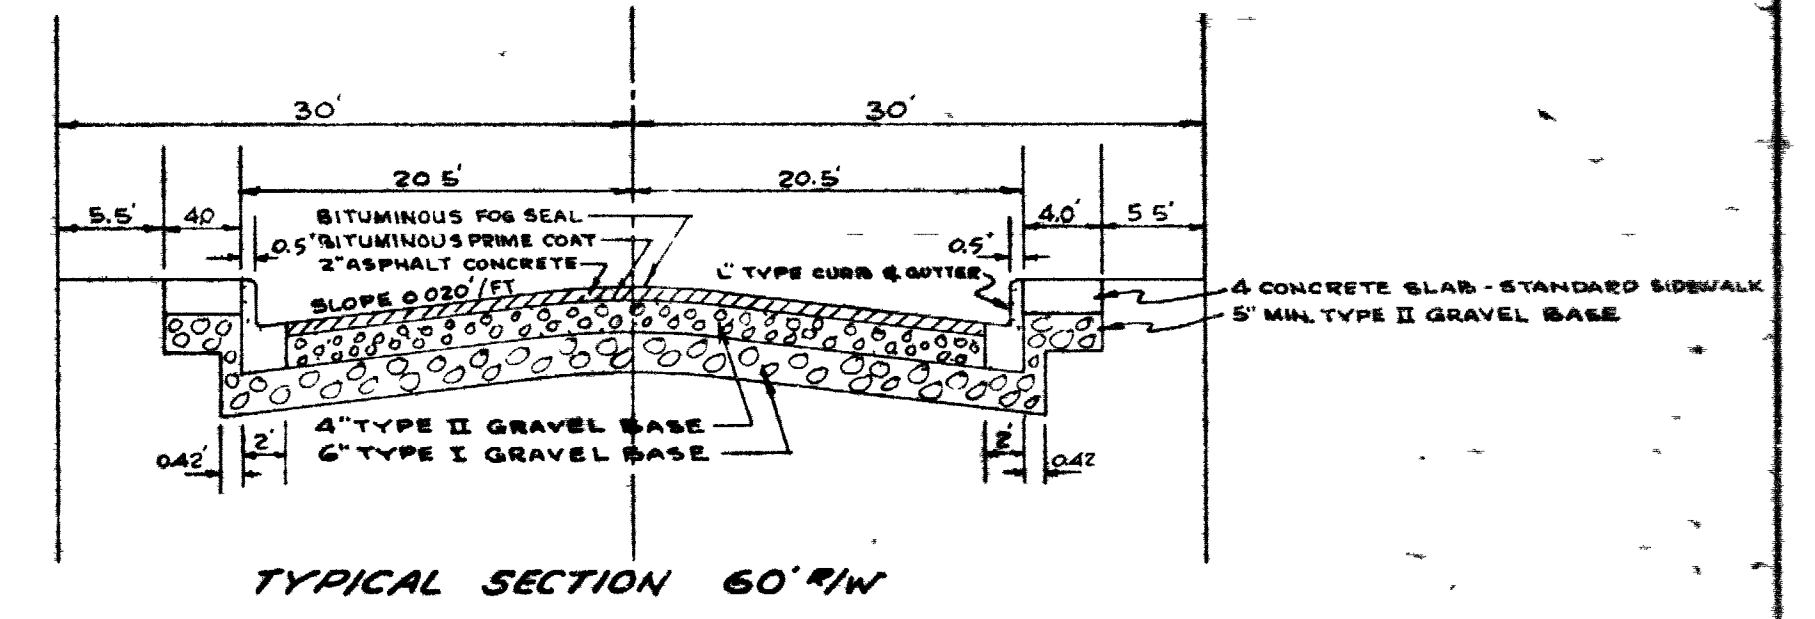

L TYPE CURB AND GUTTER

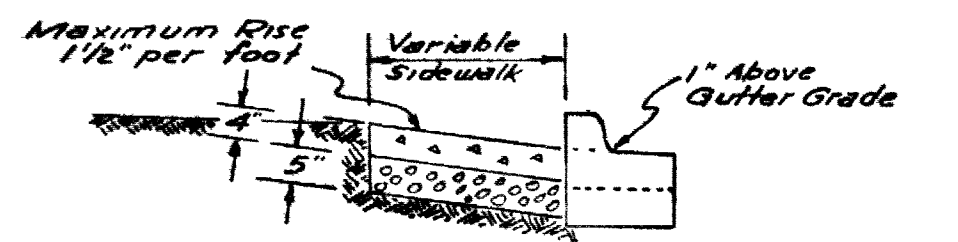

ELEVATION RESIDENTIAL DRIVEWAY

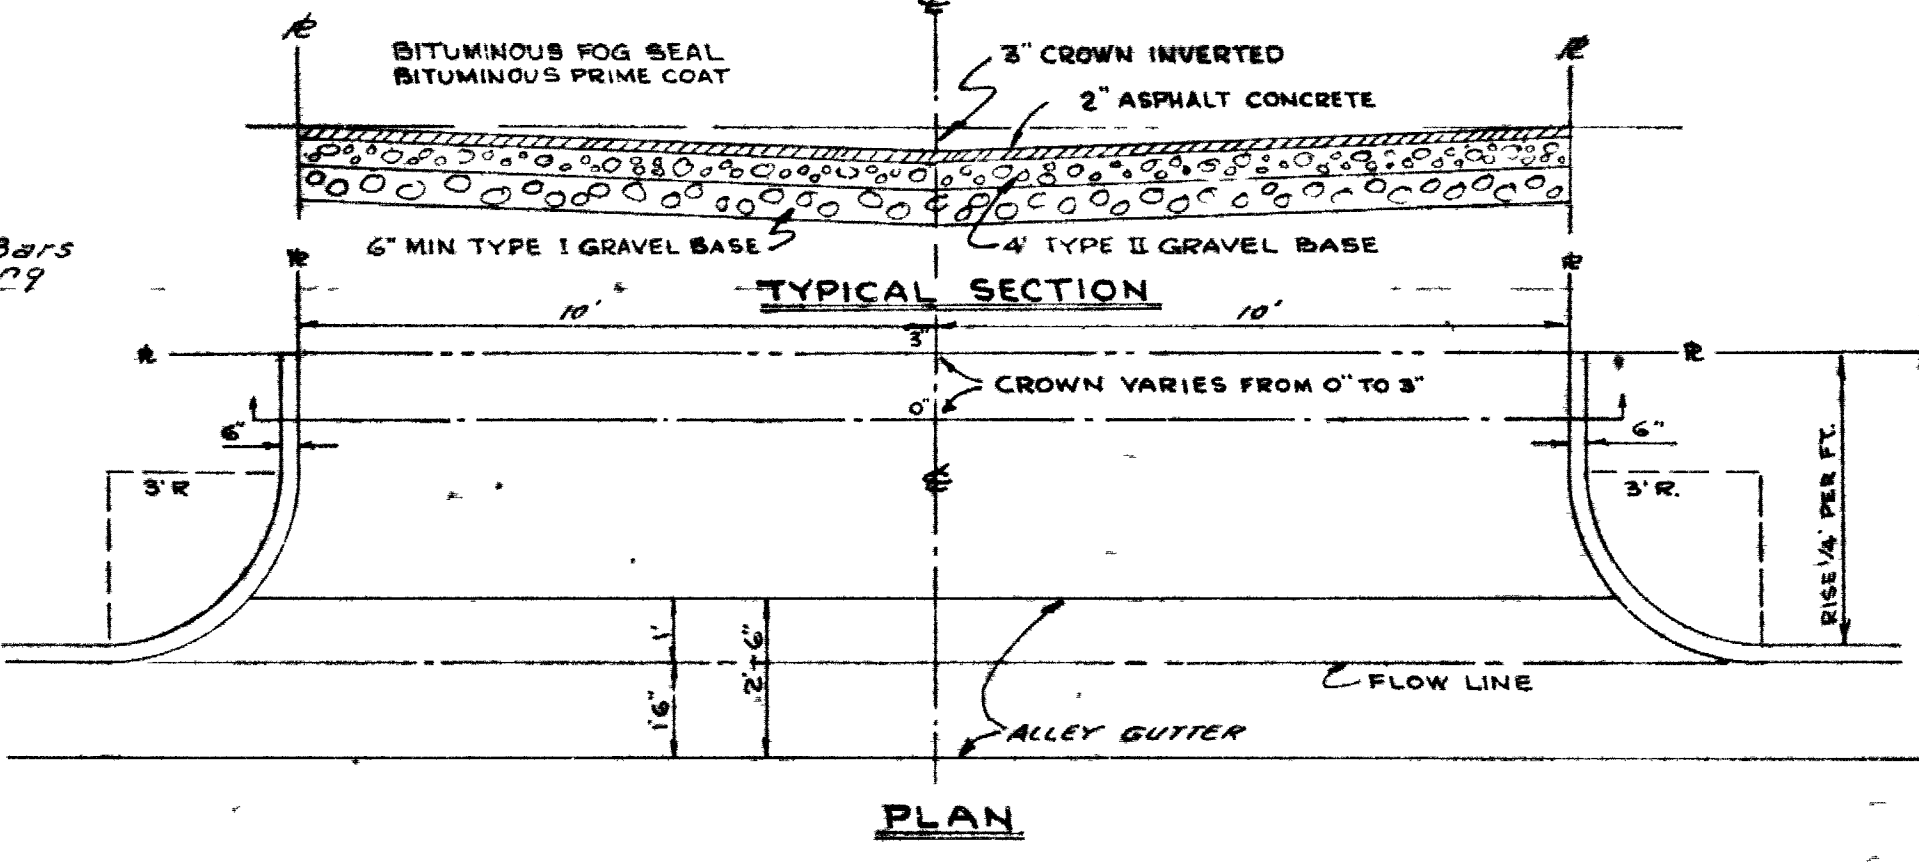
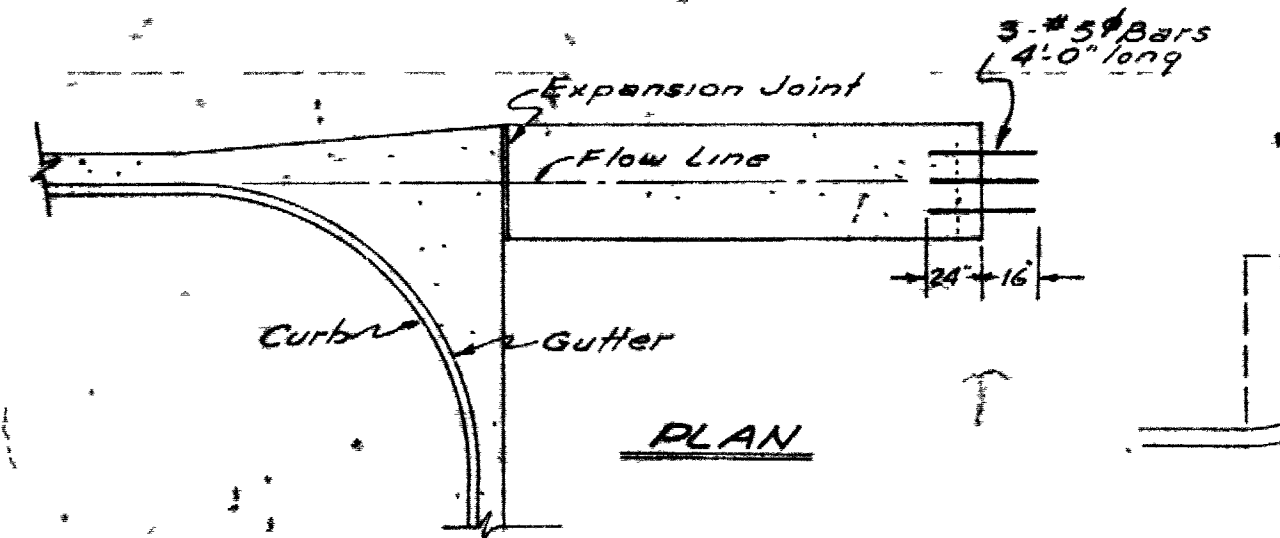


NOTES
Slope on crown may be reduced to 0.015/ft when required for drainage purposes.
All construction shall comply with Clark County specifications.

Approved: Truman B. McJury 9/63

FABULOUS FORTY

CHECKED	APPROVED	DESIGNED
DATE 10-1-62	<i>R. Johnson</i>	DESIGNED R.L.K.
TYPICAL STANDARDS		
No Scale		
Kraemer Engineer - Co.		SHEET OF
Las Vegas, Nevada		

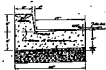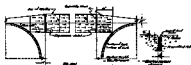









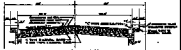




























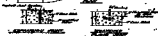














