

PLAN

DATE: _____ BY: _____

DESIGNED BY: _____

CHECKED BY: _____

NO. _____





PROFILE

DATE: _____ BY: _____

DESIGNED BY: _____

CHECKED BY: _____

NO. _____

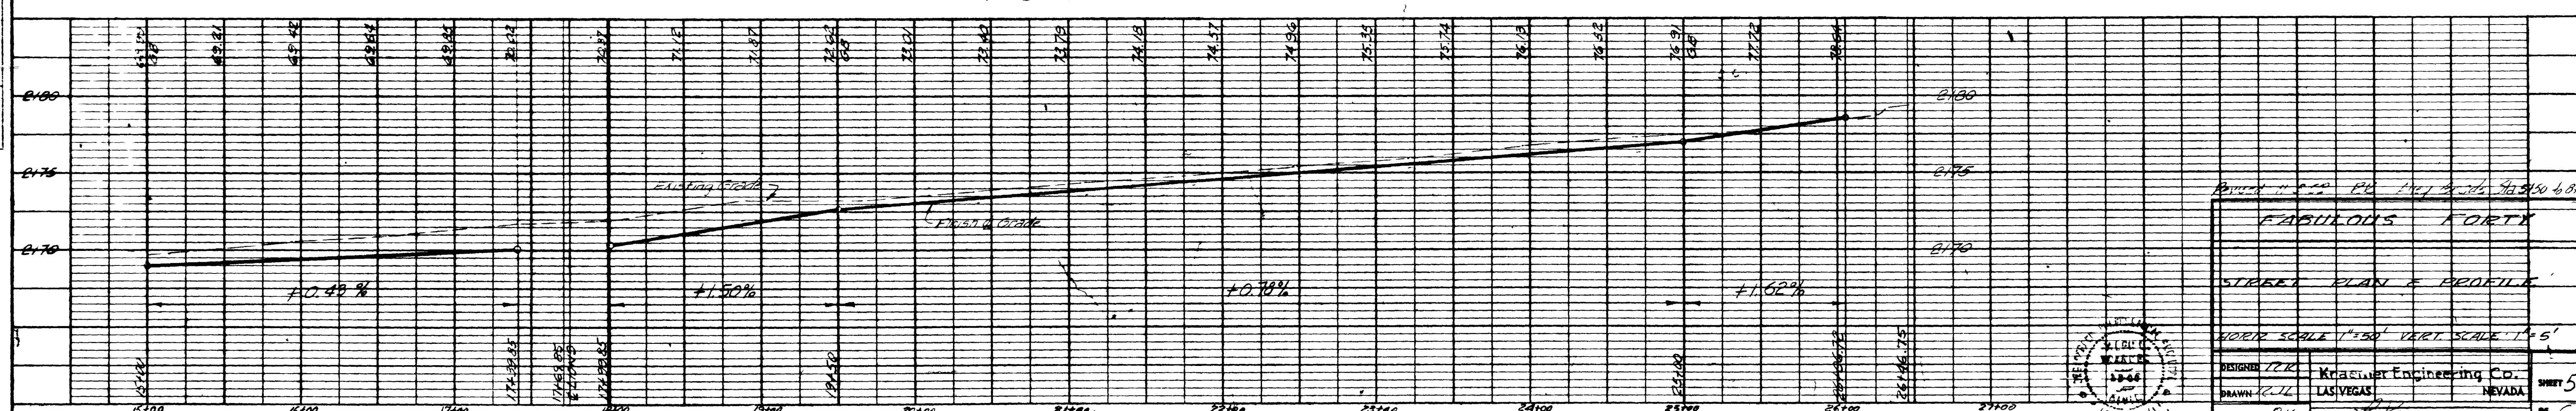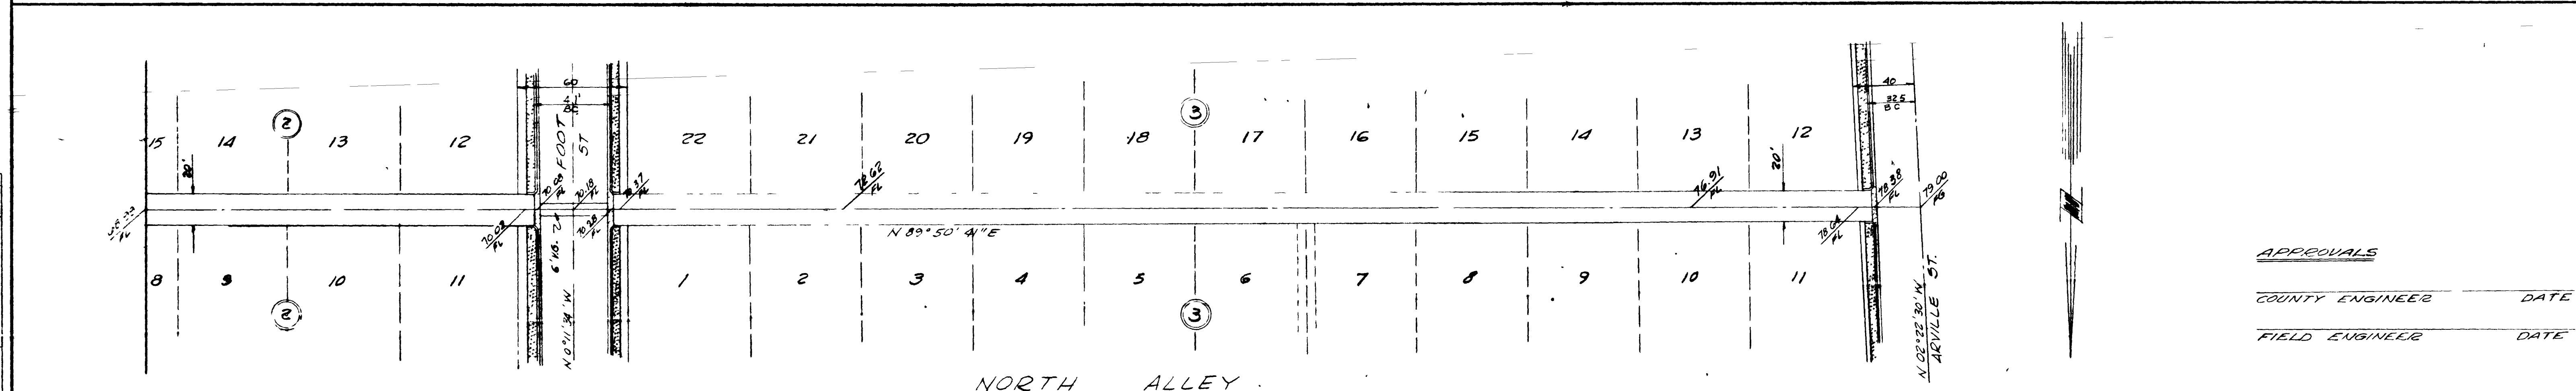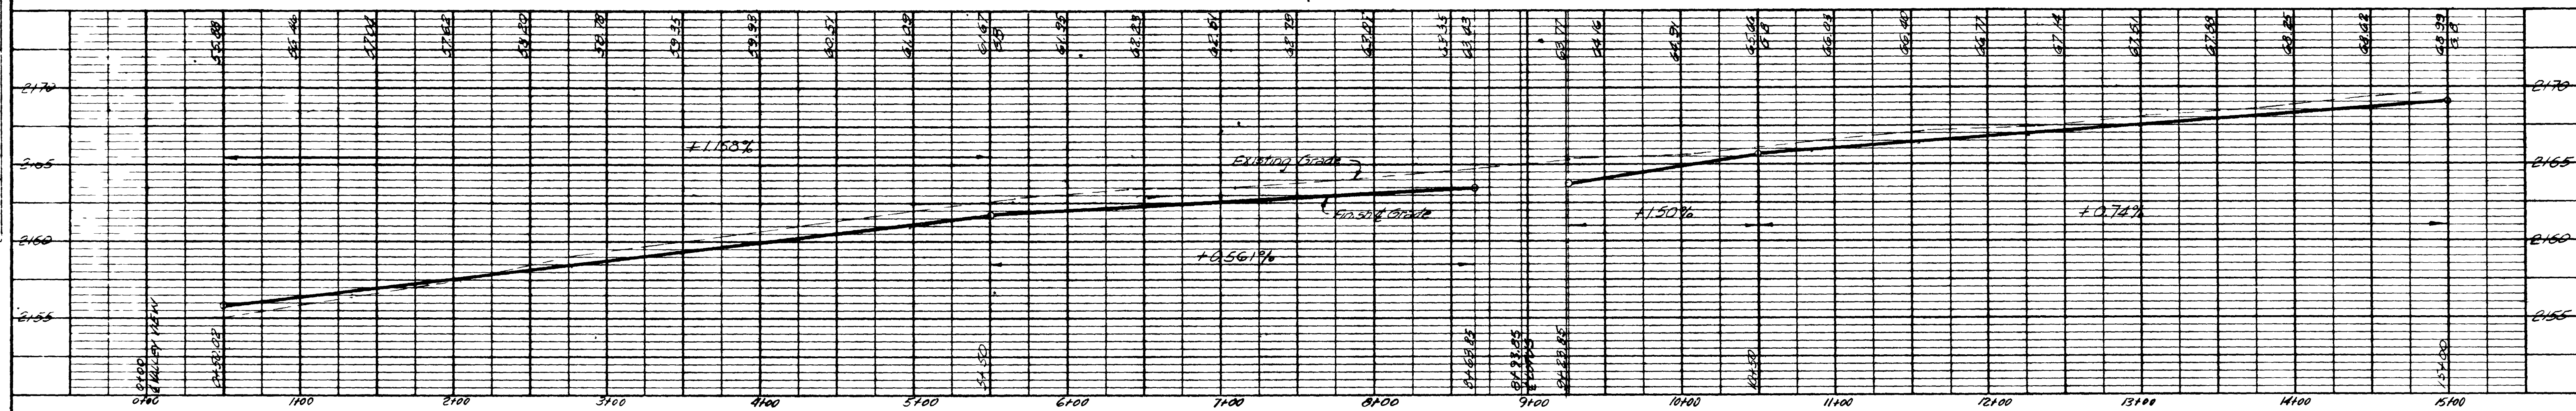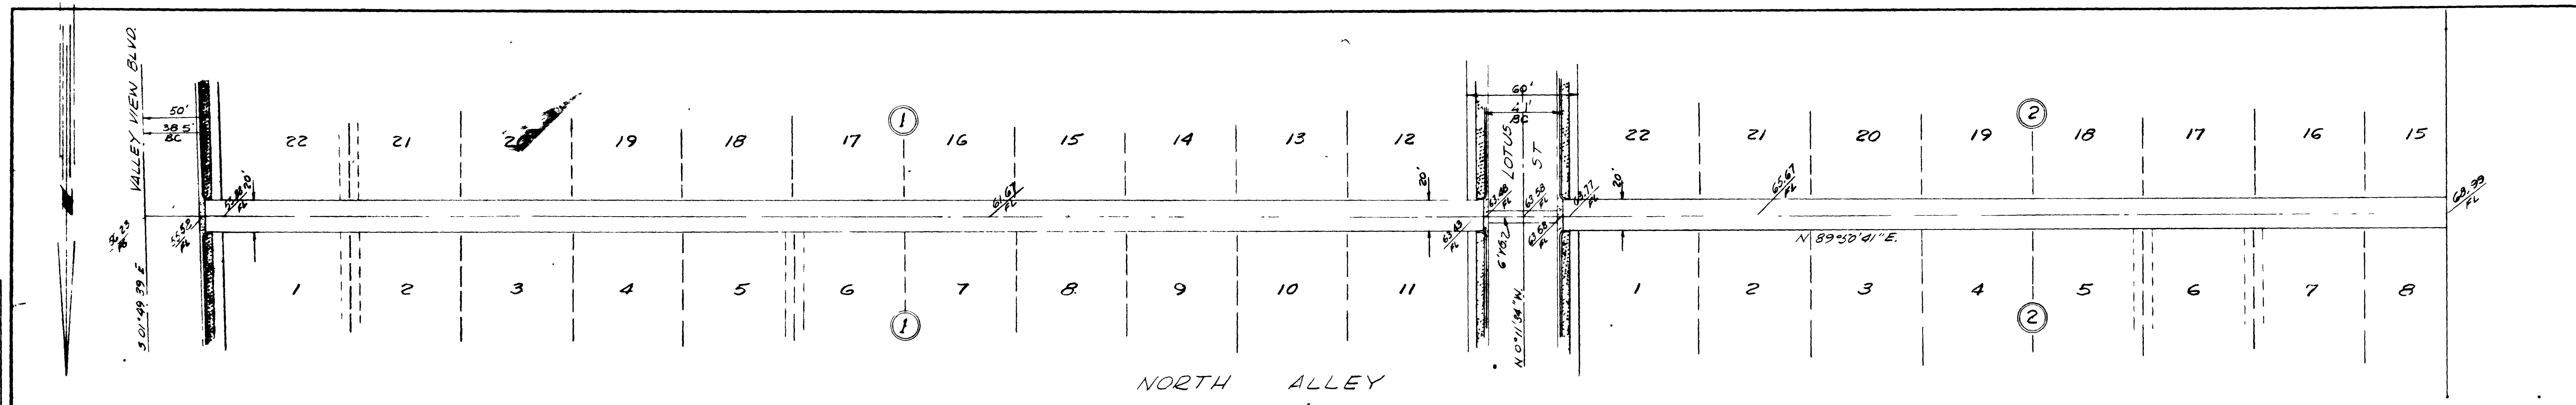

APPROVALS

COUNTY ENGINEER _____ DATE _____

FIELD ENGINEER _____ DATE _____

4060

FABULOUS FORTY





STREET PLAN & PROFILE

HORIZ. SCALE 1"=50' VERT. SCALE 1"=5'

DESIGNED: T.K. Krasner Engineering Co. SHEET 5

DRAWN: C.H. LAS VEGAS, NEVADA


 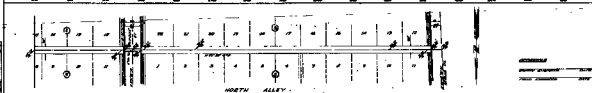 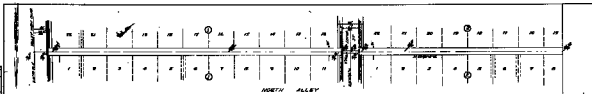

DESIGNED BY
 DRAWN BY