



PLAN
 SURVEYED BY _____ DATE _____
 PLOTTED BY _____
 CHECKED BY _____
 NOTE BOOK NO. _____
 FIELD BOOK NO. _____

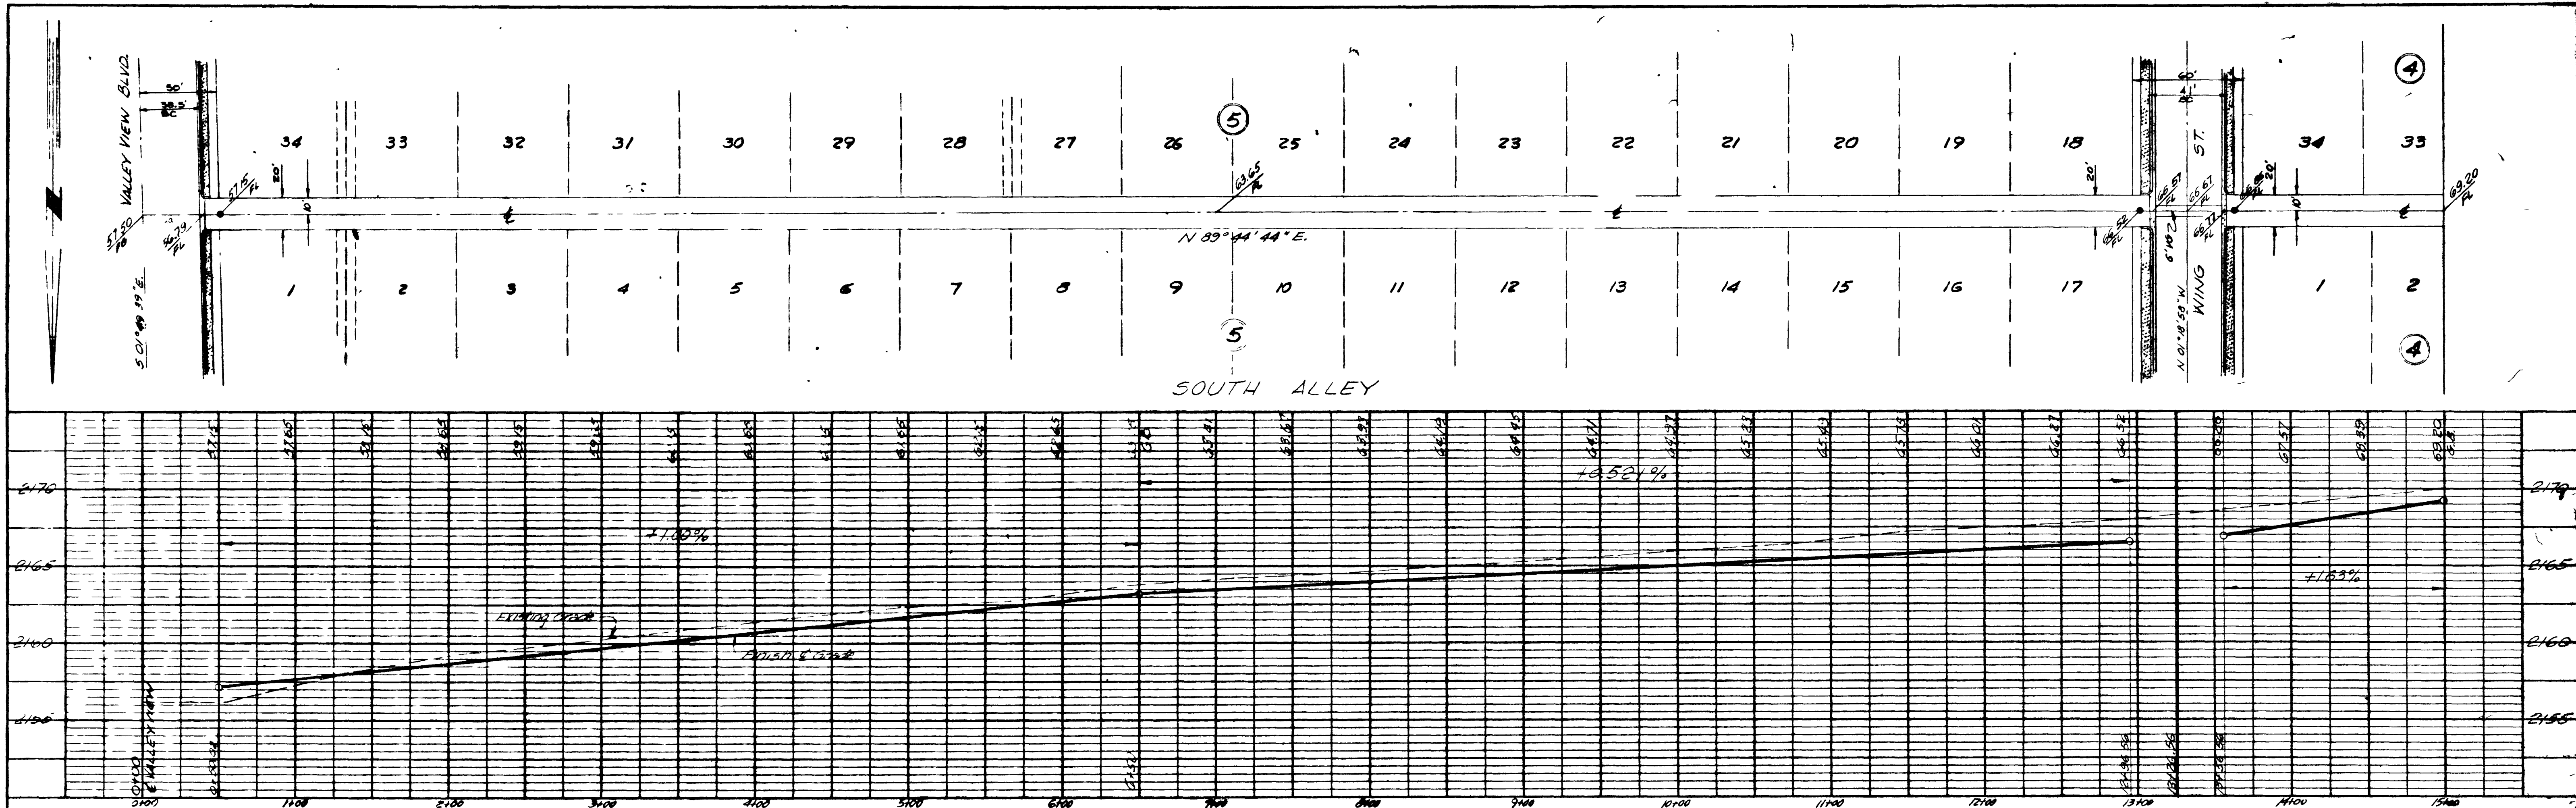


PROFILE
 SURVEYED BY _____ DATE _____
 PLOTTED BY _____
 CHECKED BY _____
 NOTE BOOK NO. _____
 FIELD BOOK NO. _____


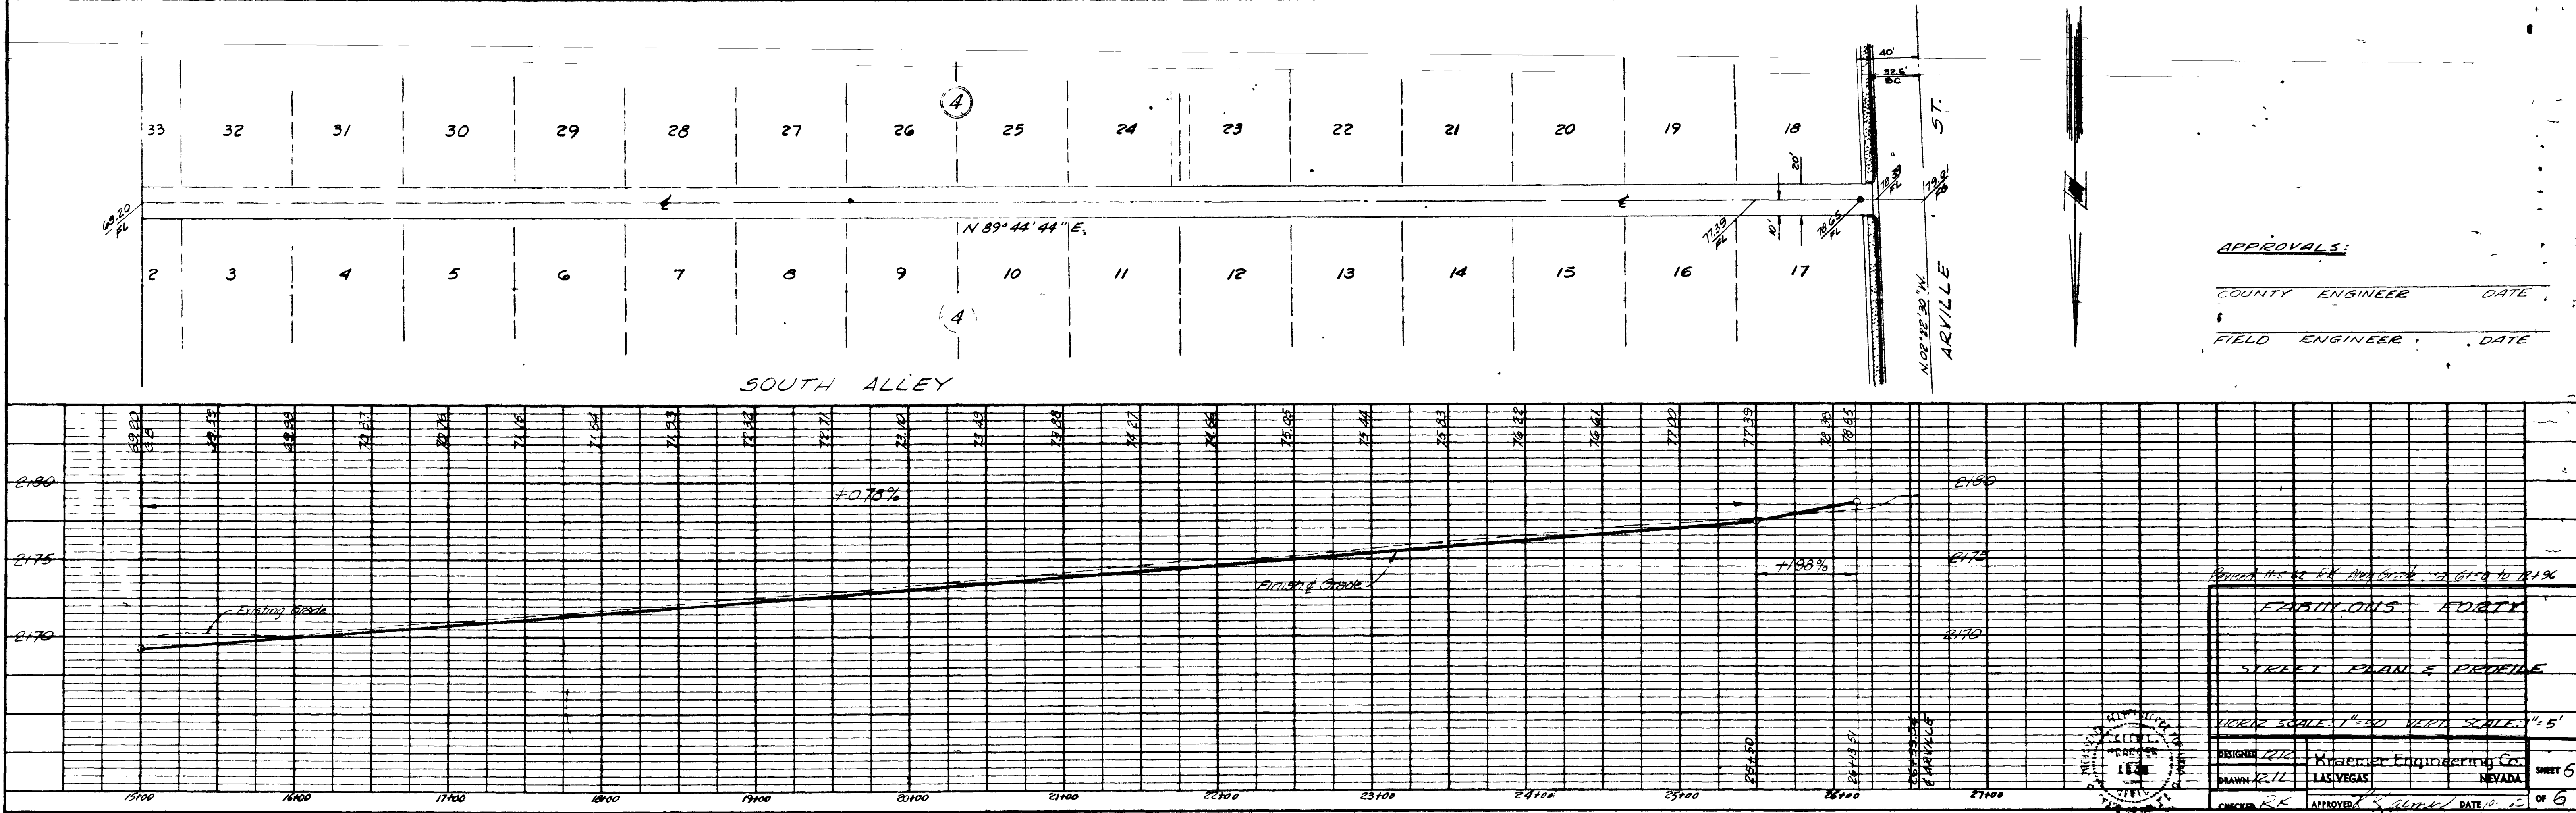


APPROVALS:
 COUNTY ENGINEER _____ DATE _____
 FIELD ENGINEER _____ DATE _____

REVISION 115 12 14
 FABULOUS FORTY
 STREET PLAN & PROFILE
 HORIZONTAL SCALE 1"=50' VERTICAL SCALE 1"=5'
 DESIGNER: R. K. Kraemer Engineering Co.
 DRAWN: R. K. LAS VEGAS NEVADA
 CHECKED: R. K. APPROVED: [Signature] DATE: 12-15-14 SHEET 6 OF 6

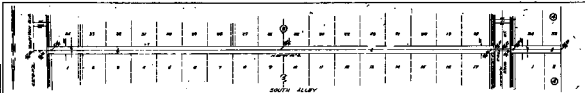

1
 2
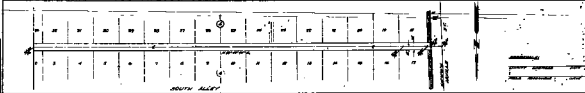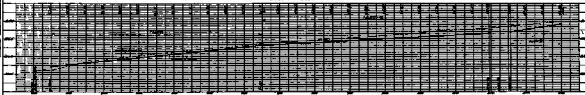

1
 2
