
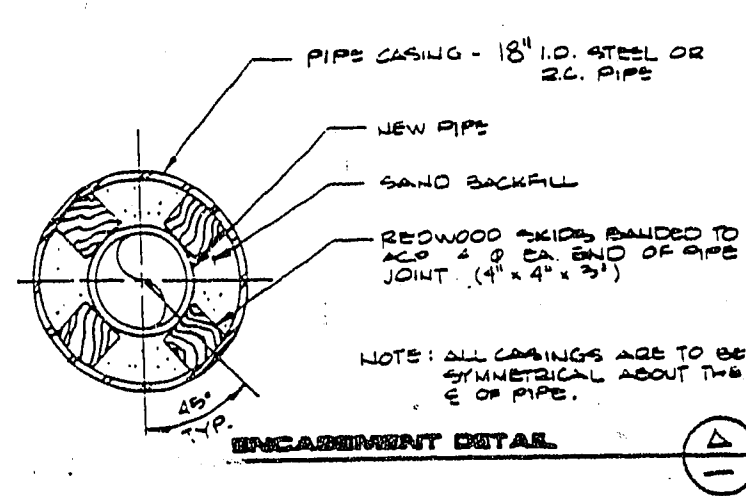



11-7-90

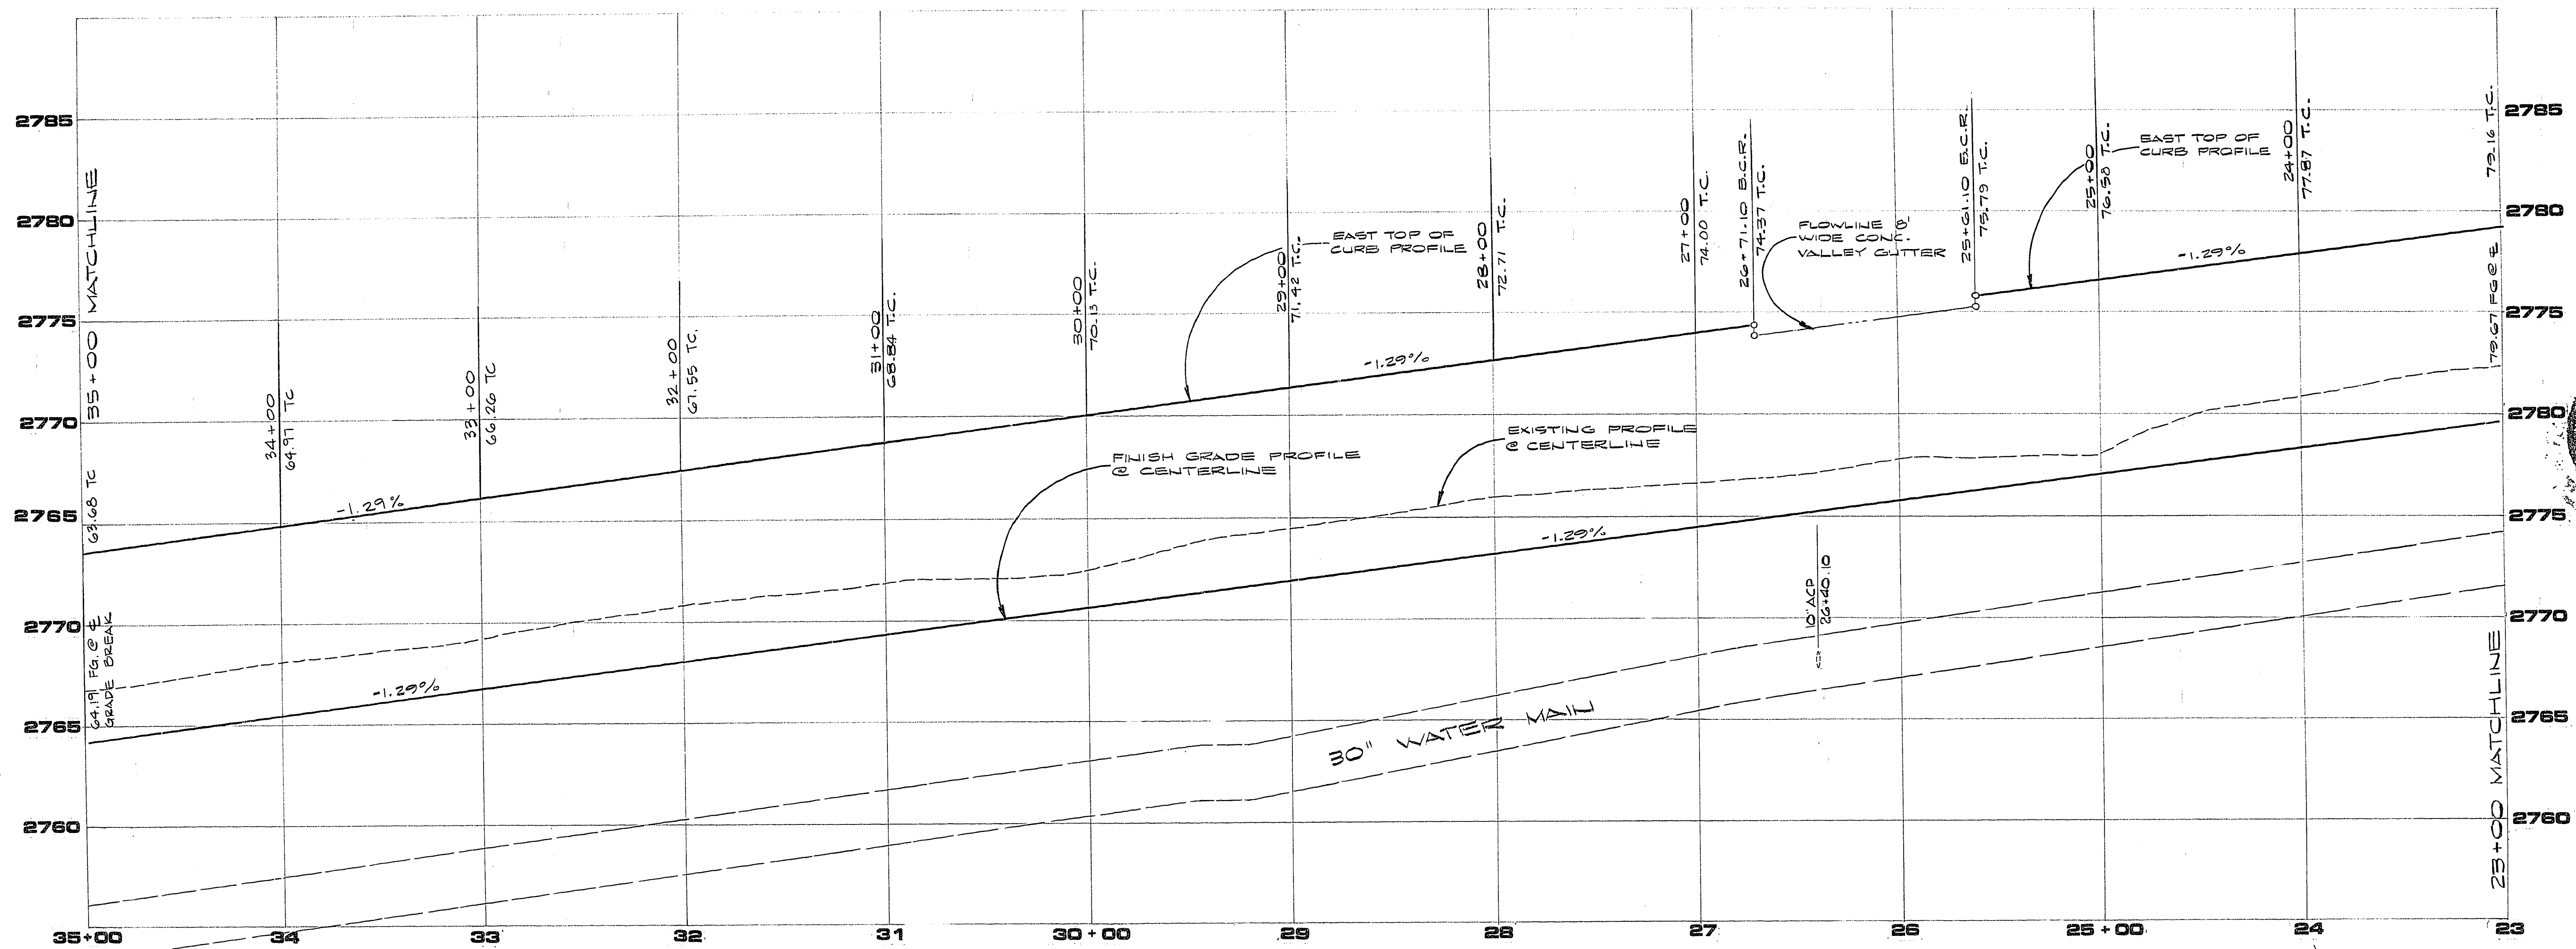



- NOTE:
1. Steel pipe casing shall be fabricated from a minimum of 1/2" thick steel plates, conforming to the requirements of ASTM A36, Grade A, C, or D. All joints shall be welded, interior joints shall be ground to a smooth finish. All welding shall be performed in accordance with AWS D11.1, "Standard for Fabricated Electrically Welded Steel Water Pipe." Coatings for steel casing are not required.
 2. Pipe casing shall be laid true to line and grade with no bends or changes in grade for the full length of the casing.
 3. The pipe shall be supported at each end of each joint with a block. The annular space between the pipe and the casing shall be backfilled with sand. After installation of the pipe, the casing shall be sealed at both ends with mortar or brick or cement price.

BCR CURVE DATA

LC	Δ	R	L	T
1	90°00'00"	25.00'	39.27	25.00'

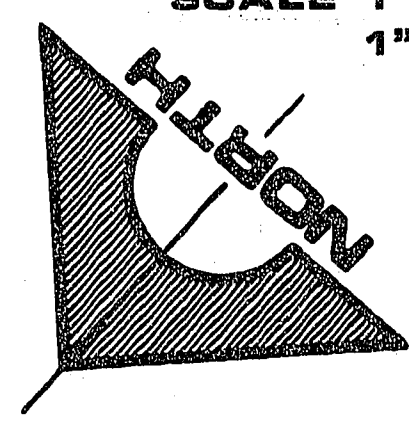

- NOTES:
1. STRUCTURAL SECTION OF STREET TO CONFORM TO C. L. V. STANDARD DRAWINGS.
 2. OWNER AGREES THAT IF EXISTING NATIVE MATERIAL DOES NOT CONFORM TO SPECIFICATIONS FOR TYPE I BASE, OWNER WILL IMPORT TYPE I BASE FOR A. C. PAVEMENT.
 3. C. L. V. WILL BE CONTACTED PRIOR TO CONSTRUCTION TO DETERMINE SUITABILITY OF NATIVE MATERIAL.

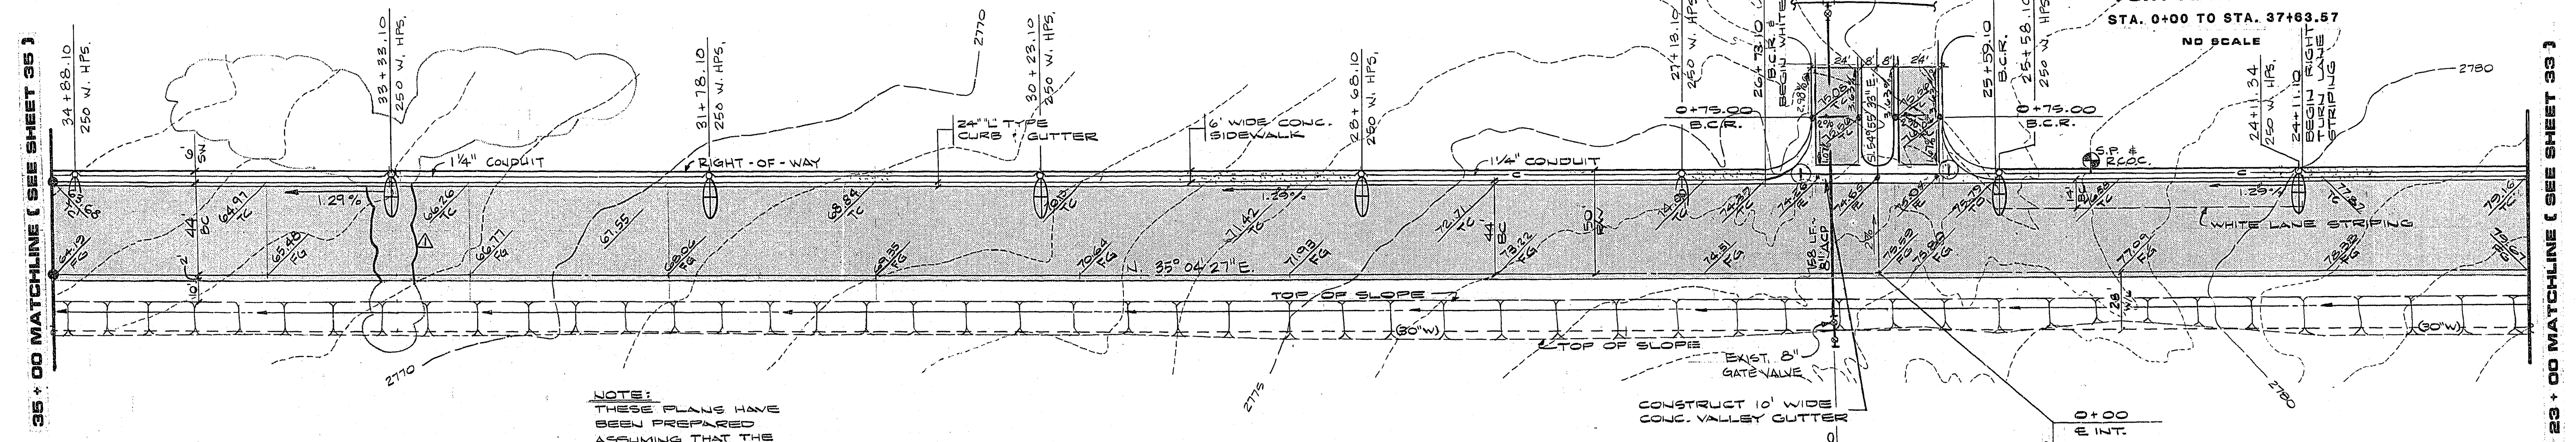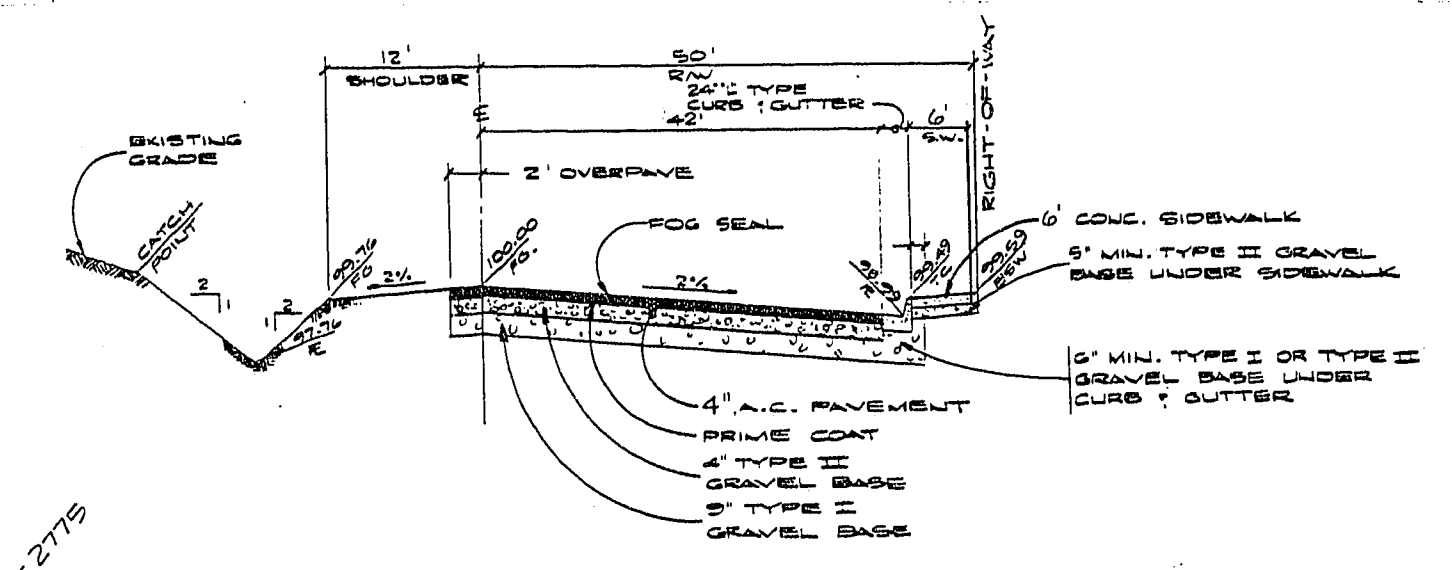


NOTE:
THESE PLANS HAVE BEEN PREPARED ASSUMING THAT THE 30" WATER LINE TO BE CONSTRUCTED IN FORT APACHE RD. R.O.W. BY OTHERS IS EXISTING.

FORT APACHE ROAD
SCALE 1" = 40'

FOOTHILLS COUNTRY CLUB UNIT NO. 3
AT PECOLE RANCH
FORT APACHE ROAD
STA. 23+00 TO STA. 35+00

G.C. WALLACE, INC.
Engineering/Architecture
1555 SOUTH RAINBOW BLVD LAS VEGAS, NEVADA 89102

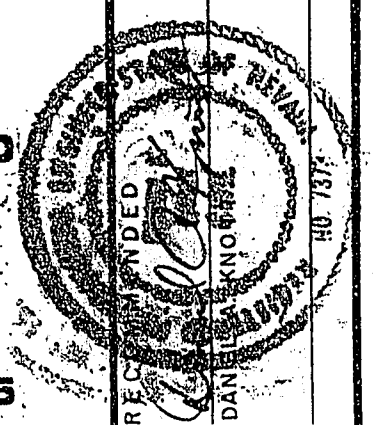

REV	DATE	DESCRIPTION
1	11/7/90	DESIGNED BY G.C. WALLACE, INC. ON 11/7/90