

NORTH T.C. PROFILE 2785

EX. GRADE PROFILE 2785

2785

2780




2775

2770

2765


2760

2755

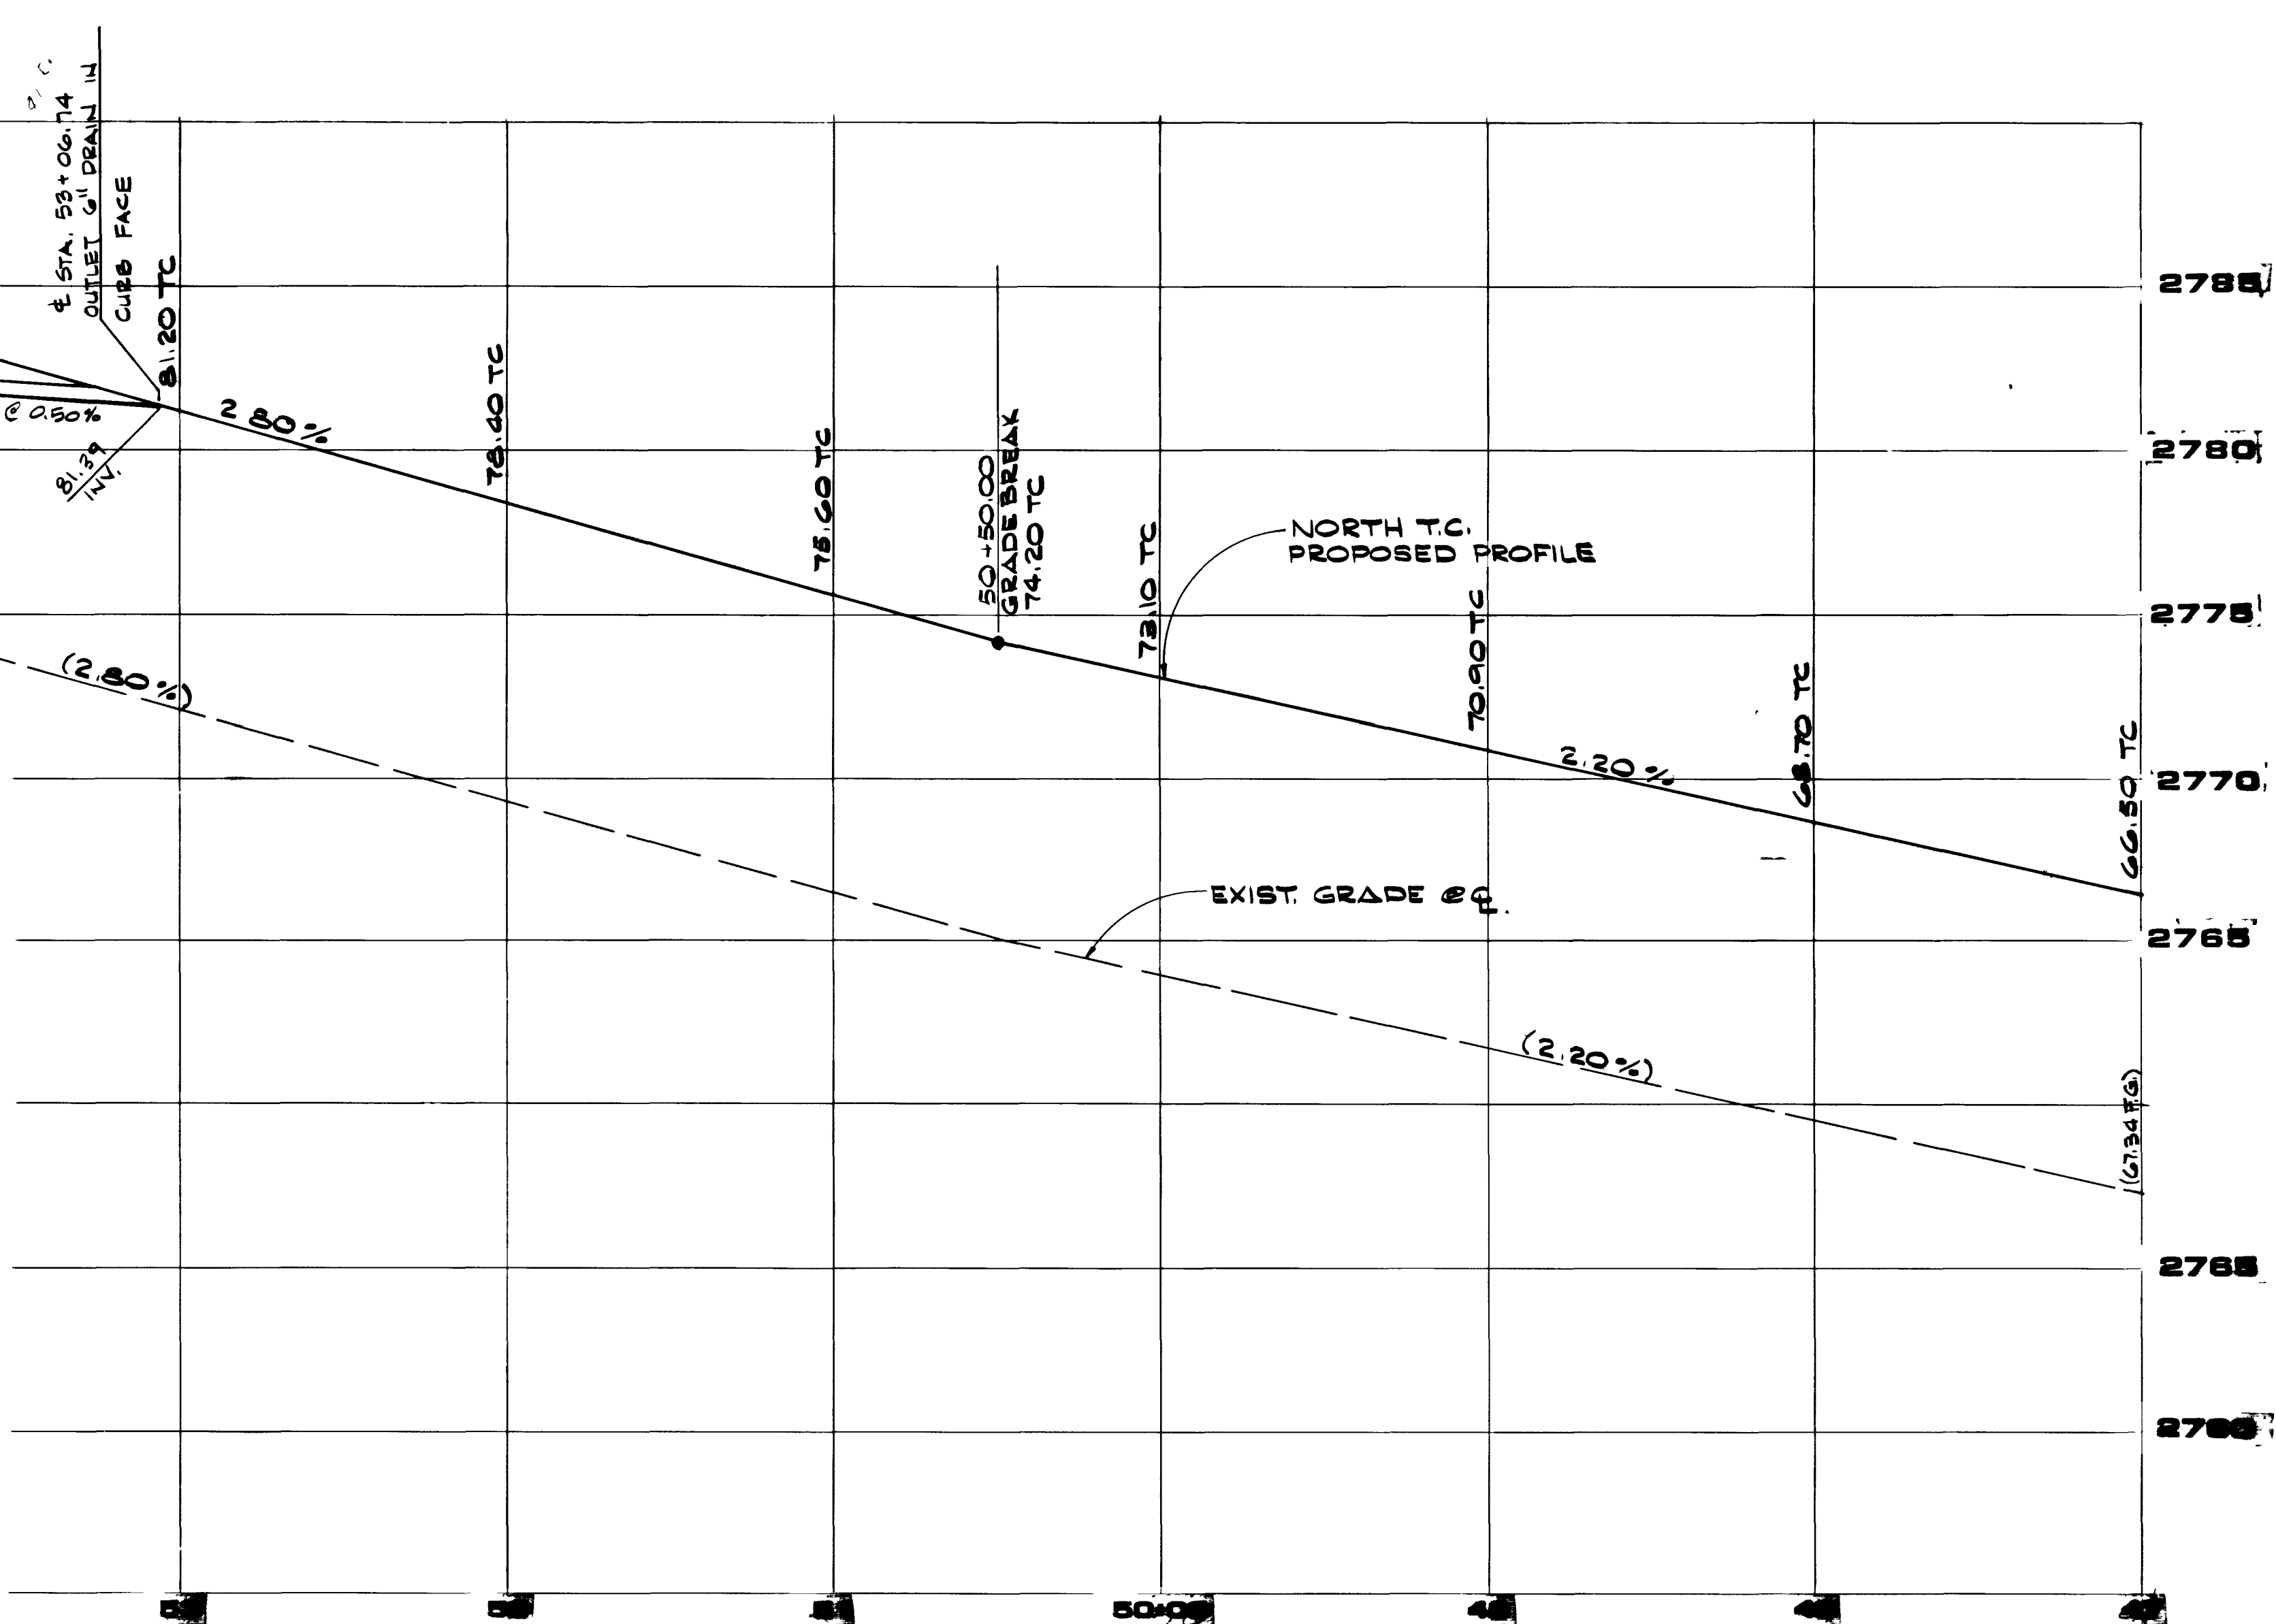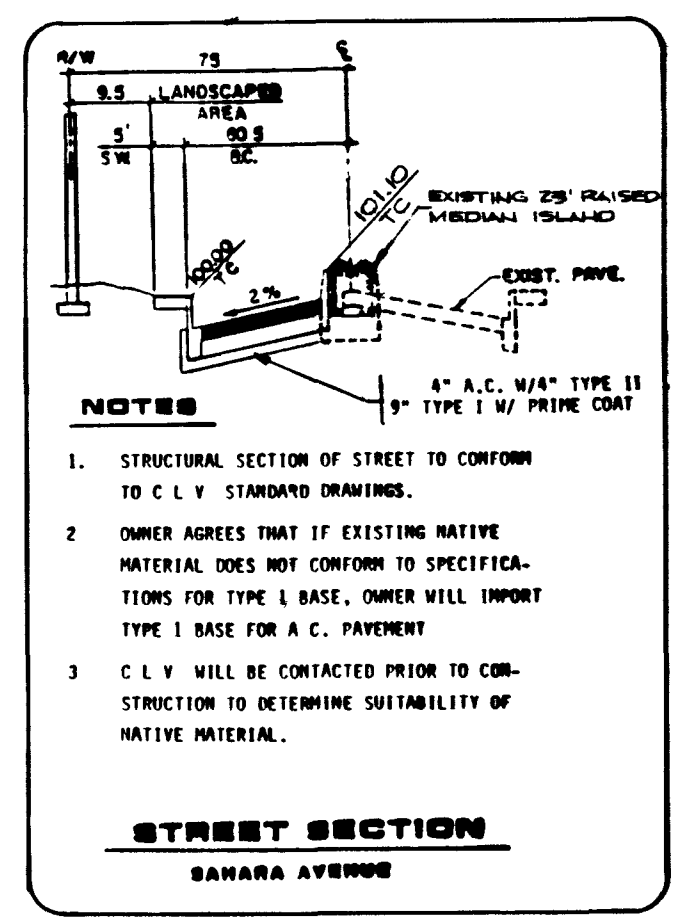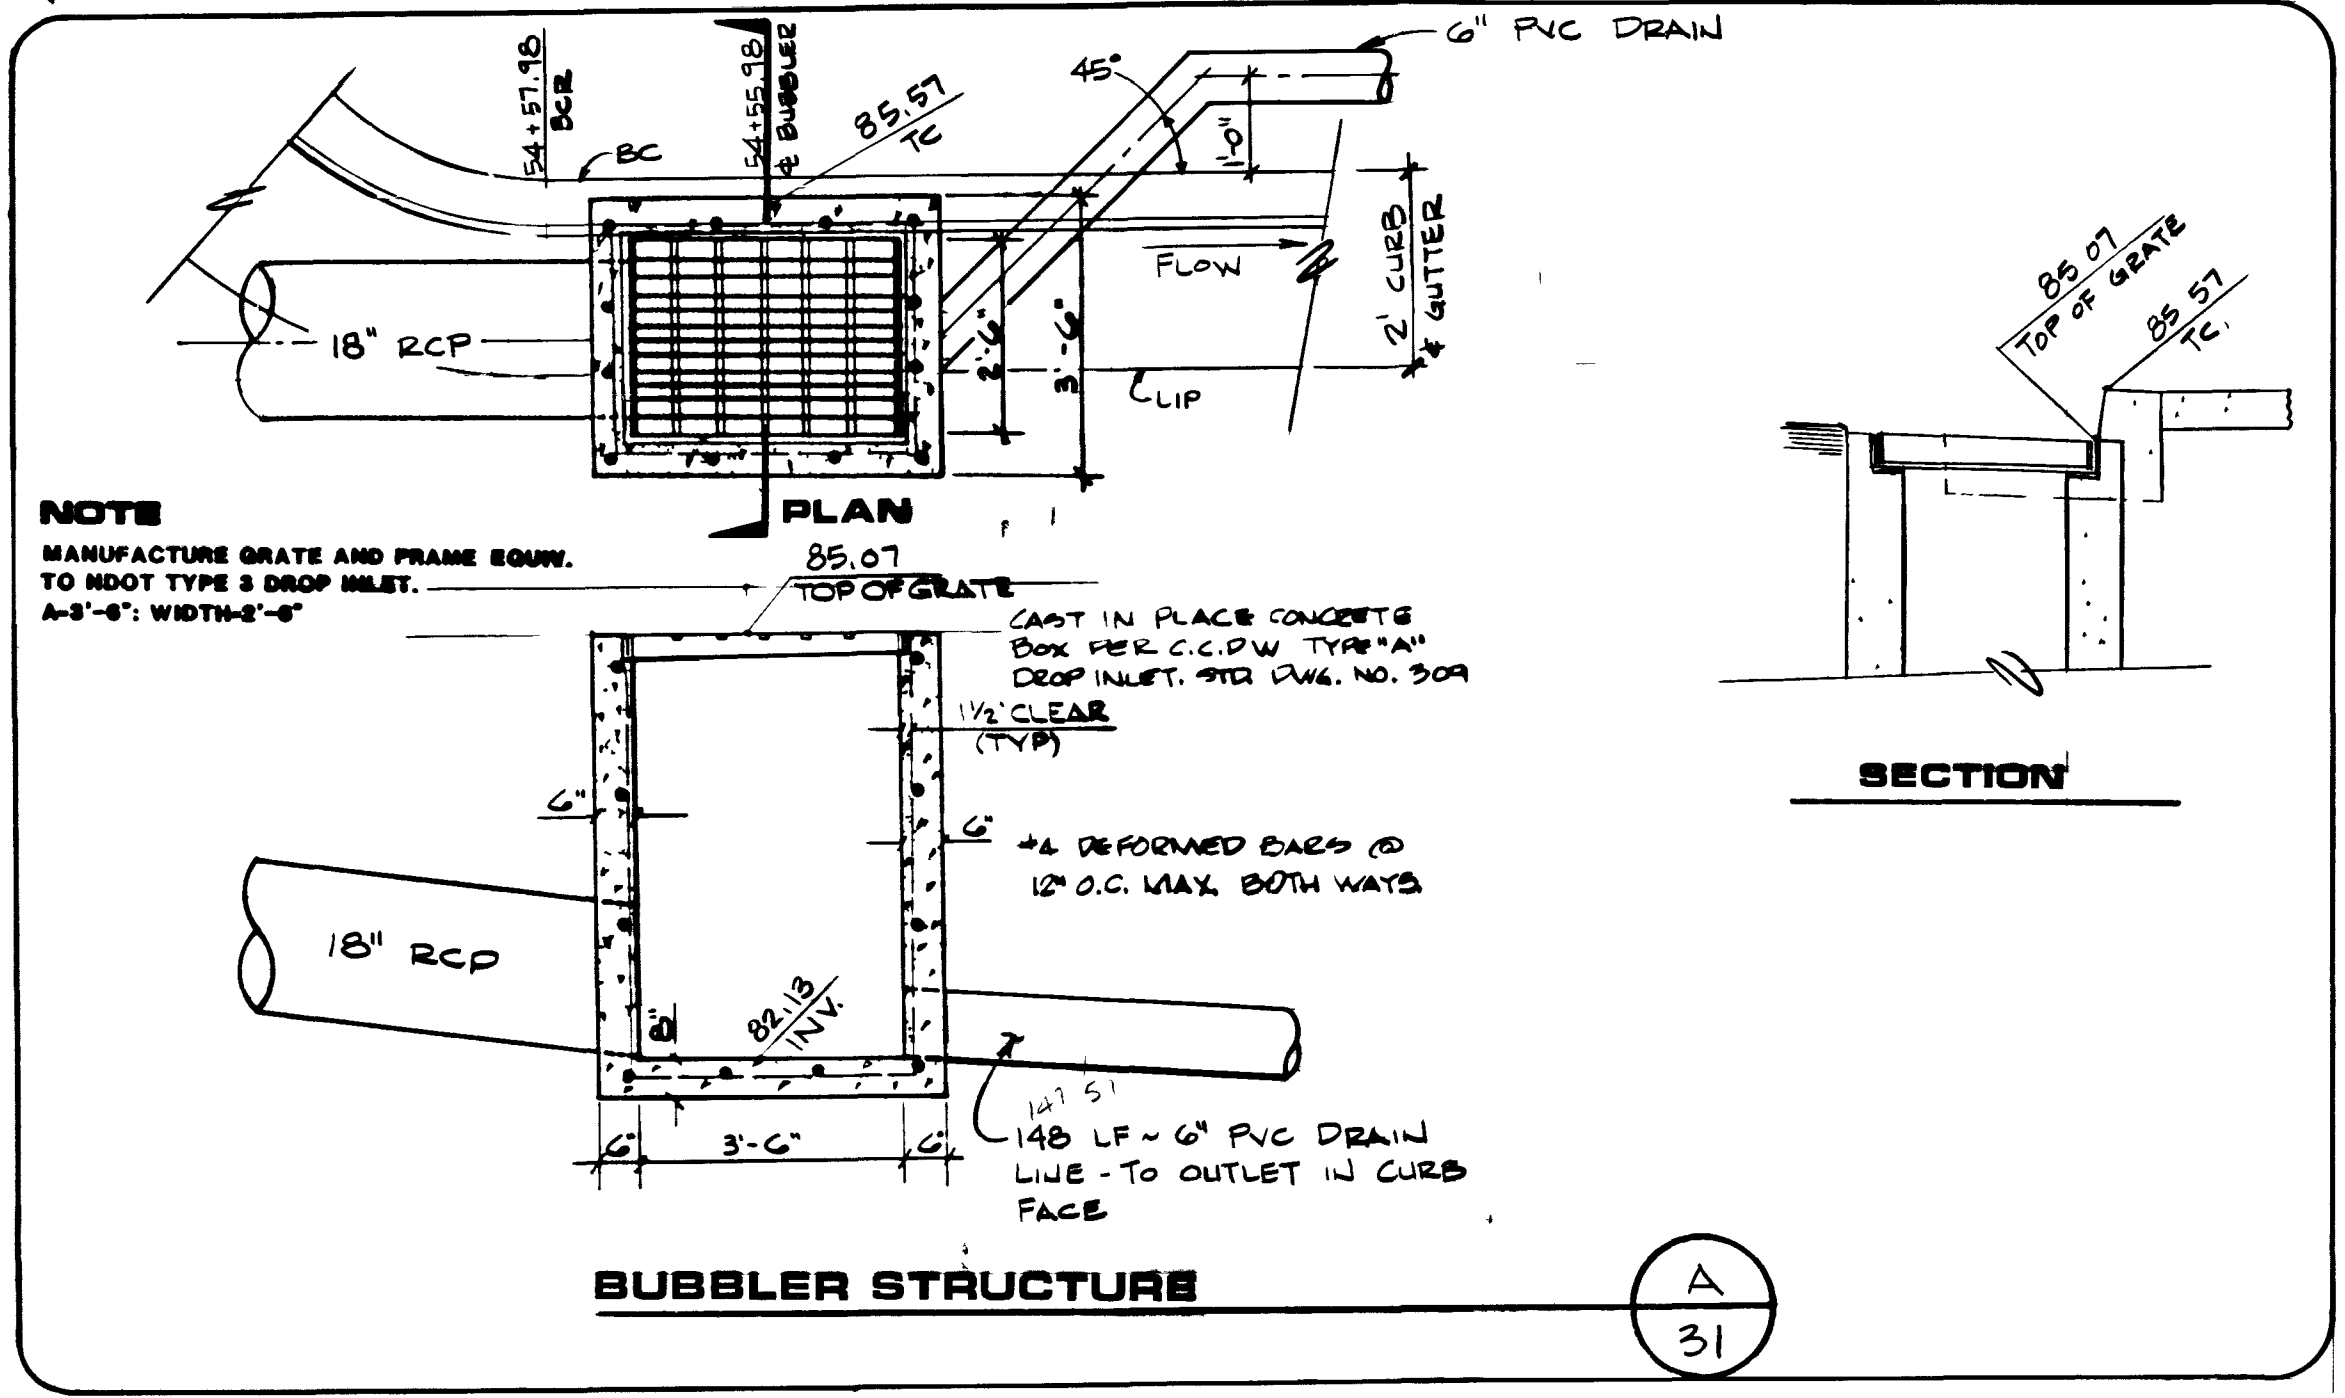

PROFILE
SCALE: HORIZ. 1"=40'
VERT. 1"=4'

BCR CURVE DATA				
St	Δ	R	L	T
1	85°53'01"	30.00'	44.97'	27.92'

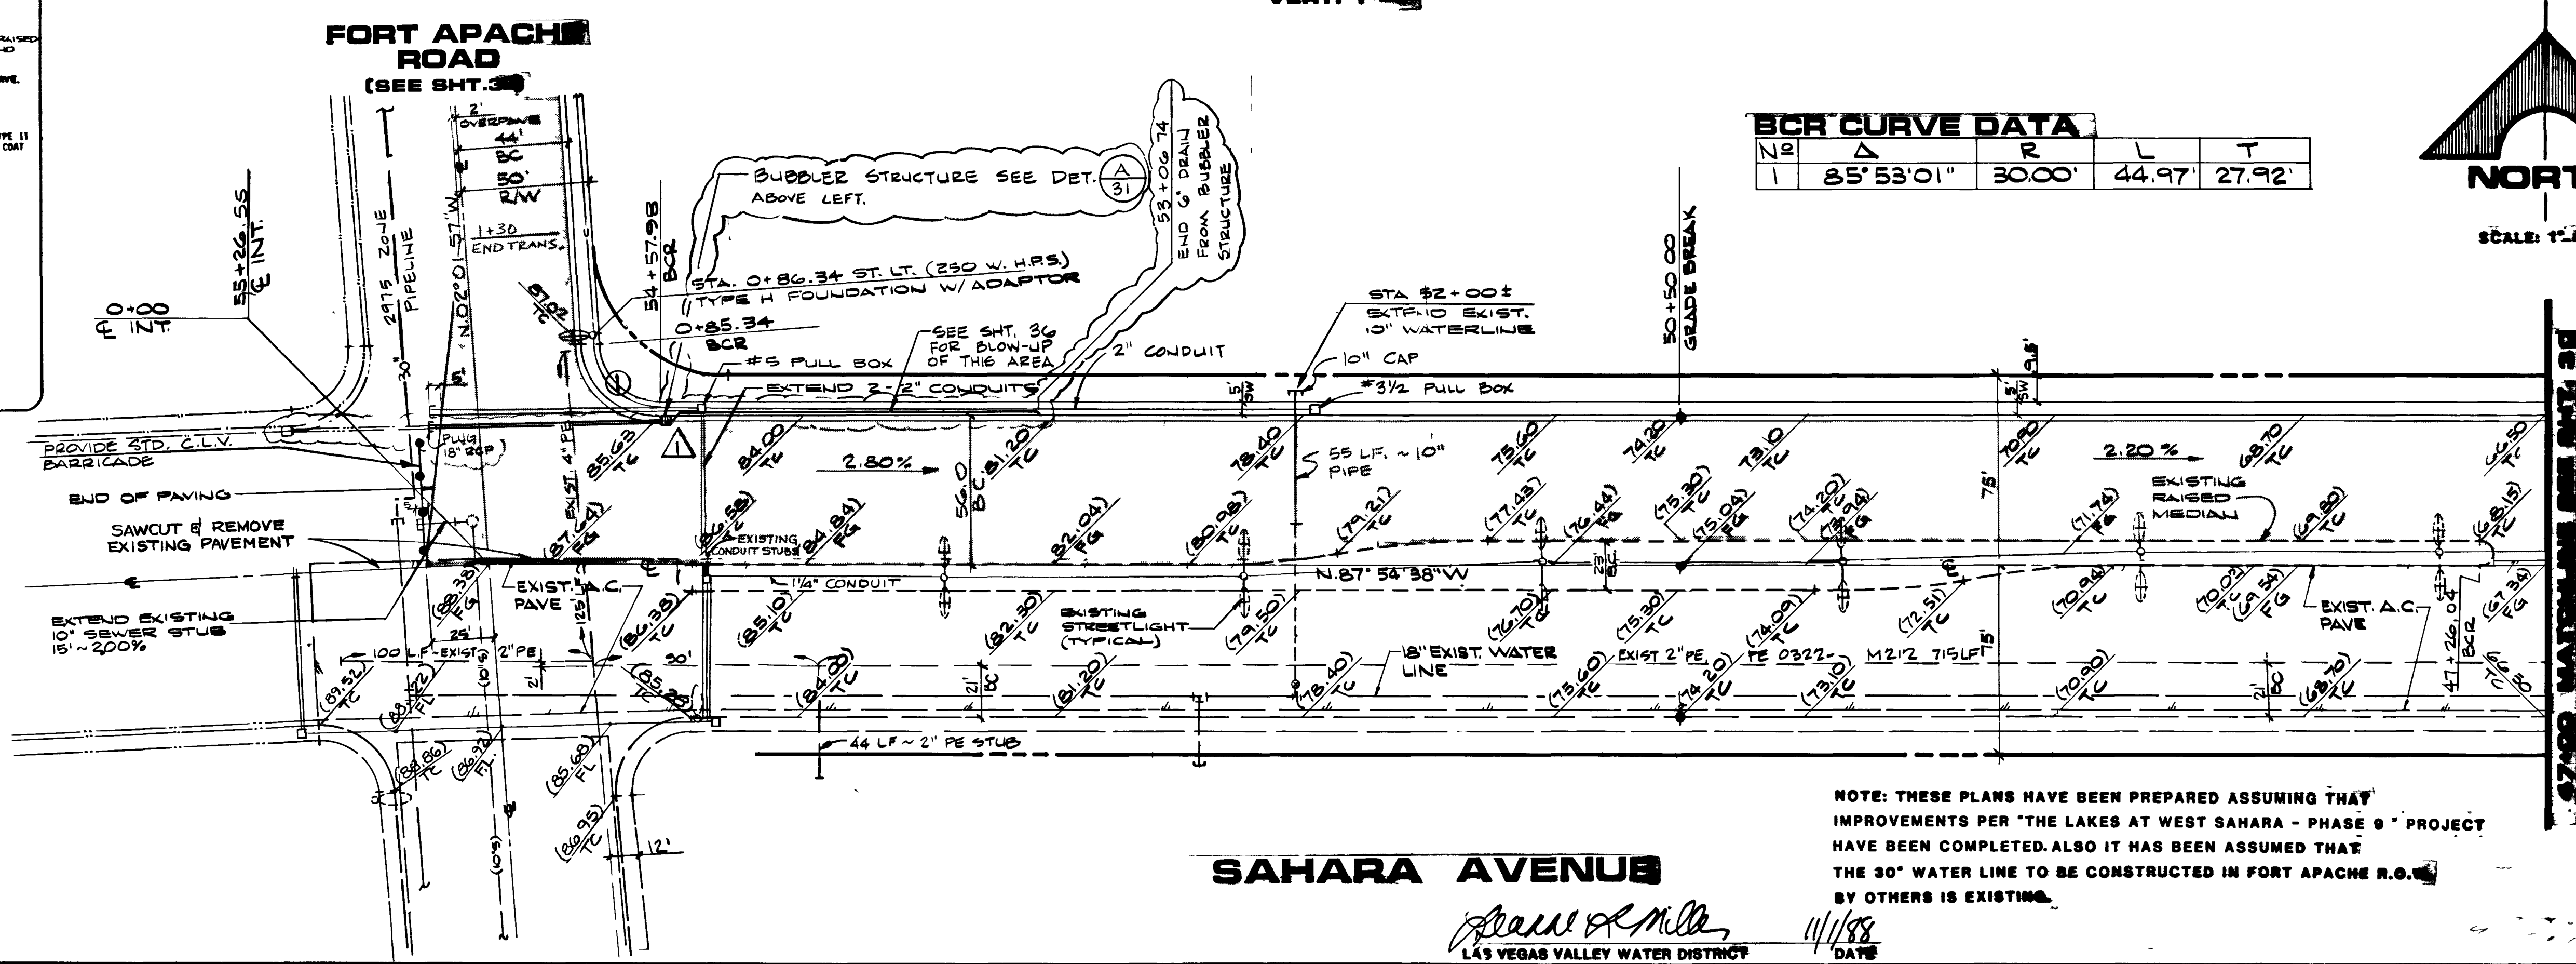


SAHARA AVENUE

NOTE: THESE PLANS HAVE BEEN PREPARED ASSUMING THAT IMPROVEMENTS PER "THE LAKES AT WEST SAHARA - PHASE 9" PROJECT HAVE BEEN COMPLETED. ALSO IT HAS BEEN ASSUMED THAT THE 30" WATER LINE TO BE CONSTRUCTED IN FORT APACHE R.O.W. BY OTHERS IS EXISTING.

David Miller
LAS VEGAS VALLEY WATER DISTRICT

11/1/88
DATE

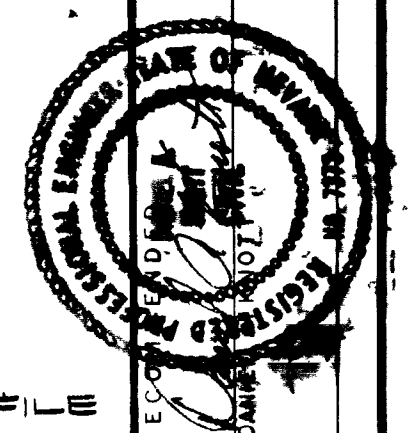

1555 SOUTH RAINBOW BLVD / LAS VEGAS, NEVADA 89102

G.C. WALLACE, INC.
Engineering/Architecture

FOOTHILLS COUNTRY CLUB UNIT NO. 3
AT PECCOLE RANCH
SAHARA AVE.
STA. 47+00.00 TO STA. 57+00.00

SHEET
31
OF 36 SHEETS

