11-7-76

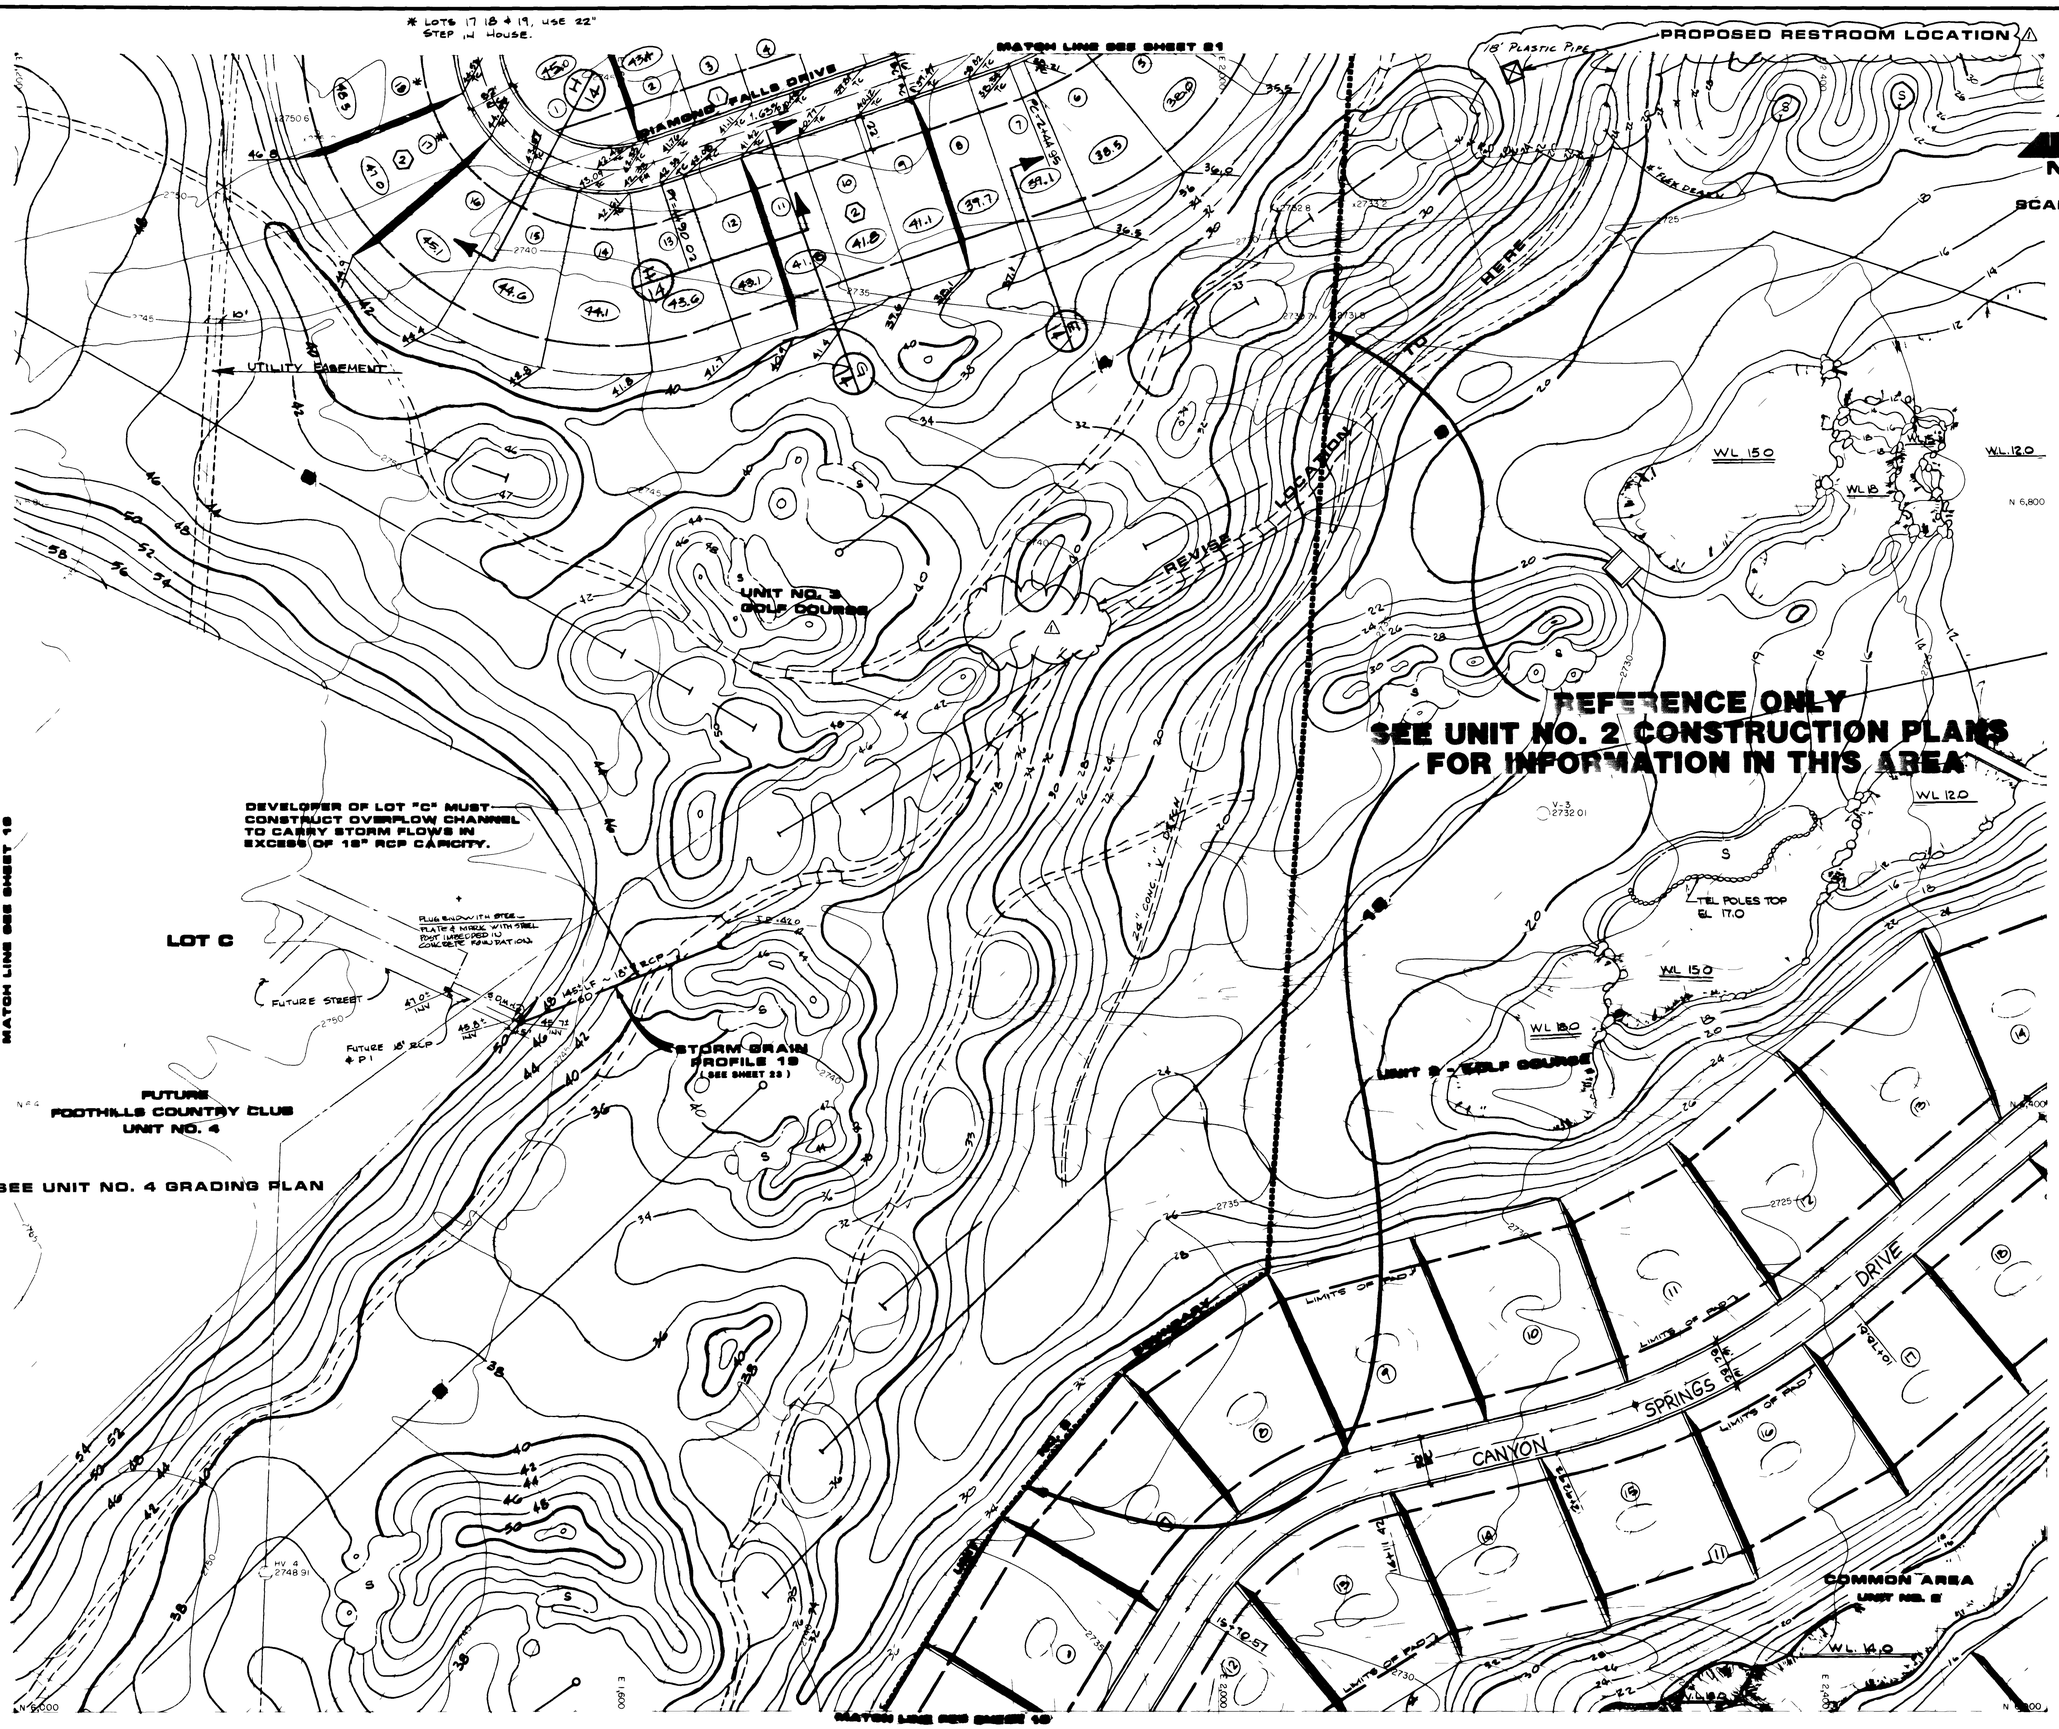

REV	DATE	DESCRIPTION
1	4-16-76	REVISE RESTROOM LOCATION

JOB
DATE
DRAWN
CHECK

G.C. WALLACE, INC.
Engineering/Architecture
1555 SOUTH RAINBOW BLVD / LAS VEGAS, NEVADA 89102

FOOTHILLS COUNTRY CLUB UNIT NO. 3
AT PEBBLE BEACH

GRADING PLAN

SHEET 20 OF 36 SHEETS

JOB NO. [redacted]

531

1074-1407-3

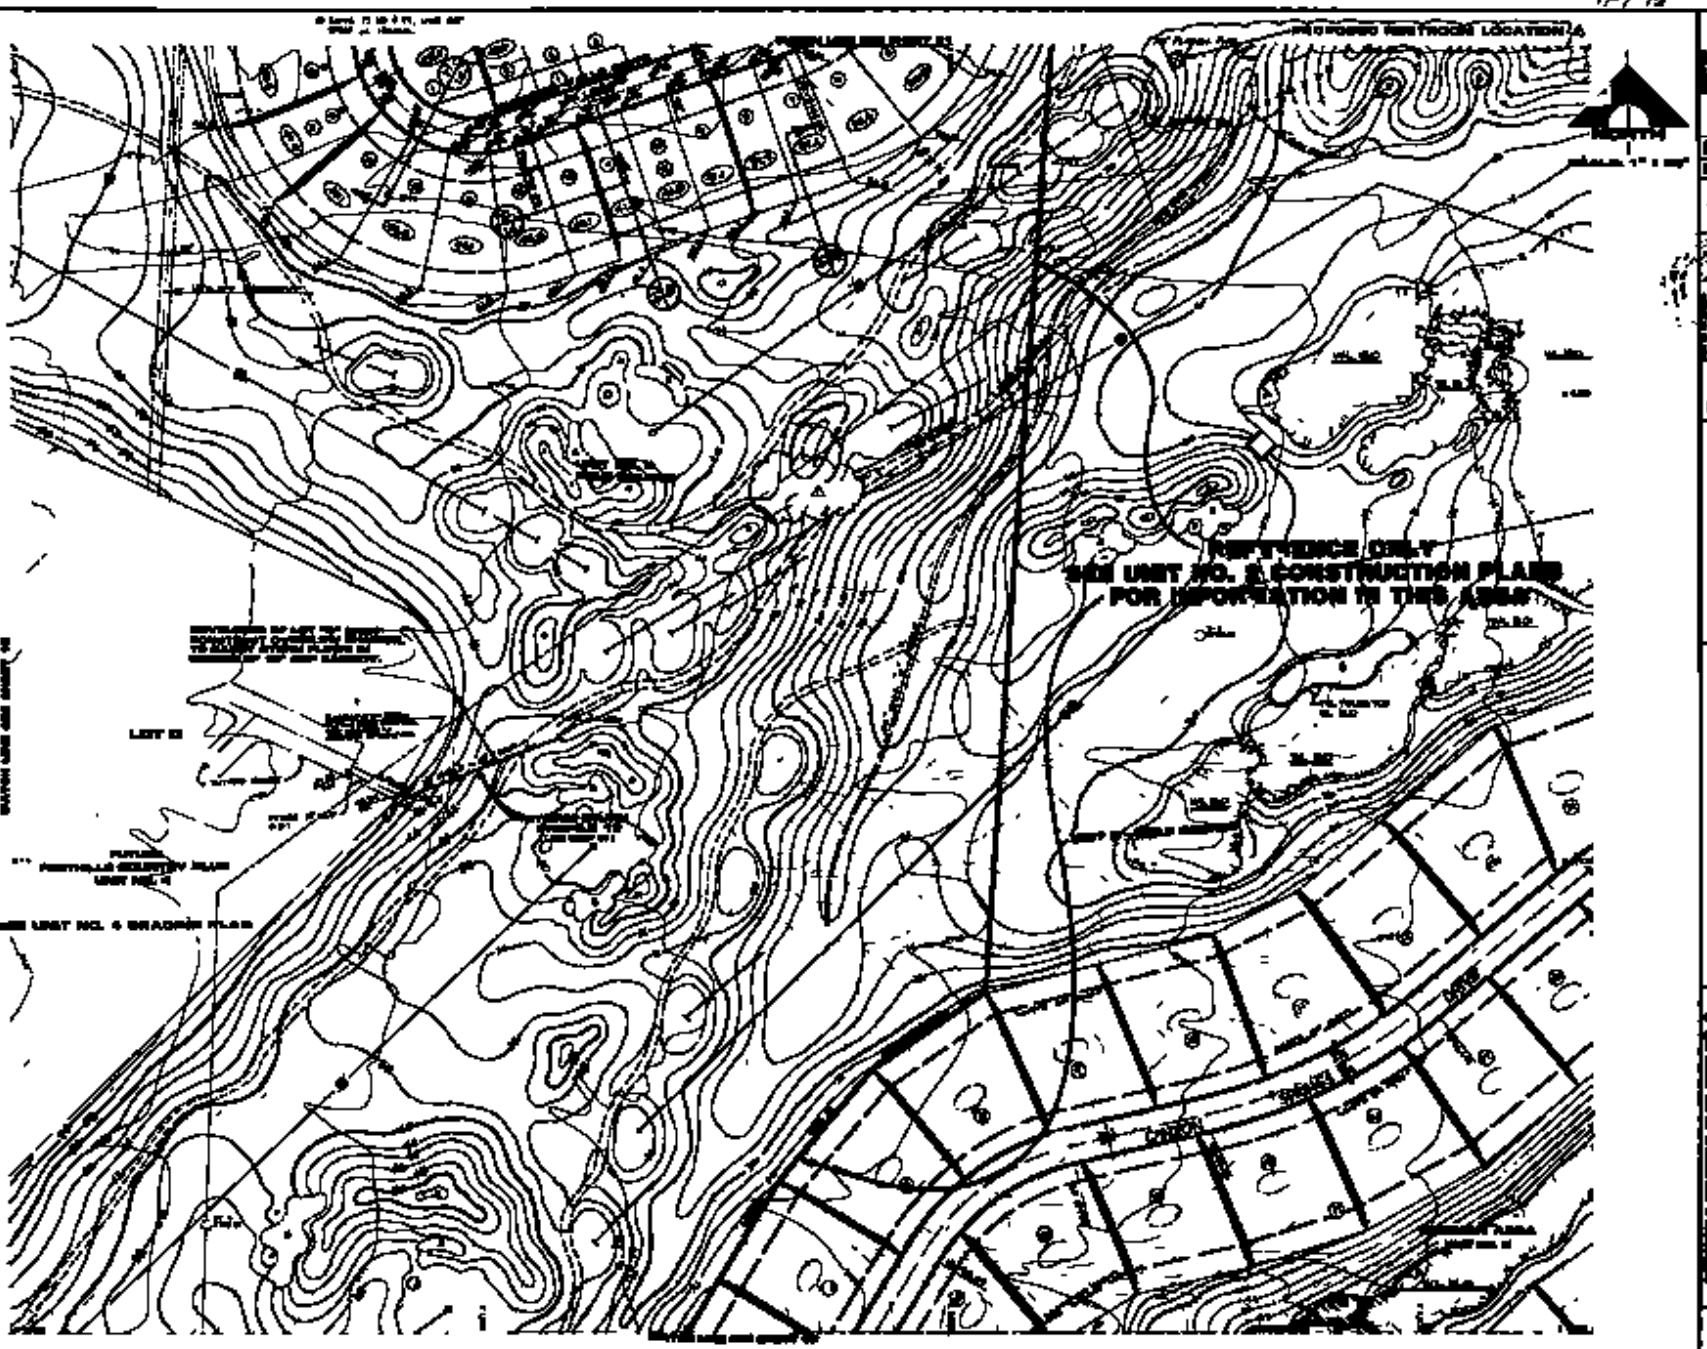
PROPOSED RESTROOM LOCATION A
NORTH
REFERENCE ONLY
FOR INFORMATION IN THIS AREA
SEE UNIT NO. 4 GRADING PLAN
20