
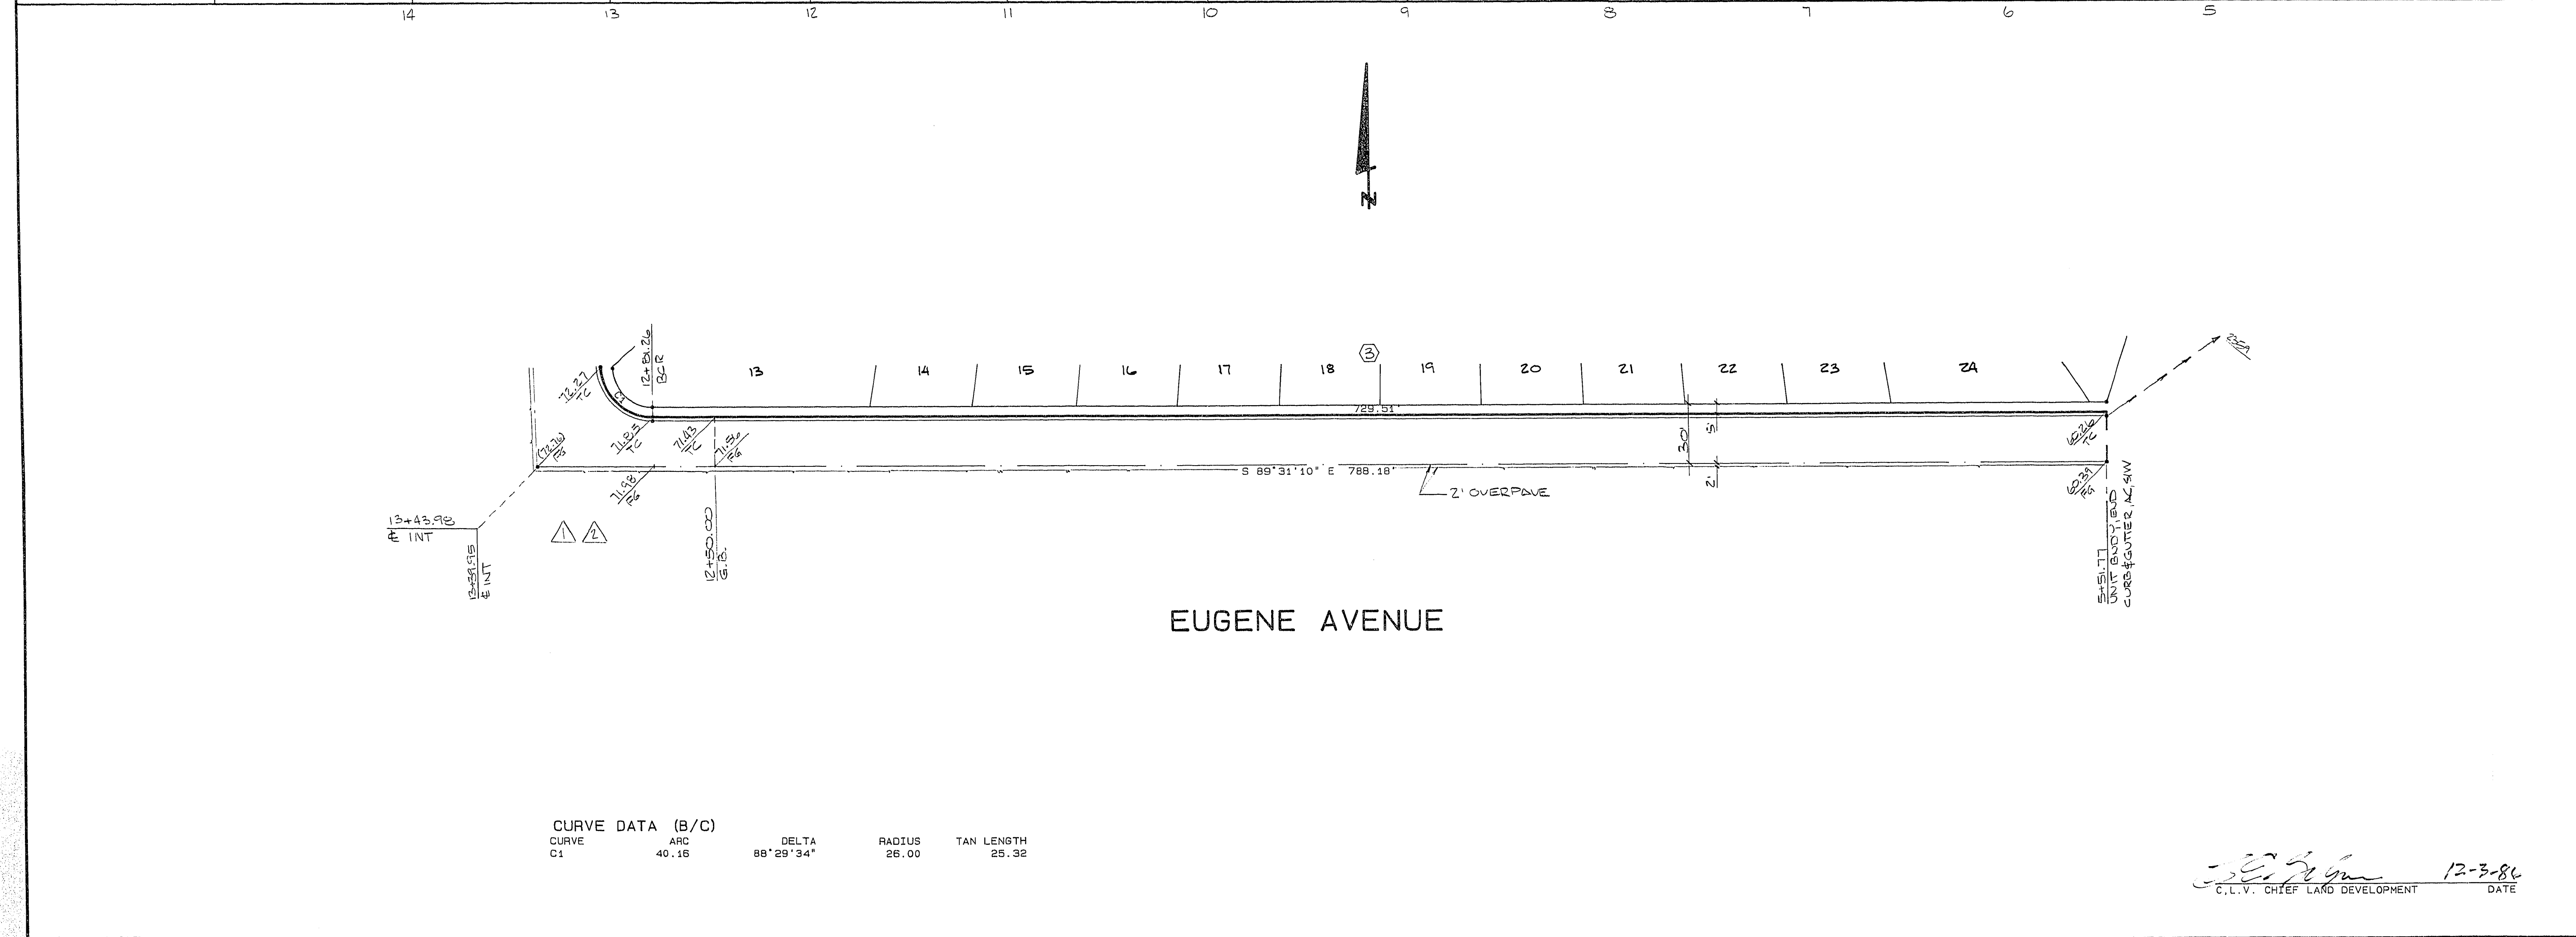


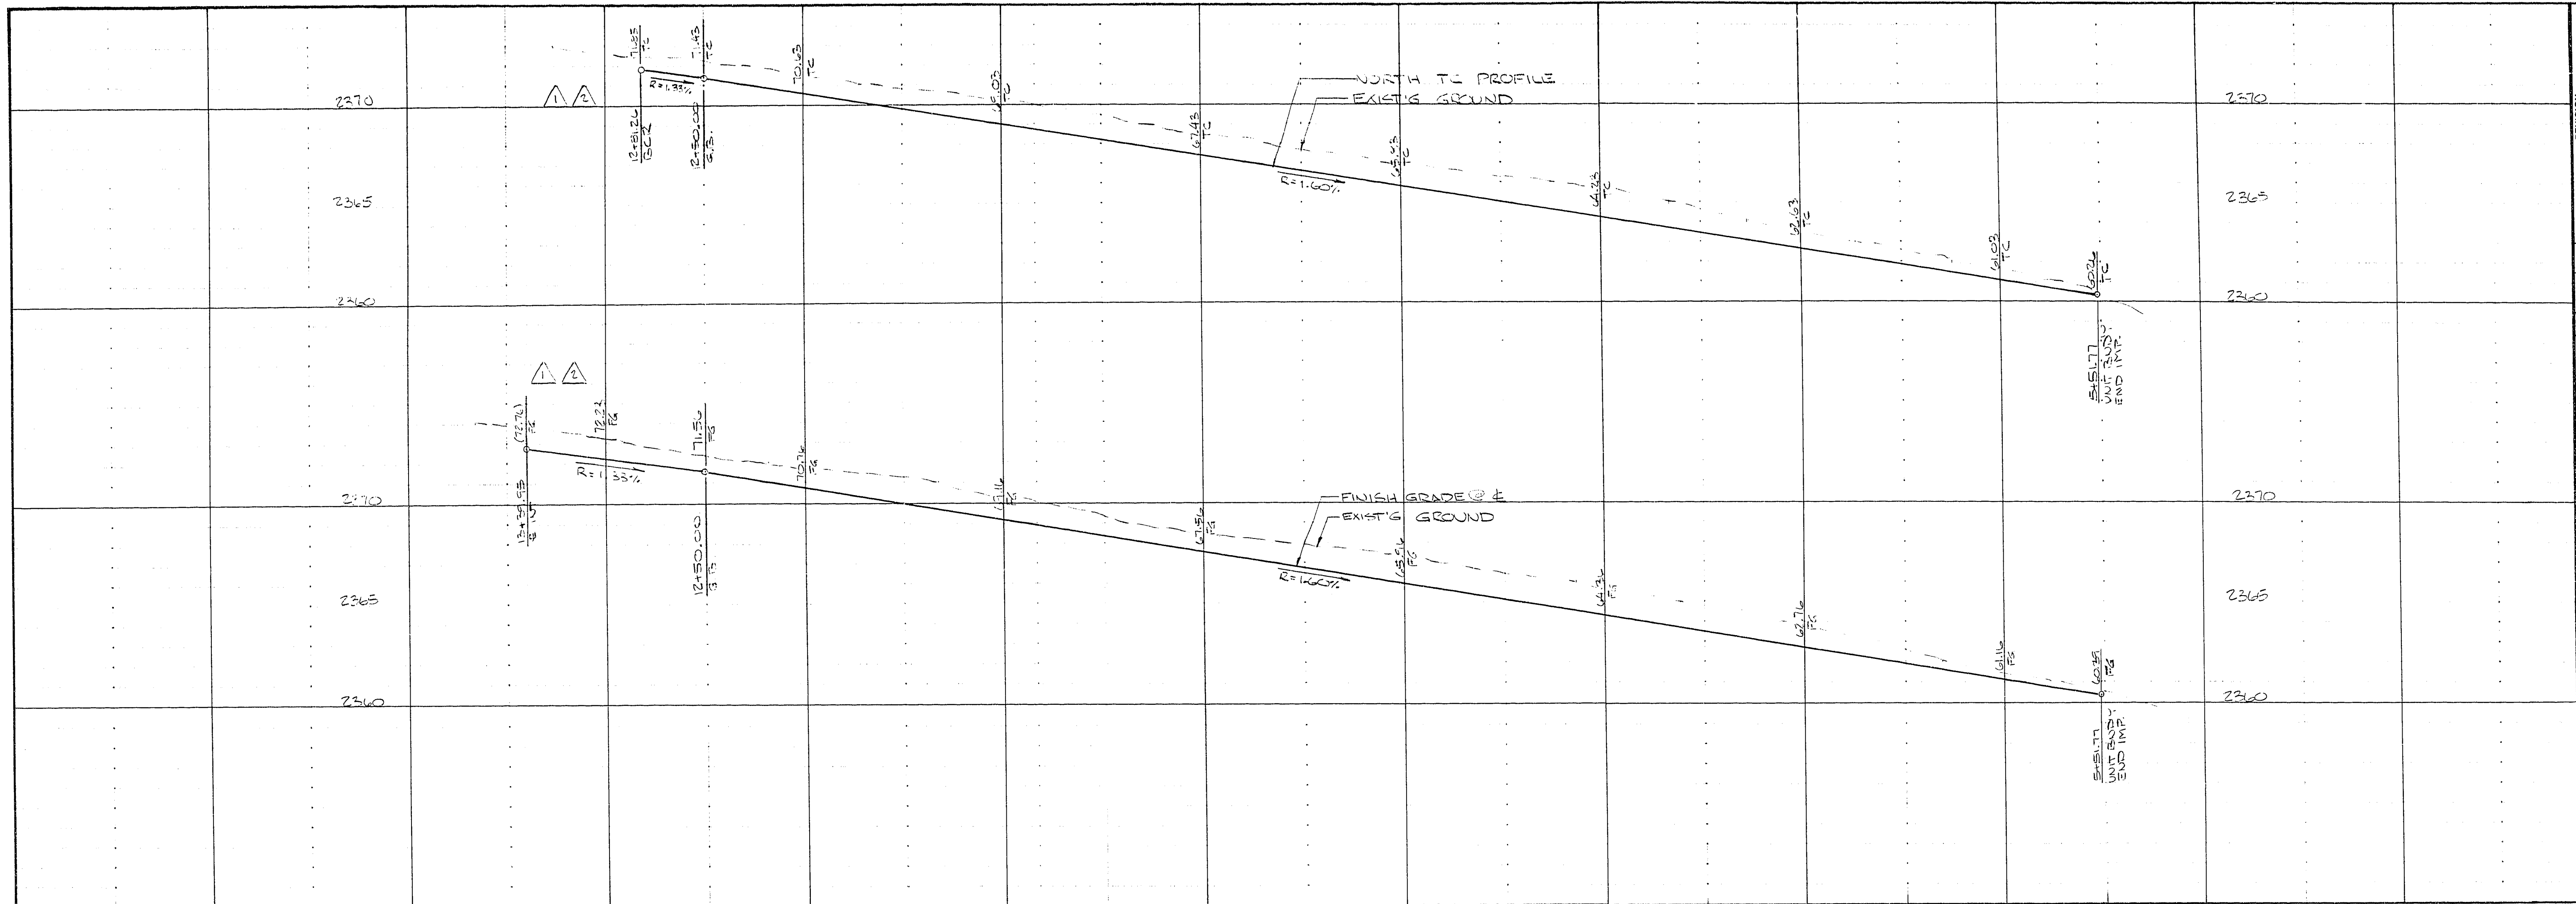

CURVE DATA (B/C)				
CURVE	ARC	DELTA	RADIUS	TAN LENGTH
C1	40.16	88°29'34"	26.00	25.32

C.L.V.
C.L.V. CHIEF LAND DEVELOPMENT
12-3-86
DATE

NO.	DATE	BY	REVISION
1	12-3-86	CH	ADJUSTED ON TIE LINE

SOUTHWEST ENGINEERING
CIVIL ENGINEERS & PLANNERS
2801 W. CHARLESTON BLVD.
LAS VEGAS, NV 89102
(702) 877-9700

8-19-86

STREET PLAN & PROFILE
EUGENE AVENUE
GATES MILL PHASE 4

TITLE
PROJECT

W.O. No.	860202-4
BY	CHIP
DATE	AUGUST 1986
SCALE	VER: 1" = 4' HOR: 1" = 40'

SHEET	4
OF 12 SHEETS	

1074-1515-4