FED. RD. REG. NO.	STATE	PROJECT NO.	COUNTY
9	NEV.	SPS-095-2(4)	CLARK

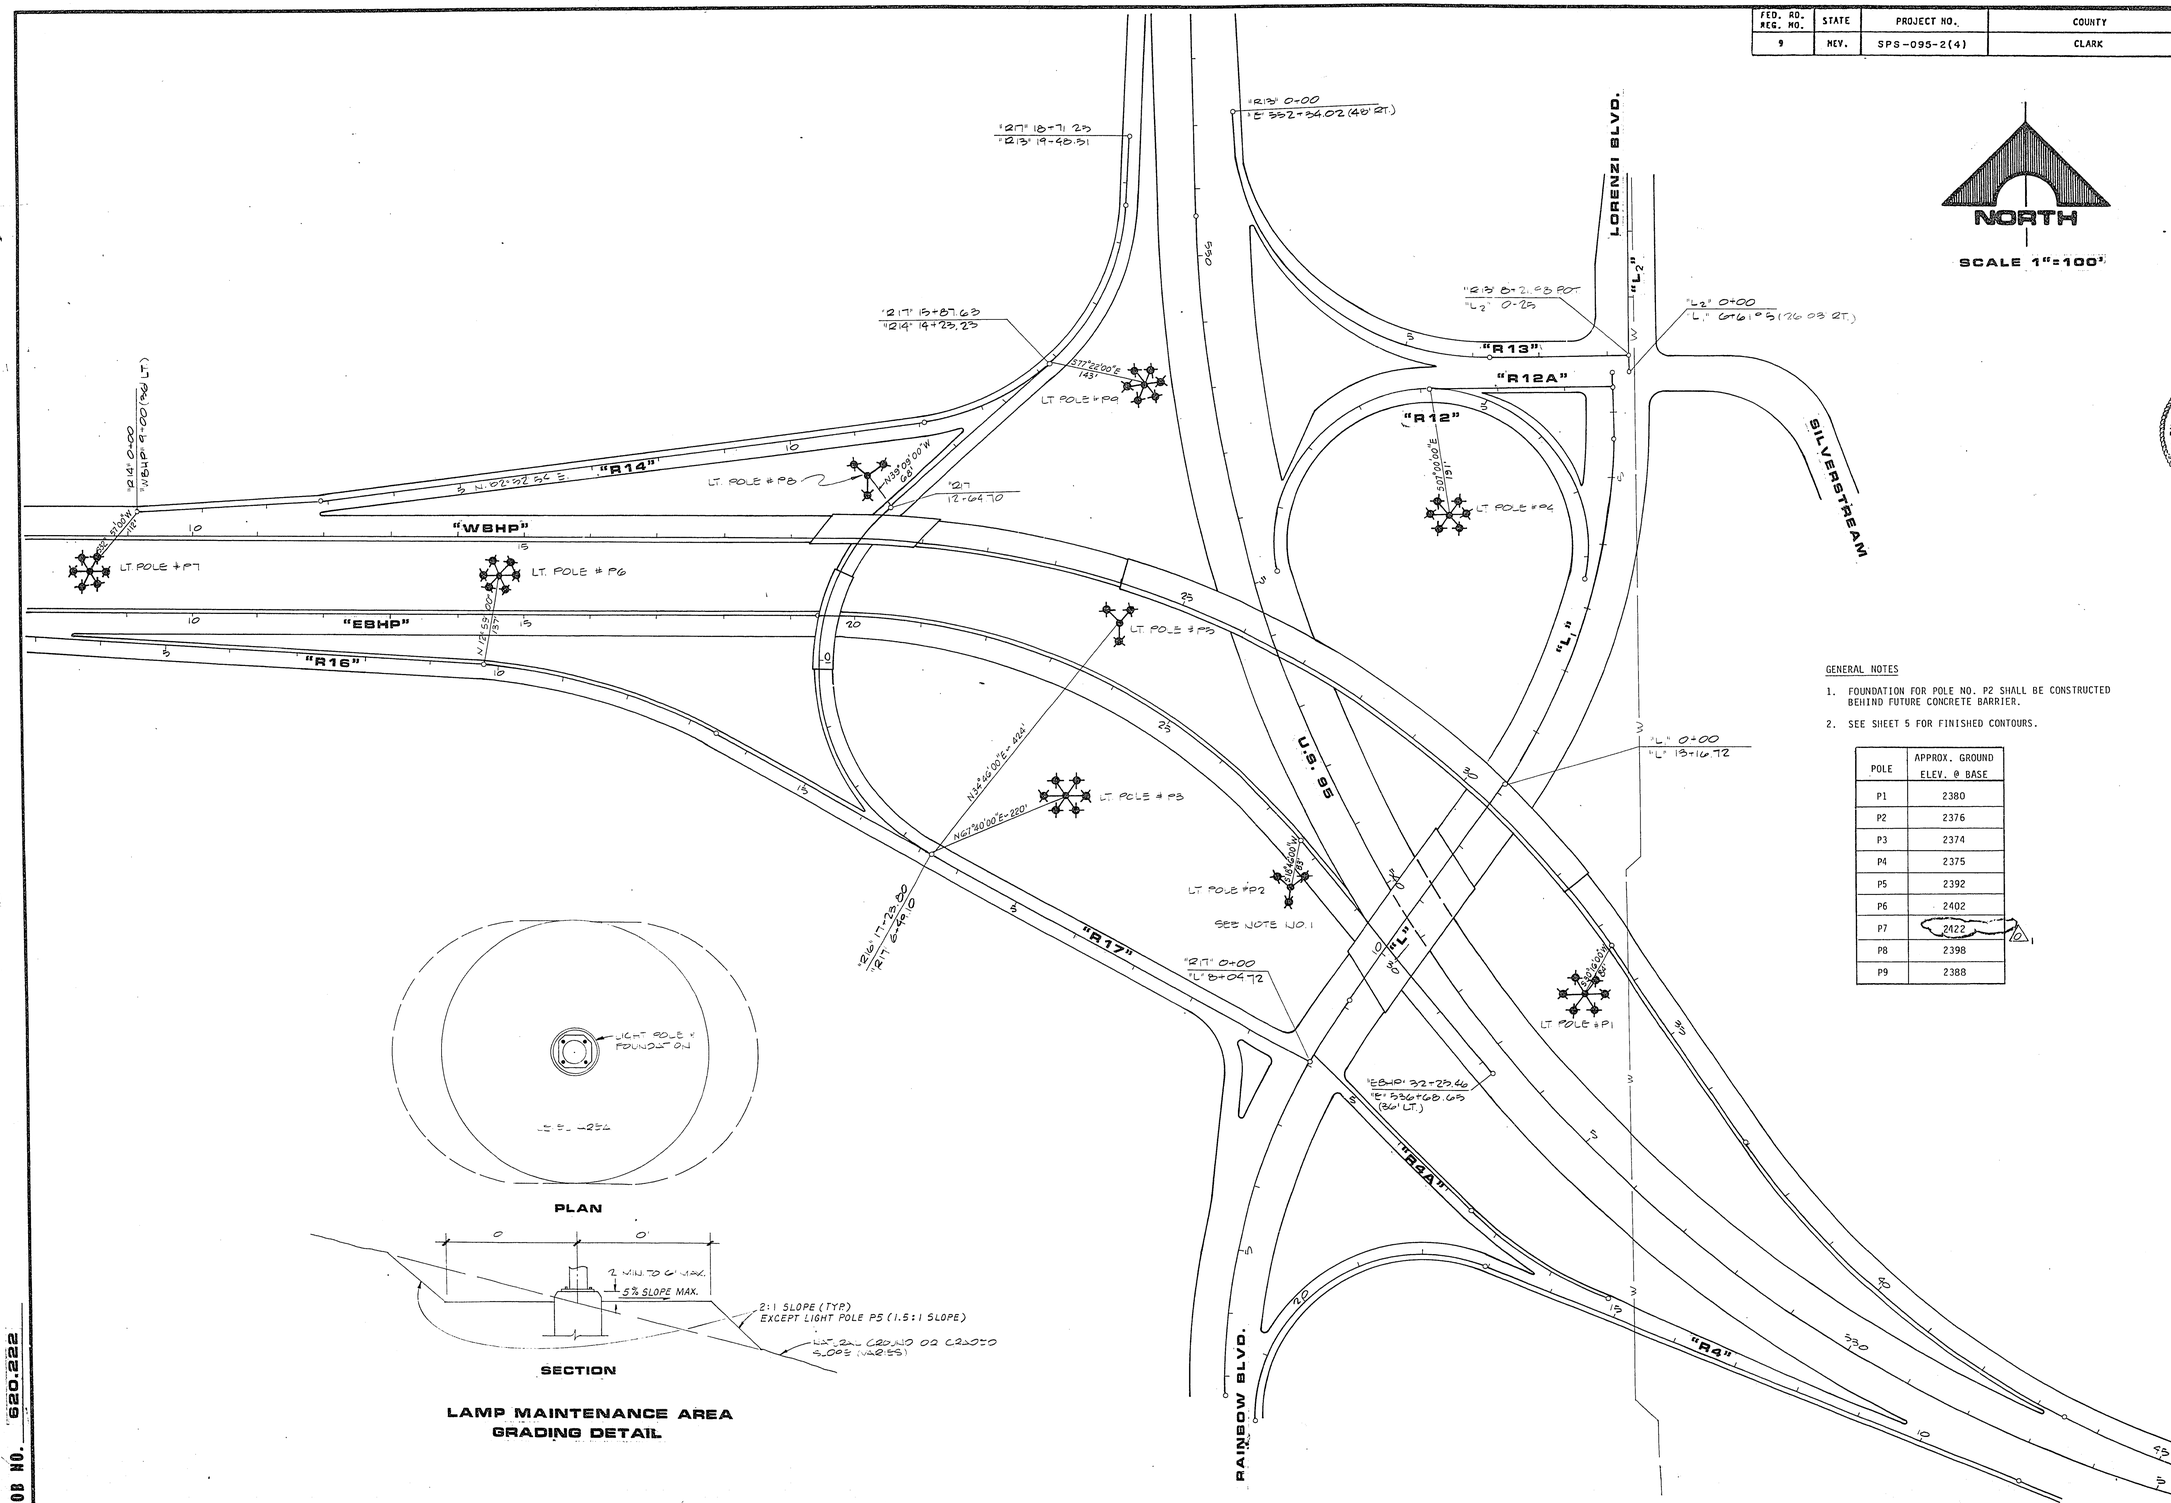

LAMP MAINTENANCE AREA
GRADING DETAIL

GENERAL NOTES

1. FOUNDATION FOR POLE NO. P2 SHALL BE CONSTRUCTED BEHIND FUTURE CONCRETE BARRIER.
2. SEE SHEET 5 FOR FINISHED CONTOURS.

POLE	APPROX. GROUND ELEV. @ BASE
P1	2380
P2	2376
P3	2374
P4	2375
P5	2392
P6	2402
P7	2422
P8	2398
P9	2388

REV	DATE	DESCRIPTION
1	8-14-81	ISSUE FOR GMP
2	2-1-86	ISSUE FOR CONSTRUCTION

RECOMMENDED FOR APPROVAL
JAMES A. GUDDLESTON
R.E. NO. 4878 DATE 8/6/87

REGISTERED PROFESSIONAL ENGINEER
JAMES A. GUDDLESTON
NEVADA

G.C. WALLACE, INC.
Engineering/Architecture
1555 SOUTH RAINBOW BLVD / LAS VEGAS, NEVADA 89102

HOWARD HUGHES PROPERTIES
HUSITE PARKWAY INTERCHANGE
HIGHWAY LIGHTING
LIGHT POLE LOCATIONS

SHEET 73
L-7
OF 138 SHEETS

JOB NO. 620.222

8/84 DIETERICH-POST 6532B

26-3-105 107-V1882