


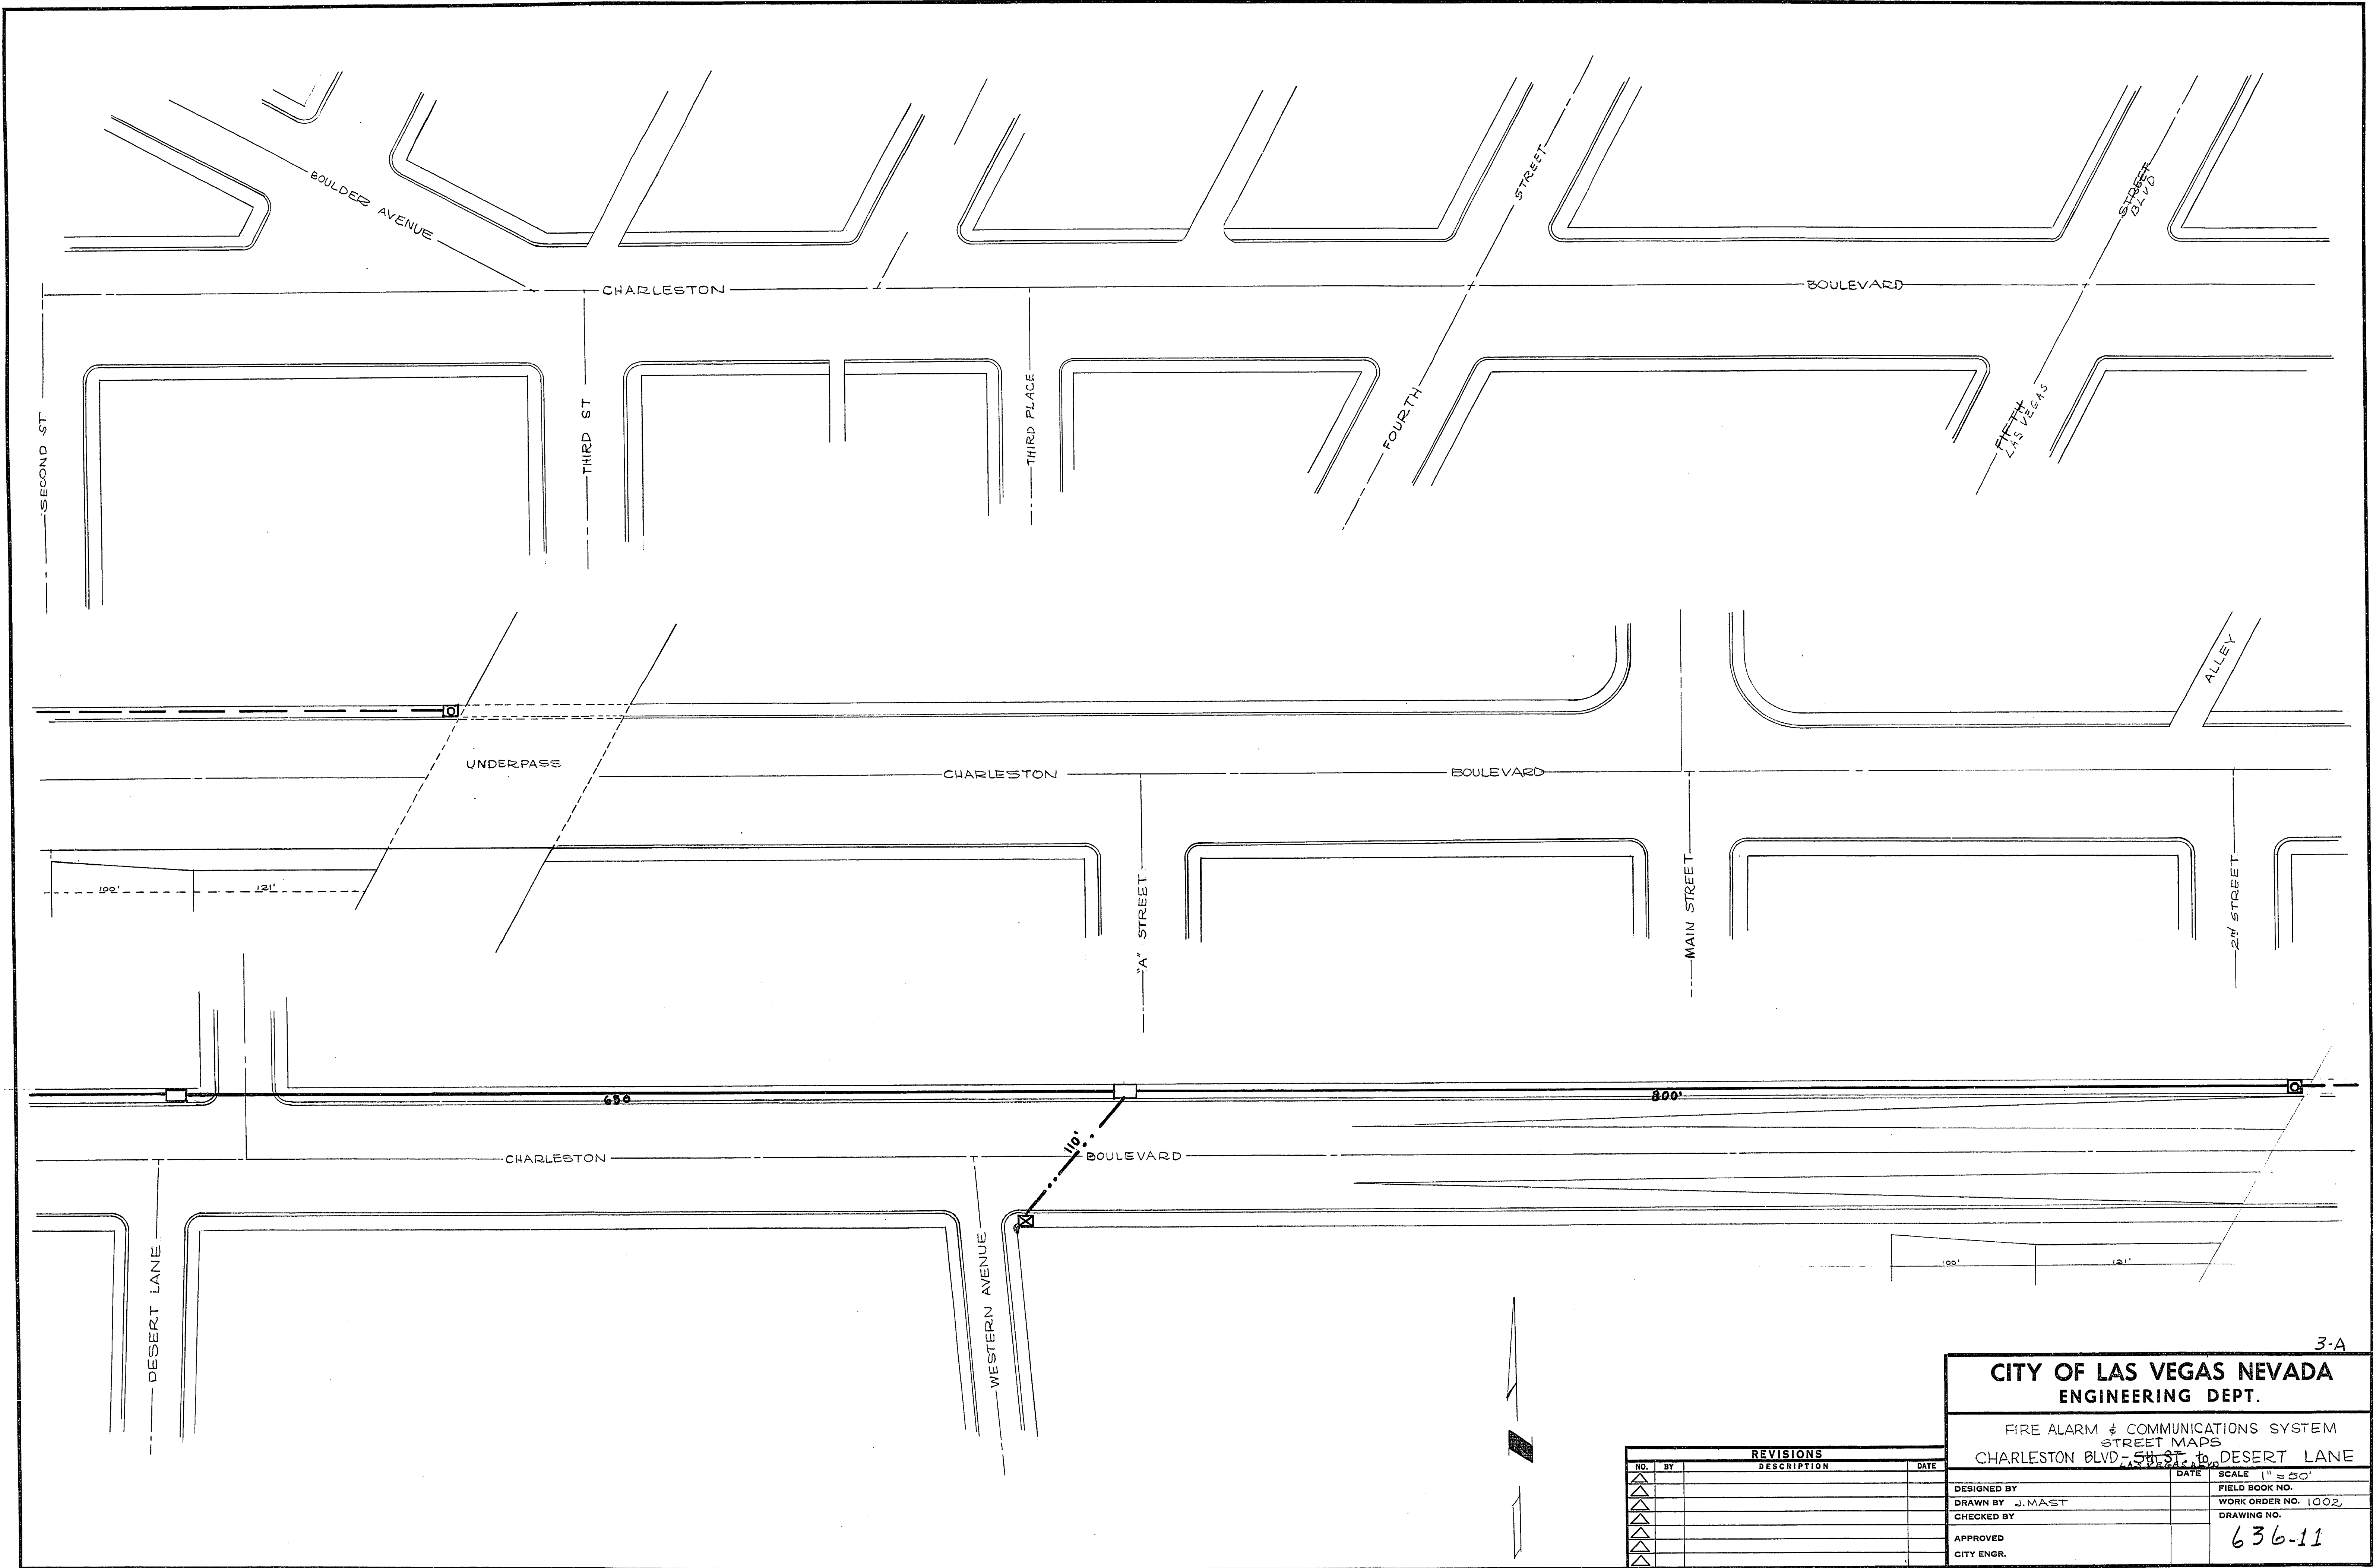

LIEZT 1110 TOPFLIGHT 500 11-53

REVISIONS		
NO.	BY	DESCRIPTION

CITY OF LAS VEGAS NEVADA ENGINEERING DEPT.	
FIRE ALARM & COMMUNICATIONS SYSTEM STREET MAPS CHARLESTON BLVD - 5th ST. to DESERT LANE	
DESIGNED BY	SCALE 1" = 50'
DRAWN BY J. MAST	FIELD BOOK NO.
CHECKED BY	WORK ORDER NO. 1002
APPROVED	DRAWING NO.
CITY ENGR.	636-11

4-44