


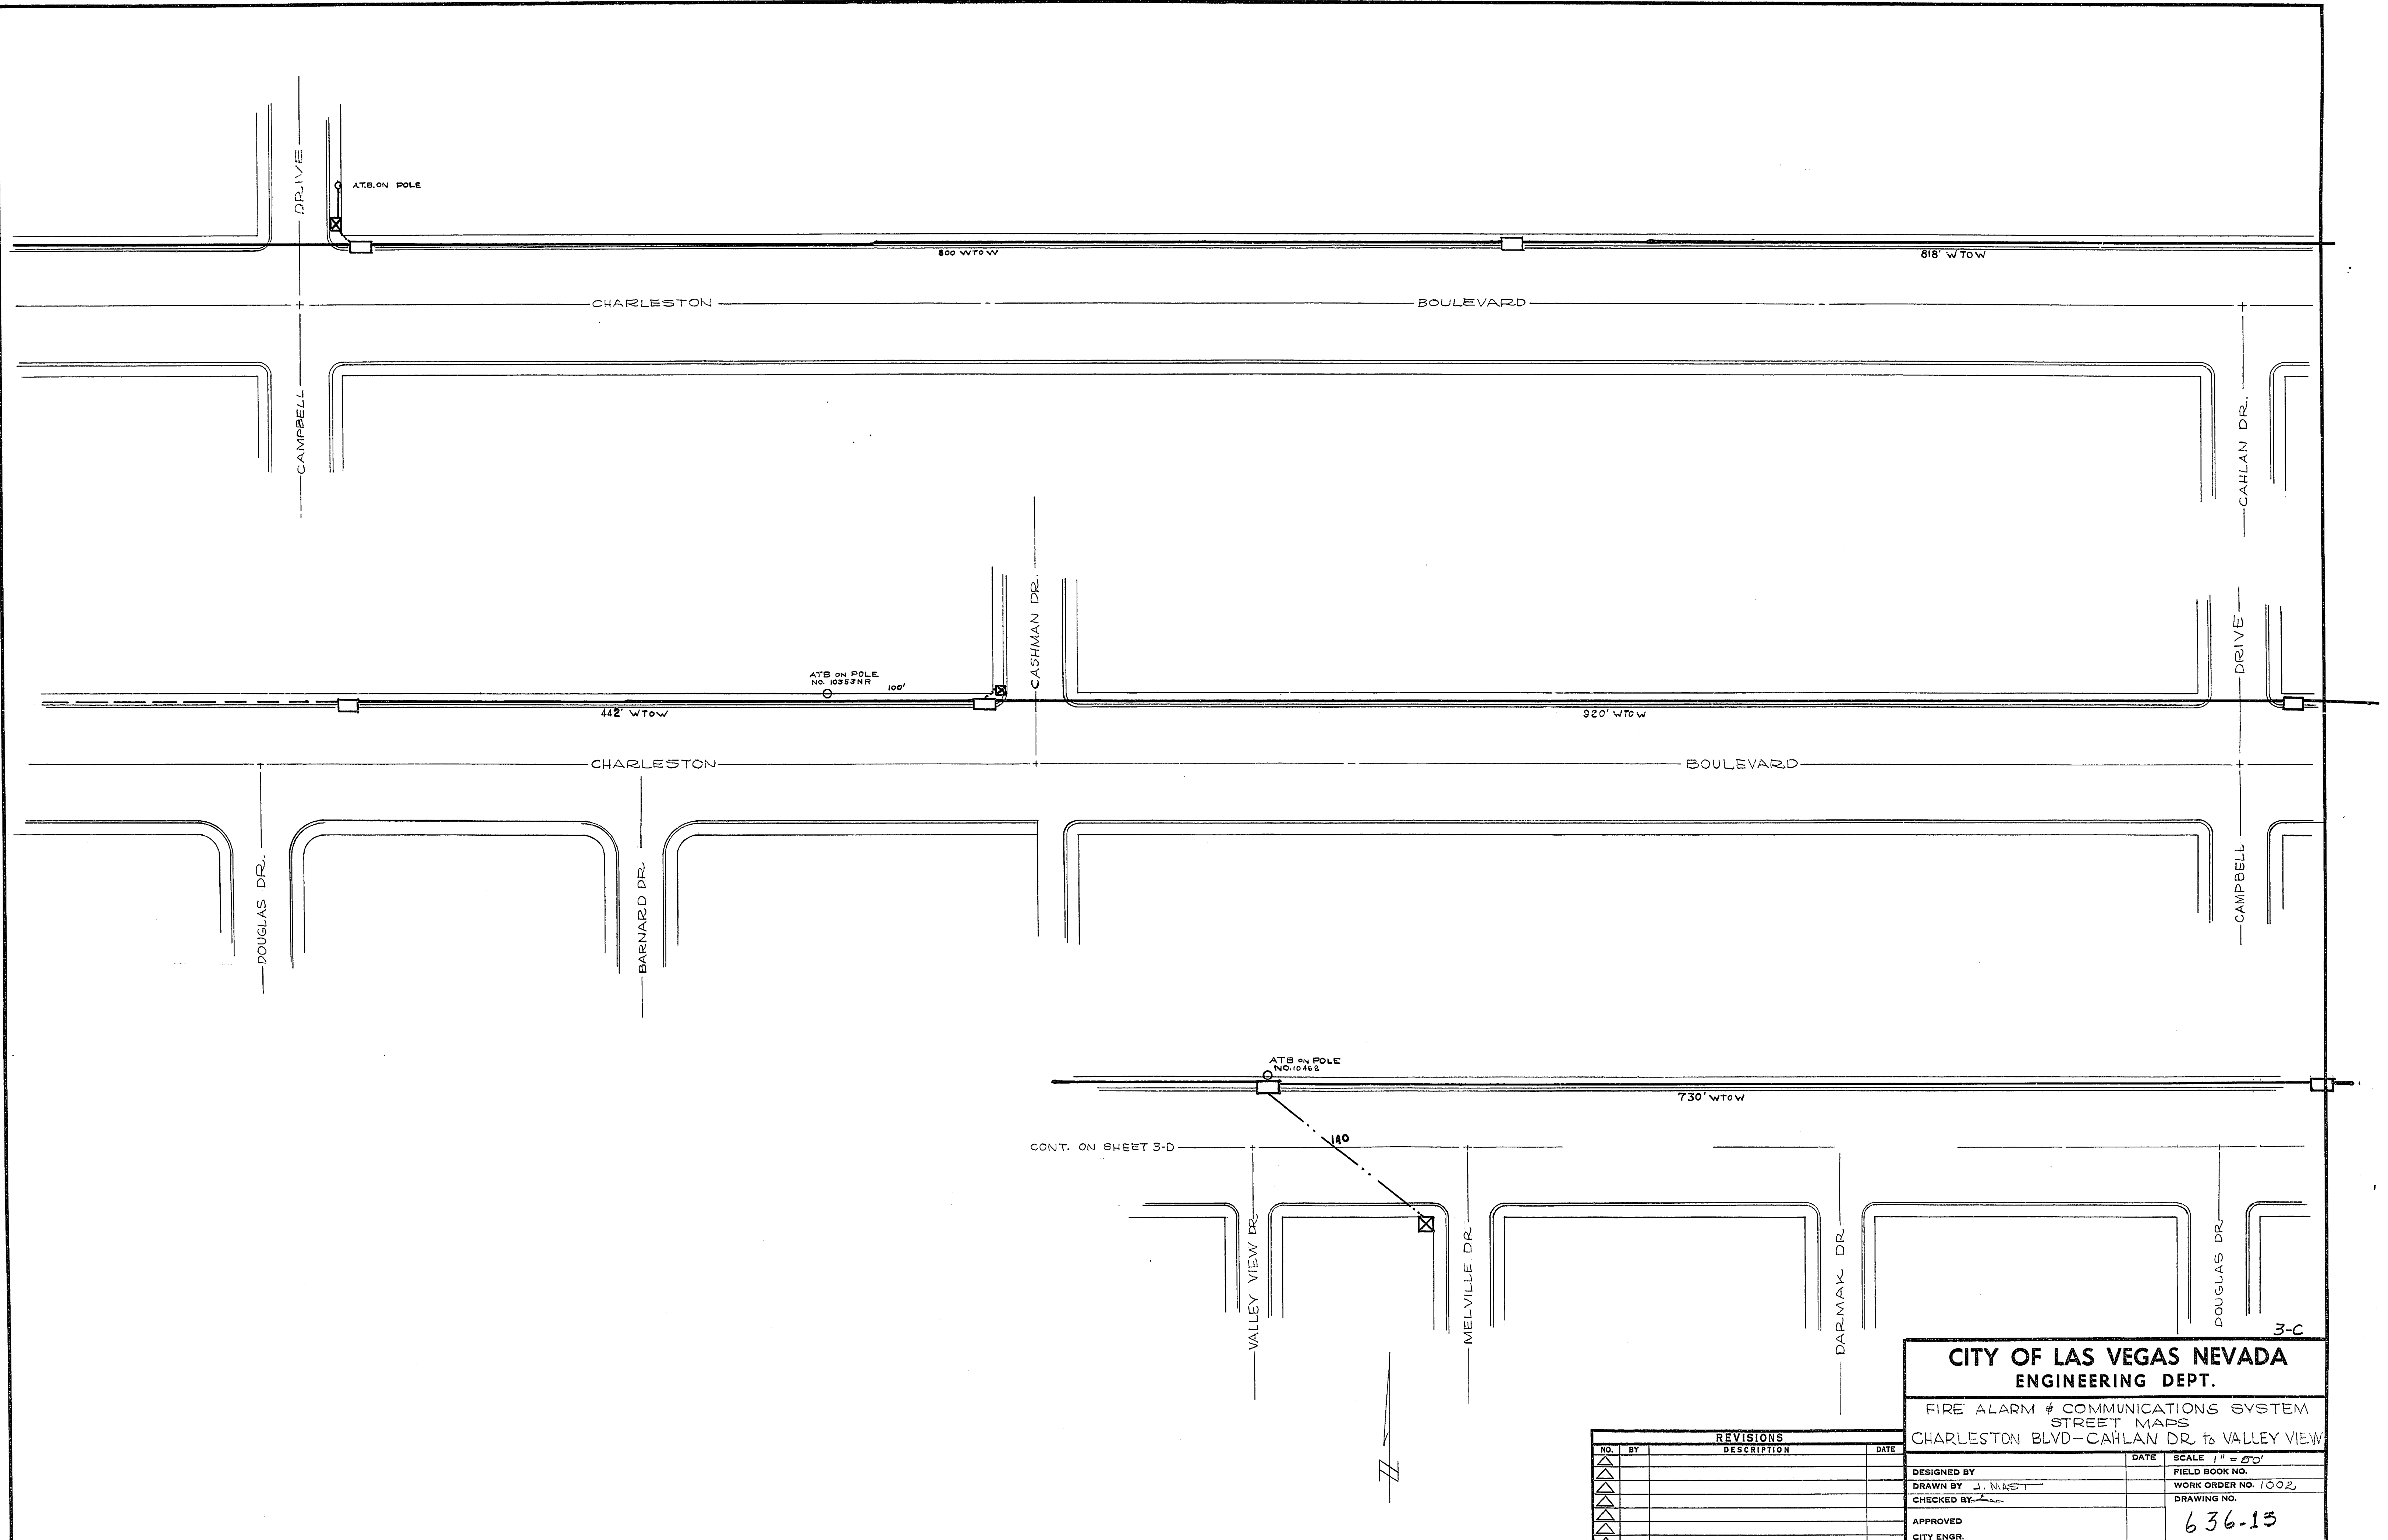

REVISIONS		
NO.	BY	DESCRIPTION

CITY OF LAS VEGAS NEVADA ENGINEERING DEPT.	
FIRE ALARM & COMMUNICATIONS SYSTEM STREET MAPS CHARLESTON BLVD-CARLAN DR to VALLEY VIEW	
DESIGNED BY	DATE
DRAWN BY J. MAST	SCALE 1" = 50'
CHECKED BY	FIELD BOOK NO.
APPROVED	WORK ORDER NO. 1002
CITY ENGR.	DRAWING NO.
	636-13

1-42