


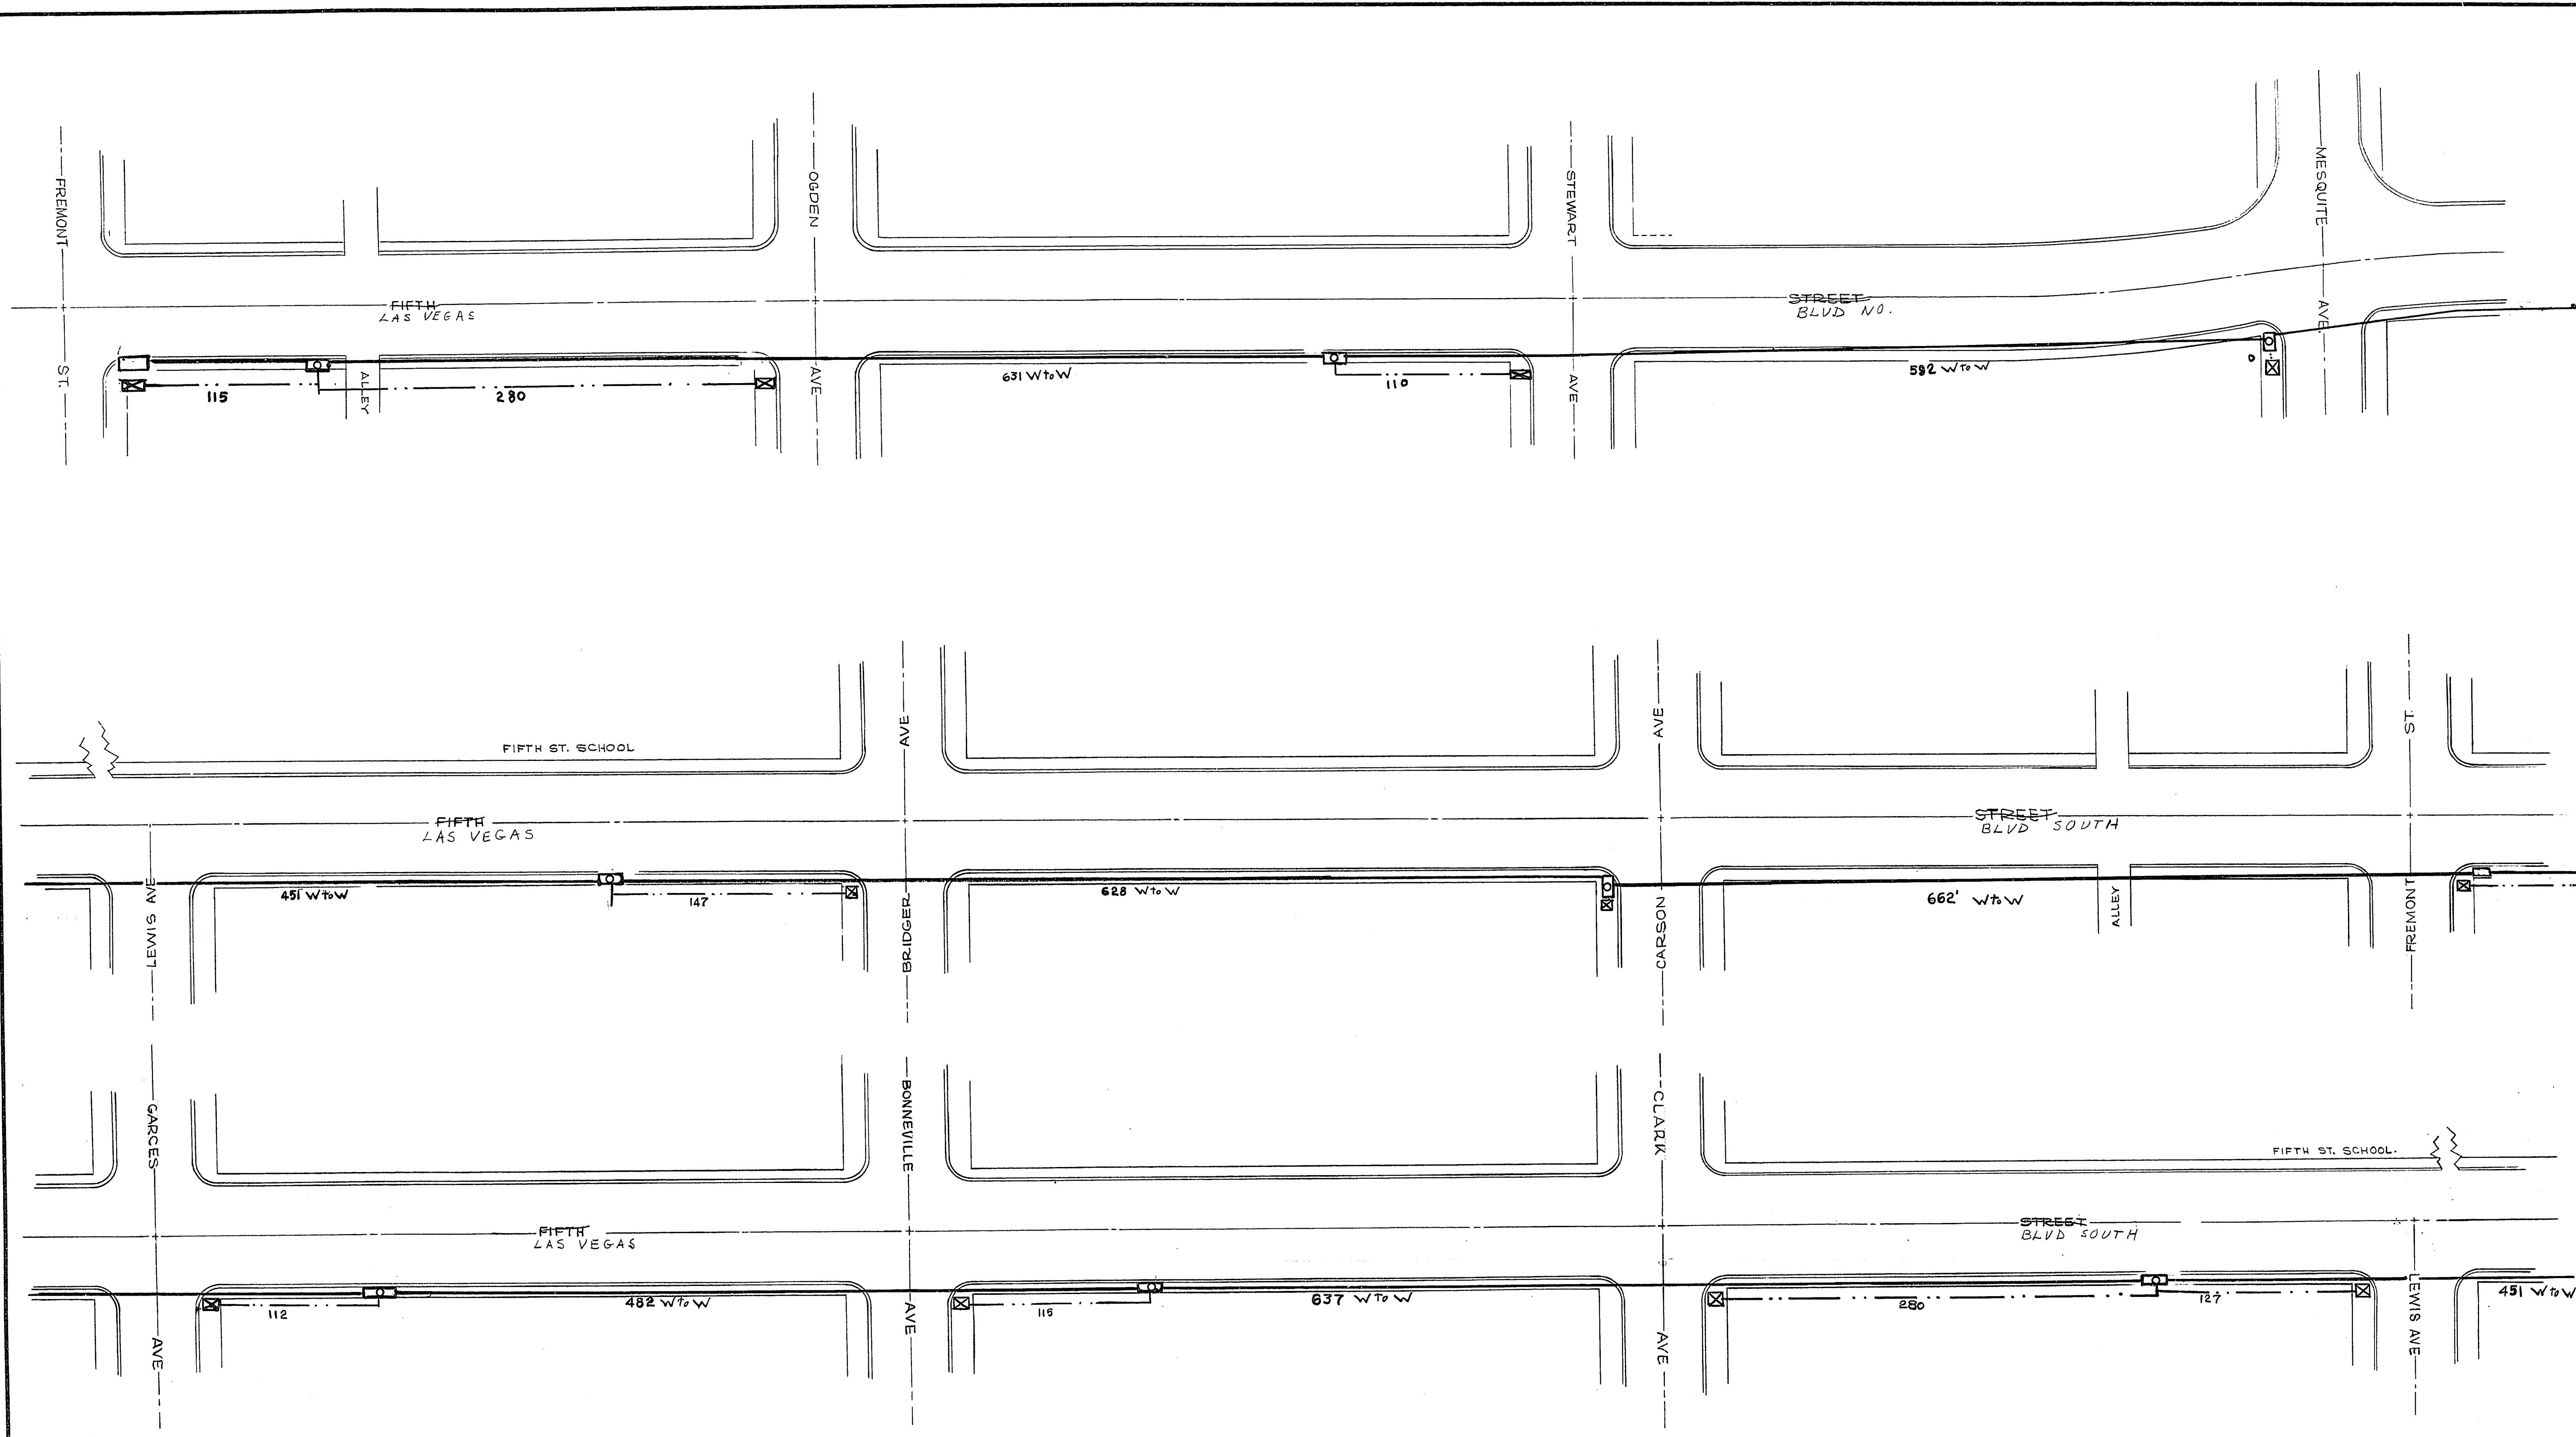

2-A

CITY OF LAS VEGAS NEVADA
ENGINEERING DEPT.

FIRE ALARM & COMMUNICATIONS SYSTEM
STREET MAP
FIFTH ST. - MESQUITE TO GARCES

DESIGNED BY	DATE	SCALE 1" = 50'
DRAWN BY J. MAST		FIELD BOOK NO.
CHECKED BY		WORK ORDER NO. 1002
APPROVED		DRAWING NO.
CITY ENGR.		636-4

REVISIONS		
NO.	BY	DESCRIPTION