


GLENVIEW MEADOWS I

A SUBDIVISION AS SHOWN IN
BOOK 31 PAGE 90
OF PLATS
CLARK COUNTY, NEV RECORDS

SCALE


1" = 20'

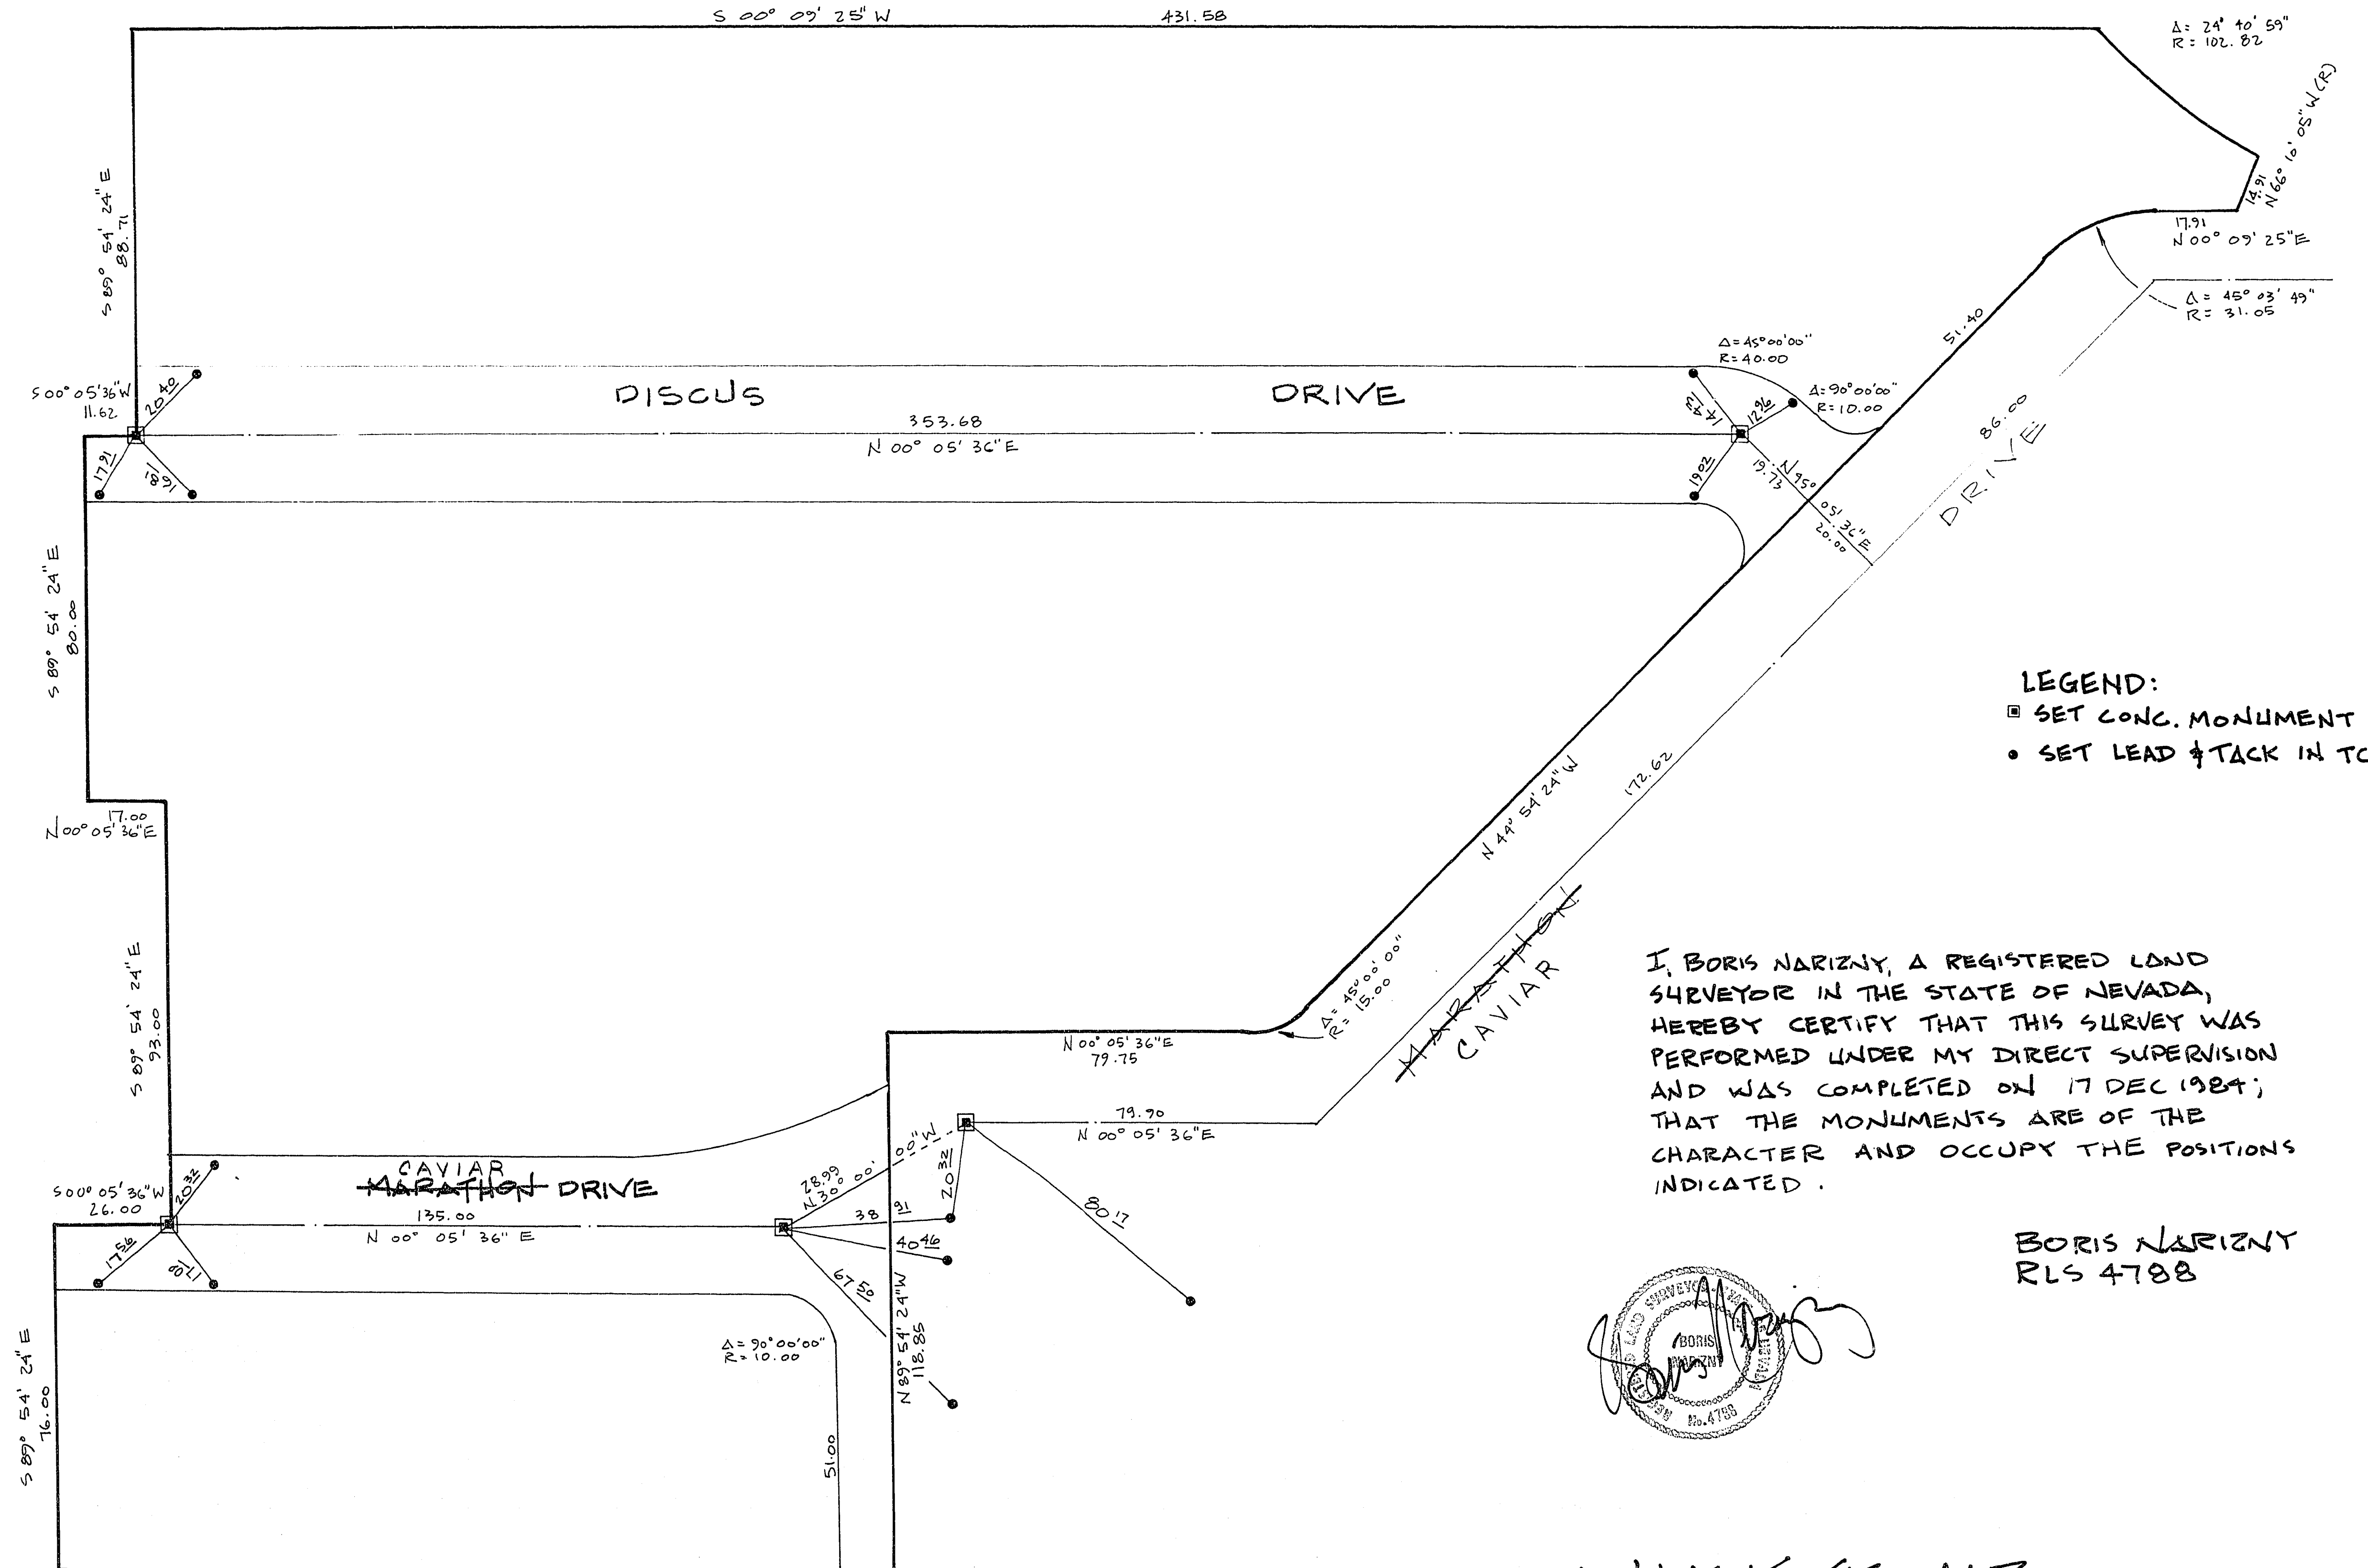

LEGEND:
■ SET CONC. MONUMENT
• SET LEAD & TACK IN TC

I, BORIS NARIZNY, A REGISTERED LAND SURVEYOR IN THE STATE OF NEVADA, HEREBY CERTIFY THAT THIS SURVEY WAS PERFORMED UNDER MY DIRECT SUPERVISION AND WAS COMPLETED ON 17 DEC 1984; THAT THE MONUMENTS ARE OF THE CHARACTER AND OCCUPY THE POSITIONS INDICATED.

BORIS NARIZNY
RLS 4788

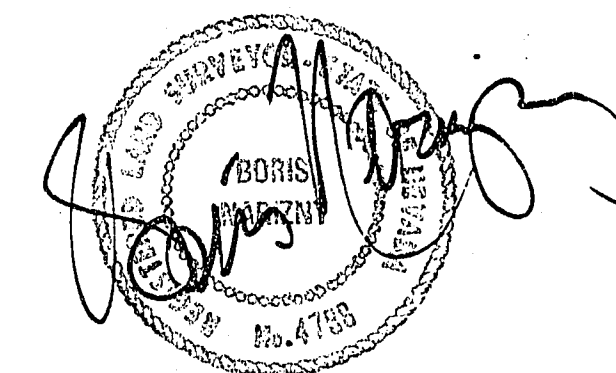

MONUMENT TIE MAP

ACES ENGR 362-2850 LAS VEGAS, NEV.

4-6-61

058-1542-1