

HOMESTEAD ESTATES - UNIT NO. 2

MONUMENT TIE MAP

SURVEYOR'S CERTIFICATE
I, JERRY E. BARNSON, A REGISTERED LAND SURVEYOR, DO HEREBY CERTIFY THAT THE MONUMENTS HAVE BEEN SET AND THE TIES ESTABLISHED AS SHOWN HEREON.


JERRY E. BARNSON
REG. LAND SURVEYOR
NEV. CERT. NO. 4046

DATE

CURVE NO.	Δ	R	L	T
1	90°51'48"	15.00	2379	15.23
2	89°08'12"	15.00	2334	14.78
3	90°51'48"	15.00	2379	15.23
4	36°52'13"	25.00	1609	8.33
9	16°53'45"	25.00	737	3.71
10	19°58'28"	25.00	872	4.40
11	161°28'13"	70.00	197.27	429.12
12	87°43'47"	25.00	3828	24.03
13	90°00'00"	15.00	2356	15.00
14	94°07'19"	20.00	3286	21.49
15	85°52'41"	20.00	2998	18.61

LEGEND

- 4 Lot Number
- ② Block Number
- ⑥ Curve Number
- Set Brass Cap In Conc Mon. R.L.S. 4046
- Found Mon. as indicated
- Building Setback Line
- 15' Side
- 50' Front
- Set 3/8" rebar 741 cap, R.L.S. 4046
- SET LEAD IN BRASS NAIL IN TC, R.L.S. 4046

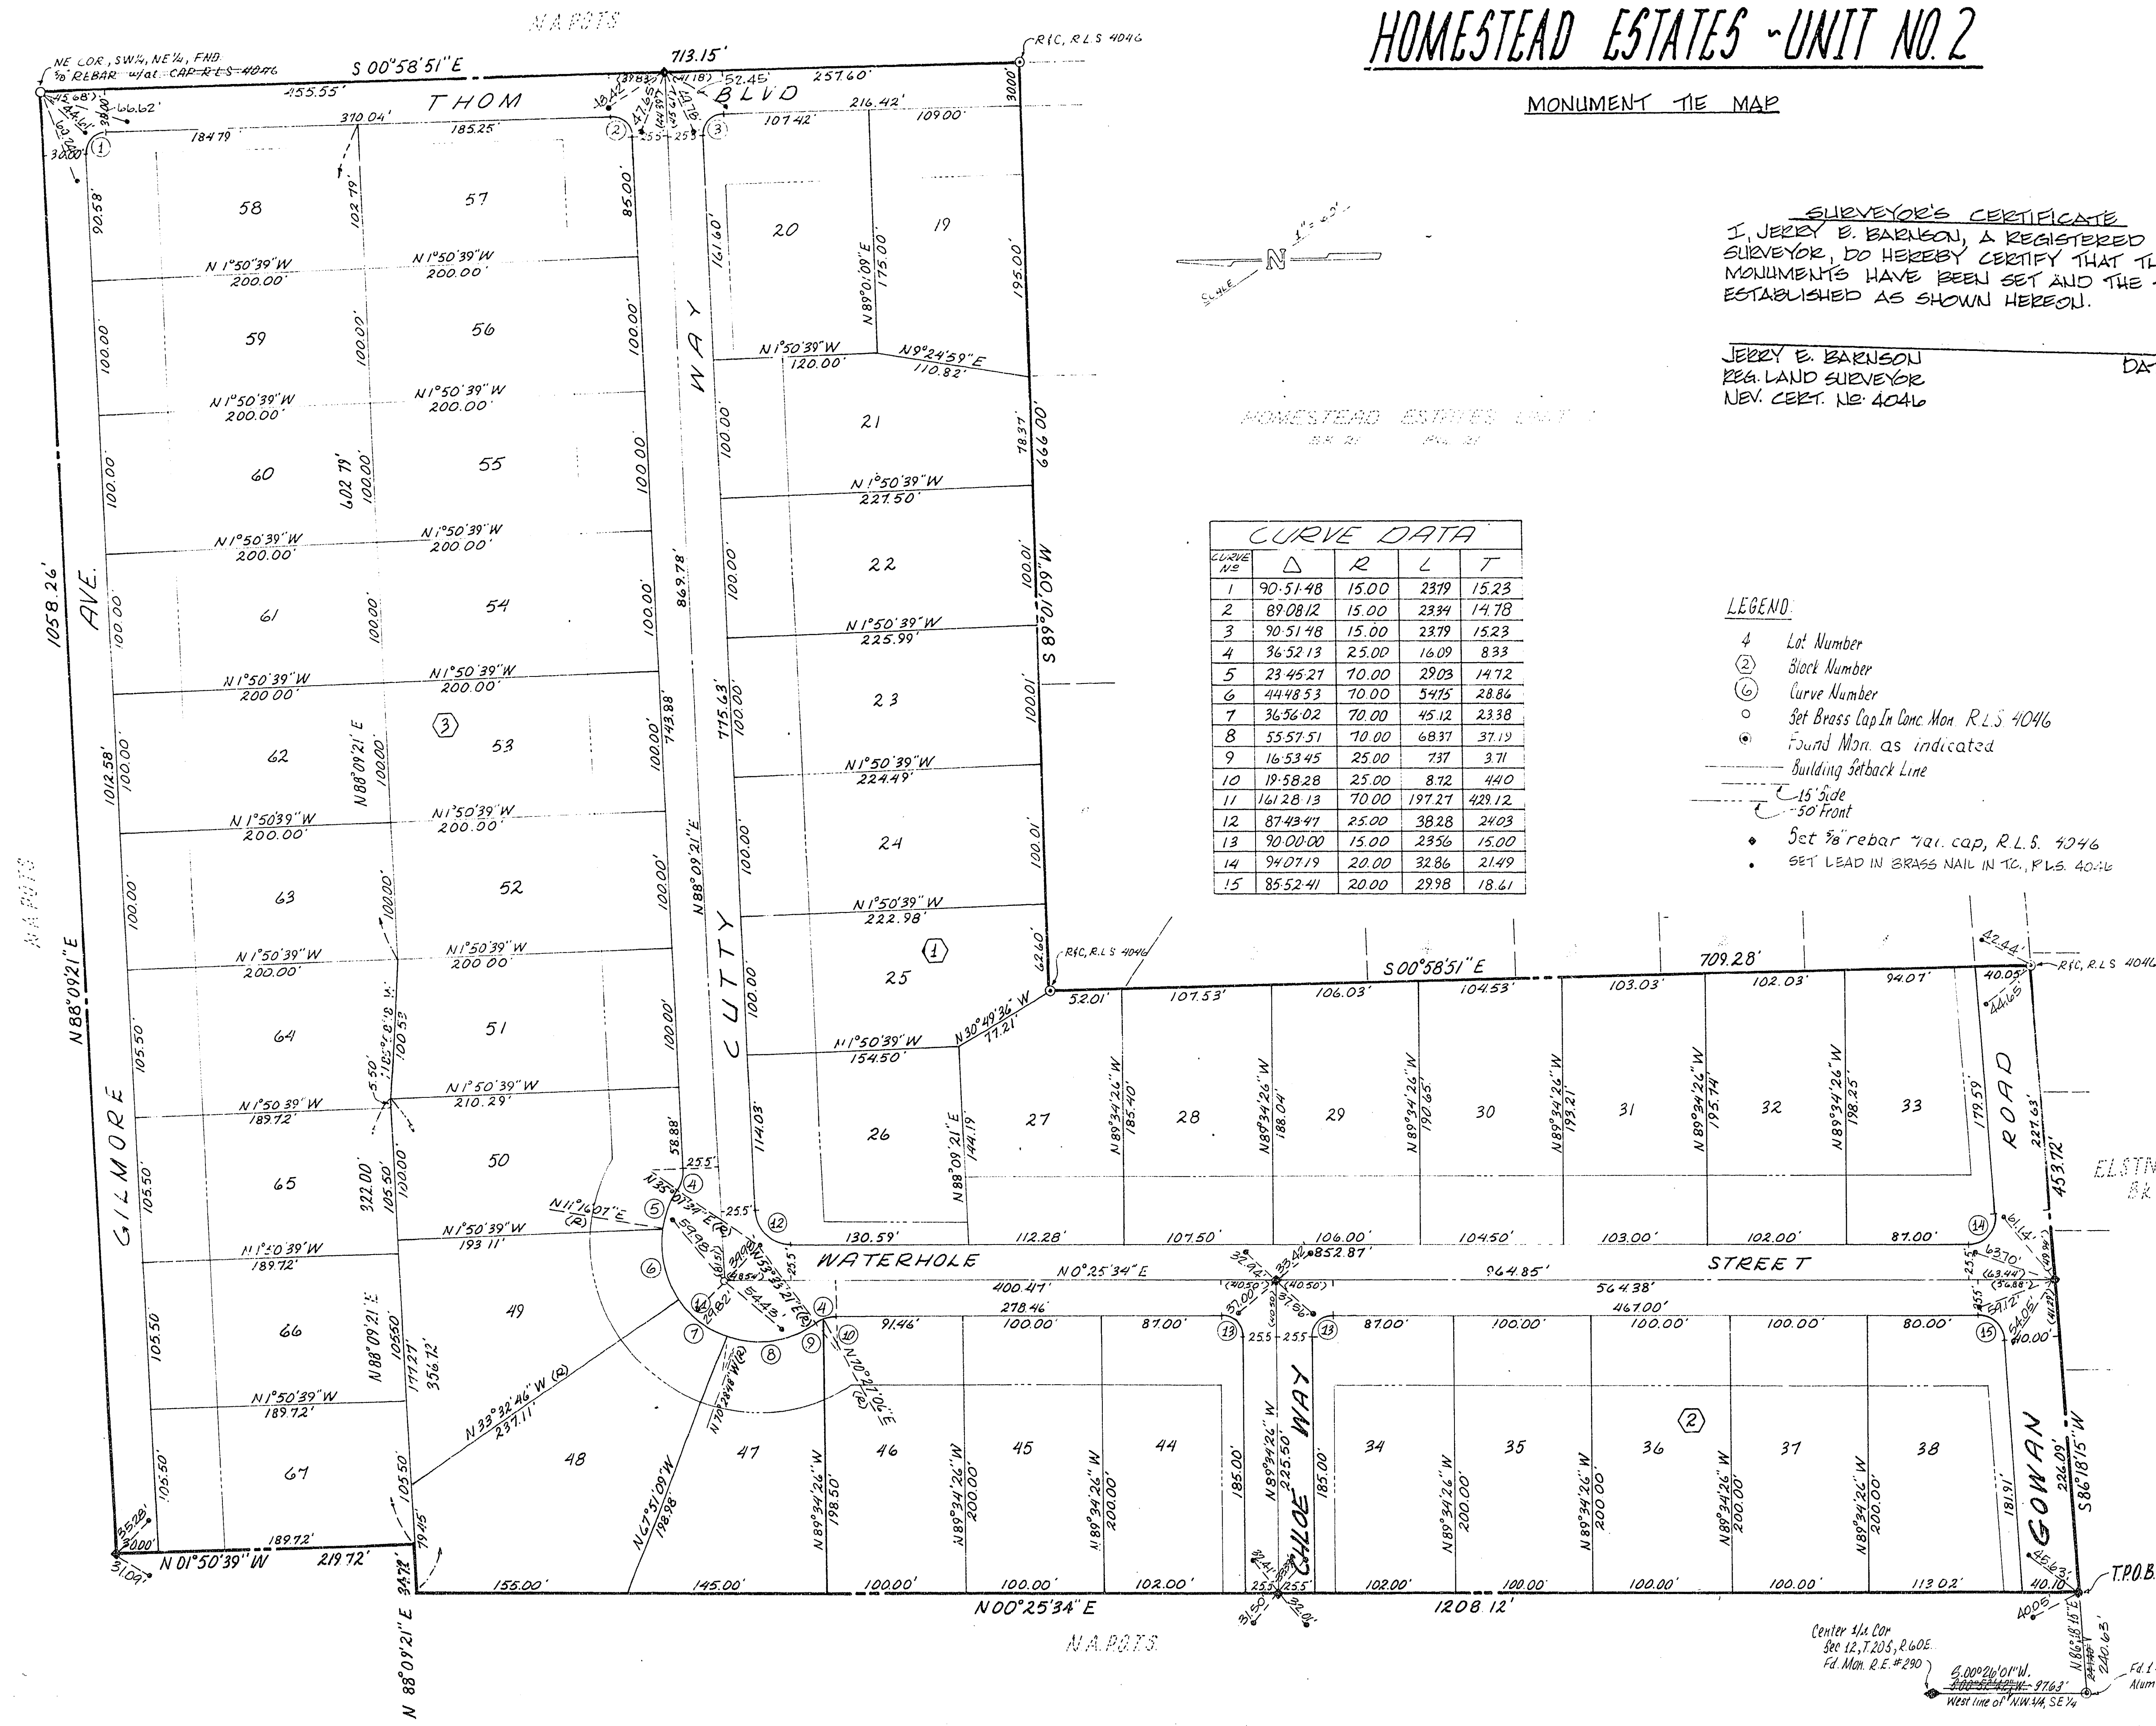

ELSTNER ESTATES
Bk 3 Pg 86

Center 1/4 Cor.
Sec 12, T20S, R60E.
Pd. Mon. R.E. #290
6.000' 26.01' W.
West line of NW 1/4, SE 1/4
Pd. 1 1/2" I.P. w/
Alum Plate - R.E. #361

SHEET 2 OF 2

4-6-36

058-18250