



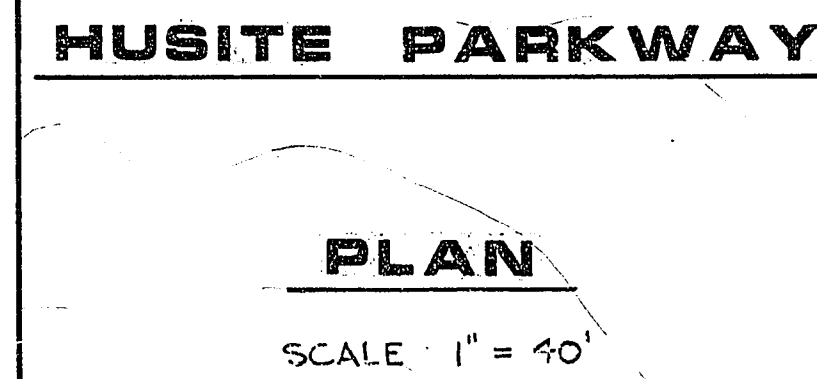

CURVE DATA				
NO	Δ	R	L	T
4	209°00'00"	2,443.32	131.15'	842.81'
5	27°49'10"	3,000.00'	187.12'	969.02'
6	107°08'00"	2,756.68'	140.70'	716.35'

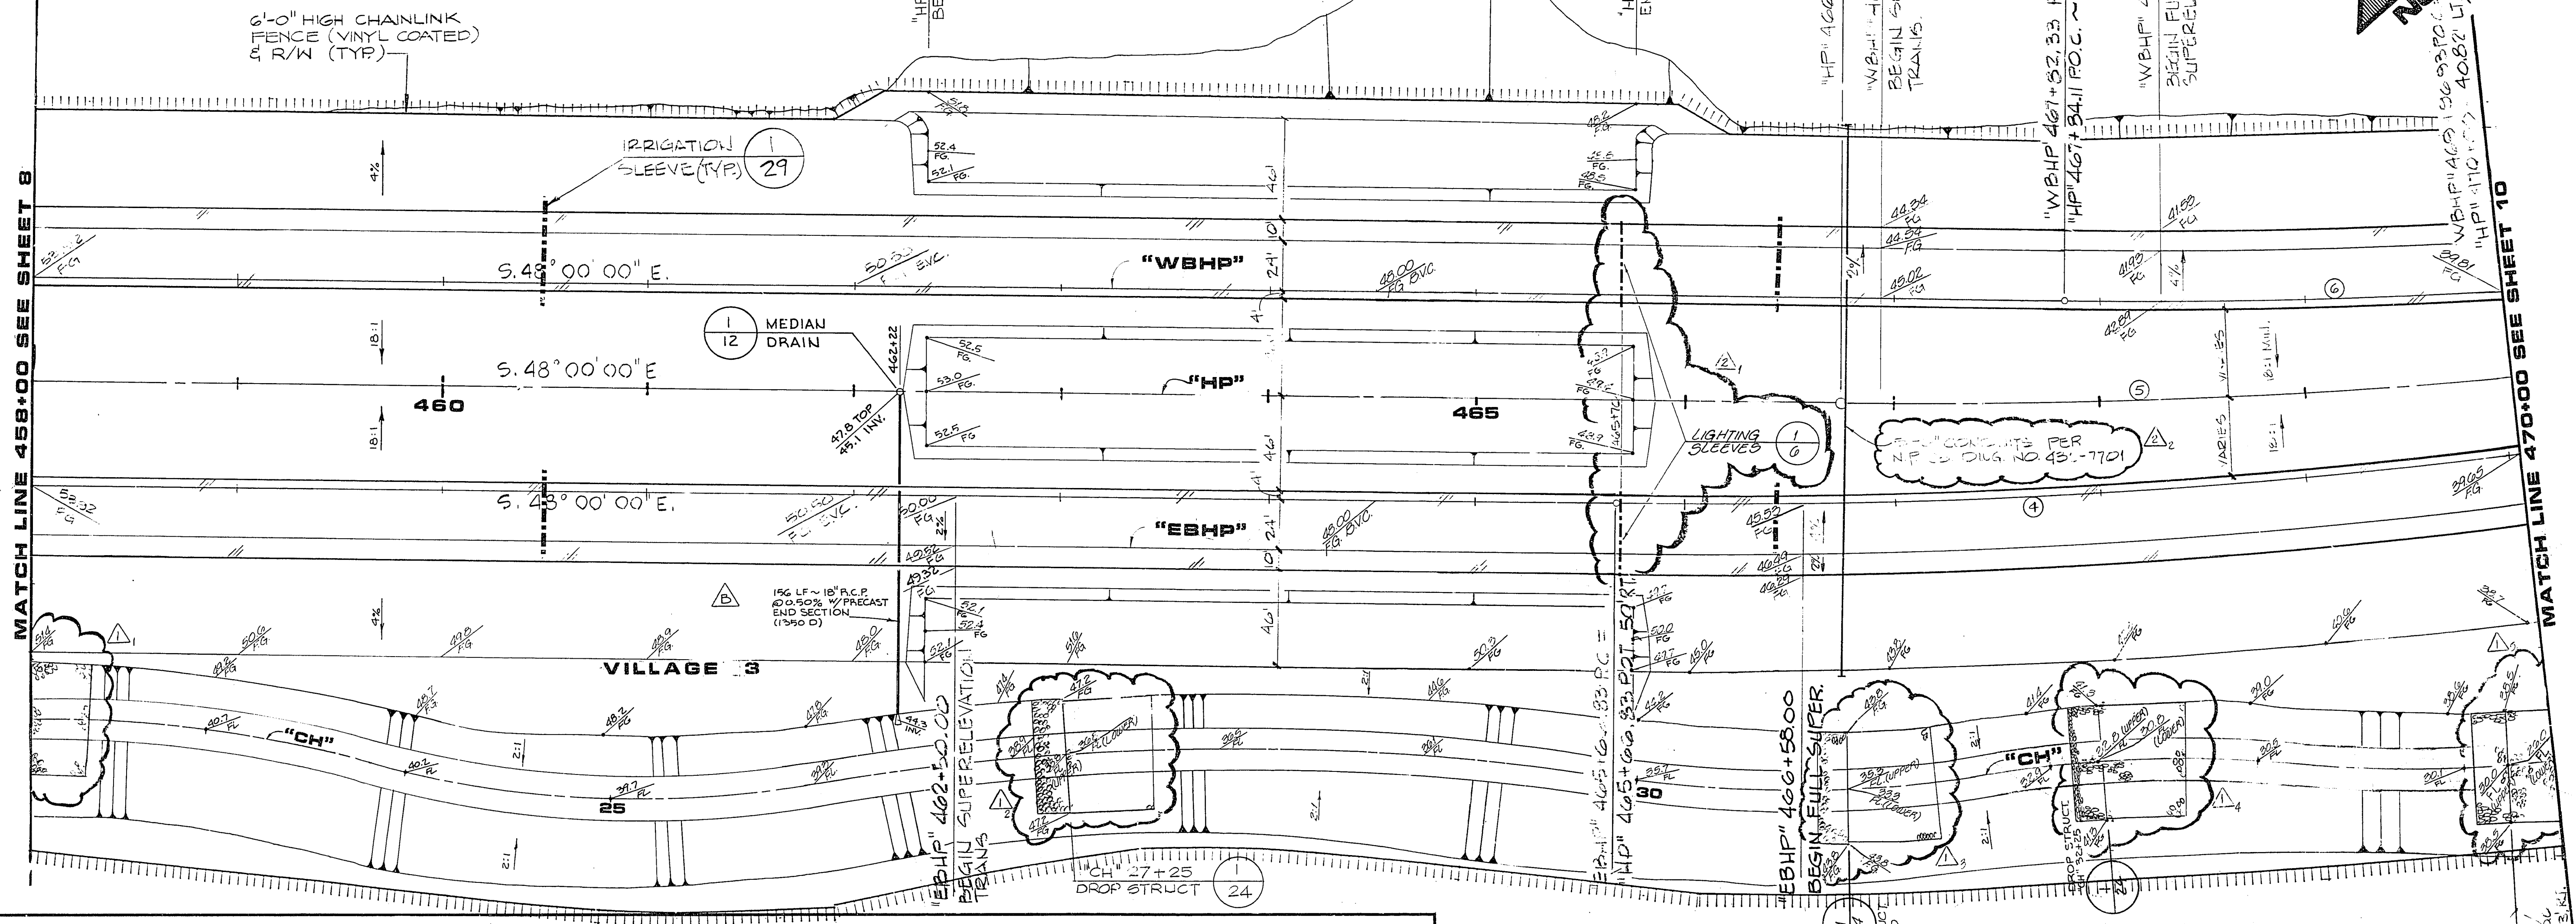

 G.C. WALLACE, INC. Engineering/Architecture 1555 SOUTH RAINBOW BLVD./LAS VEGAS, NEVADA 89102	HOWARD HUGHES PROPERTIES HUSITE PARKWAY PLAN & PROFILE STA. 458+00 TO STA. 470+00		RECOMMENDED 5638 11/10/88 R.E. NO. 7 DATE GRAIG, FRANK	<table border="1"> <thead> <tr> <th>REV</th> <th>DATE</th> <th>DESCRIPTION</th> </tr> </thead> <tbody> <tr> <td>1</td> <td>11/16/87</td> <td>ISSUED FOR GMP</td> </tr> <tr> <td>2</td> <td>11/25/87</td> <td>ISSUED PER ADDENDUM NO. 1</td> </tr> <tr> <td>3</td> <td>01/21/88</td> <td>ISSUED FOR SETBACK</td> </tr> <tr> <td>4</td> <td>01/21/88</td> <td>ISSUED FOR SETBACK LETTER</td> </tr> <tr> <td>5</td> <td>01/21/88</td> <td>ISSUED PER GMP LETTER</td> </tr>
