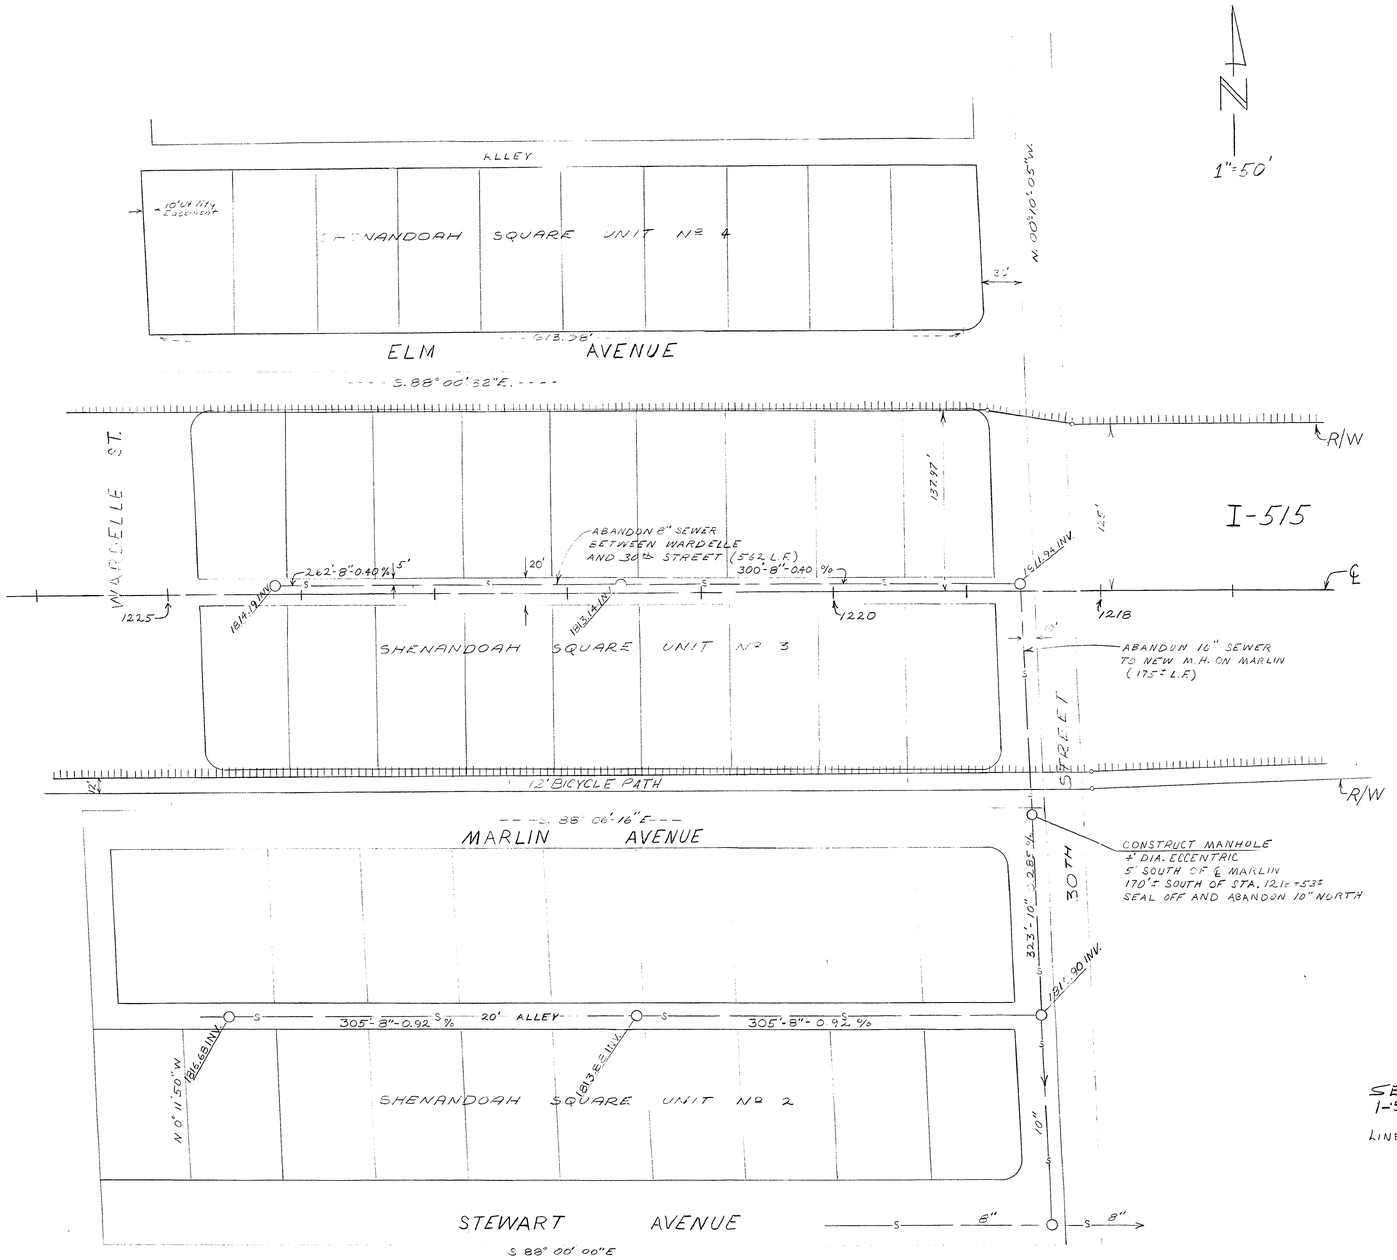

1"=50'

SEE STATE HWY DWG
I-515 - BOOK 2 - Sheet 9

LINE ABANDONED AND NEW M.H. PLACED

J.H. Ellison
Aug 82

Revisions	Date

Scale (h) 1"=50'	Scale (v) —	W.O. no.	
Fld. bk. no.	Date 6-10-81		
Design by Eugene Hunt	Drawn by Eugene Hunt		
Approved by the Director of Public Services	Date		

Department of Public Services — Engineering Design Division

SEWER MODIFICATION
30TH STREET

I-515
CHARLESTON TO EASTERN

CITY OF LAS VEGAS — DEPARTMENT OF PUBLIC WORKS

Drawing no. 307-546 — 2/2

21-1-65