



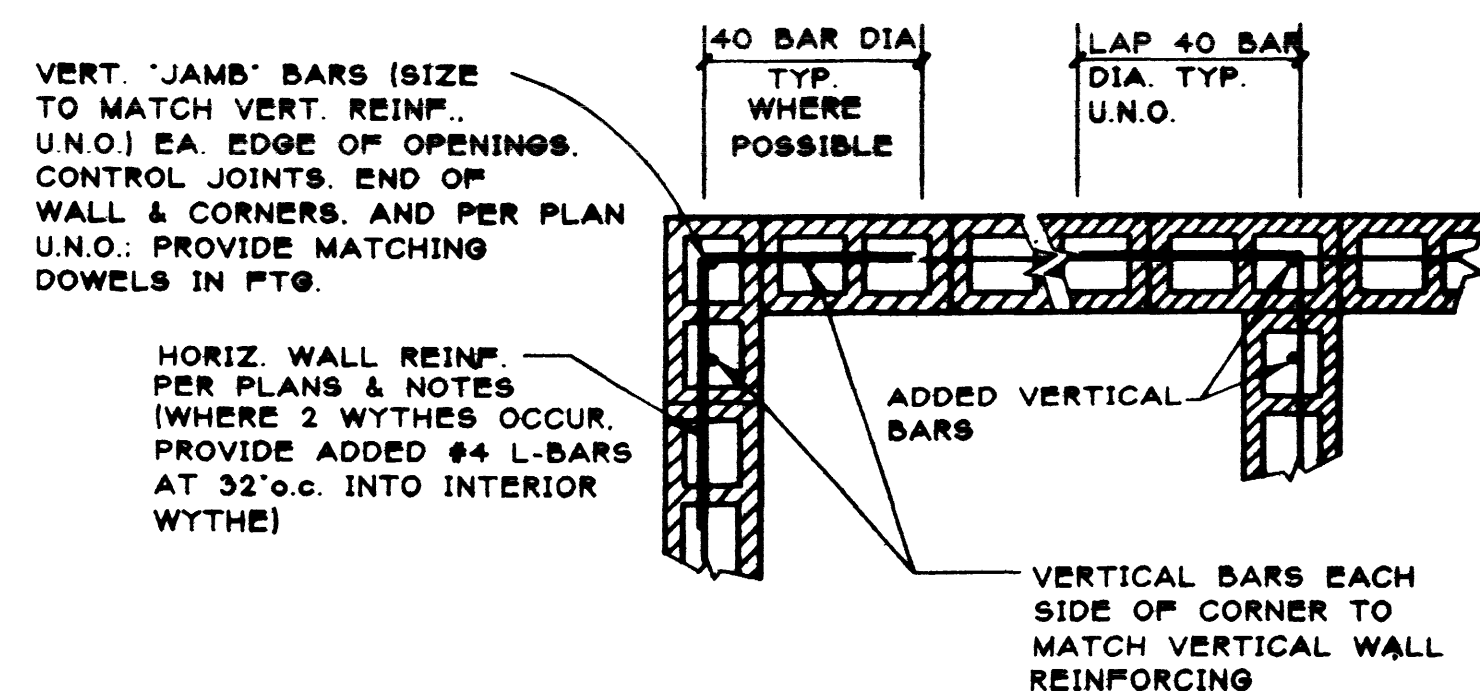


NOTE: MIN. CLEARANCE OF REINF. TO INSIDE FACE OF CMU SHALL BE 1/2".

Typical Masonry Wall Reinforcing Placement Single Curtain
N.T.S.

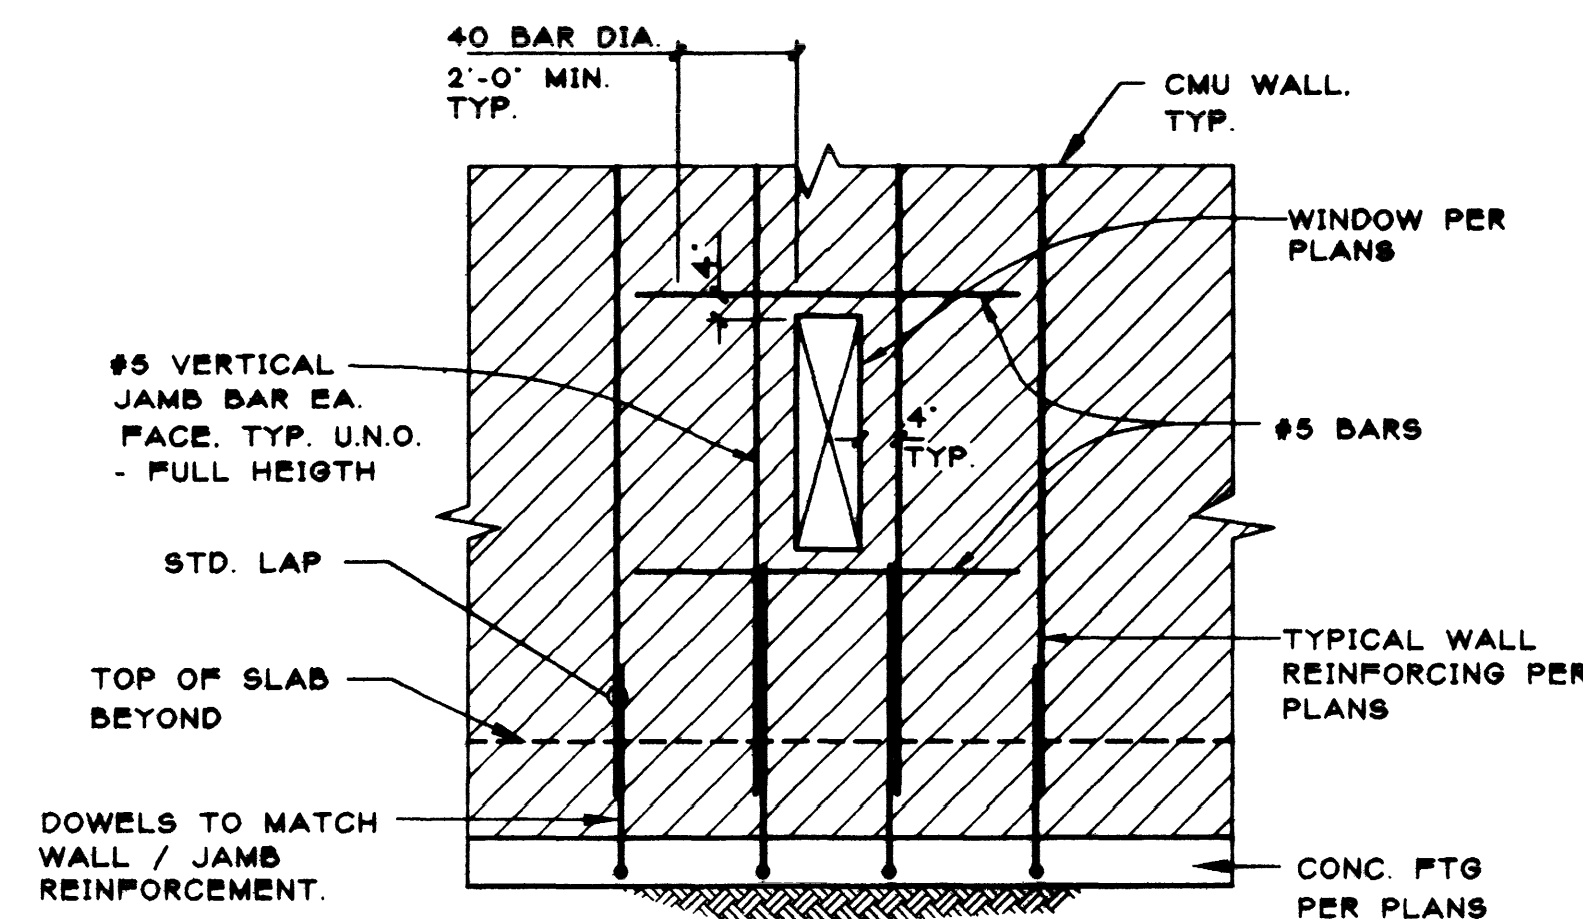



Typical Wall Louver Opening Detail
N.T.S.

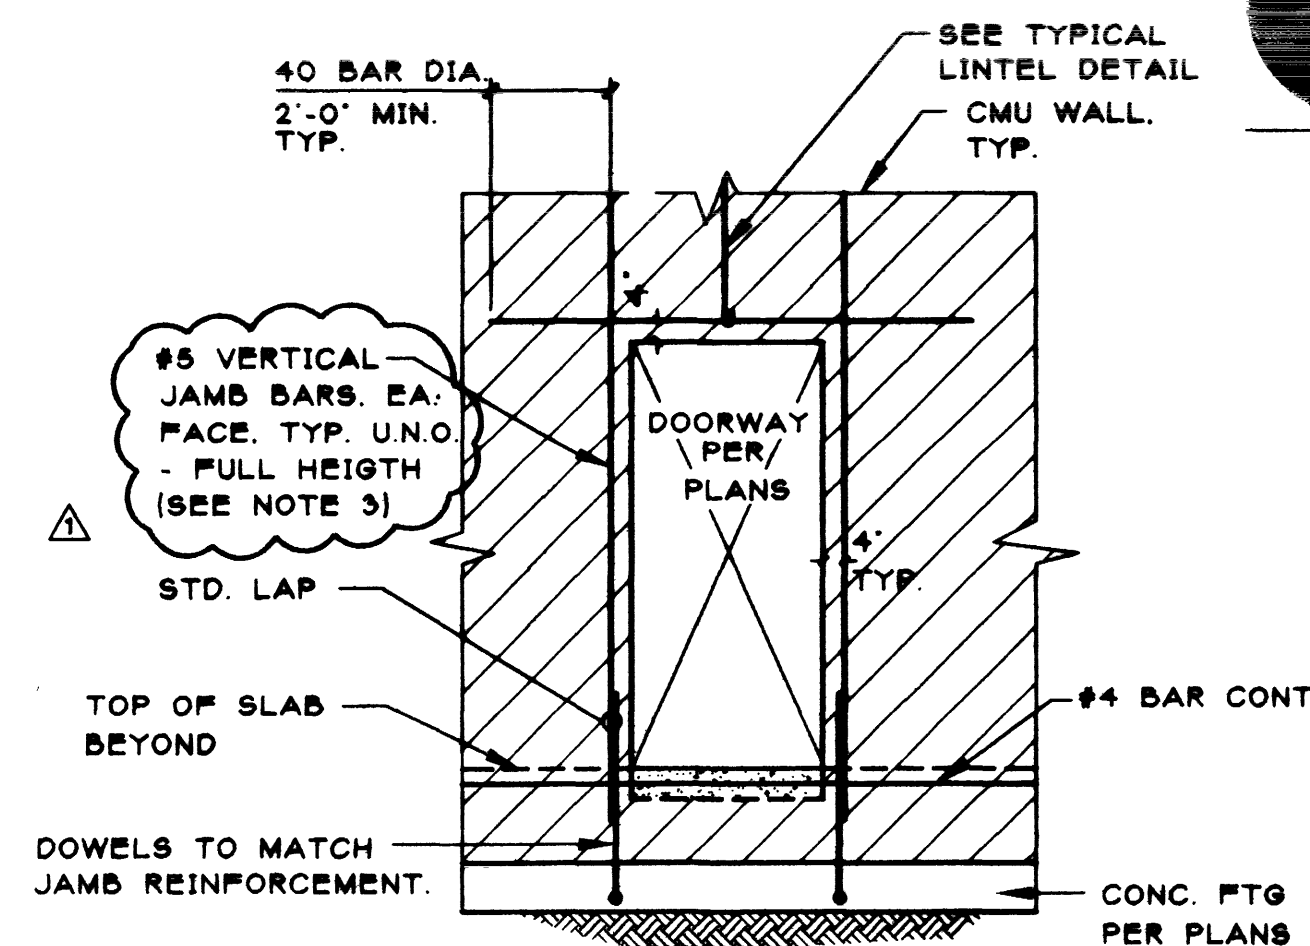

Typical CMU Wall Doorway Opening Detail
N.T.S.

- NOTE: 1.) SIMILAR DETAIL APPLIES AT OTHER OPENINGS. U.N.O.
2.) BEND LINTEL REINFORCING & EXTEND HORIZONTALLY 40 BAR DIAMETERS WHERE OPENING OCCURS AT CORNERS.
3.) USE 2-#5 JAMB BARS AT SIDES OF ROLL-UP DOOR.


JAMB REINF. FULL HEIGHT, EA. SIDE OF OPENING - SEE TYPICAL CMU WALL DOORWAY / LOUVER OPENING DETAILS

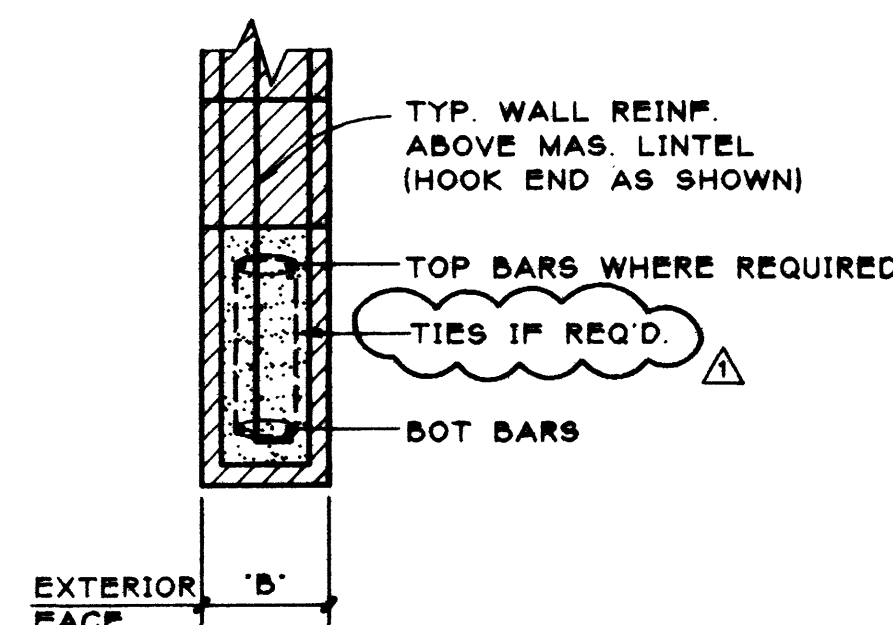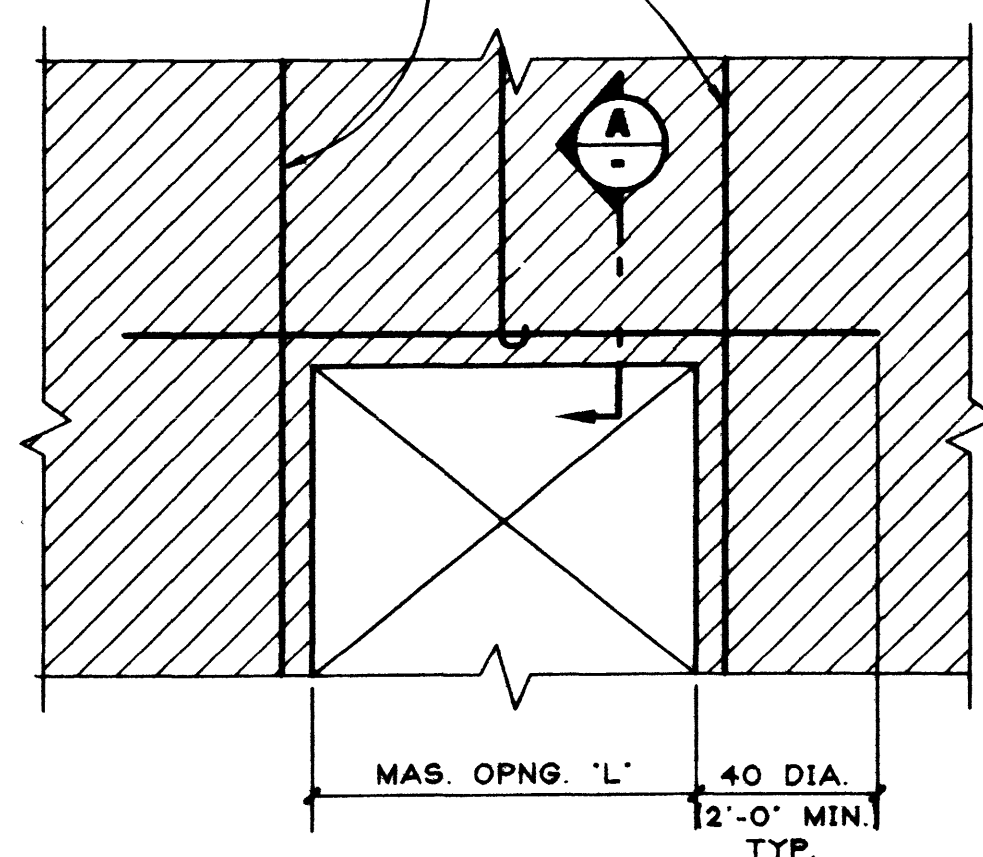

Typical Lintel
N.T.S.


MARK #	MASONRY	NOMINAL LINTEL SIZE	REINFORCING		NOTES:
	MAX. 'L'	'B'	BOT BAR	TOP BARS	
L1	8'-0"	8	2-#5's	2-#5's (CHORD REINF.)	#3 TIES @ 16" O.C.
L2	3'-4"	8	2-#5's	-	
L3	4'-0"	8	2-#5's	-	

Lintel Schedule

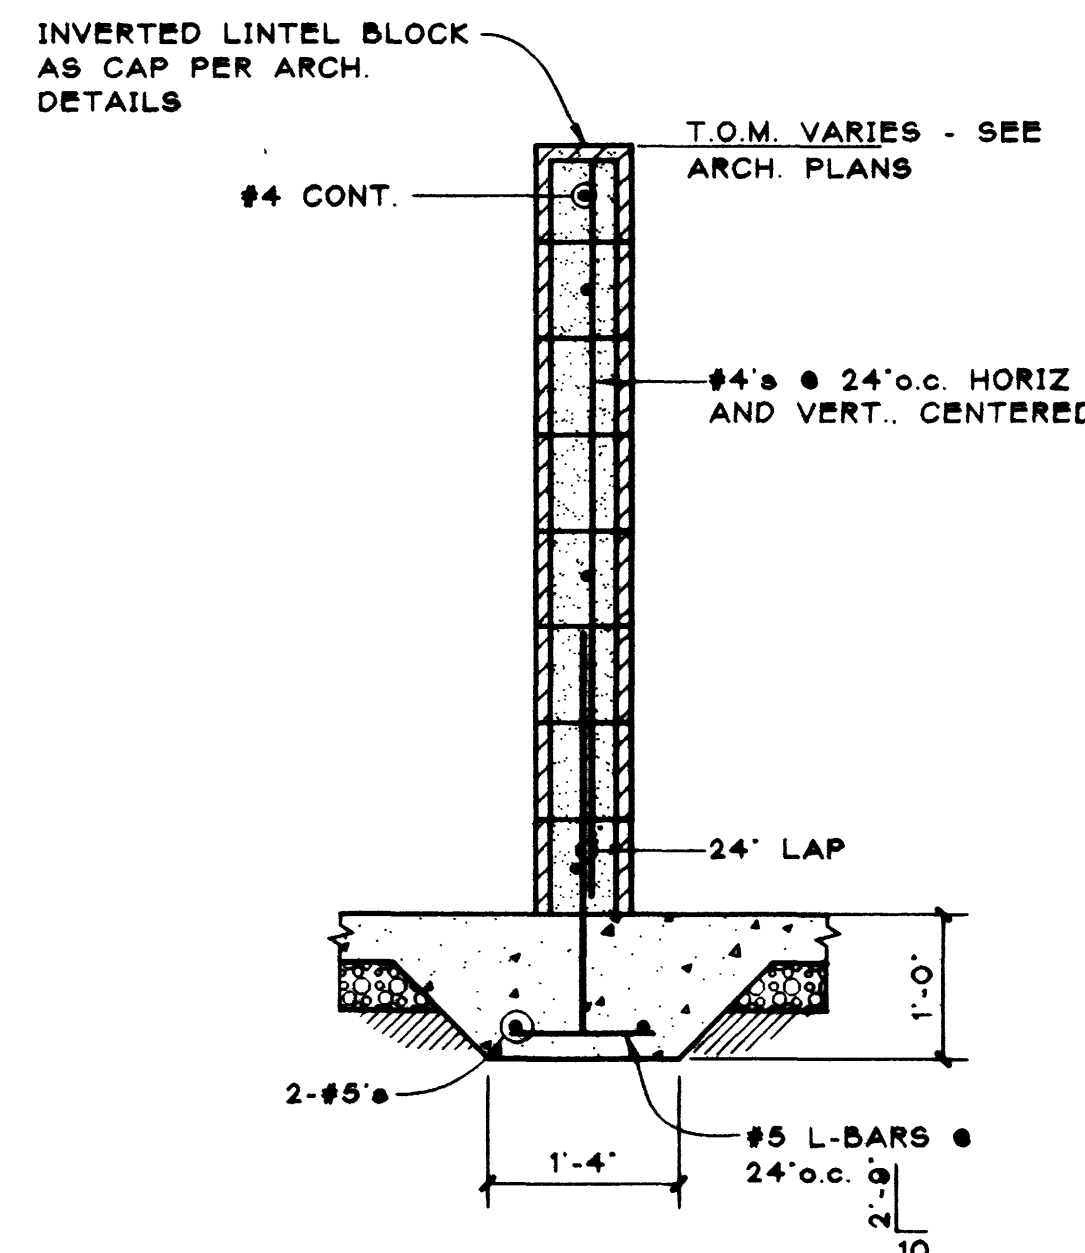

1 Typical CMU Toilet Partition Wall
SCALE: 3/4"=1'-0"

NOTES: 1.) LINTEL BLOCKS CAN BE INSTALLED AND GROUTED AFTER GROUTING OF LOWER PORTION OF WALL. LEAVE LINTEL BLOCK NEAREST THE PLUMBING WALL OUT FOR GROUT PLACEMENT. INSTALL THIS LINTEL BLOCK AFTER GROUTING.

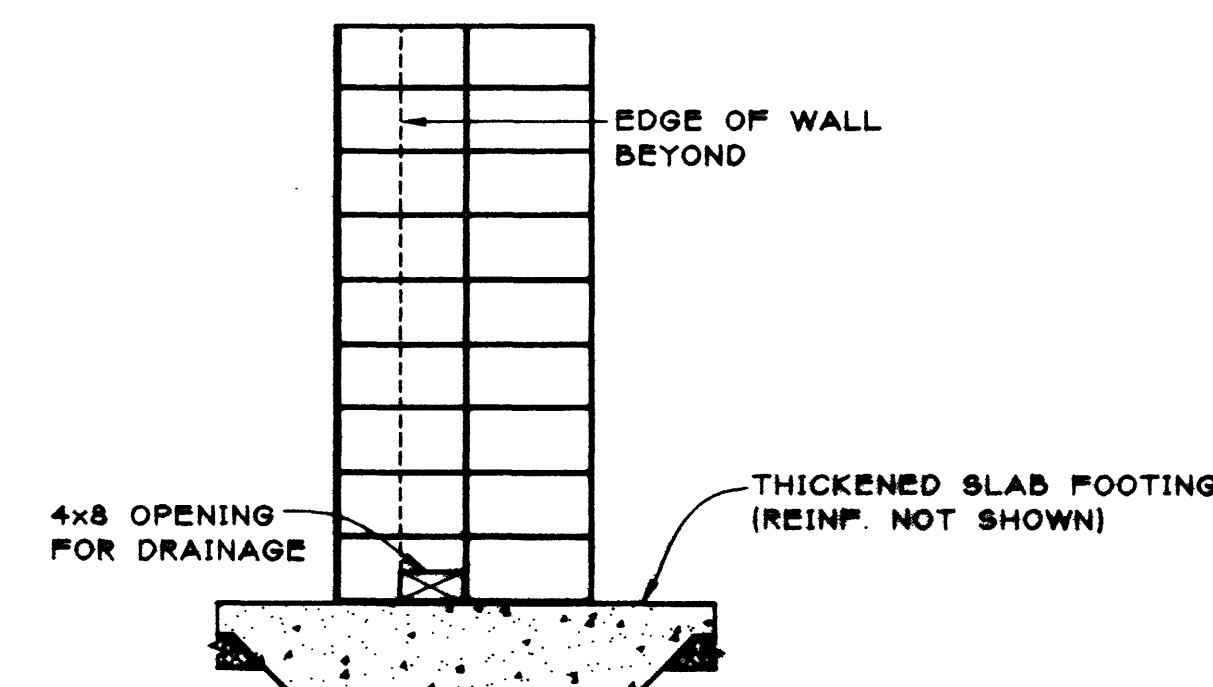

Toilet Partition Return Elevation
SCALE: 1/2"=1'-0"

PLANS APPROVED
STRUCTURAL
Brading & Sorely Dept.
City of Las Vegas, Nevada

JM AUG 20 1999

Does Not constitute Architectural, Electrical, Plumbing, Mechanical or Civil Engineering. Plans are subject to change without approval of the City of Las Vegas. Not to be used for any other purpose.



Aug 11, 1999

CMU DETAILS

Stantec Consulting Inc.
950 Industrial Way
Sparks, Nevada 89431 USA
Tel: (775) 358-6931
Fax: (775) 358-6954
www.stantec.com

Stantec

City of Las Vegas
DEPARTMENT OF PUBLIC WORKS

**HERITAGE PARK
PHASE II
PARK IMPROVEMENT PLANS**
CLARK COUNTY CITY OF LAS VEGAS NEVADA

24 OF 43
S2