


RECORD OF SURVEY/TIE MAP FOR **"FARM AND HUALAPAI"** (A COMMON INTEREST COMMUNITY)

AS SHOWN BY MAP THEREOF ON FILE IN BOOK 133, PAGE 25 OF PLATS IN THE CLARK COUNTY RECORDER'S OFFICE, NEVADA, LYING WITHIN THE NORTHEAST QUARTER (NE 1/4) OF SECTION 13, TOWNSHIP 19 SOUTH, RANGE 59 EAST, M.D.M., CITY OF LAS VEGAS, CLARK COUNTY, NEVADA.


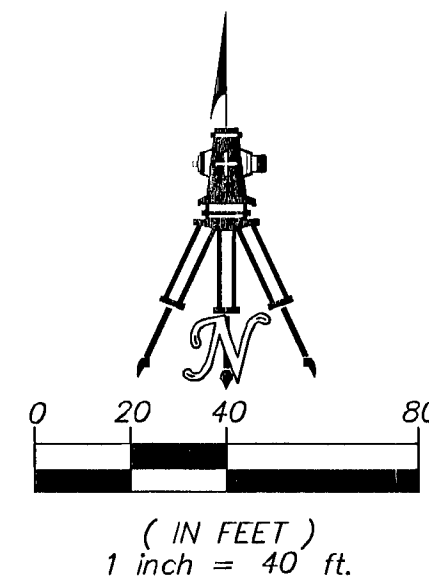


LEGEND

- SUBDIVISION BOUNDARY
- PRIVATE RIGHT-OF-WAY
- CENTERLINE
- ADJACENT LOT LINE
- TIE LINE
- FOUND MONUMENT AT NOTED
- SET 5/8" REBAR AND 1 1/2" ALCAP (TYPE III MONUMENT) STAMPED "PLS 20394"
- SET 2" ALCAP (TYPE IV MONUMENT) STAMPED DISTANCES AS INDICATED ON THIS PLAT AND "RM PLS 20394"

CURVE	DELTA	RADIUS	LENGTH	TANGENT
C1	03°01'41"	2786.50'	147.27'	73.65'
C2	02°52'39"	2786.50'	139.94'	69.99'
C3	00°09'02"	2786.50'	7.32'	3.66'
C4	03°01'41"	1511.00'	79.86'	39.94'

LINE	BEARING
R1	S87°25'03"E
R2	N87°16'01"W

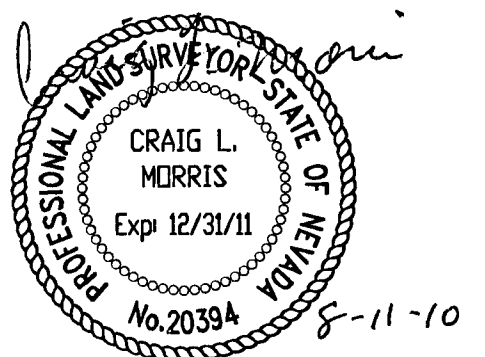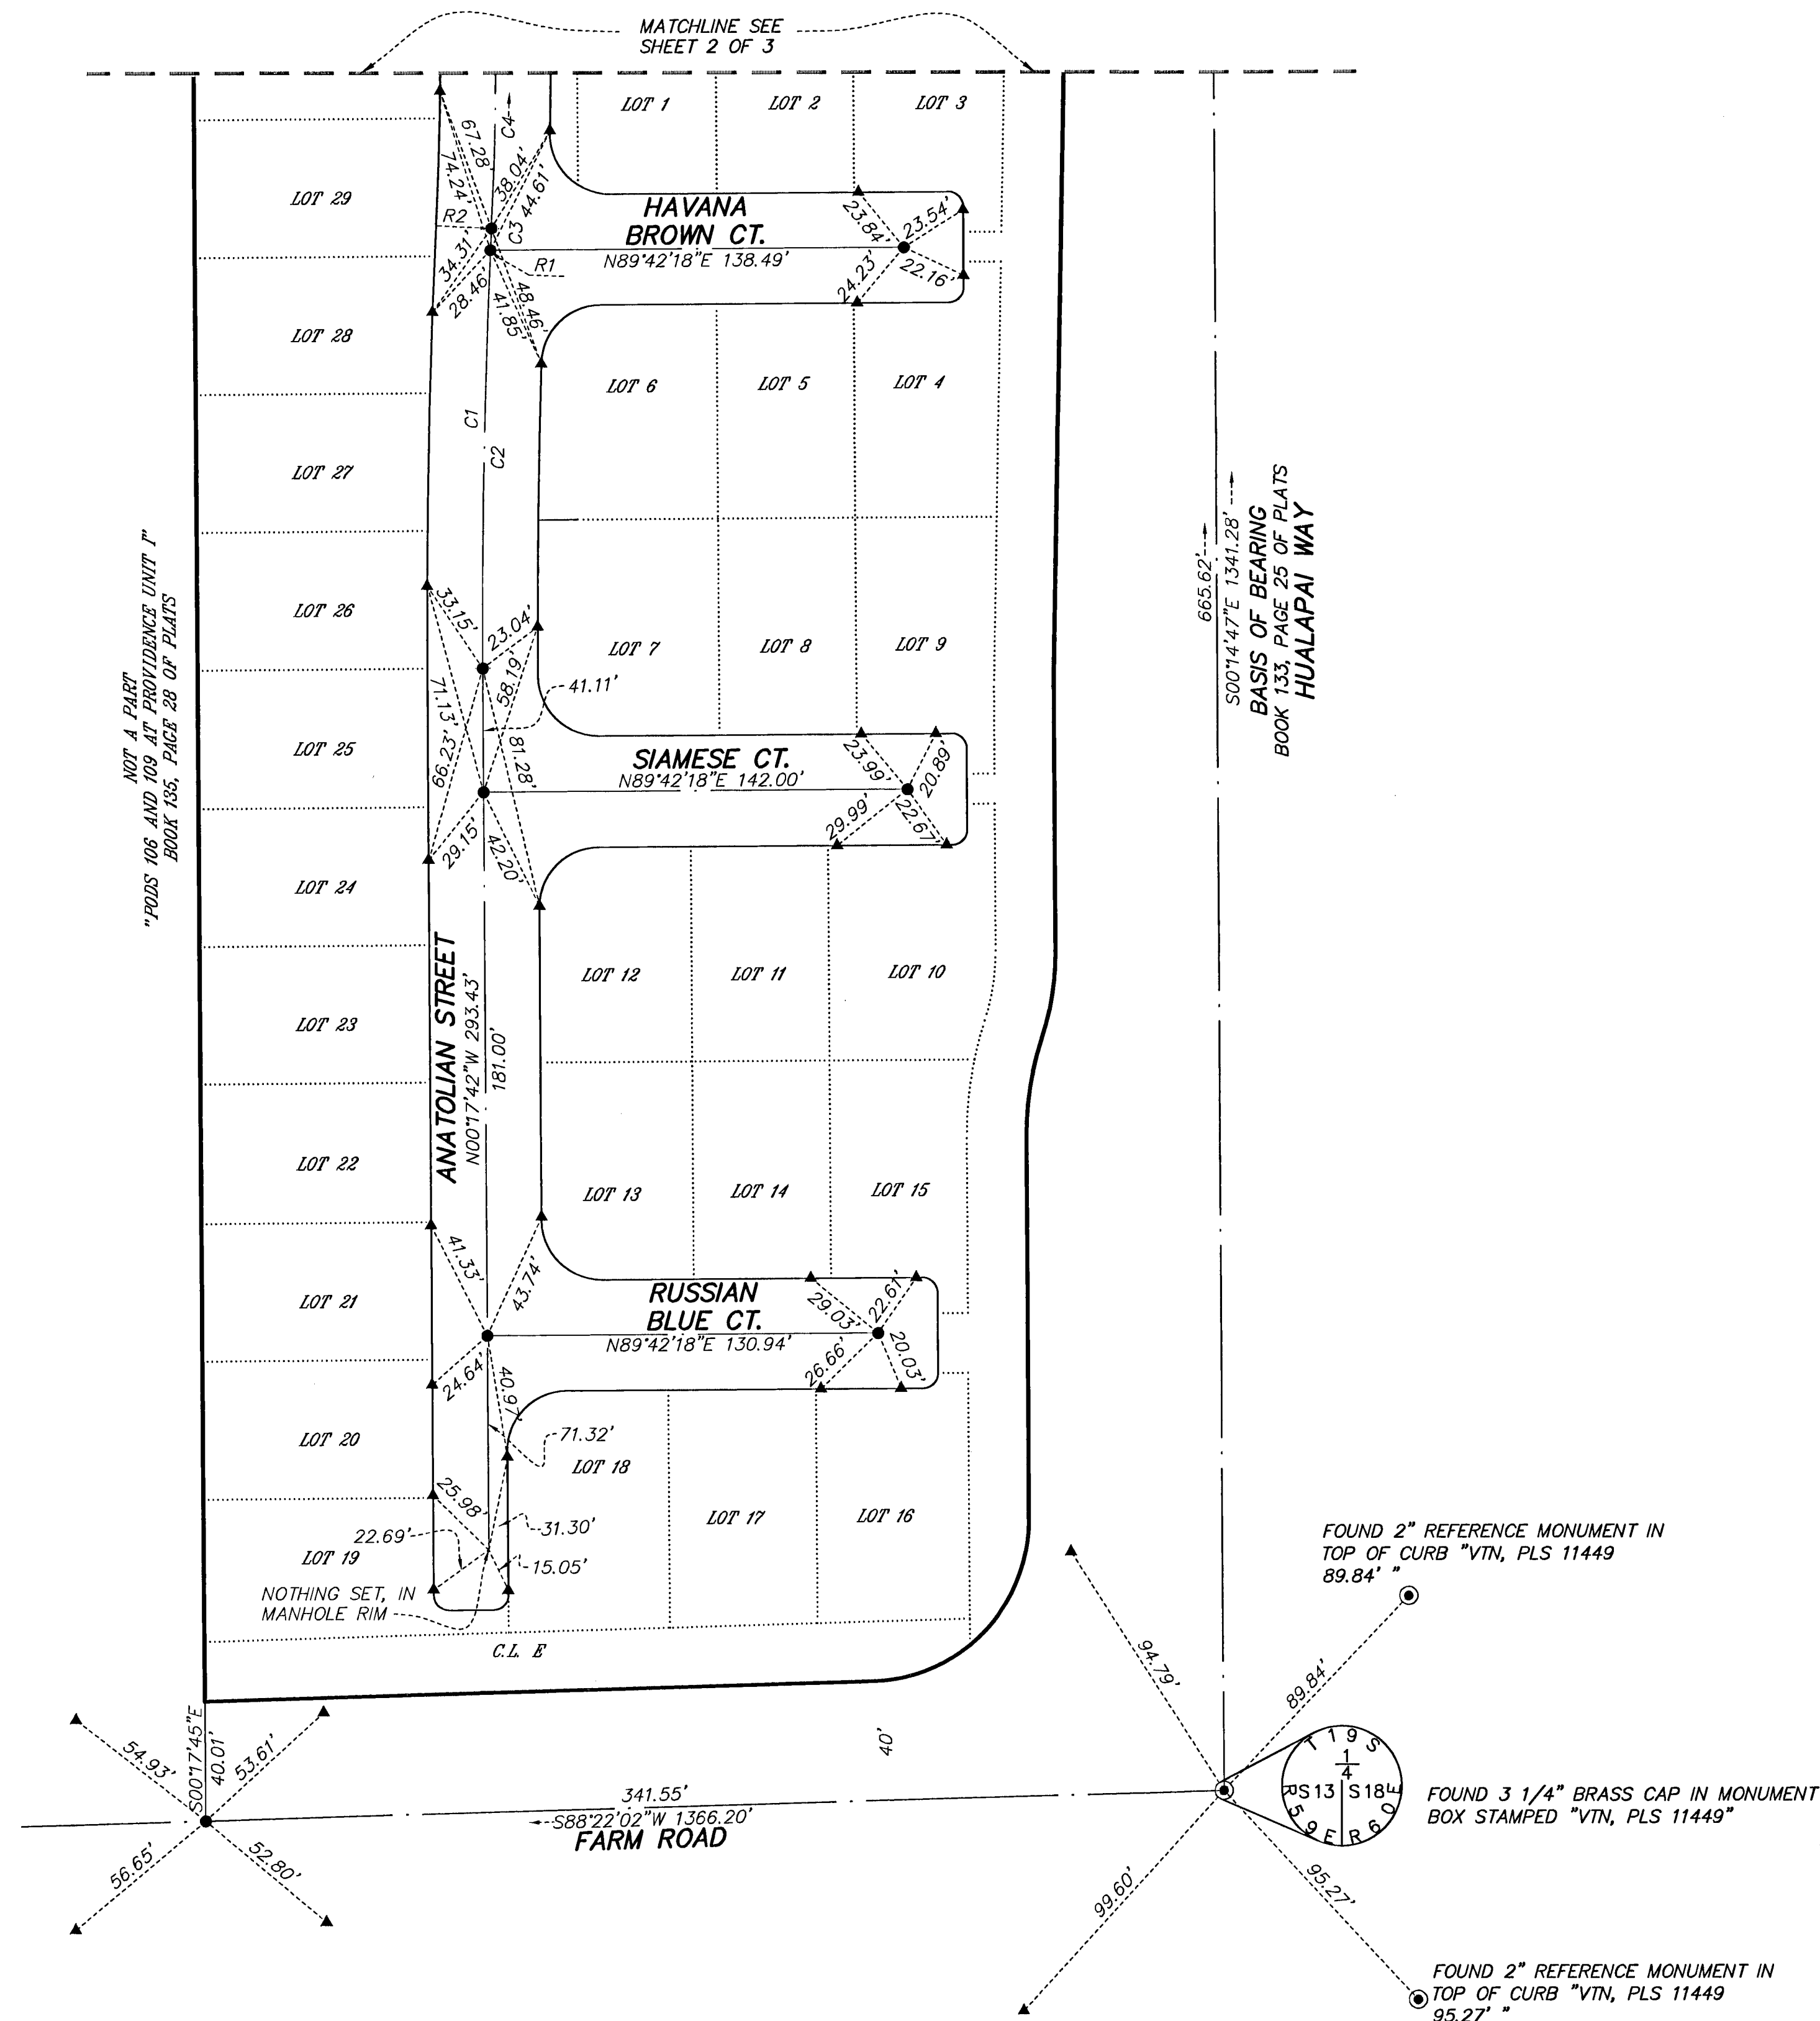

058-4905
SHEET 3 OF 3