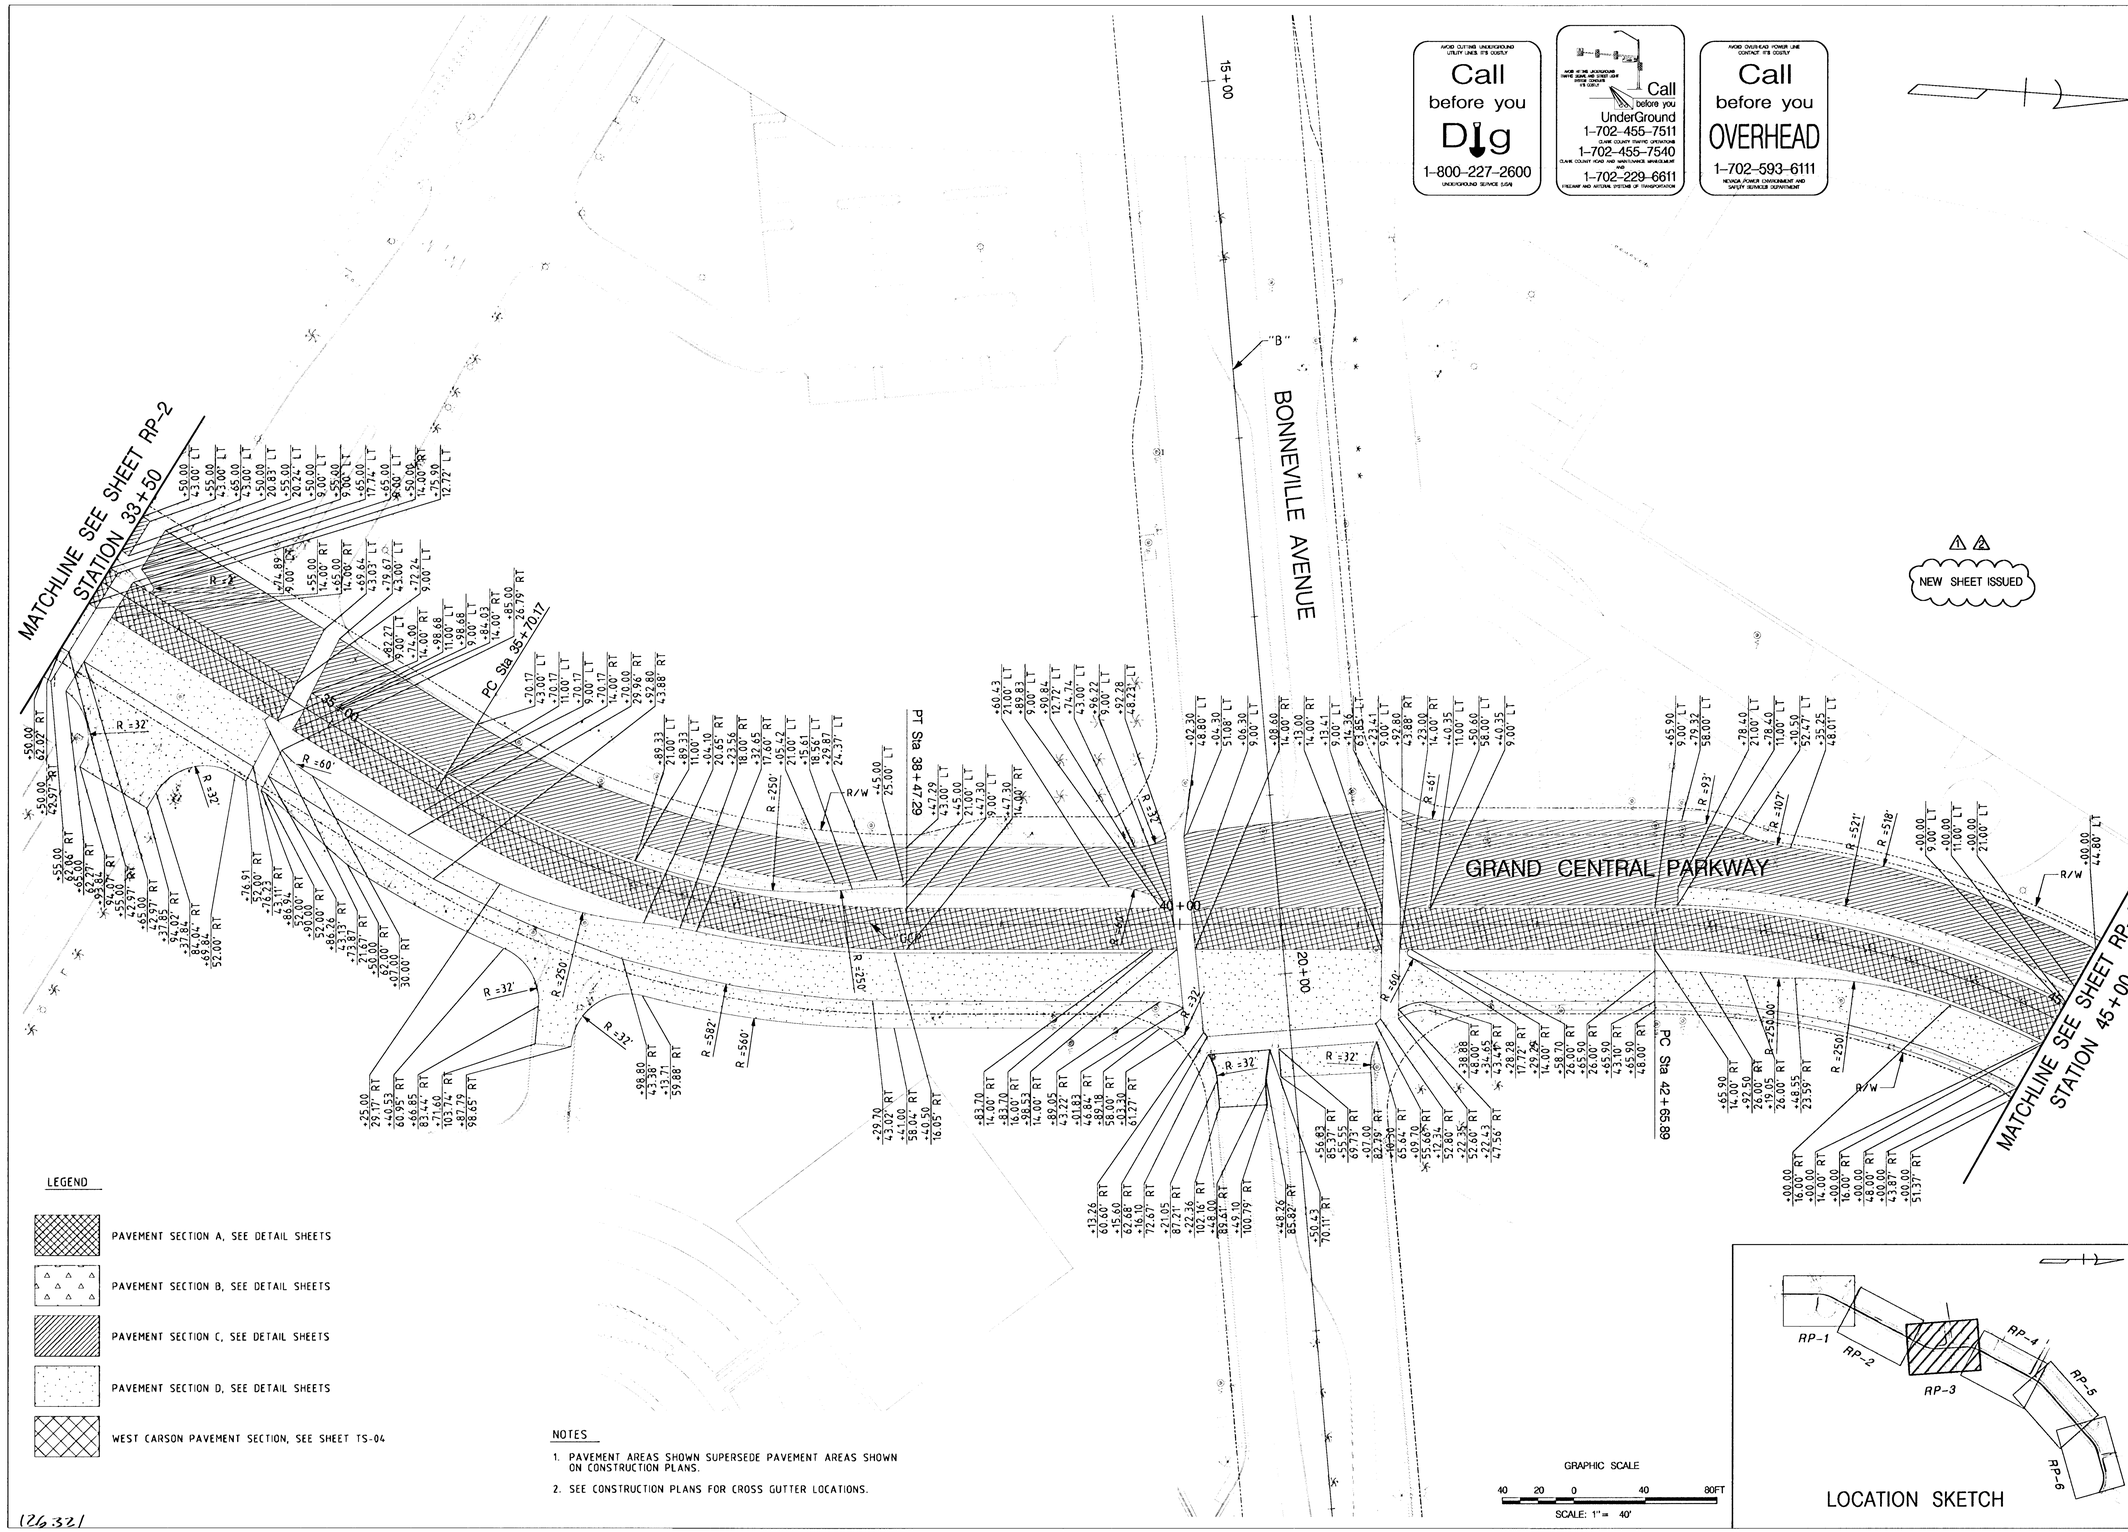

No.	DATE	DESCRIPTION	BY
1	8-28-07	PAVEMENT REVISION	PDS
2	9-24-07	PAVEMENT REVISION	PDS

REVISIONS

SCALE (H): 1" = 40'
SCALE (V): N/A
DESIGNED BY: DA
CHECKED BY: PDS
PROJECT No.: 10704782
DATE: AUG. 28, 2007

PARSONS BRINCKERHOFF
LAS VEGAS, NEVADA

CITY OF LAS VEGAS
NEVADA

DEPARTMENT OF PUBLIC WORKS

DOWNTOWN CONNECTOR BUS RAPID TRANSIT PROJECT
GRAND CENTRAL PARKWAY WIDENING
PAVEMENT PLAN SHEET

PROFESSIONAL ENGINEER - STATE OF NEVADA
PHILLIP D. SLAGEL
Exp 6/30/08
CIVIL

DRAWING No.
RP-3

10704782