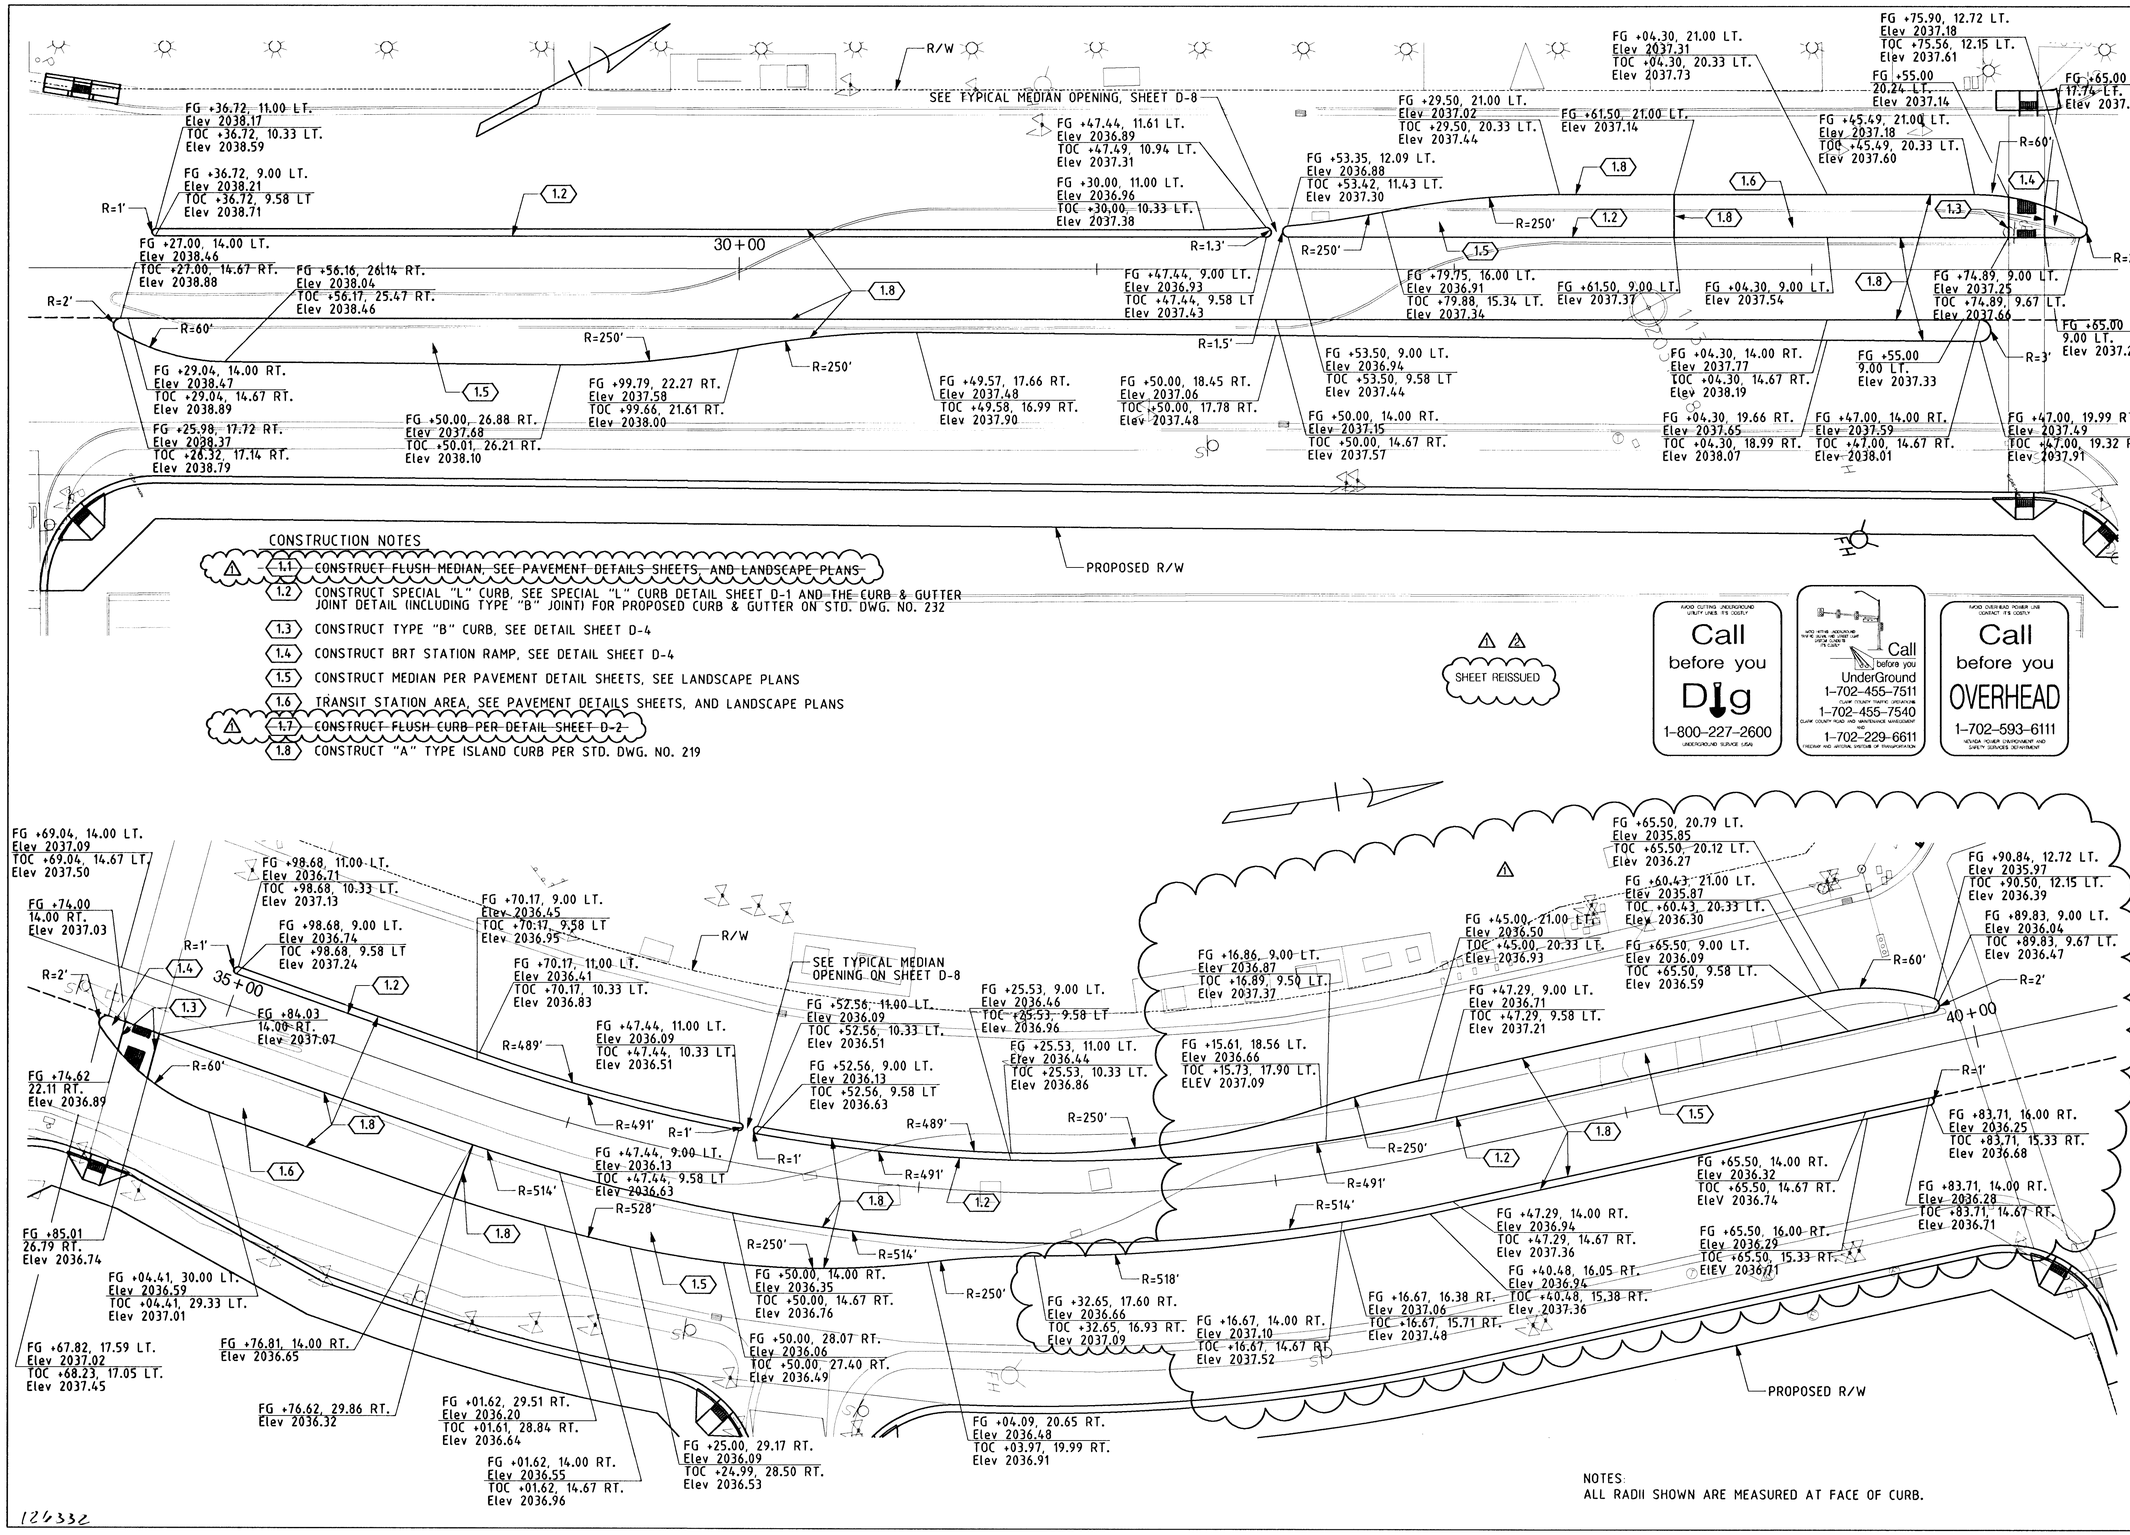

CONSTRUCTION NOTES

1. ~~1.1 CONSTRUCT FLUSH MEDIAN, SEE PAVEMENT DETAILS SHEETS, AND LANDSCAPE PLANS~~
2. 1.2 CONSTRUCT SPECIAL "L" CURB, SEE SPECIAL "L" CURB DETAIL SHEET D-1 AND THE CURB & GUTTER JOINT DETAIL (INCLUDING TYPE "B" JOINT) FOR PROPOSED CURB & GUTTER ON STD. DWG. NO. 232
3. 1.3 CONSTRUCT TYPE "B" CURB, SEE DETAIL SHEET D-4
4. 1.4 CONSTRUCT BRT STATION RAMP, SEE DETAIL SHEET D-4
5. 1.5 CONSTRUCT MEDIAN PER PAVEMENT DETAIL SHEETS, SEE LANDSCAPE PLANS
6. 1.6 TRANSIT STATION AREA, SEE PAVEMENT DETAILS SHEETS, AND LANDSCAPE PLANS
7. ~~1.7 CONSTRUCT FLUSH CURB PER DETAIL SHEET D-2~~
8. 1.8 CONSTRUCT "A" TYPE ISLAND CURB PER STD. DWG. NO. 219

NOTES:
ALL RADII SHOWN ARE MEASURED AT FACE OF CURB.

No.	DATE	DESCRIPTION	BY
3	3-3-2008	MEDIAN ISLAND REVISION	MJ
4	4-15-2008	MEDIAN ISLAND REVISION	MJ

REVISIONS

SCALE (H): 1"=20'
SCALE (V): N/A
DESIGNED BY: PDS
CHECKED BY: TS
PROJECT No.: 10704782
DATE: AUG. 28, 2007

PARSONS BRINCKERHOFF
Las Vegas, Nevada

CITY OF LAS VEGAS NEVADA

DEPARTMENT OF PUBLIC WORKS
DOWNTOWN CONNECTOR BUS RAPID TRANSIT PROJECT
GRAND CENTRAL PARKWAY WIDENING
MEDIAN ISLAND DETAILS

NATIONAL REGISTERED PROFESSIONAL ENGINEER STATE OF NEVADA
MARK T. JEWELL
Exp. 6/30/09
CIVIL

DRAWING No. D-9
35 / 147

126332