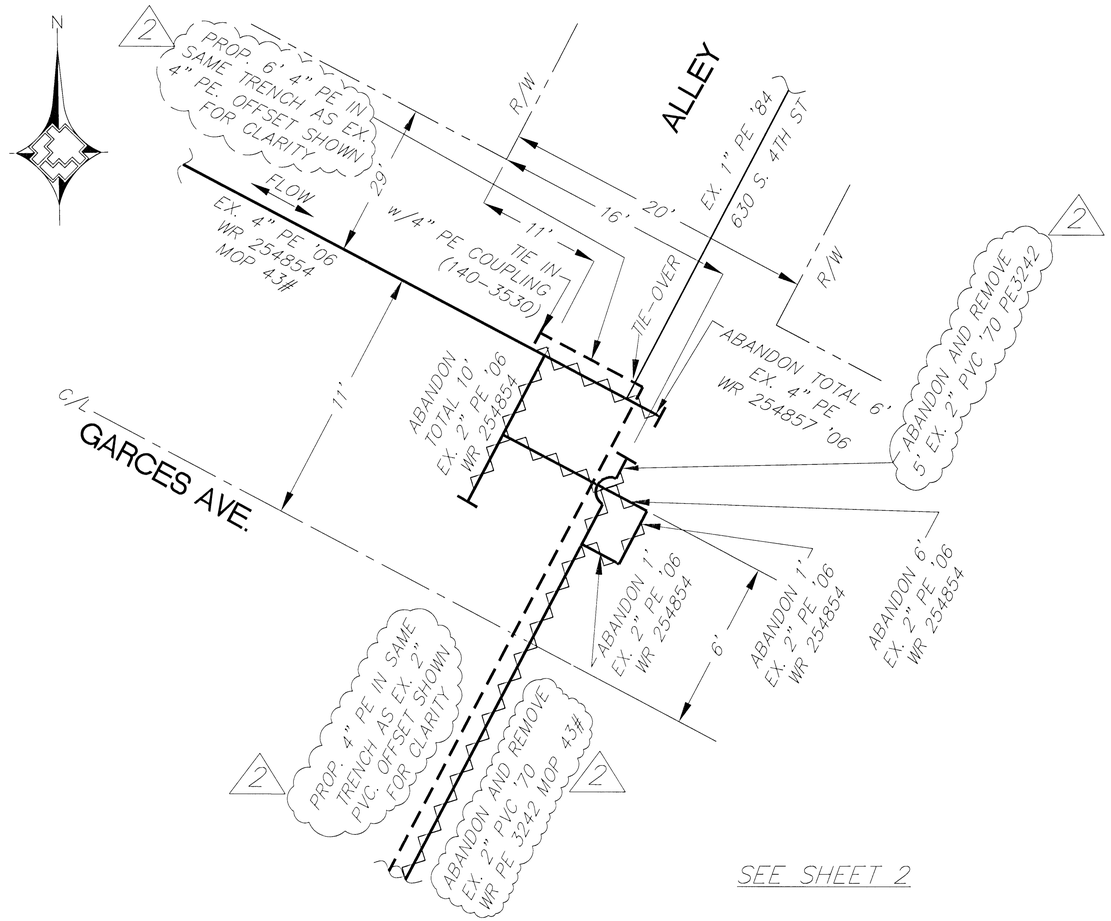

SEE SHEET 2

A/6 DETAIL "A"
N.T.S.

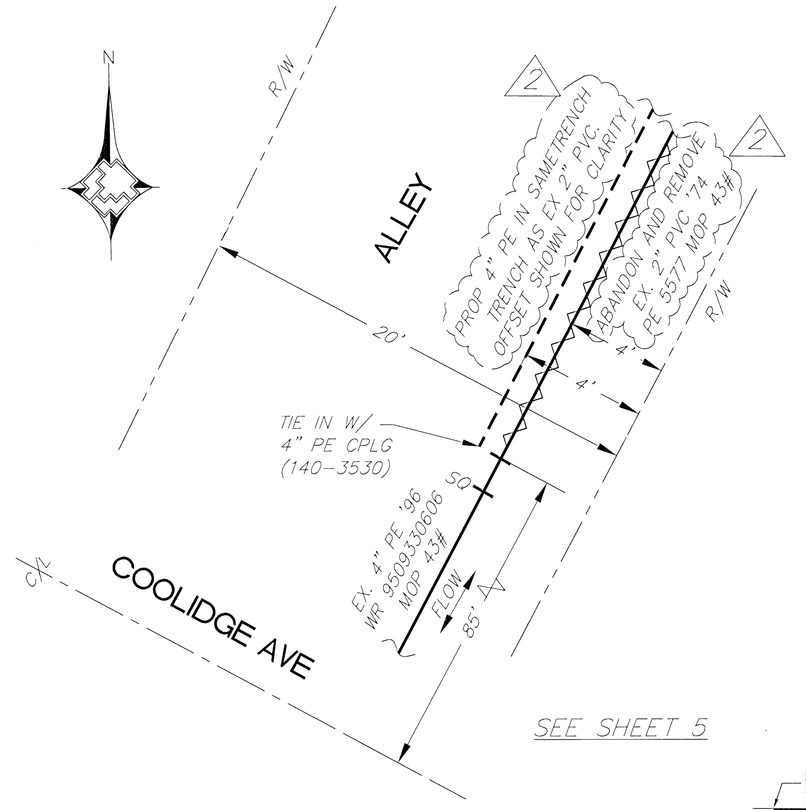

SEE SHEET 5

B/6 DETAIL "B"
N.T.S.

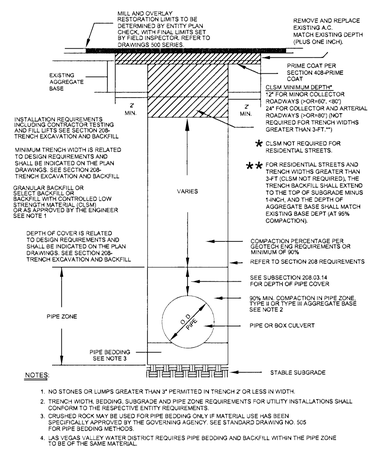

NOTES

1. NO STONES OR LUMPS GREATER THAN 3" PERMITTED IN TRENCH 2' OR LESS IN WIDTH.
2. TRENCH WIDTH, BEDDING, SUBGRADE AND PIPE ZONE REQUIREMENTS FOR UTILITY INSTALLATIONS SHALL CONFORM TO THE RESPECTIVE ENTITY REQUIREMENTS.
3. CRUSHED ROCK MAY BE USED FOR PIPE BEDDING ONLY IF MATERIAL USE HAS BEEN SPECIFICALLY APPROVED BY THE GOVERNING AGENCY. SEE STANDARD DRAWING NO. 505 FOR PIPE BEDDING METHODS.
4. LAS VEGAS VALLEY WATER DISTRICT REQUIRES PIPE BEDDING AND BACKFILL WITHIN THE PIPE ZONE TO BE OF THE SAME MATERIAL.

REVISED

RTC STD 503

Know what's **below.** **Call** before you dig.

NO.	DESCRIPTION	BY	DATE	APPVD.
3	FOOTAGE UPDATE	RAM	4/15/13	PK
2	ALLEY LOCATION RE-DESIGN	TCT	4/10/13	
1	REVISED PROPOSED DESIGN	TCT	2/28/13	4-24-13

REVISIONS

1742 Southwest Gas Corporation

SEE SHEET 1

UNIT NO.	UNIT TYPE	INSTL. PROPOSED	RET. PROPOSED	INSTL. COMPLETED	RET. COMPLETED

PROPERTY UNITS

AS-BUILT DRAWING-PRESSURE TEST DATA

PIPE DIA. _____ TEST MEDIUM: ☐ AIR ☐ NITROGEN ☐ WATER ☐ SOAP — TEST METHOD: ☐ GAUGE ☐ CHART
PIPE LENGTH _____
PIPE TYPE _____ GAUGE/PRESS REC SN#
MIN. DURATION _____

	START	END
TEST PRES. (PSIG)		
TIME		
DATE		
PERFORMED BY		

VISUAL INSPECTION CERTIFICATION

I HAVE VISUALLY INSPECTED ALL HEATED FUSIONS, SOLVENT, MECHANICAL JOINTS, AND WELDS THAT I HAVE PERFORMED

NAME _____ DATE _____

AS-BUILTS ACCEPTED BY _____ DATE _____
POSTED BY _____ DATE _____
POSTING QC'D BY _____ DATE _____

CONSTRUCTION

INSPECTOR _____
FOREMAN _____
REVIEWED BY _____

PERMIT INFORMATION
CITY OF LAS VEGAS

TAX CODE
02-0203

ISOLATION AREA	W. R. NO.
DIST 96	1536317

LOCATION	ATLAS #/TILE #
T20S R61E S34 M.D.M. NEVADA	x627y514 x627y512

P. Pepler

ENGINEER/TECHNICIAN: BOB MIDDAG		PHONE 365-2071
ACCOUNT REP:		PHONE
PROJECT CONTACT:		PHONE
SHEET NO. 6 OF 6	SCALE 1"=30'	DATE 12-12-12
DWN. BY: ZONEENG	CHKD. BY	UPDATED

TITLE

SI-CLV-GARCES AND ALLEY 2" PVC REPLACEMENT