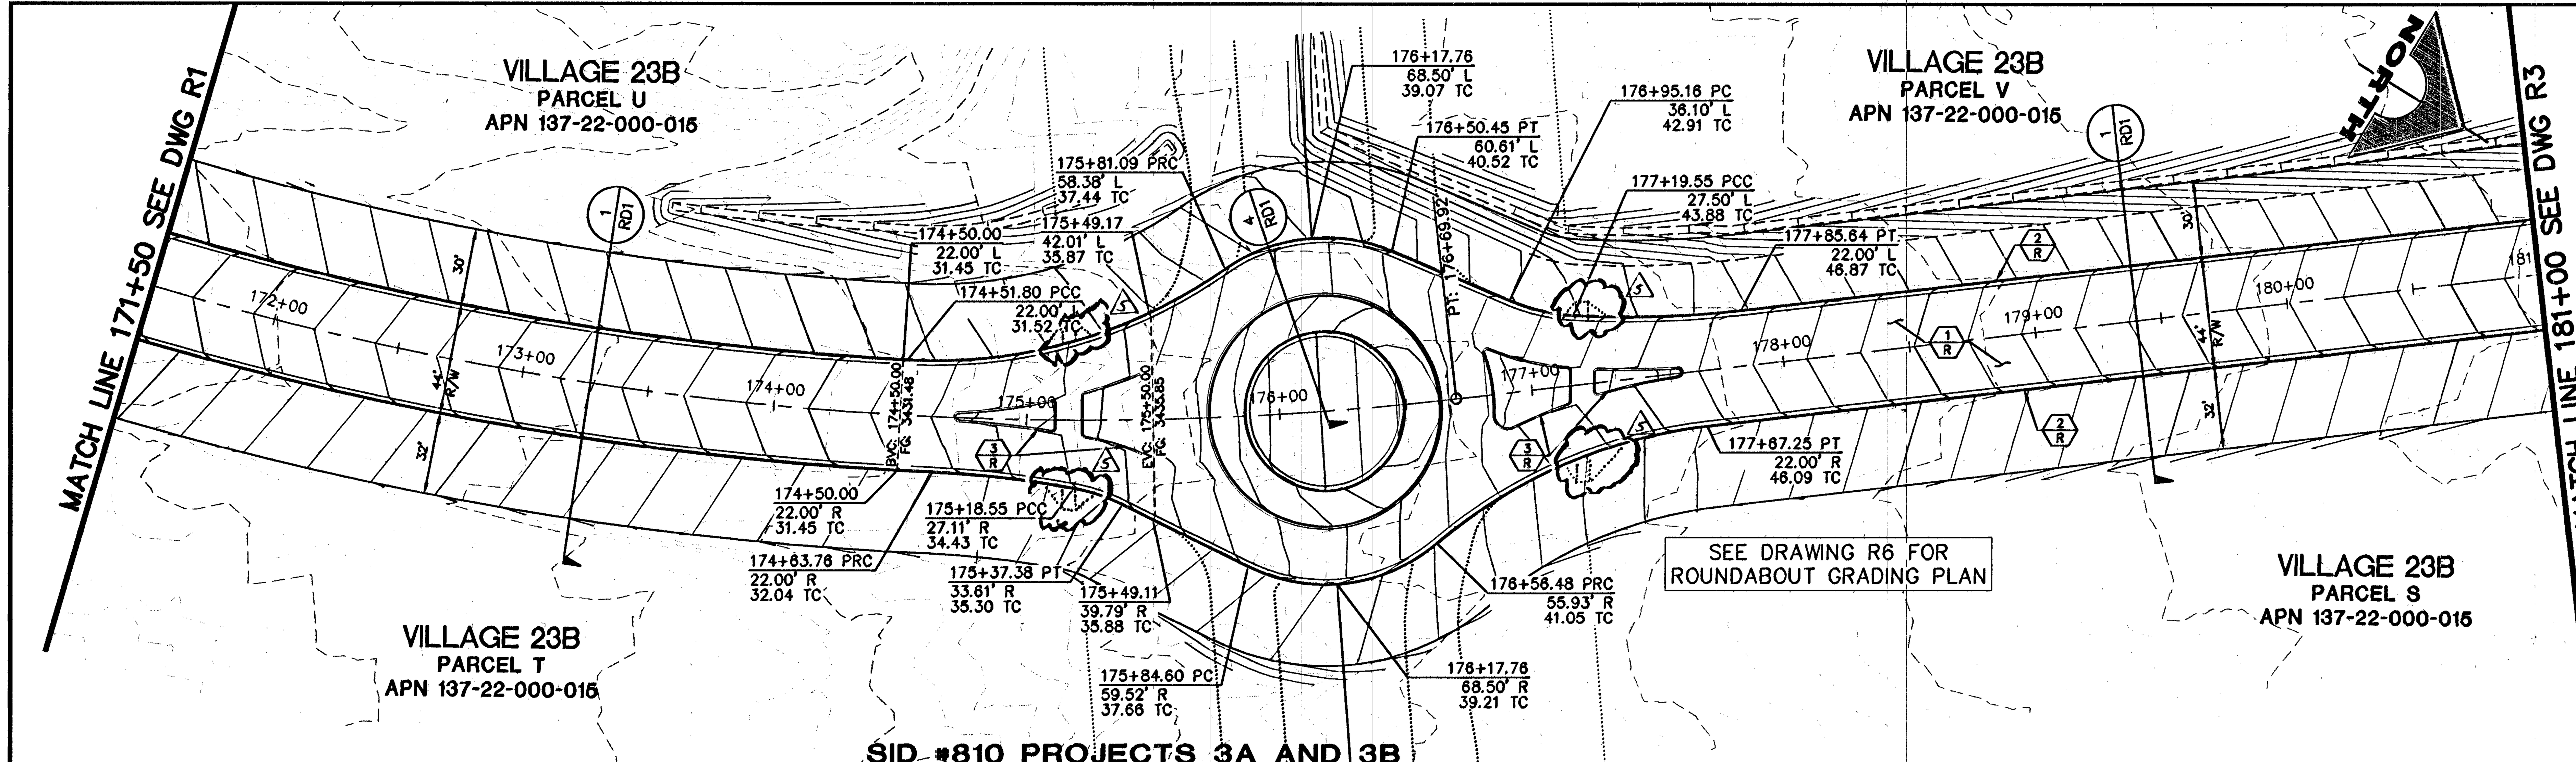

SID #810 PROJECTS 3A AND 3B
FOX HILL DRIVE (PUBLIC)

SCALE: HORIZ. 1" = 40'
VERT. 1" = 8'

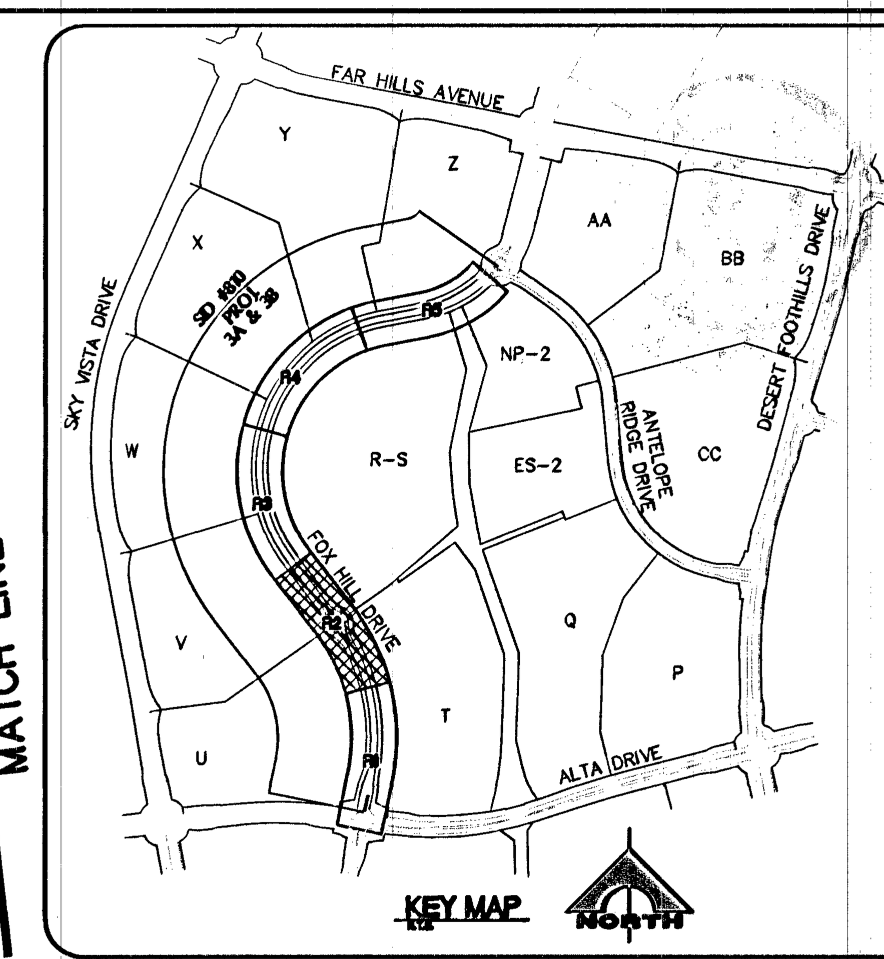

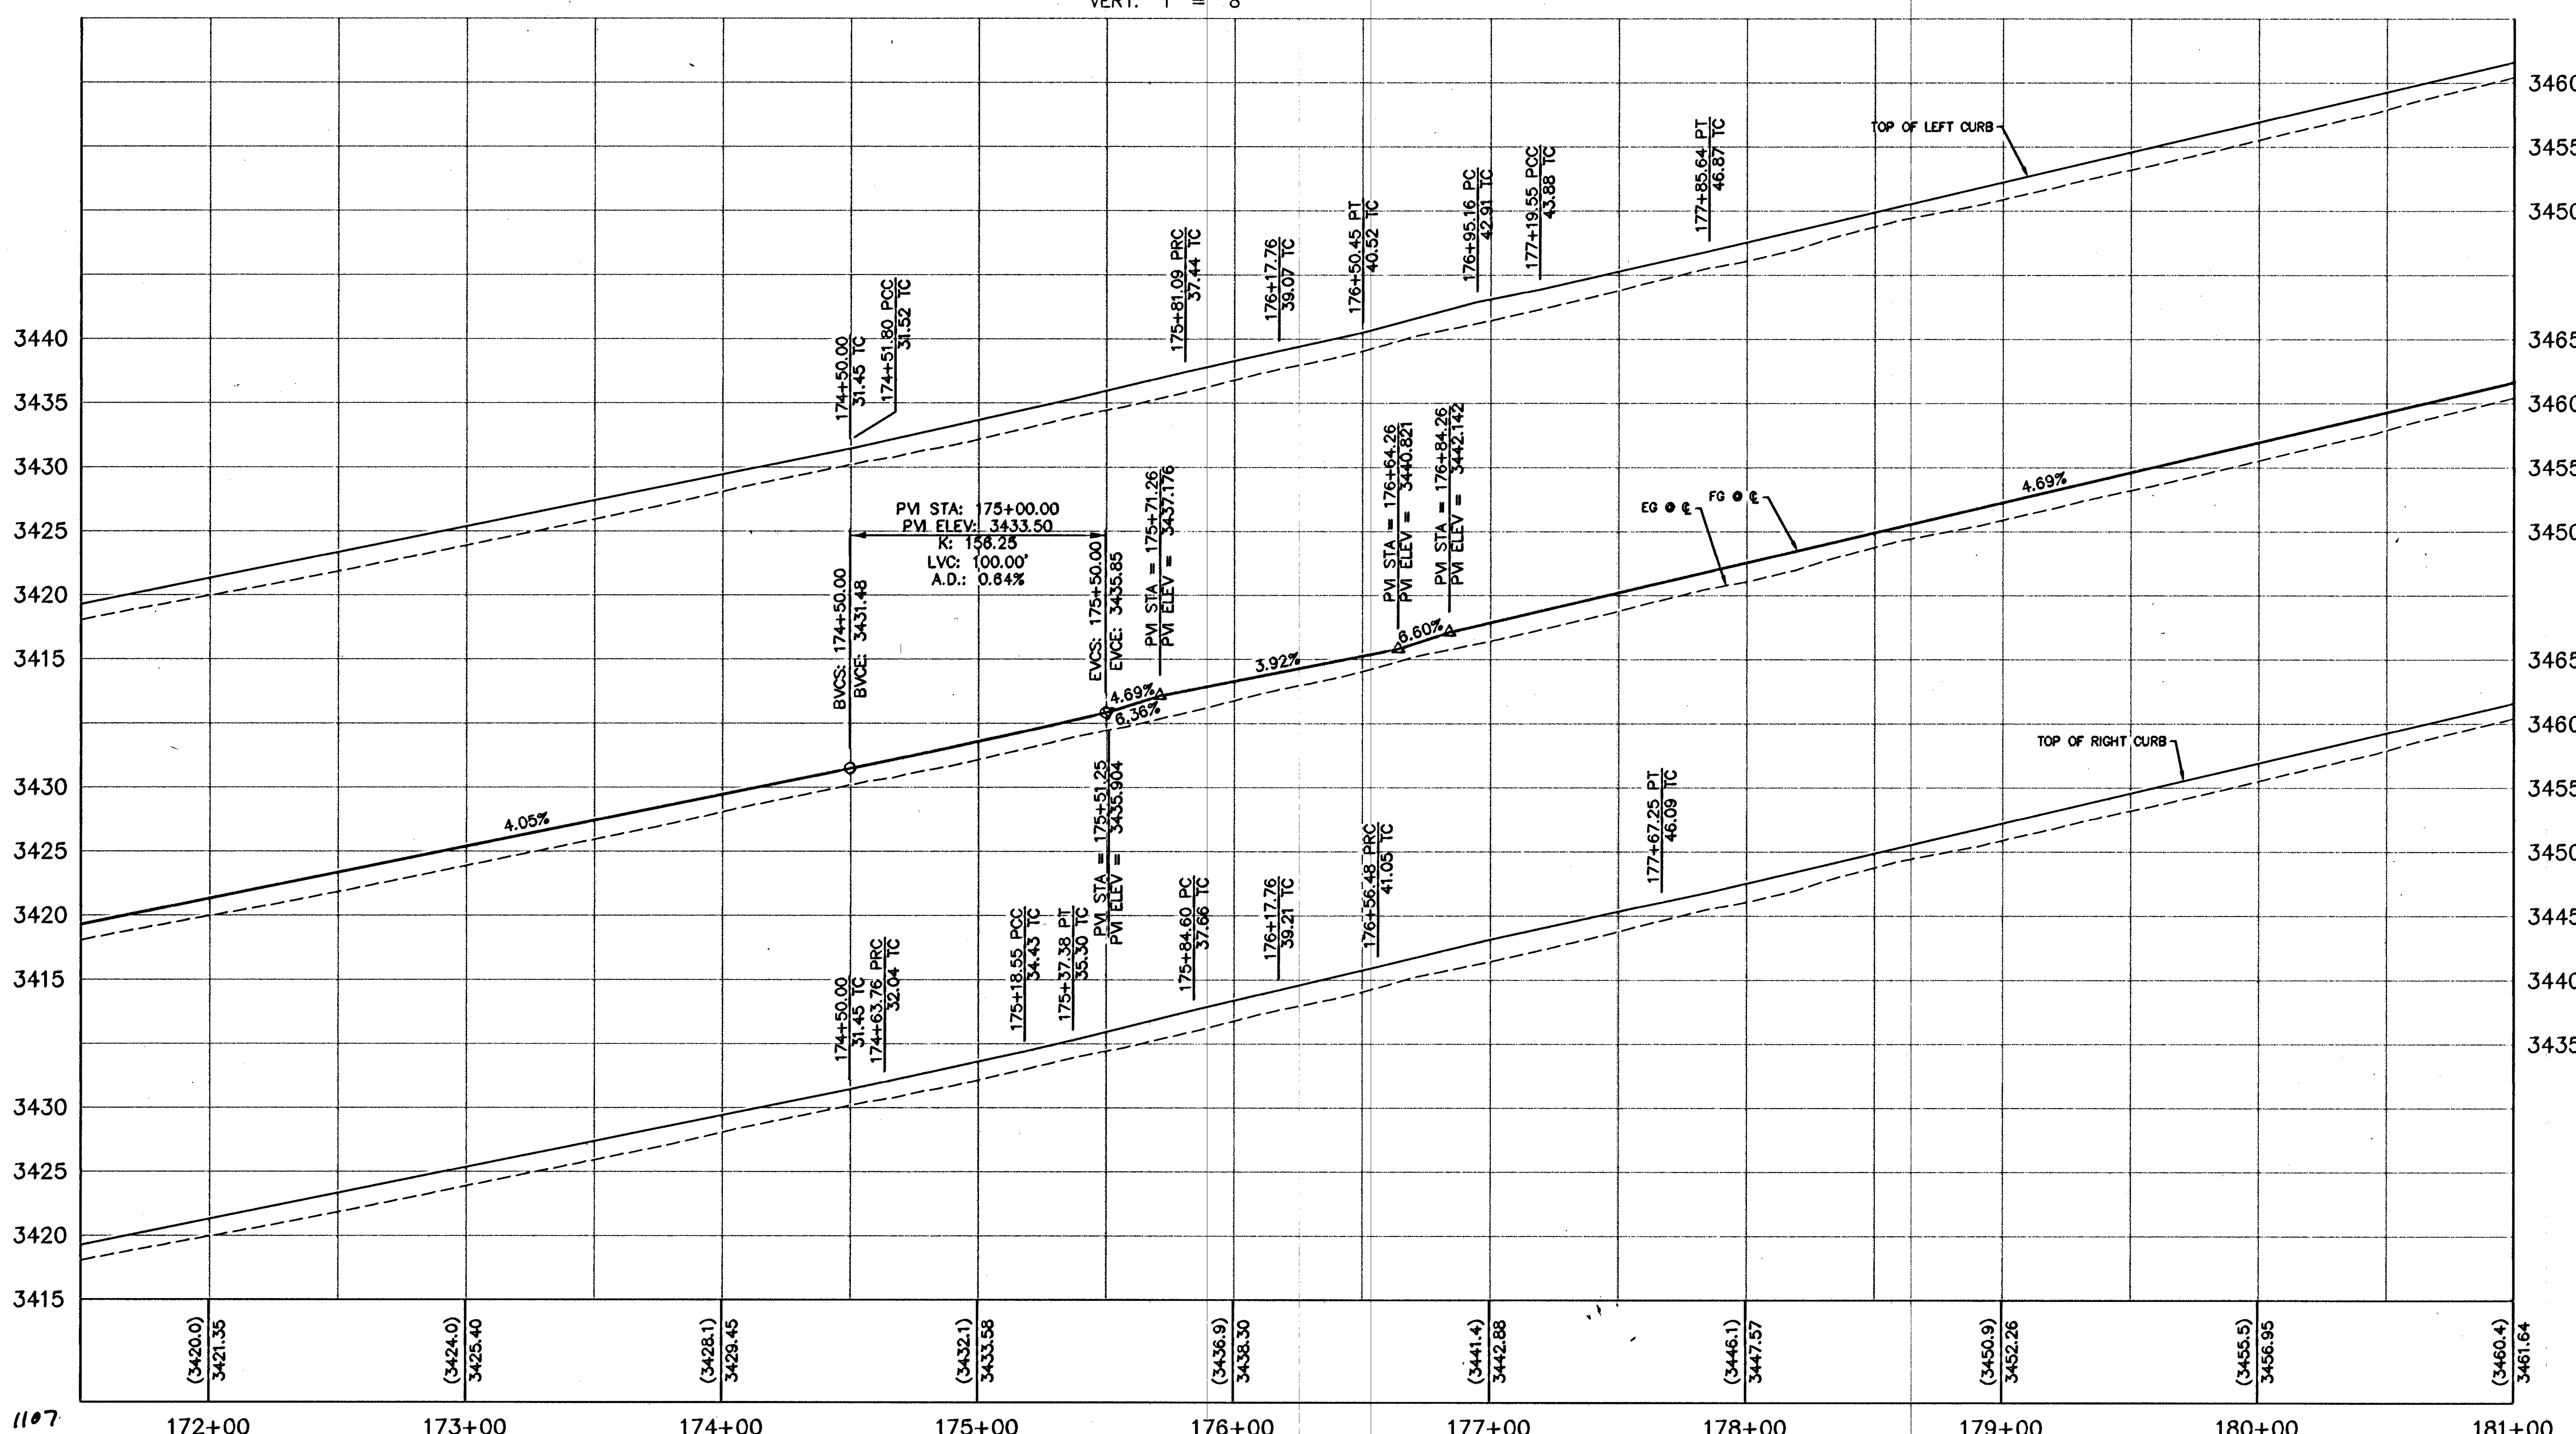

ROADWAY CONSTRUCTION NOTES:

1R INSTALL AC PAVEMENT PER STREET SECTIONS. SEE DWG RD1
2R INSTALL 6" "L" CURB AND GUTTER PER SIS DWG. NO. S-47
3R INSTALL "A" TYPE ISLAND CURB PER SIS DWG. NO. S-50
4R INSTALL "L" TYPE ISLAND CURB PER SIS DWG. NO. S-50
5R CONSTRUCT DEPRESSED CURB FOR FUTURE SIDEWALK RAMP (PER SIS DWG. NO S-75)

BENCHMARK

BM #	DESCRIPTION	NAVD 88 DATUM	NAVD 88 DATUM
5LV09-34NE6	RIVET AND PLATE IN TOP OF CURB @ NORTHEAST CORNER OF DESERT FOOTHILLS AND ALTA DRIVE	3304.45 (FEET)	1007.197 (METERS)

NOTE

THIS SET OF DRAWINGS IS BASED UPON NAVD 88 DATUM. PREVIOUS DRAWINGS MAY BE BASED ON OTHER DATUM. CARE SHOULD BE OBSERVED WHEN UTILIZING THIS SET OF DRAWINGS.

BASIS OF BEARINGS

NORTH 89°45'05" EAST BEING THE SOUTH LINE OF THE SOUTHWEST QUARTER (SW 1/4) OF SECTION 35, TOWNSHIP 20 SOUTH, RANGE 59 EAST, M.D.M., AS SHOWN BY MAP ON FILE IN FILE 91, PAGE 28 OF PARCEL MAPS IN THE CLARK COUNTY RECORDER'S OFFICE, CLARK COUNTY, NEVADA.

DRAINAGE CERTIFICATION

I CERTIFY THAT THE GRADING PLANS ARE IN CONFORMANCE WITH THE APPROVED DRAINAGE STUDY ON FILE AT THE CITY OF LAS VEGAS FOR THIS PROJECT.

DANIEL F. KELLEY P.E. 21134 DATE

Call before you Dig
Avoid cutting underground utility lines. It's costly.
Call 811
1-800-227-2600

AVOID HITTING OVERHEAD POWER LINES. IT'S COSTLY
CALL BEFORE YOU DO OVERHEAD
1-702-227-2929

FAST
Call before you UnderGround.
1-702-432-5300
FREEWAY AND ARTERIAL SYSTEM OF TRANSPORTATION

CLV #107V5924 11# 47788

1107

REV	DATE	DESCRIPTION	DATE	AGEN APP	DATE	GOV APP
5	4/25/14	ADDED CURB DEPRESSION				

G.C. WALLACE COMPANIES
ENGINEERS | PLANNERS | SURVEYORS
1555 S. RAINBOW BOULEVARD · LAS VEGAS, NV 89146
T: 702.804.2000 · F: 702.804.2299 · GCWALLACE.COM
LAS VEGAS · MESQUITE

LAS VEGAS

PROJECT NO. 62023B-204
DESIGN: DFK
DRAWN: DFK
CHECK: JLJ
PLOT DATE: 03-11-13
PLOT TIME: 11:51:04

THE HOWARD HUGHES COMPANY, LLC

FOX HILL DRIVE
FROM ALTA DRIVE TO ANTELOPE RIDGE DRIVE

ROADWAY CURB PLAN AND PROFILE 2

DRAWING R2
29 OF 42 SHTS