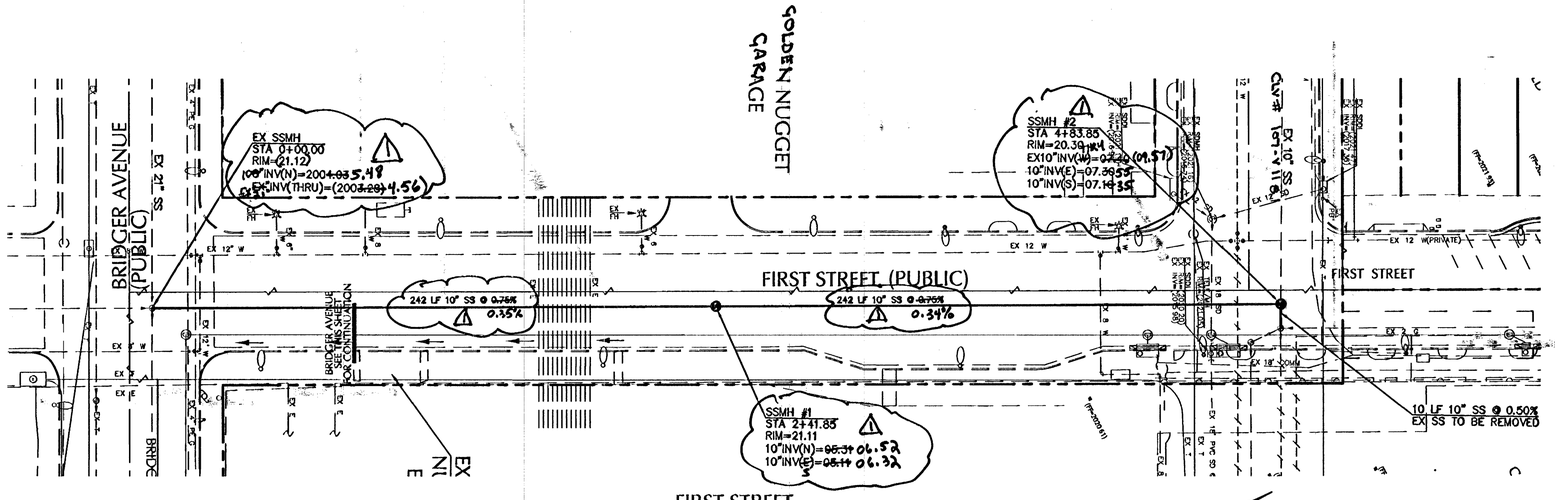

FIRST STREET

GRAPHIC SCALE

30 0 15 30 60 120

(IN FEET)
1 INCH = 30 FT

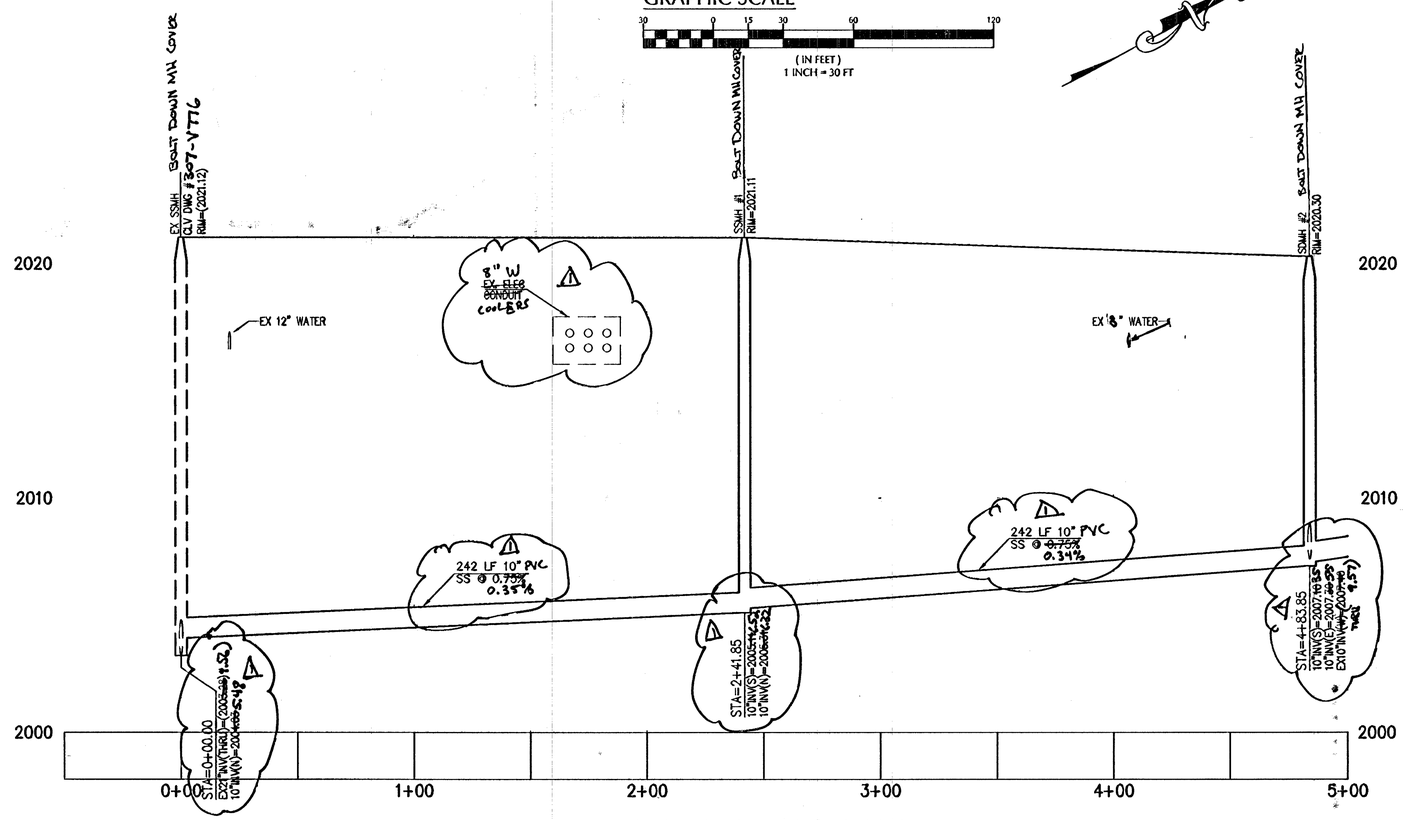

BRIDGER AVENUE/FIRST STREET

SCALE: HORIZONTAL 1"=30'
VERTICAL 1"=3'

95992 & 99640

CALL BEFORE YOU DO UNDERGROUND WORK
CALL 1-702-455-7511
CALL 1-702-229-6011

CALL BEFORE YOU DO OVERHEAD WORK
CALL 1-702-227-2929

Call before you Dig
CALL 1-800-227-2600 UNDERGROUND SERVICE (USA)

MARTIN & MARTIN ASSUMES NO RESPONSIBILITY FOR EXISTING UTILITY LOCATIONS AND ELEVATIONS. THE UTILITIES SHOWN ON THIS DRAWING HAVE BEEN PLOTTED FROM THE BEST AVAILABLE INFORMATION. IT IS, HOWEVER, THE CONTRACTOR'S RESPONSIBILITY TO FIELD VERIFY THE LOCATION AND ELEVATION OF ALL UTILITIES PRIOR TO THE COMMENCEMENT OF ANY CONSTRUCTION. CONTRACTOR TO FIELD VERIFY ALL EXISTING SITE CONDITIONS PRIOR TO CONSTRUCTION. IF A CONFLICT EXISTS BETWEEN WHAT IS SHOWN ON THESE DRAWINGS AND WHAT EXISTS IN THE FIELD, THE CONTRACTOR IS TO NOTIFY THE ARCHITECT OR ENGINEER IMMEDIATELY.

AS BUILTS

NO.	DESCRIPTION OF REVISIONS	DATE	INITIALS
1	ADJUST FIRST ST. SS	12/21/06	HW/K KB

GNLV CORPORATION
P.O. BOX 610
LAS VEGAS NEVADA
89125

MARTIN & MARTIN
CONSULTING ENGINEERS
2101 S. JONES, SUITE 120
LAS VEGAS, NV 89146
PHONE (702) 248-0000
FAX (702) 248-8070

SHEET
SANITARY SEWER PLAN AND PROFILE

TITLE
GOLDEN NUGGET TOWER ADDITION

DATE 6/8/06
JOB NUMBER 2107.02
DESIGN BY J. PATCHETT, E.I.
DRAWN BY B. FUNK
CHECKED BY R. STRIEGEL, P.E.

SEAL
REGISTERED PROFESSIONAL ENGINEER - STATE OF NEVADA
RICHARD R. STRIEGEL
EXP. 6-30-08
CIVIL
NO. 12555

SHEET
C5.06
SHEET 12 OF 14

DRAWING NUMBER
10714611-2

H:\Civil\proj\2107\dwg\gn-towers\drawings\2107-06-SS-PP.dwg CS 96, 8/30/2006 11:34:04 AM, jpatchett