

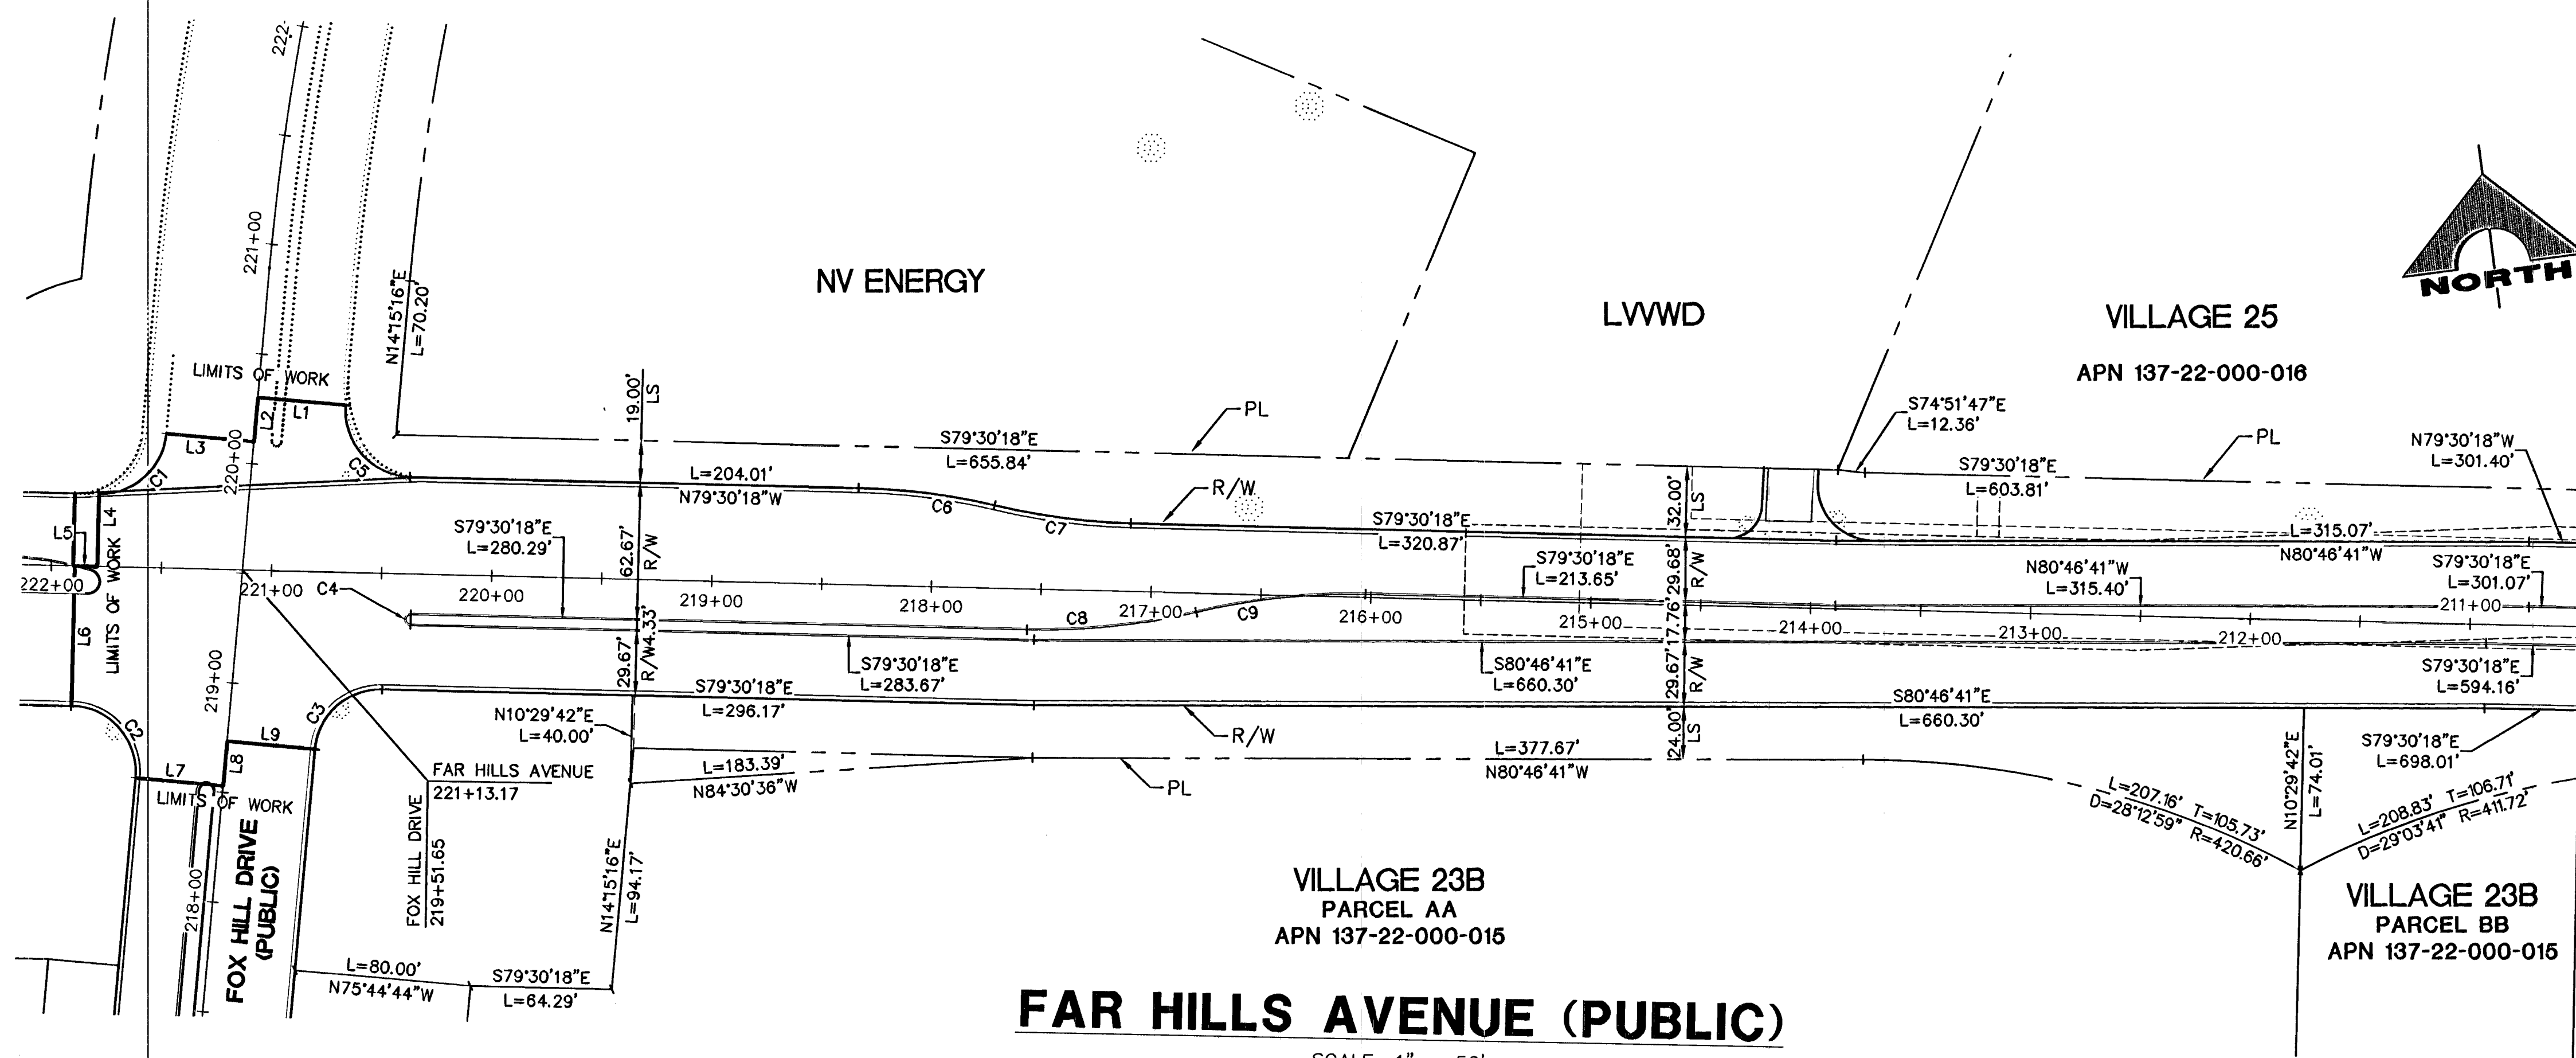
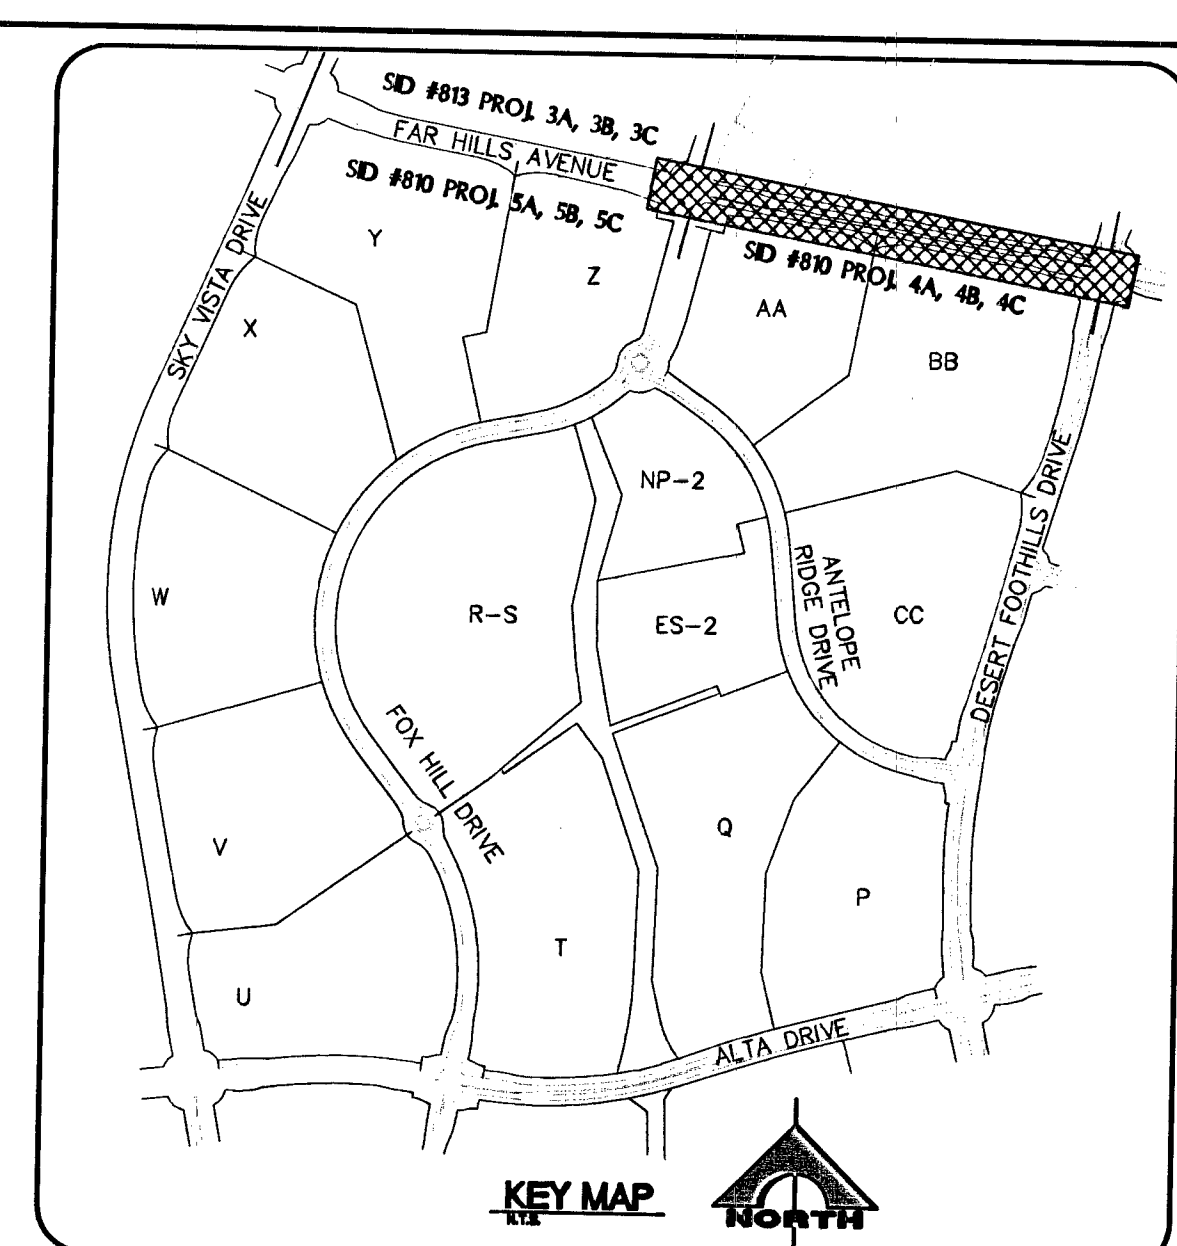


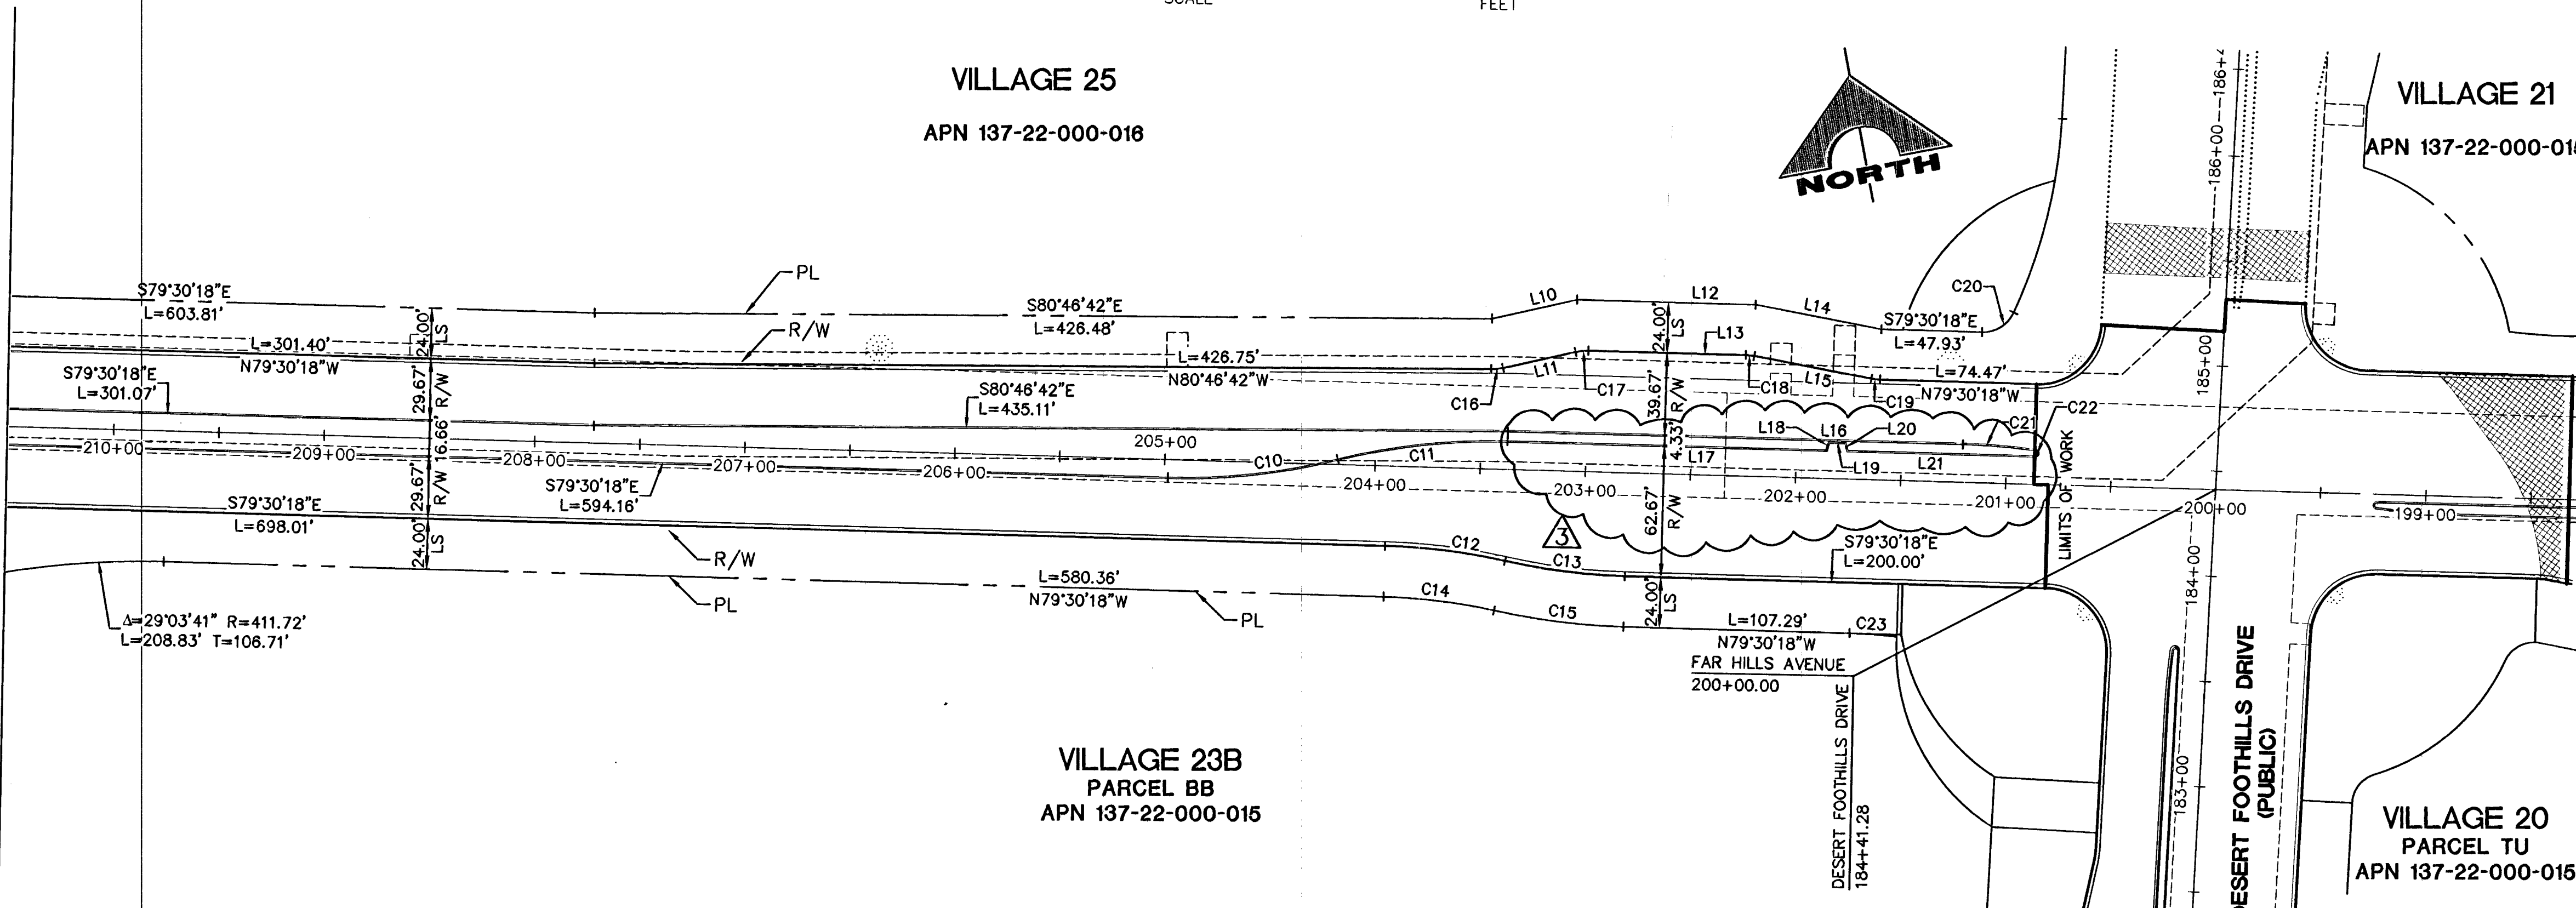

FAR HILLS AVENUE (PUBLIC)

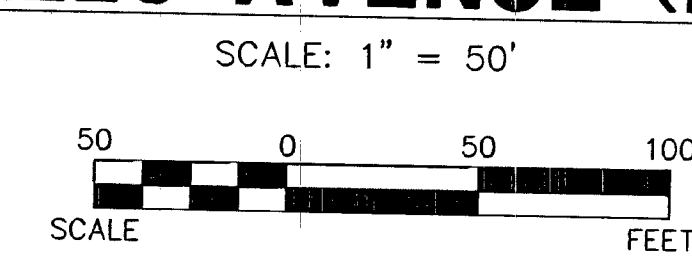

CURVE TABLE				
CURVE #	LENGTH	RADIUS	TANGENT	DELTA
C1	45.16'	30.00'	28.09'	N57°22'29"E
C2	49.09'	30.00'	32.04'	N32°37'31"W
C3	45.16'	30.00'	28.09'	S57°22'29"W
C4	6.80'	2.16'	348134.10'	S10°29'41"W
C5	49.09'	30.00'	32.04'	S32°37'31"E
C6	62.56'	300.00'	31.40'	N73°31'50"W
C7	62.56'	300.00'	31.40'	S73°31'50"E
C8	77.68'	300.00'	39.06'	S86°55'21"E
C9	77.68'	300.00'	39.06'	N86°55'21"W
C10	81.49'	300.00'	41.00'	S87°17'12"E
C11	81.49'	300.00'	41.00'	N87°17'12"W
C12	57.53'	300.00'	28.86'	N74°00'39"W
C13	57.53'	300.00'	28.86'	S74°00'39"E
C14	52.93'	276.00'	26.55'	N74°00'39"W
C15	62.14'	324.00'	31.16'	S74°00'39"E
C16	5.84'	25.00'	2.83'	S87°14'33"E
C17	6.20'	25.00'	3.11'	N86°36'21"W
C18	4.13'	25.00'	2.07'	N74°46'26"W
C19	4.13'	25.00'	2.07'	S74°46'26"E
C20	18.62'	16.00'	10.53'	N67°08'59"E
C21	34.64'	300.00'	17.34'	N76°11'49"W
C22	3.54'	1.17'	20.24'	N13°48'11"E
C23	22.86'	251.00'	11.44'	N76°53'46"W

PARCEL LINE TABLE		
LINE #	LENGTH	DIRECTION
L1	40.00'	N75°44'44"W
L2	20.22'	S14°15'16"W
L3	40.00'	N75°44'44"W
L4	33.00'	S10°29'42"W
L5	10.29'	N79°30'18"W
L6	63.67'	S10°29'42"W
L7	40.00'	N75°49'07"W
L8	20.22'	S14°15'16"W
L9	40.00'	N75°40'22"W
L10	41.42'	N86°17'36"E
L11	35.31'	S86°17'36"W
L12	84.98'	S79°30'18"E
L13	74.82'	N79°30'18"W
L14	60.74'	S70°02'34"E
L15	56.69'	N70°02'34"W
L16	216.54'	S79°30'18"E
L17	151.46'	S79°30'18"E
L18	3.83'	N25°29'42"E

PARCEL LINE TABLE		
LINE #	LENGTH	DIRECTION
L19	8.41'	S79°30'18"E
L20	3.83'	S4°30'18"E
L21	89.12'	S79°30'18"E

BENCHMARK			
BM #	DESCRIPTION	NAVD 88 DATUM	NAVD 88 DATUM
34NE8	RIVET AND PLATE IN TOP OF CURB @ NORTHEAST CORNER OF DESERT FOOTHILLS AND ALTA DRIVE	3304.45 (FEET)	1007.197 (METERS)

NOTE
THIS SET OF DRAWINGS IS BASED UPON NAVD 88 DATUM. PREVIOUS DRAWINGS MAY BE BASED ON OTHER DATUM. CARE SHOULD BE OBSERVED WHEN UTILIZING THIS SET OF DRAWINGS.

BASIS OF BEARINGS
NORTH 89°45'05" EAST BEING THE SOUTH LINE OF THE SOUTHWEST QUARTER (SW 1/4) OF SECTION 35, TOWNSHIP 20 SOUTH, RANGE 59 EAST, W.D.M., AS SHOWN BY MAP ON FILE IN FILE 91, PAGE 28 OF PARCEL MAPS IN THE CLARK COUNTY RECORDER'S OFFICE, CLARK COUNTY, NEVADA

PROJECT NO. **62023B-205**

DESIGN: DFK
DRAWN: HLF
CHECK: JJJ

PLOT DATE: 09-24-14
PLOT TIME: 09:04:27

G.C. WALLACE COMPANIES
ENGINEERS | PLANNERS | SURVEYORS
1555 RAINBOW BOULEVARD, SUITE 200
LAS VEGAS, NEVADA 89146
TEL: 702.804.2200 FAX: 702.804.2209
WWW.GCWALLACE.COM

THE HOWARD HUGHES COMPANY, LLC

VILLAGE 23B
FAR HILLS AVENUE IMPROVEMENTS - PHASE 1
DESERT FOOTHILLS DRIVE TO FOX HILL DRIVE

HORIZONTAL CONTROL

DRAWING
H01
4 OF 29 SHOTS

MATCH LINE 210+50 SEE ABOVE RIGHT

MATCH LINE 210+50 SEE BELOW LEFT

Replot

H #50132
CLV #107V6128