
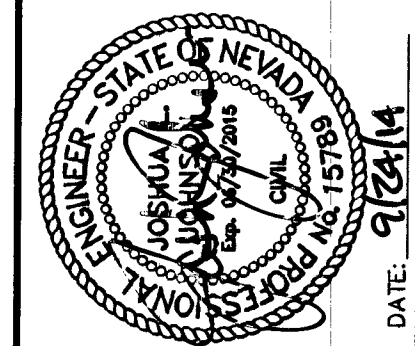


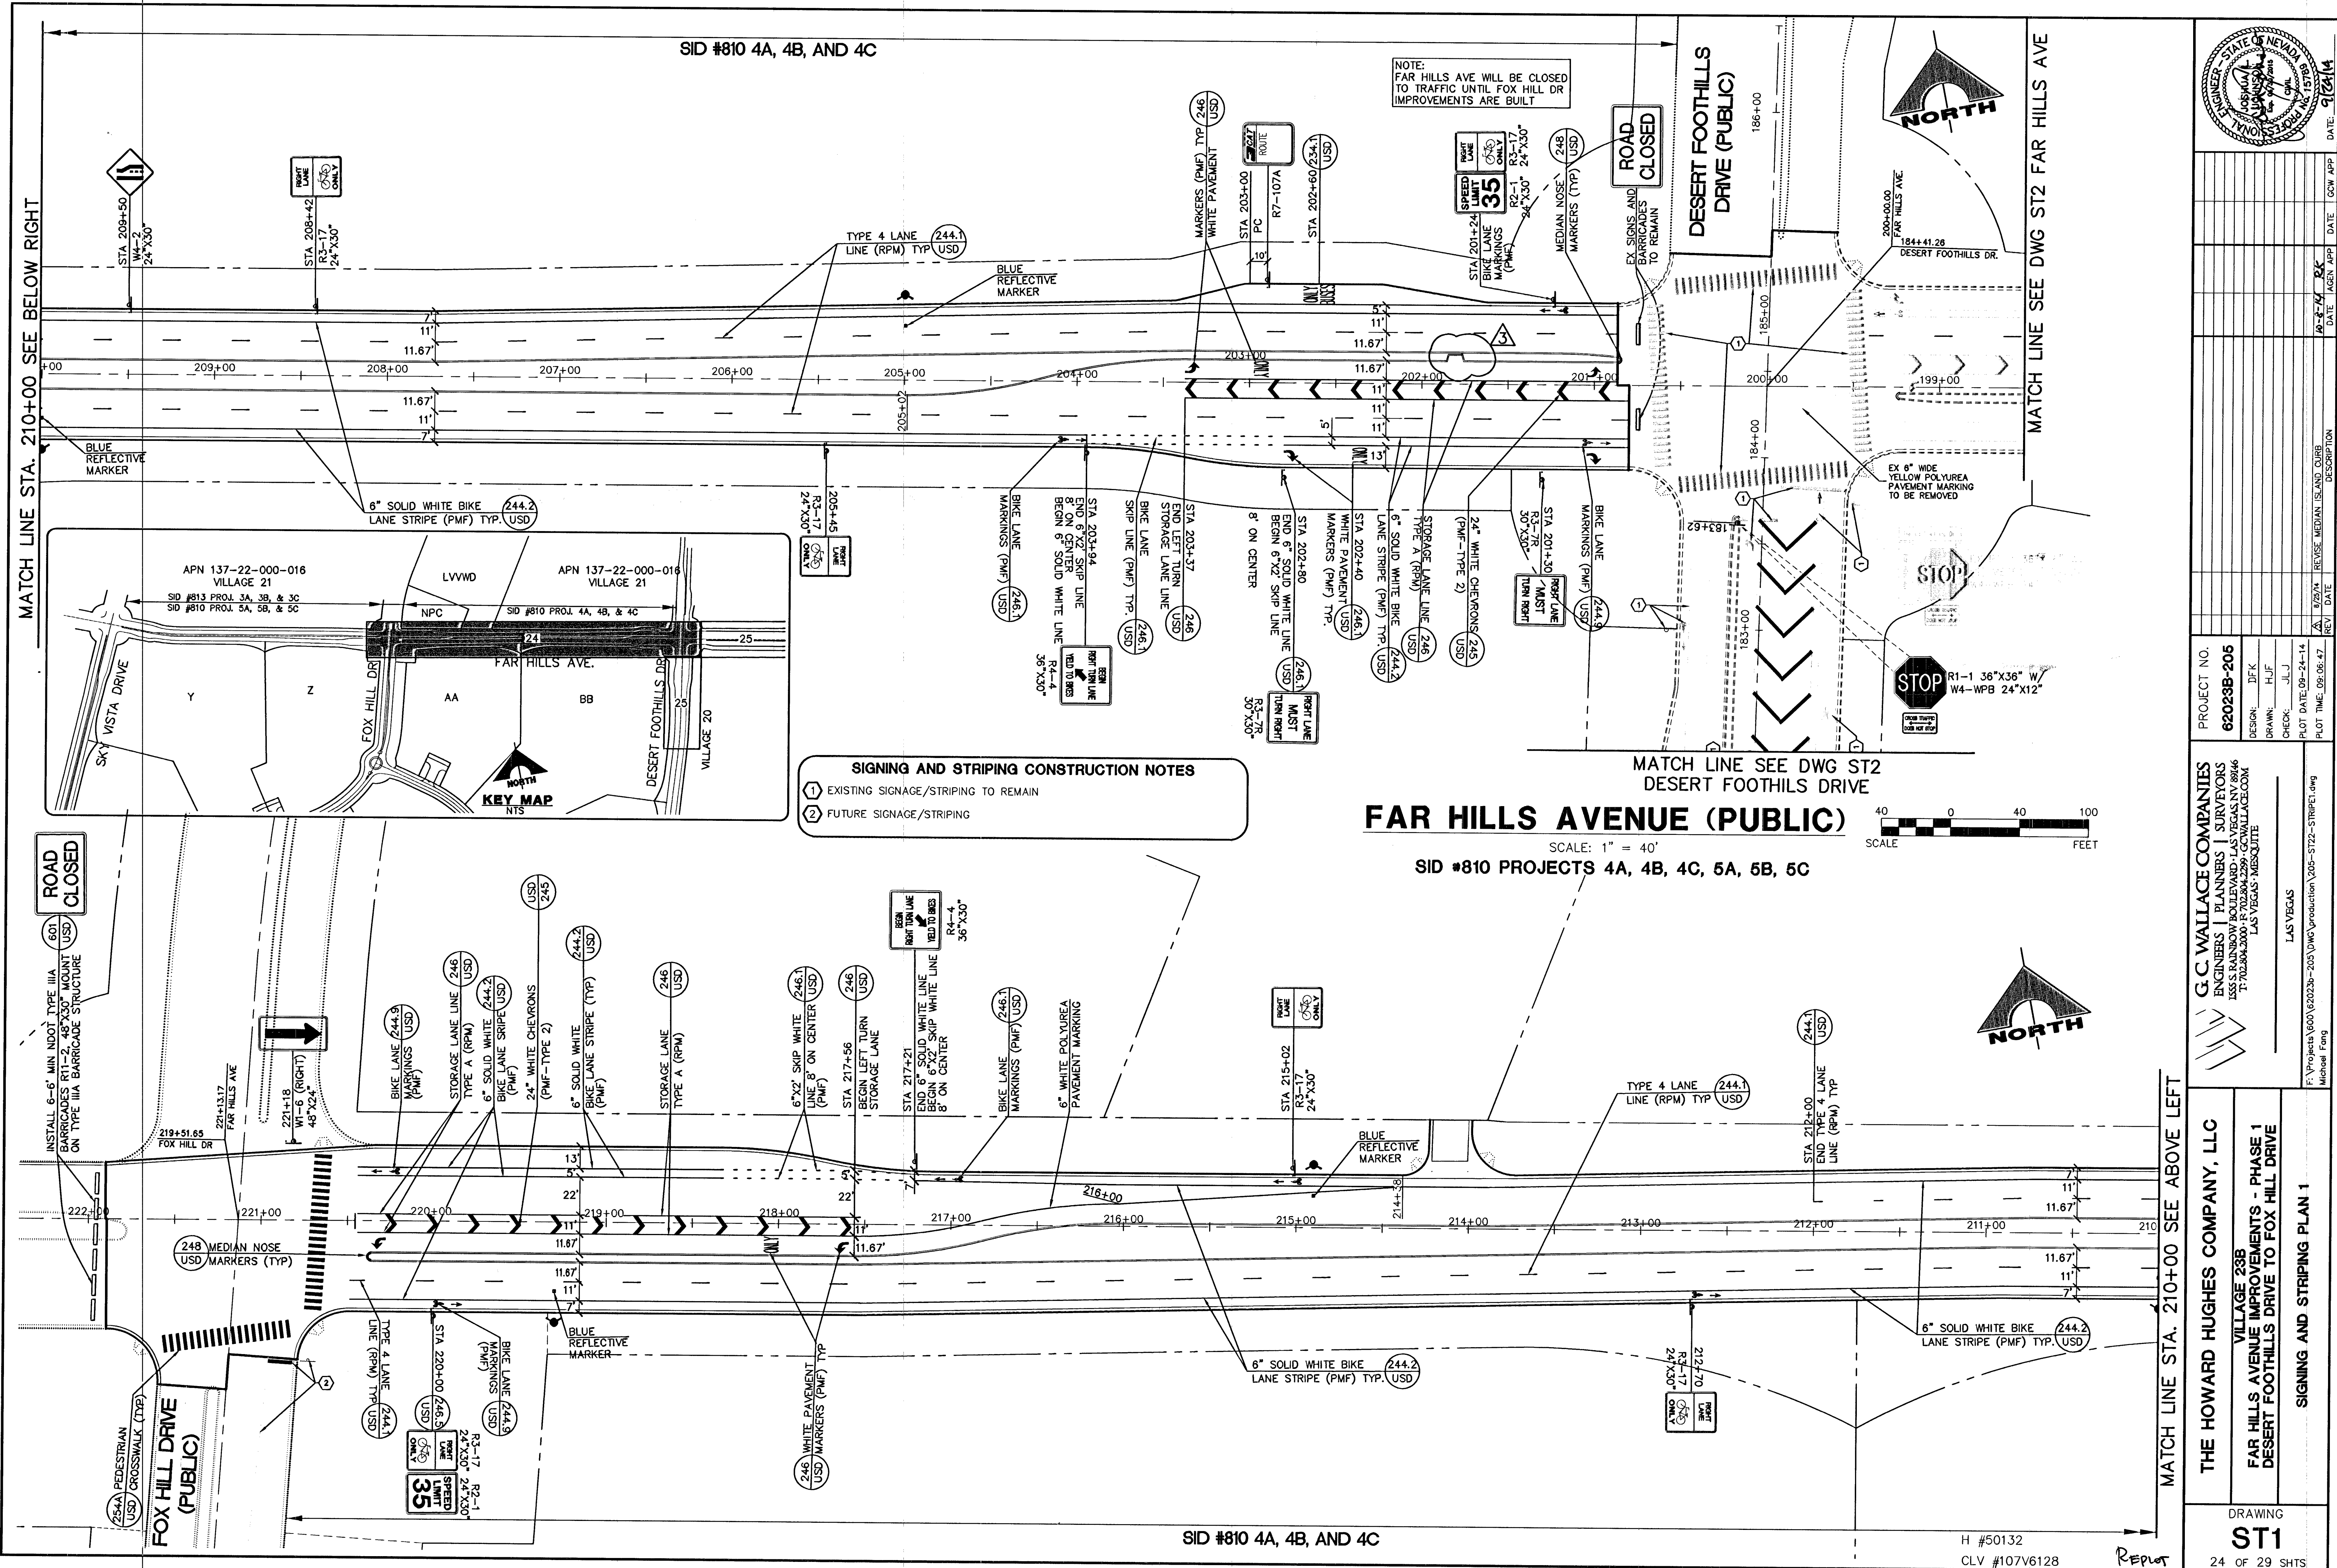

| DATE    | AGN APP | DATE | GCW APP |
|---------|---------|------|---------|
| 10-2-14 | RK      |      |         |

| PROJECT NO. | 62023B-205  |
|-------------|-------------|
| DESIGN      | DFK         |
| DRAWN       | HJF         |
| CHECK       | JLJ         |
| PLOT DATE   | 09-24-14    |
| REVISION    | ISLAND CURB |

G.C. WALLACE COMPANIES  
ENGINEERS | PLANNERS | SURVEYORS  
1535 S. RAINBOW BOULEVARD • LAS VEGAS, NV 89146  
T: 702.686.2000 • F: 702.686.2299 • GFWALLACE.COM  
LAS VEGAS, NEVADA

THE HOWARD HUGHES COMPANY, LLC  
VILLAGE 23B  
FAR HILLS AVENUE IMPROVEMENTS - PHASE 1  
DESERT FOOTHILLS DRIVE TO FOX HILL DRIVE

DRAWING  
**ST1**  
24 OF 29 SHTS