
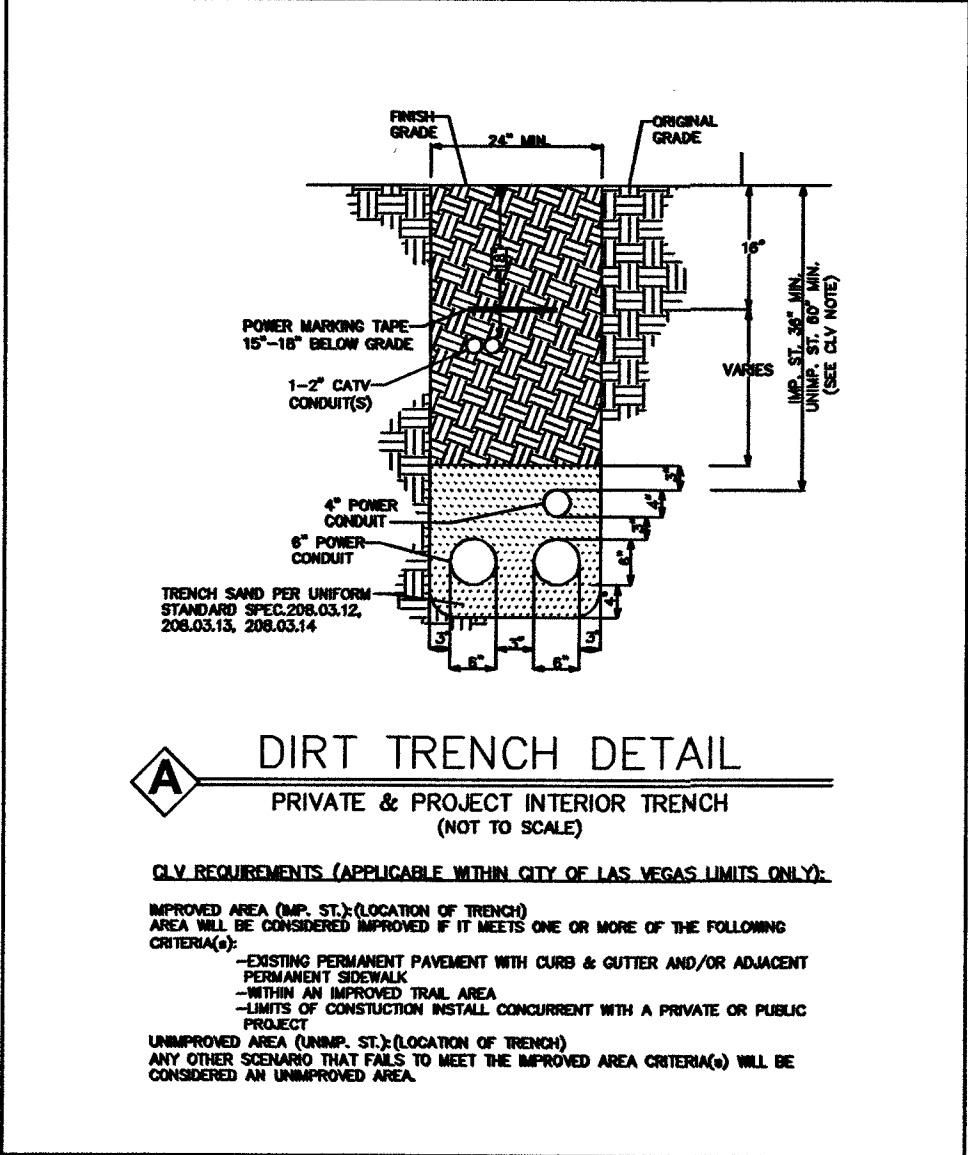


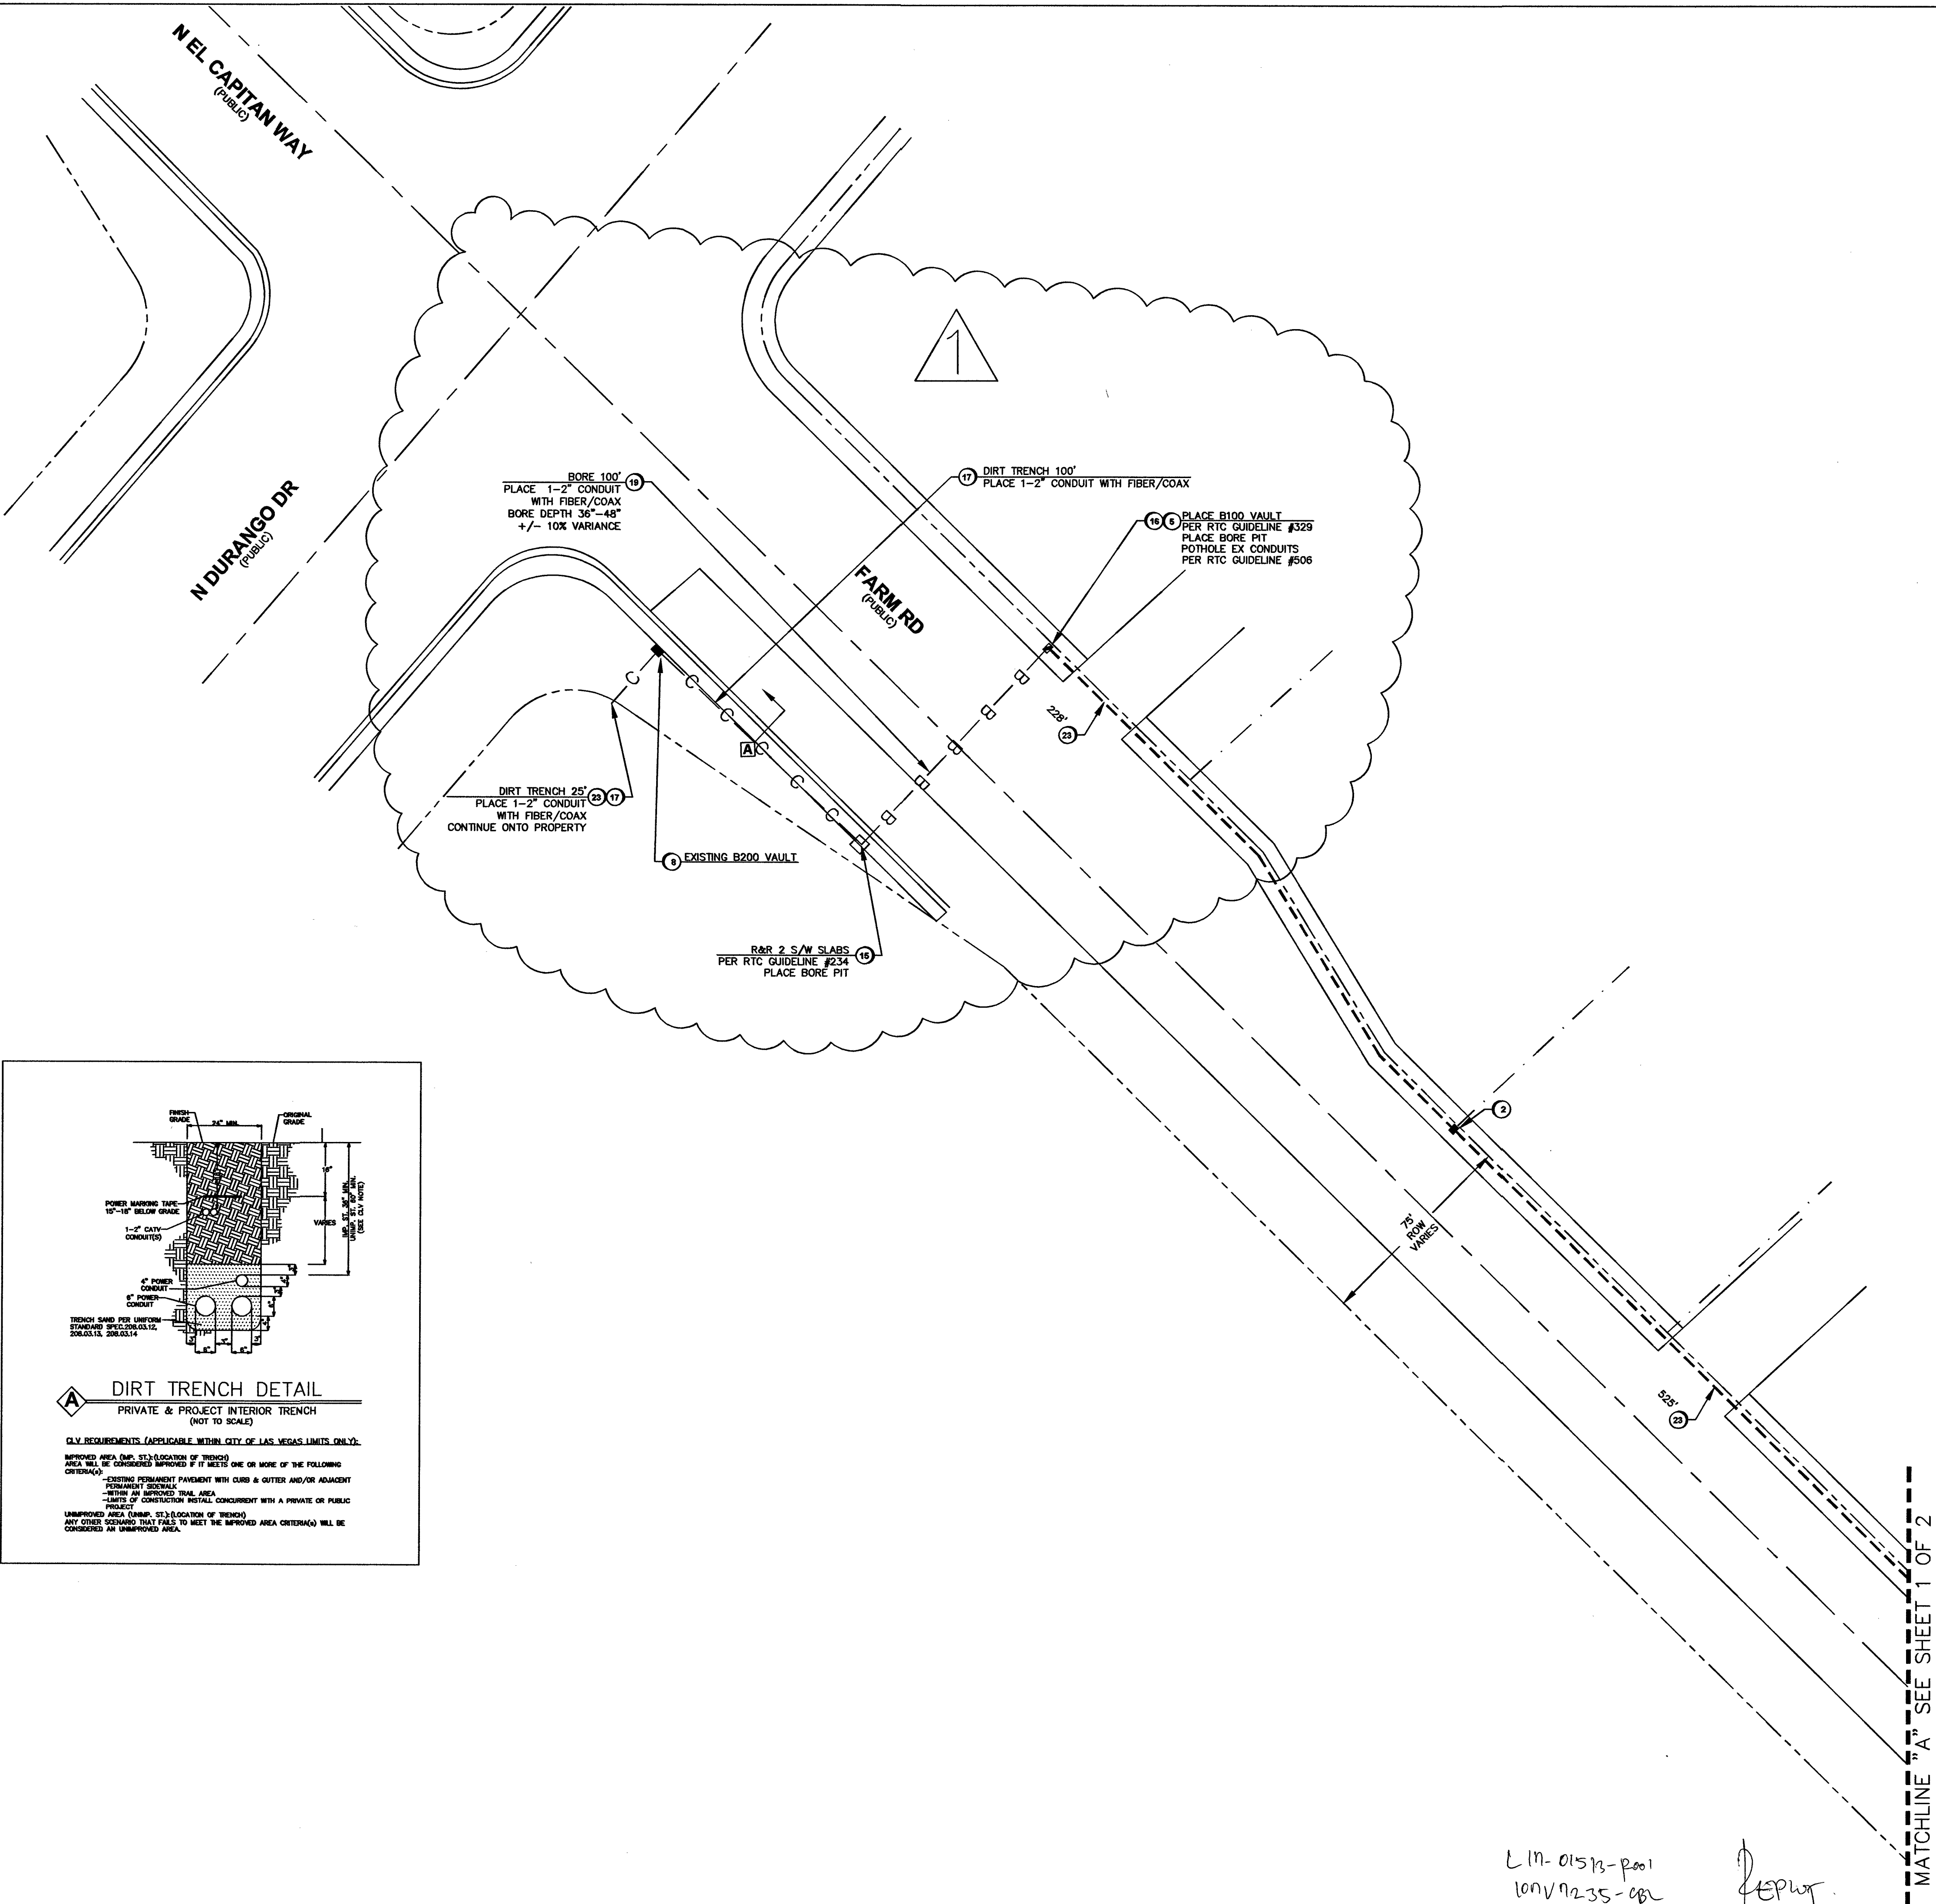

1

2

3

4

5

6

7

8

9

10

11

12

13

14

15

16

17

18

19

20

21

22

23

24

25

26

27

28

29

30

31

32

33

34

35

36

37

38

39

40

41

42

43

44

45

INSTALL B-36 PULL BOX (24"x36"x24")

EXISTING B-36 PULL BOX (24"x36"x24")

INSTALL B-50 PULL BOX (13"x24"x24")

EXISTING B-50 PULL BOX (13"x24"x24")

INSTALL B-100 PULL BOX (24"x36"x24")

EXISTING B-100 PULL BOX (24"x36"x24")

INSTALL T-200 CATV VAULT (30"x48"x36")

EXISTING T-200 CATV VAULT (30"x48"x36")

INSTALL T-400 CATV VAULT (36"x60"x36")

EXISTING T-400 CATV VAULT (36"x60"x36")

INSTALL T-600 CATV VAULT (48"x72"x36")

EXISTING T-600 CATV VAULT (48"x72"x36")

INSTALL NEW CATV PEDESTAL

EXISTING NEW CATV PEDESTAL

R&R S/W SLAB(S)

POTHOLE

SIDEWALK/DIRT TRENCH INSTALL

ASPHALT/STREET TRENCH INSTALL

PROPOSED BORE

EXISTING CATV CONDUIT(S)

PROPOSED OVERHEAD FIBER OPTIC CABLE OR COAX INSTALL

EXISTING OVERHEAD FIBER OPTIC CABLE OR COAX

U.G. FIBER/COAX PULL

RIGHT OF WAY LINE

LOT/PROPERTY LINE

EDGE OF PAVEMENT

EXISTING NVE PULL BOX

EXISTING TELCO PULL BOX

EXISTING TELCO MANHOLE

EXISTING TELCO POLE

EXISTING NVE POLE

EXISTING NVE TRANSMISSION POLE

EXISTING JOINT POLE

EXISTING JOINT POLE WITH TRANSFORMER

POLE ANCHOR

EXISTING NVE TRANSFORMER TRANSFORMER PAD

SNWA TEST STATION

COX POWER SUPPLY (49"x24"x52")

INSTALL RHINO CABINET

RISER POLE/QUADRANT DETAIL RISER OWNERSHIP NOTED

RAILROAD

EXISTING MANHOLE (SS)(SD)...ECT

1in CONDUIT LATERAL

DISCLAIMER NOTE

UTILITY LOCATIONS SHOWN HEREON ARE APPROXIMATE ONLY. IT SHALL BE THE CONTRACTOR'S RESPONSIBILITY TO DETERMINE THE EXACT HORIZONTAL AND VERTICAL LOCATION OF ALL EXISTING UNDERGROUND AND OVERHEAD UTILITIES PRIOR TO COMMENCING CONSTRUCTION. NO REPRESENTATION IS MADE THAT ALL EXISTING UTILITIES ARE SHOWN HEREON. THE ENGINEER ASSUMES NO RESPONSIBILITY FOR UTILITIES NOT SHOWN OR UTILITIES NOT SHOWN IN THEIR PROPER LOCATIONS.

BEFORE YOU DIG

OR 1-800-227-2600

UNDERGROUND SERVICE (USA)

BEFORE YOU OVERHEAD

CALL

1-702-227-2929

NEVADA POWER ENVIRONMENT AND SAFETY SERVICE DEPARTMENT

BEFORE YOU DIG

OR 1-800-227-2600

UNDERGROUND SERVICE (USA)

BEFORE YOU OVERHEAD

CALL

1-702-227-2929

NEVADA POWER ENVIRONMENT AND SAFETY SERVICE DEPARTMENT

TOTAL BORE

TOTAL DIRT TRENCH

TOTAL ASPHALT TRENCH

TOTAL TRENCH

TOTAL S/W PANELS

TOTAL LINEAR FOOTAGE

100'

125'

0'

125'

4

20'



















































































































































LM-01513-P001
100V12-35-001

TrueNet# 11741